




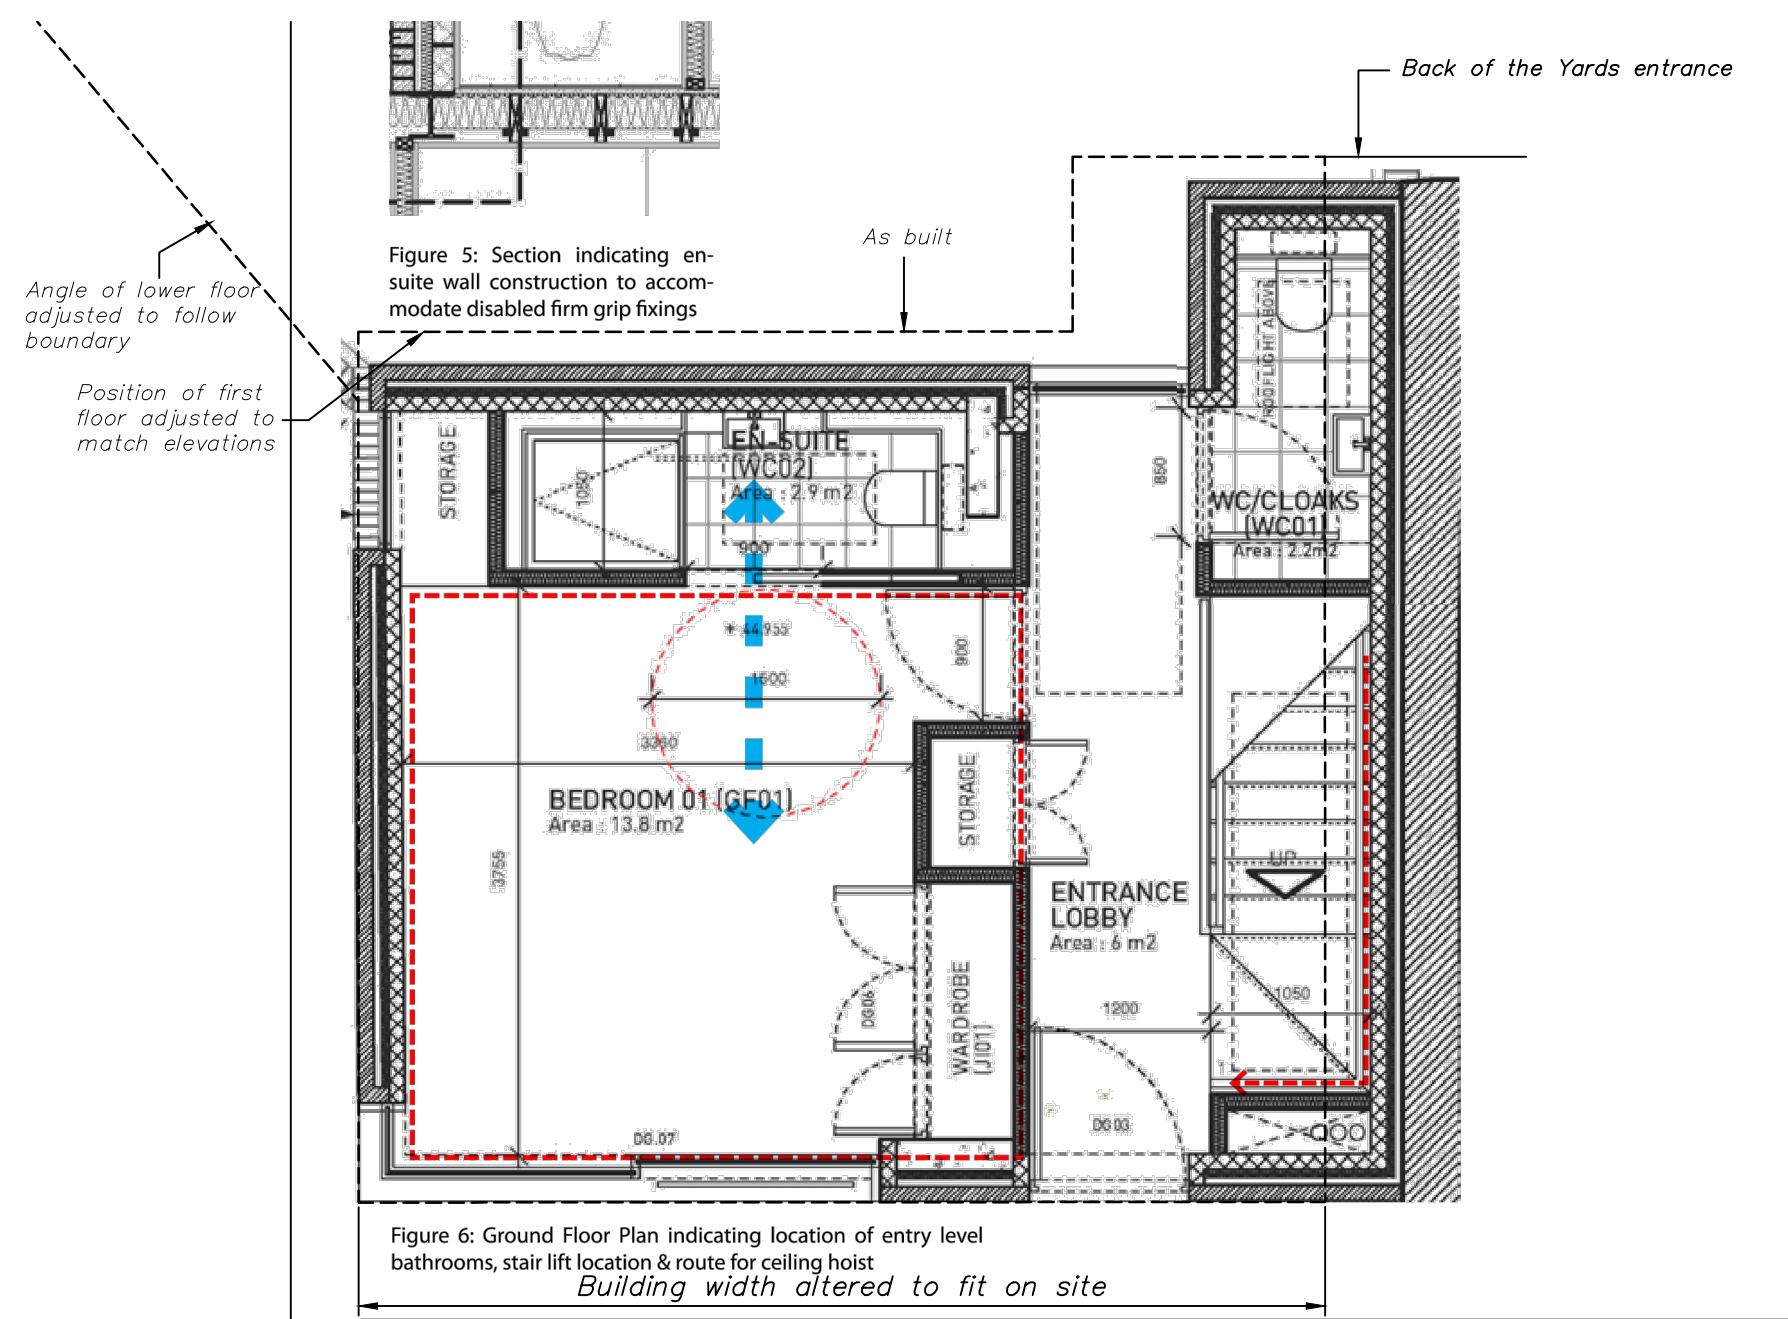

Life Time Homes and As Built overlay

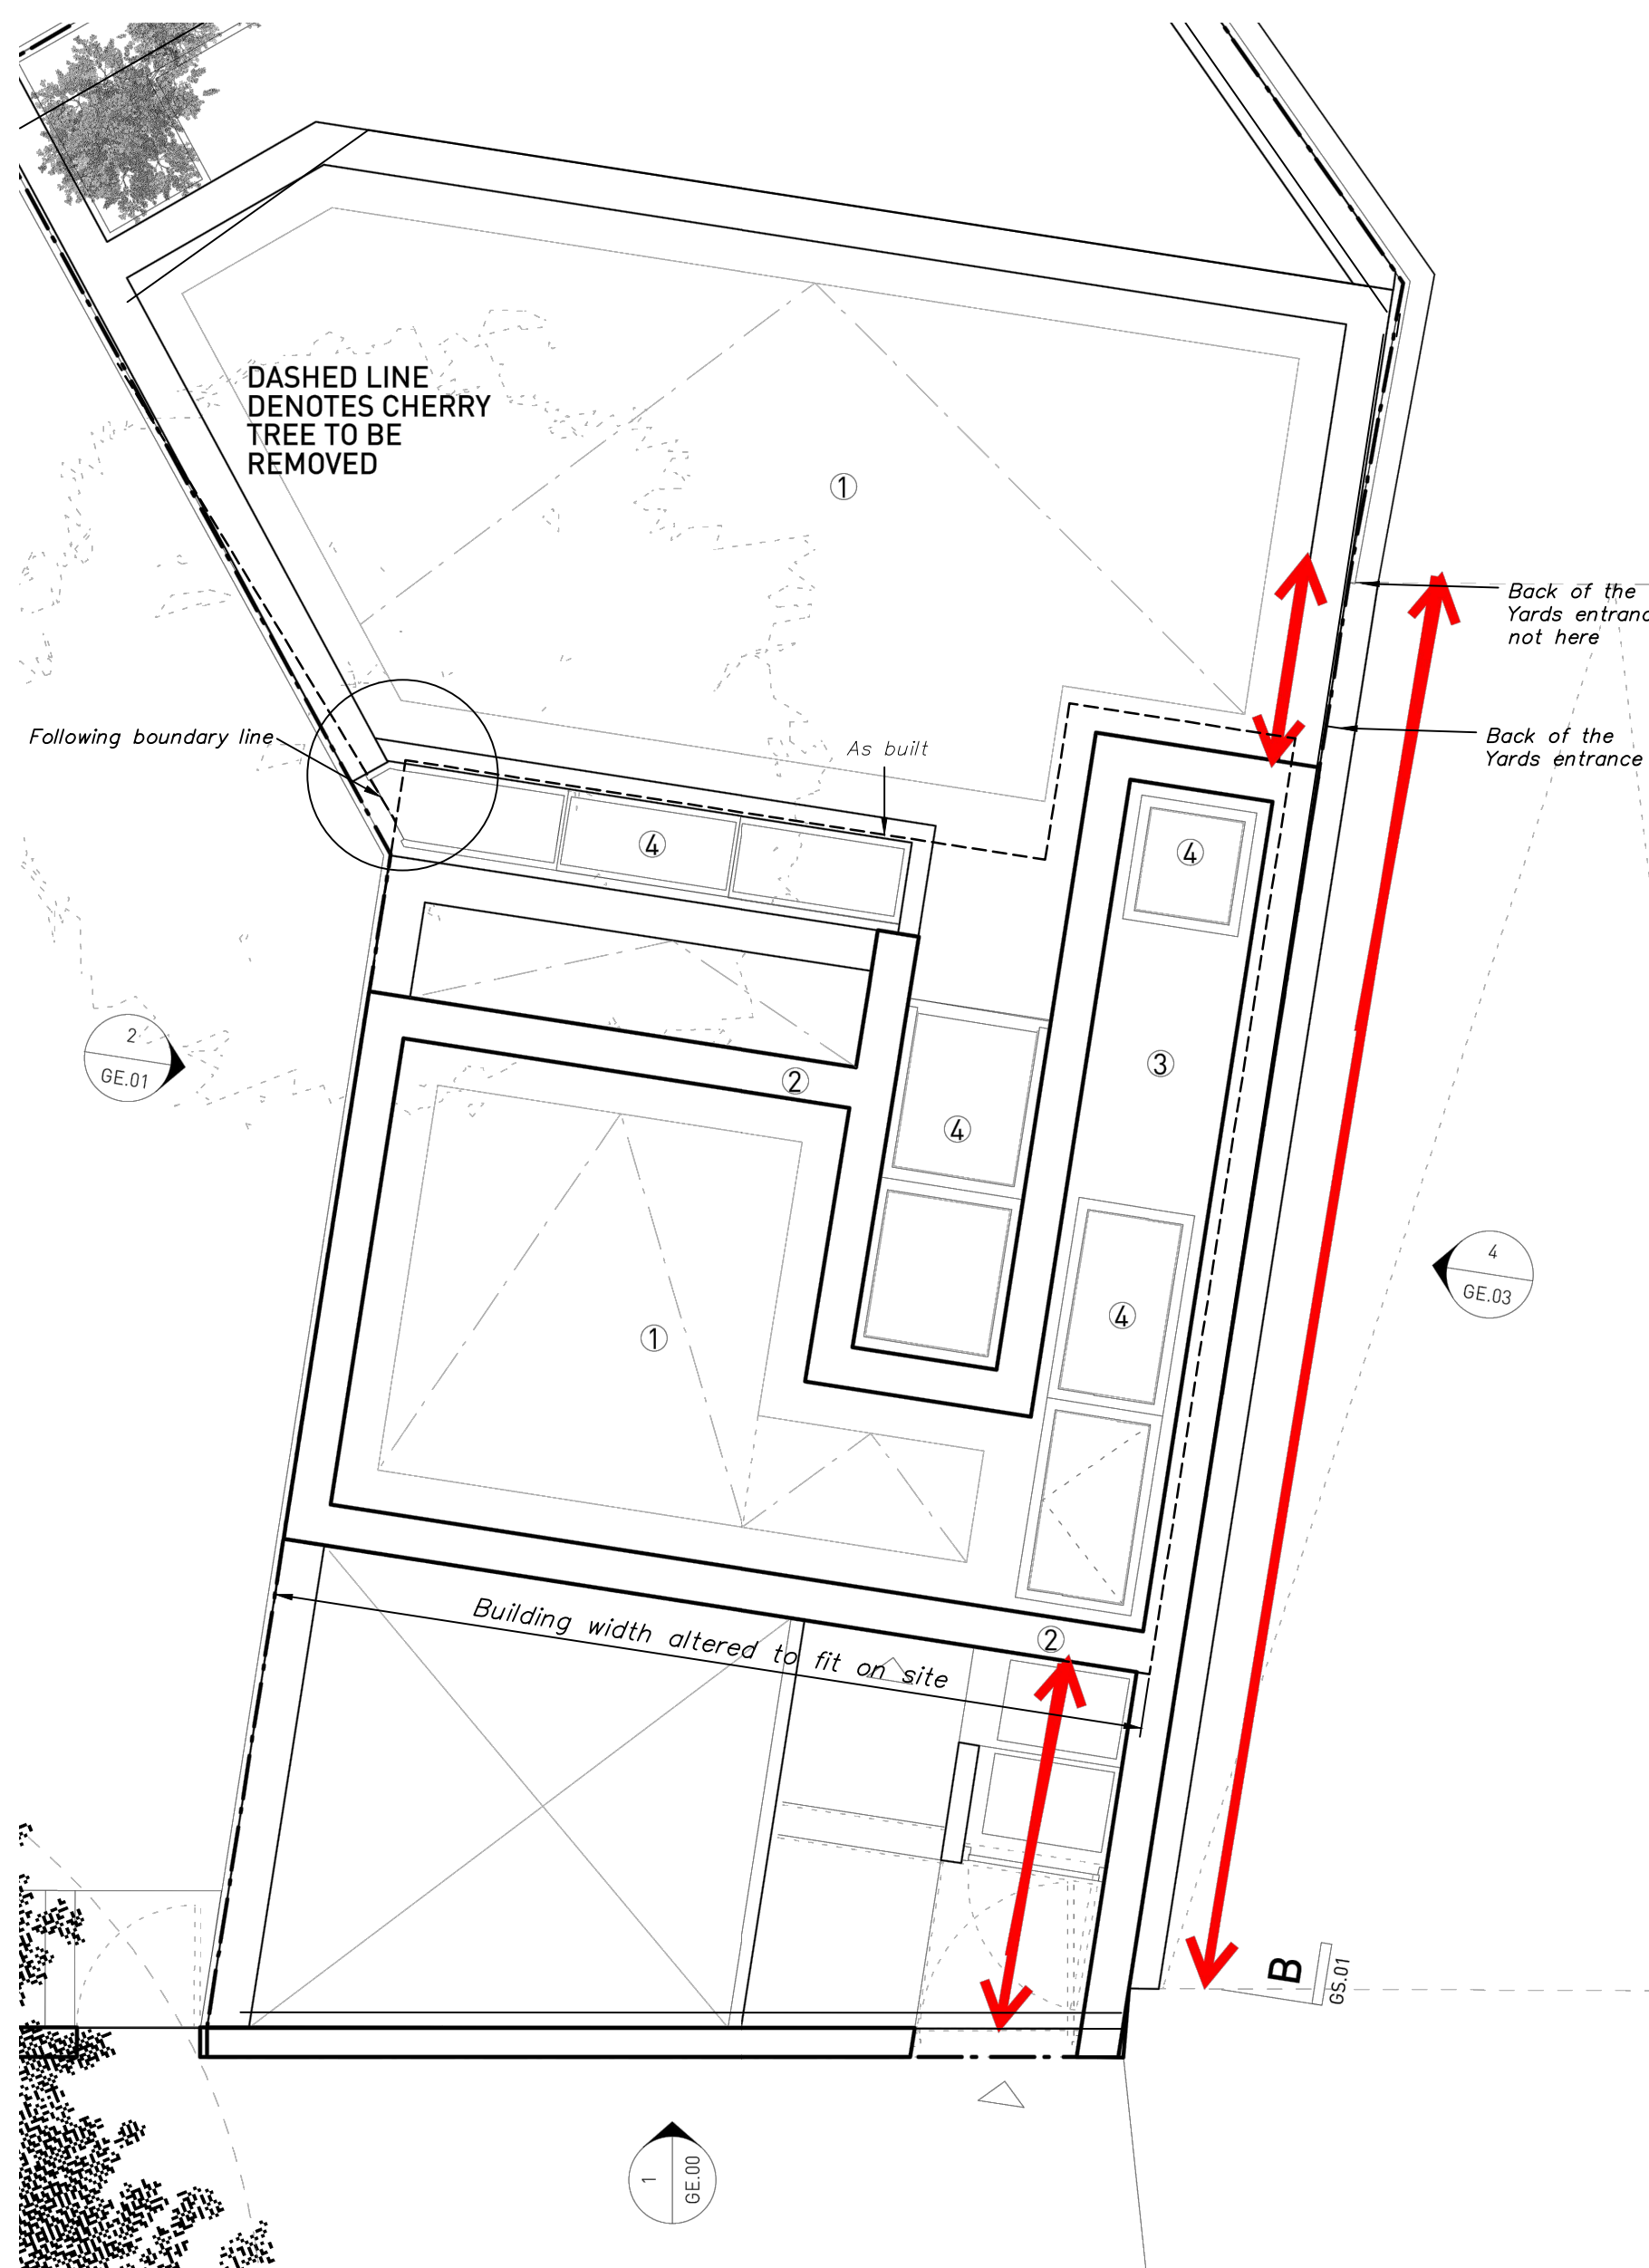

Planning and As Built overlay

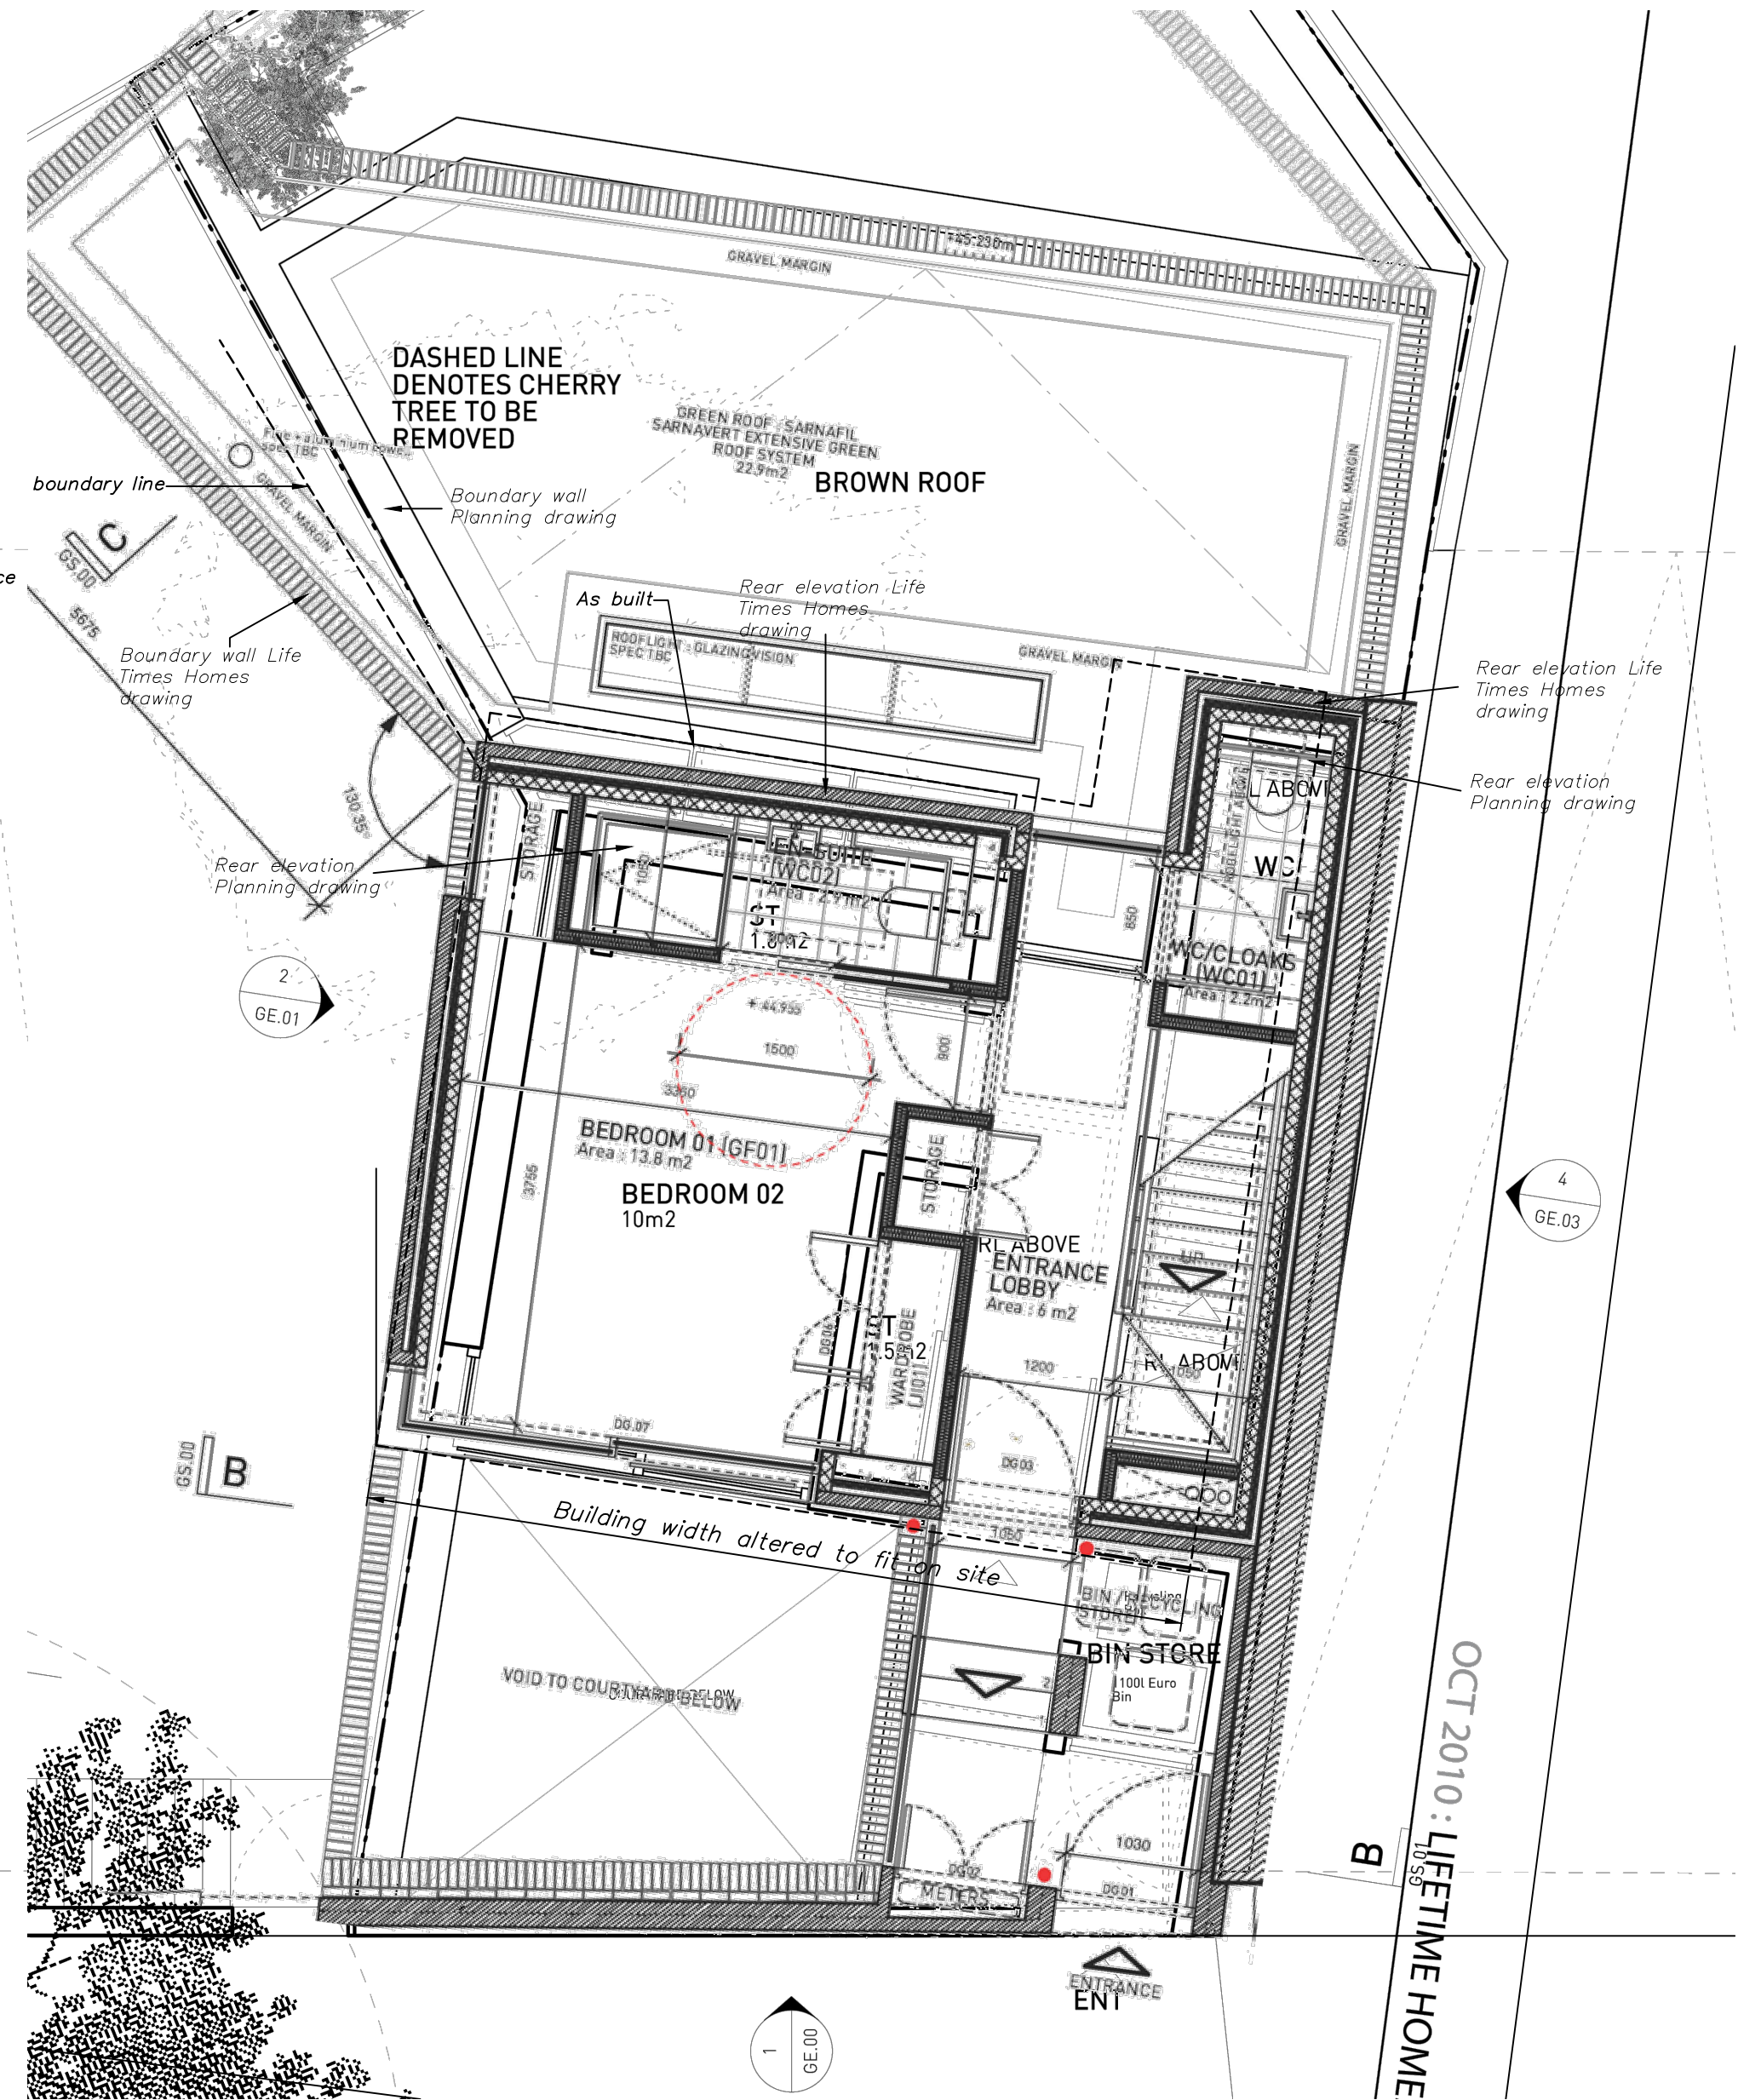

Planning and Life Time Homes and As Built overlay

RevNo	Revision note	Date	Signature	Checked
-------	---------------	------	-----------	---------

Property Design Solutions Ltd
Planning and Building Control Drawings



New builds
Loft conversions
Extensions
Conversions
SAPs

CLIENT NAME Property AV	SHEET 6	SCALE @ A1 1:50
ADDRESS Land Adjacent 10 Lady Somerset Road NW5	As Built, Planning and Life Time Homes overlays	
ISSUED 18.10.18	DWG NO LS1018/2	
REV		
CONTRACT NO		
© Copyright Property Design Solutions Ltd 2016 www.pdsitd.uk.com		07817 676211