



This drawing is protected under Copyright and at no time must any portion of this drawing be reproduced or copied in anyway without the permission of Morgan Lovell. All dimensions must be checked on site and NOT scaled from this drawing.

SUBJECT TO SITE SURVEY
CHECK SURVEY UNDERTAKEN ONLY
BUILDING PARAMETERS TAKEN FROM DRAWINGS PROVIDED
BUILDING PARAMETERS TAKEN FROM AS BUILT DRAWINGS PROVIDED

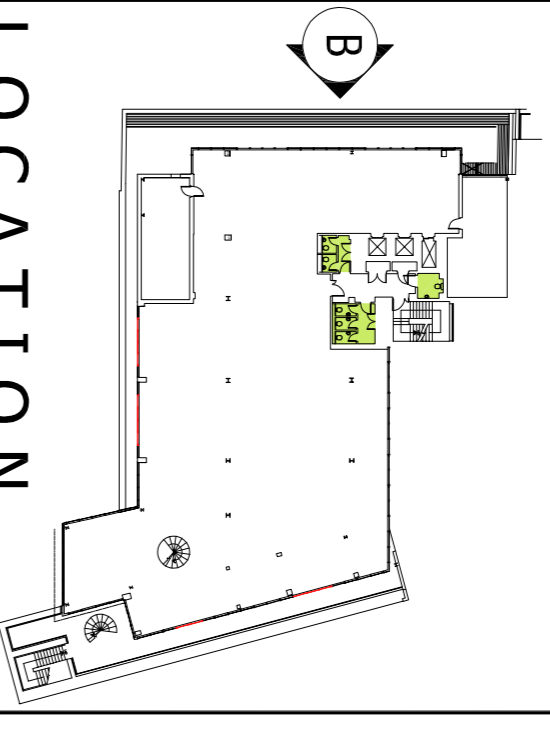

LOCATION PLAN

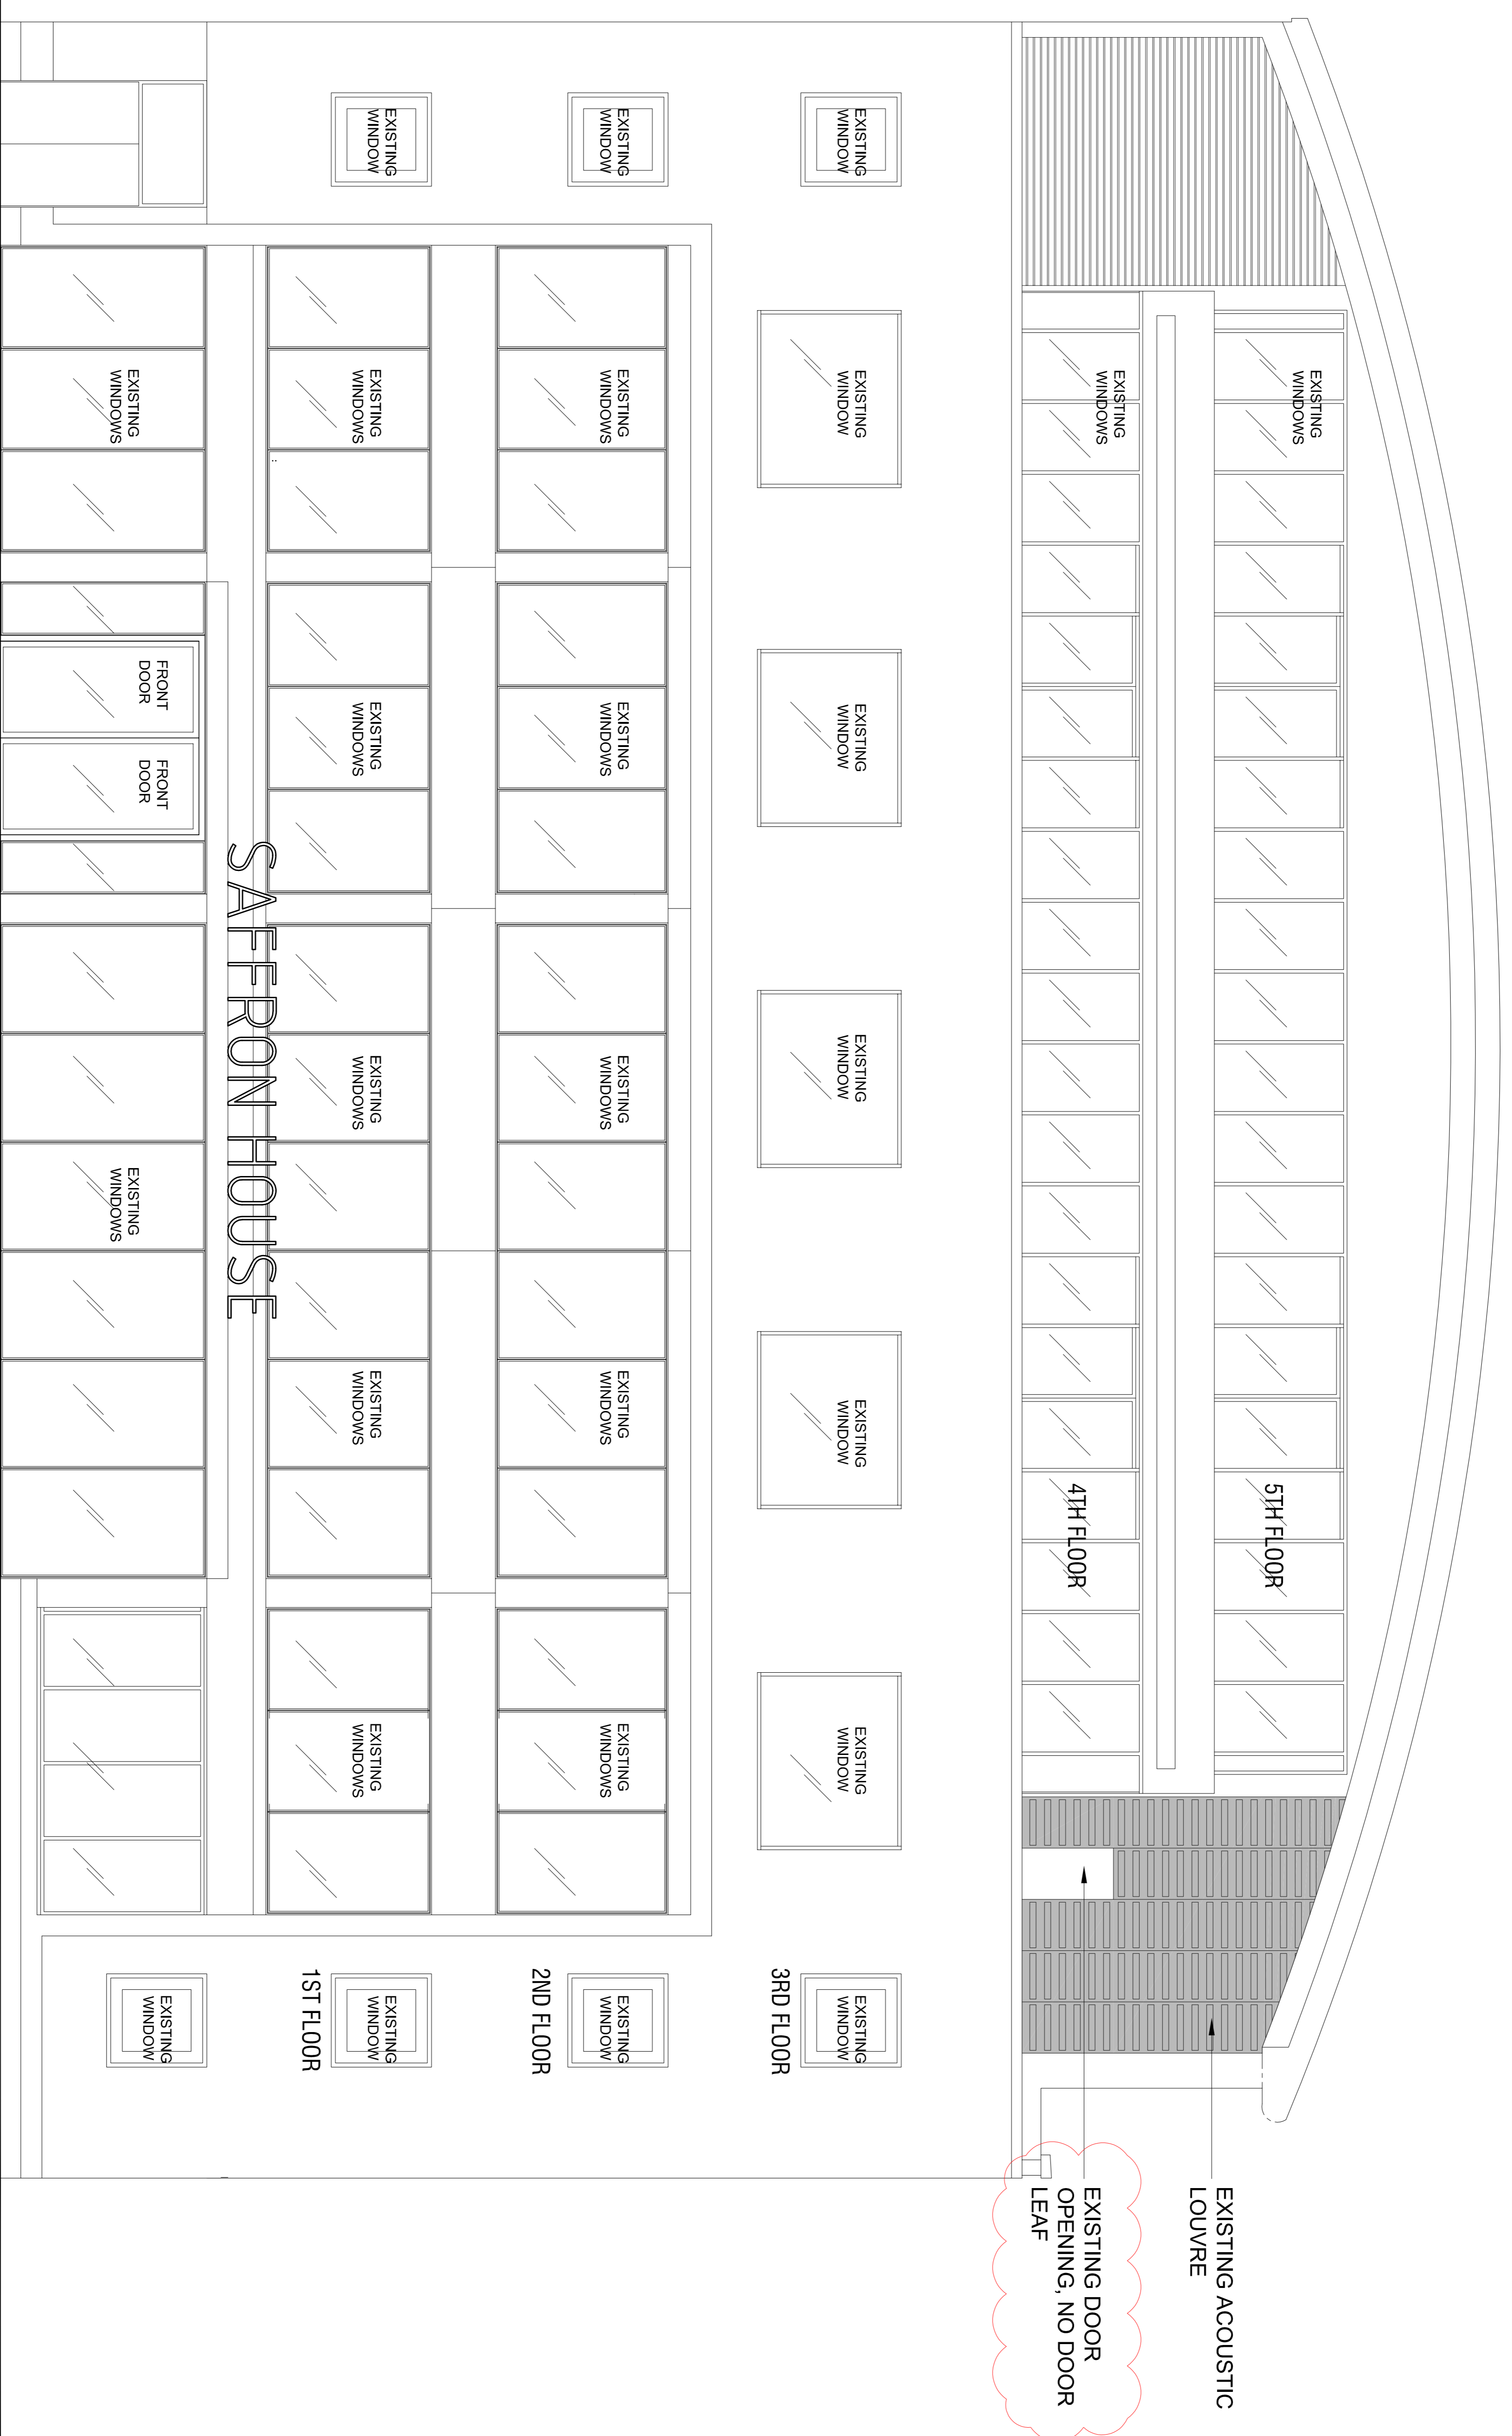

EXISTING ELEVATION (B)

1:50 @ A1

Rev	Revision	By	Date
C	AMENDED NOTE TO CORRECT MISSING DOOR	TC	03.10.18
B	REMOVED WINDOWS TO EXISTING CONDITION	TC	13.09.18
A	REVISED TO SUIT CORRELATED DRAWINGS	NS	13.07.18
-	DRAWING FIRST ISSUED	TC	16.05.18

FOR PLANNING
Morgan Lovell

16 Neal Street, London W1F 8DA
 T: 0207 734 4465 F: 0207 734 2988 E: contact@morganlovell.com
 W: mlp://www.morganlovell.com

Client
SAFFRON HOUSE
 Project
 6-10 KIRBY STREET
 LONDON
 EC1N 8TS

Title	
GROUND TO 5TH, EXISTING KIRBY STREET ELEVATION	
Scale	1:50@A1
Date	30.07.18
Designed/Drawn By	TC/TC
Checked By / Date	

Drawing Number	Floor	Drawing No.	Rev
ML2918	G-5	909	C