


Notes:
This drawing is protected by copyright. No part of this document may be reproduced, altered, or transmitted in any form or by any means without permission.
Do not scale off these drawings for construction purposes. If any discrepancies are found, please contact Proctor Watts Cole Rutter.



Lower Ground Floor Plan
Scale 1:100



Ground Floor Plan
Scale 1:100

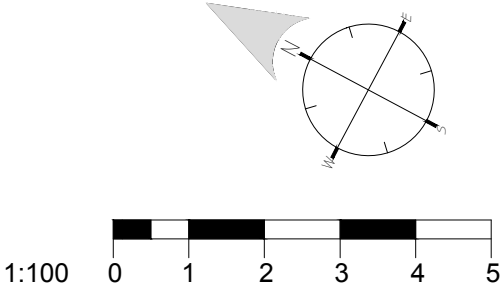


-	-	-	-
Rev.	Description:	By	Date
	Client: Peter Stuart Anderson	Drawn By:	JP
	Title: As Built Lower and Ground Floor Plans	Checked By:	-
	Project: 11 Wiblin Mews, College Lane, Kentish Town, London	Scale: 1:100@A3	Date: 17 Oct 2018
Job No: 4672(18)	Dwg No: S41	Revision:	-
Proctor Watts Cole Rutter Chartered Architects & Town Planners Grosvenor House, Bleke Street, Shaftesbury, Dorset, SP7 8AW. Phone: 01747 851881 Fax: 01747 851081 mail@pwcr.co.uk www.pwcr.co.uk			


Notes:
This drawing is protected by copyright. No part of this document may be reproduced, altered, or transmitted in any form or by any means without permission.
Do not scale off these drawings for construction purposes. If any discrepancies are found, please contact Proctor Watts Cole Rutter.



First Floor Plan
Scale 1:100

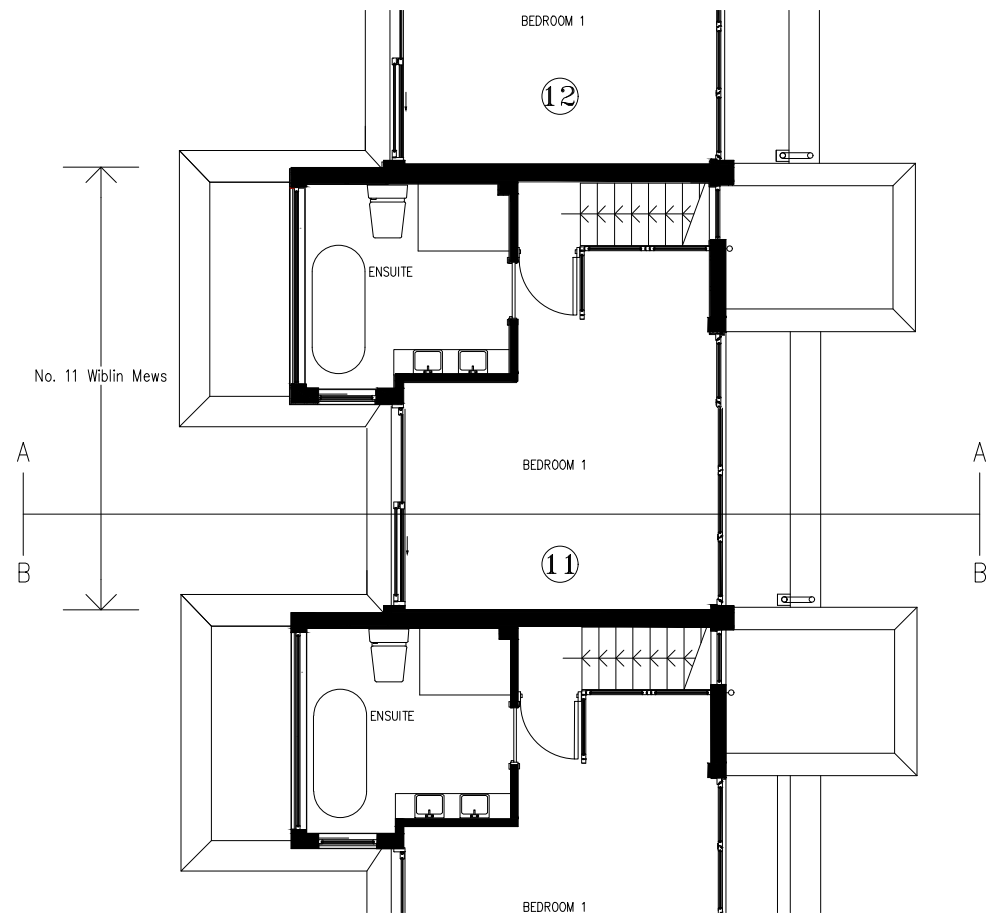


Second Floor Plan
Scale 1:100

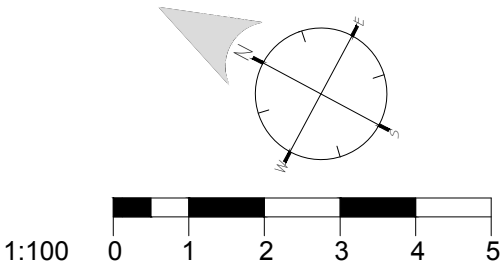

Rev.	Description:	By	Date
-	-	-	-
Client: Peter Stuart Anderson		Drawn By: JP	
Title: As Built First and Second Floor Plans		Checked By: -	
Project: 11 Wiblin Mews, College Lane, Kentish Town, London		Scale: 1:100@A3	
Job No: 4672(18)		Date: 17 Oct 2018	
Dwg No: S42		Revision: -	

Notes:
This drawing is protected by copyright. No part of this document may be reproduced, altered, or transmitted in any form or by any means without permission.
Do not scale off these drawings for construction purposes. If any discrepancies are found, please contact Proctor Watts Cole Rutter.

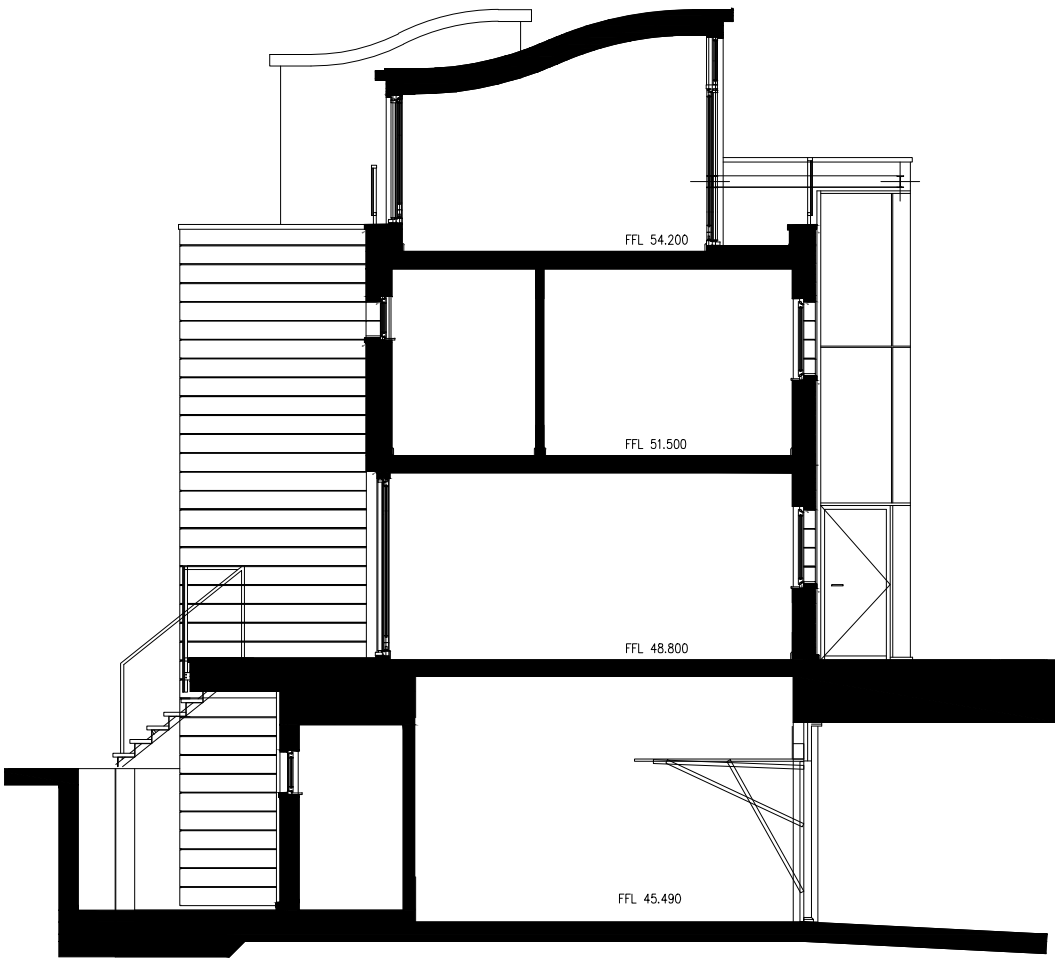

Section A-A
Scale 1:100



Section B-B
Scale 1:100




-	-	-	-
Rev.	Description:	By	Date
Client: Peter Stuart Anderson		Drawn By: JP	
Title: As Built Section		Checked By: -	
Project: 11 Wiblin Mews, College Lane, Kentish Town, London		Scale: 1:100@A3	Date: 17 Oct 2018
Job No: 4672(18)	Dwg No: S43	Revision: -	

**Proctor Watts Cole Rutter**
Chartered Architects & Town Planners
Grosvenor House, Bleke Street, Shaftesbury, Dorset, SP7 8AW.
Phone: 01747 851881 Fax: 01747 851081
mail@pwcr.co.uk www.pwcr.co.uk

Notes:
This drawing is protected by copyright. No part of this document may be reproduced, altered, or transmitted in any form or by any means without permission.
Do not scale off these drawings for construction purposes. If any discrepancies are found, please contact Proctor Watts Cole Rutter.



North West Elevation
Scale 1:100

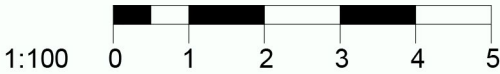

-	-	-	-
Rev.	Description:	By	Date
Client:	Peter Stuart Anderson	Drawn By:	JP
Title:	As Built Elevation	Checked By:	-
Project:	11 Wiblin Mews, College Lane, Kentish Town, London	Scale:	1:100@A3
		Date:	17 Oct 2018
Job No:	4672(18)	Dwg No:	S44
		Revision:	-

**Proctor Watts Cole Rutter**
Chartered Architects & Town Planners
Grosvenor House, Bleke Street, Shaftesbury, Dorset, SP7 8AW.
Phone: 01747 851881 Fax: 01747 851081
mail@pwcr.co.uk www.pwcr.co.uk