




AS-INSTALLED FRONT ELEVATION

Scale 1:50

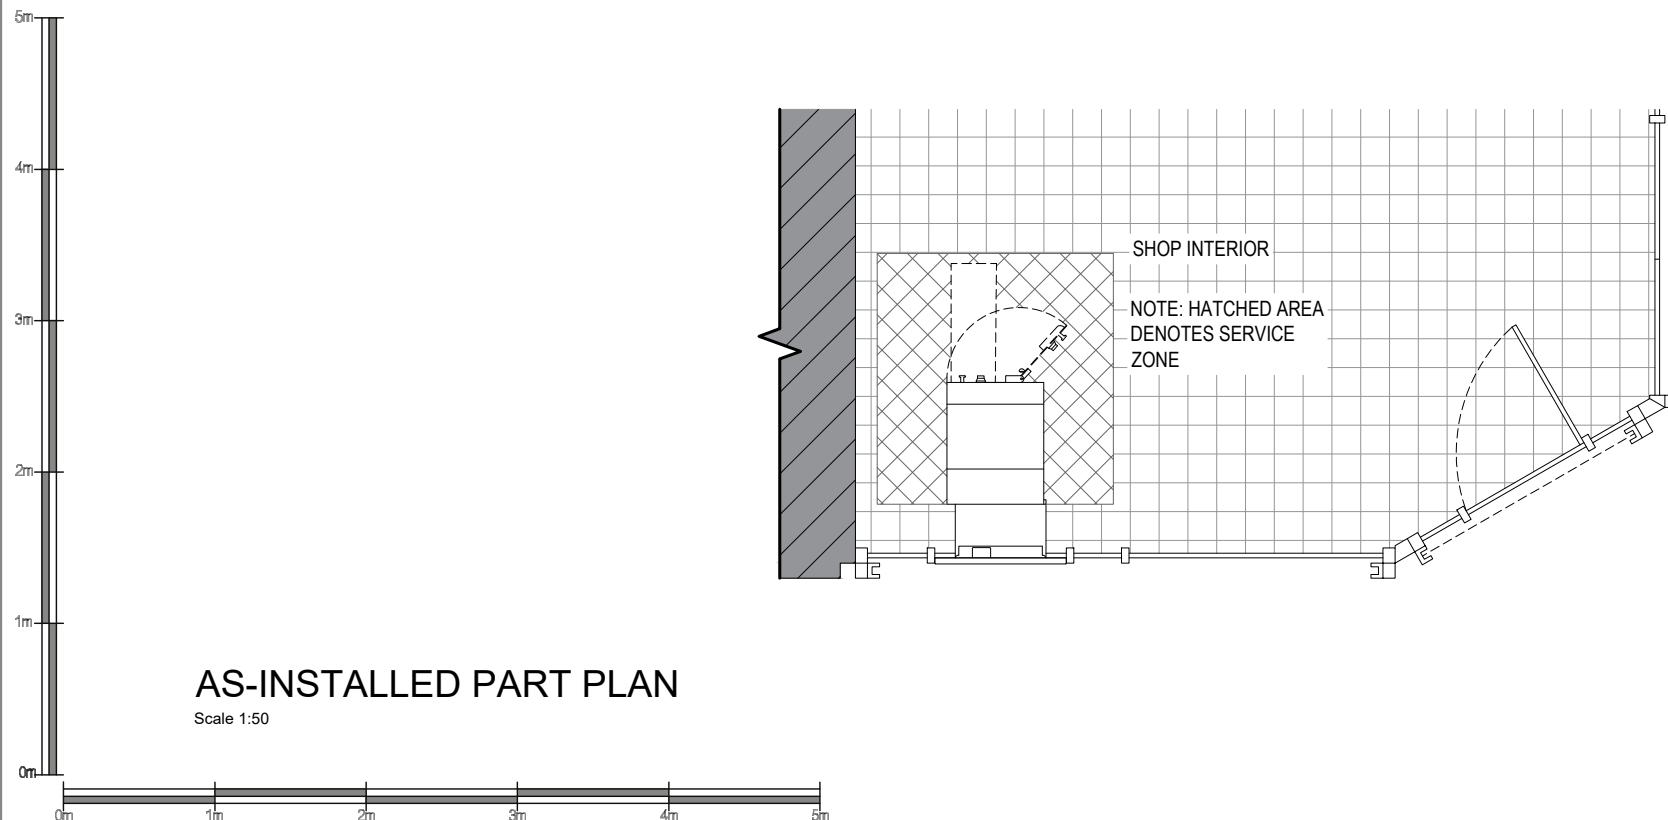

AS-INSTALLED PART PLAN

Scale 1:50

Date: _____ Comments: _____ By: _____

GENERAL NOTES:
1) All dimensions in millimeters unless otherwise stated.

Site:
Costcutter,
305 Finchley Road,
London

Drawing Title:
As-Installed Plan and Elevation

| | | |
|----------------|---------------------|-----------|
| Ref: | Date: 18/12/2018 | Rev: |
| Scale: 1:50 | Paper: A3 | Date Rev: |