

LONDON BOROUGH OF CAMDEN
TOWN AND COUNTRY PLANNING ACTS
25 JAN 1983
PLANS APPROVED
~~NOT APPROVED~~
ON BEHALF OF THE COUNCIL

FIRST FLOOR.

SECOND FLOOR.


SCALE 1/4" = 1'-0"
DWG No. 135/2.
DATE - JUNE 1982.

(for info only)
CTP/H12/29/D

35161 +
HB3037

135-137, WHITFIELD STREET, W.1.

HARMAN HEALY & CO.
SURVEYORS,
14, ROGER STREET,
LONDON, W.C.1.

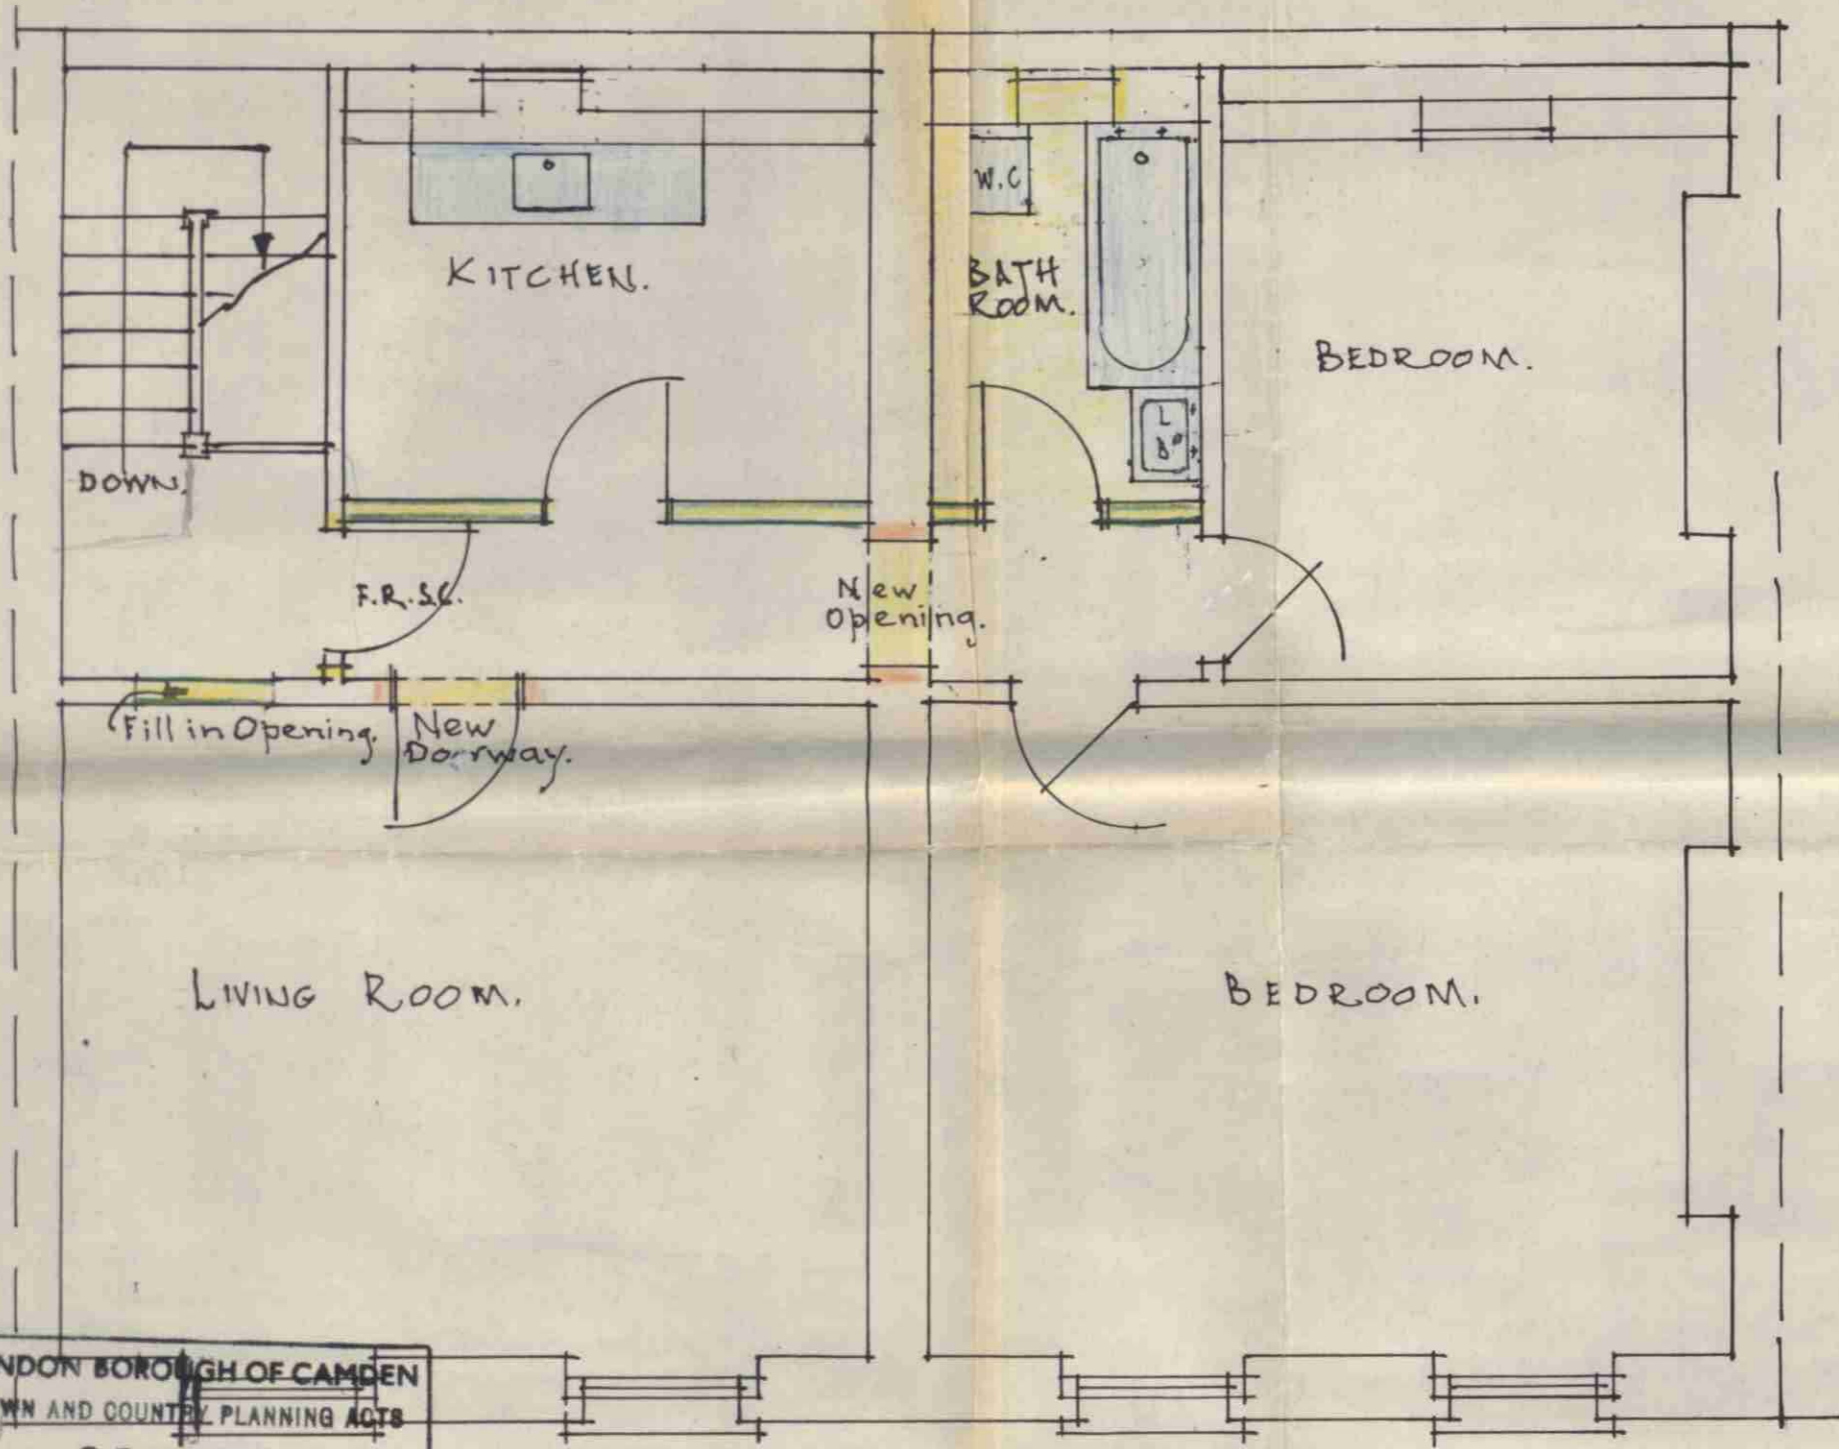


LONDON BOROUGH OF CAMDEN
 TOWN AND COUNCIL PLANNING ACTS
 25 JAN 1983
 PLANS APPROVED
 NOT APPROVED
 ON BEHALF OF THE COUNCIL

135

137

THIRD FLOOR - PROPOSED.

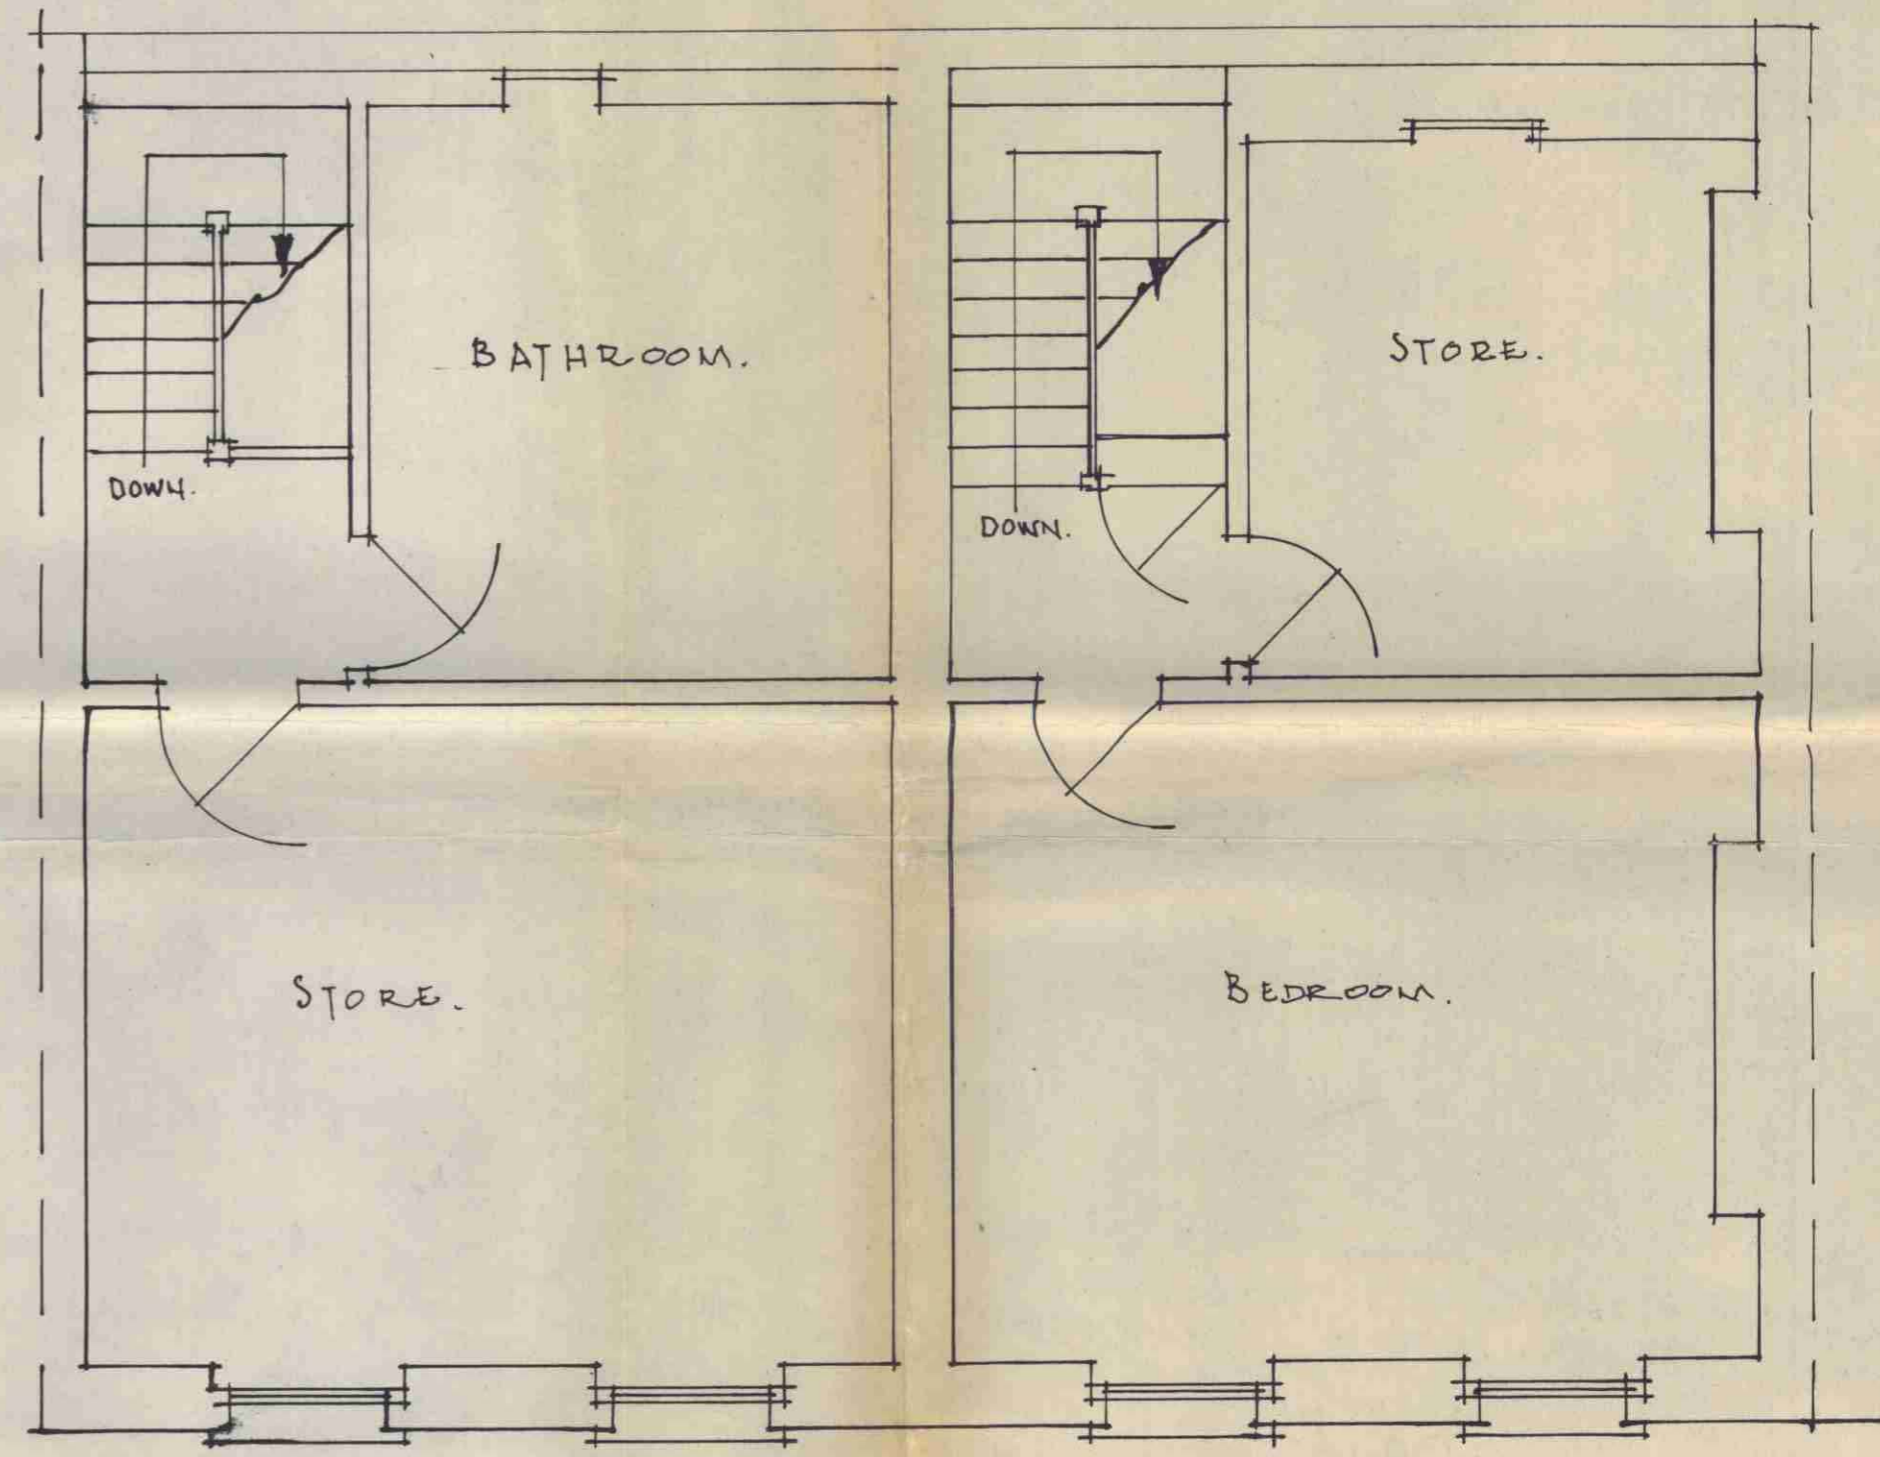

135

137



THIRD FLOOR - EXISTING.

CTP/M12/29/D /35161 +
 HB3037

SCALE 1/4" = 1'-0"
 DWG NO. 135/1 a.
 DATE - JUNE 1982.

135 - 137, WHITFIELD STREET, W.1.
 PROPOSED SELF-CONTAINED FLAT CONVERSION.

HARMAN HEALY & CO.
 SURVEYORS,
 14 ROGER STREET,
 LONDON, W.C.1.

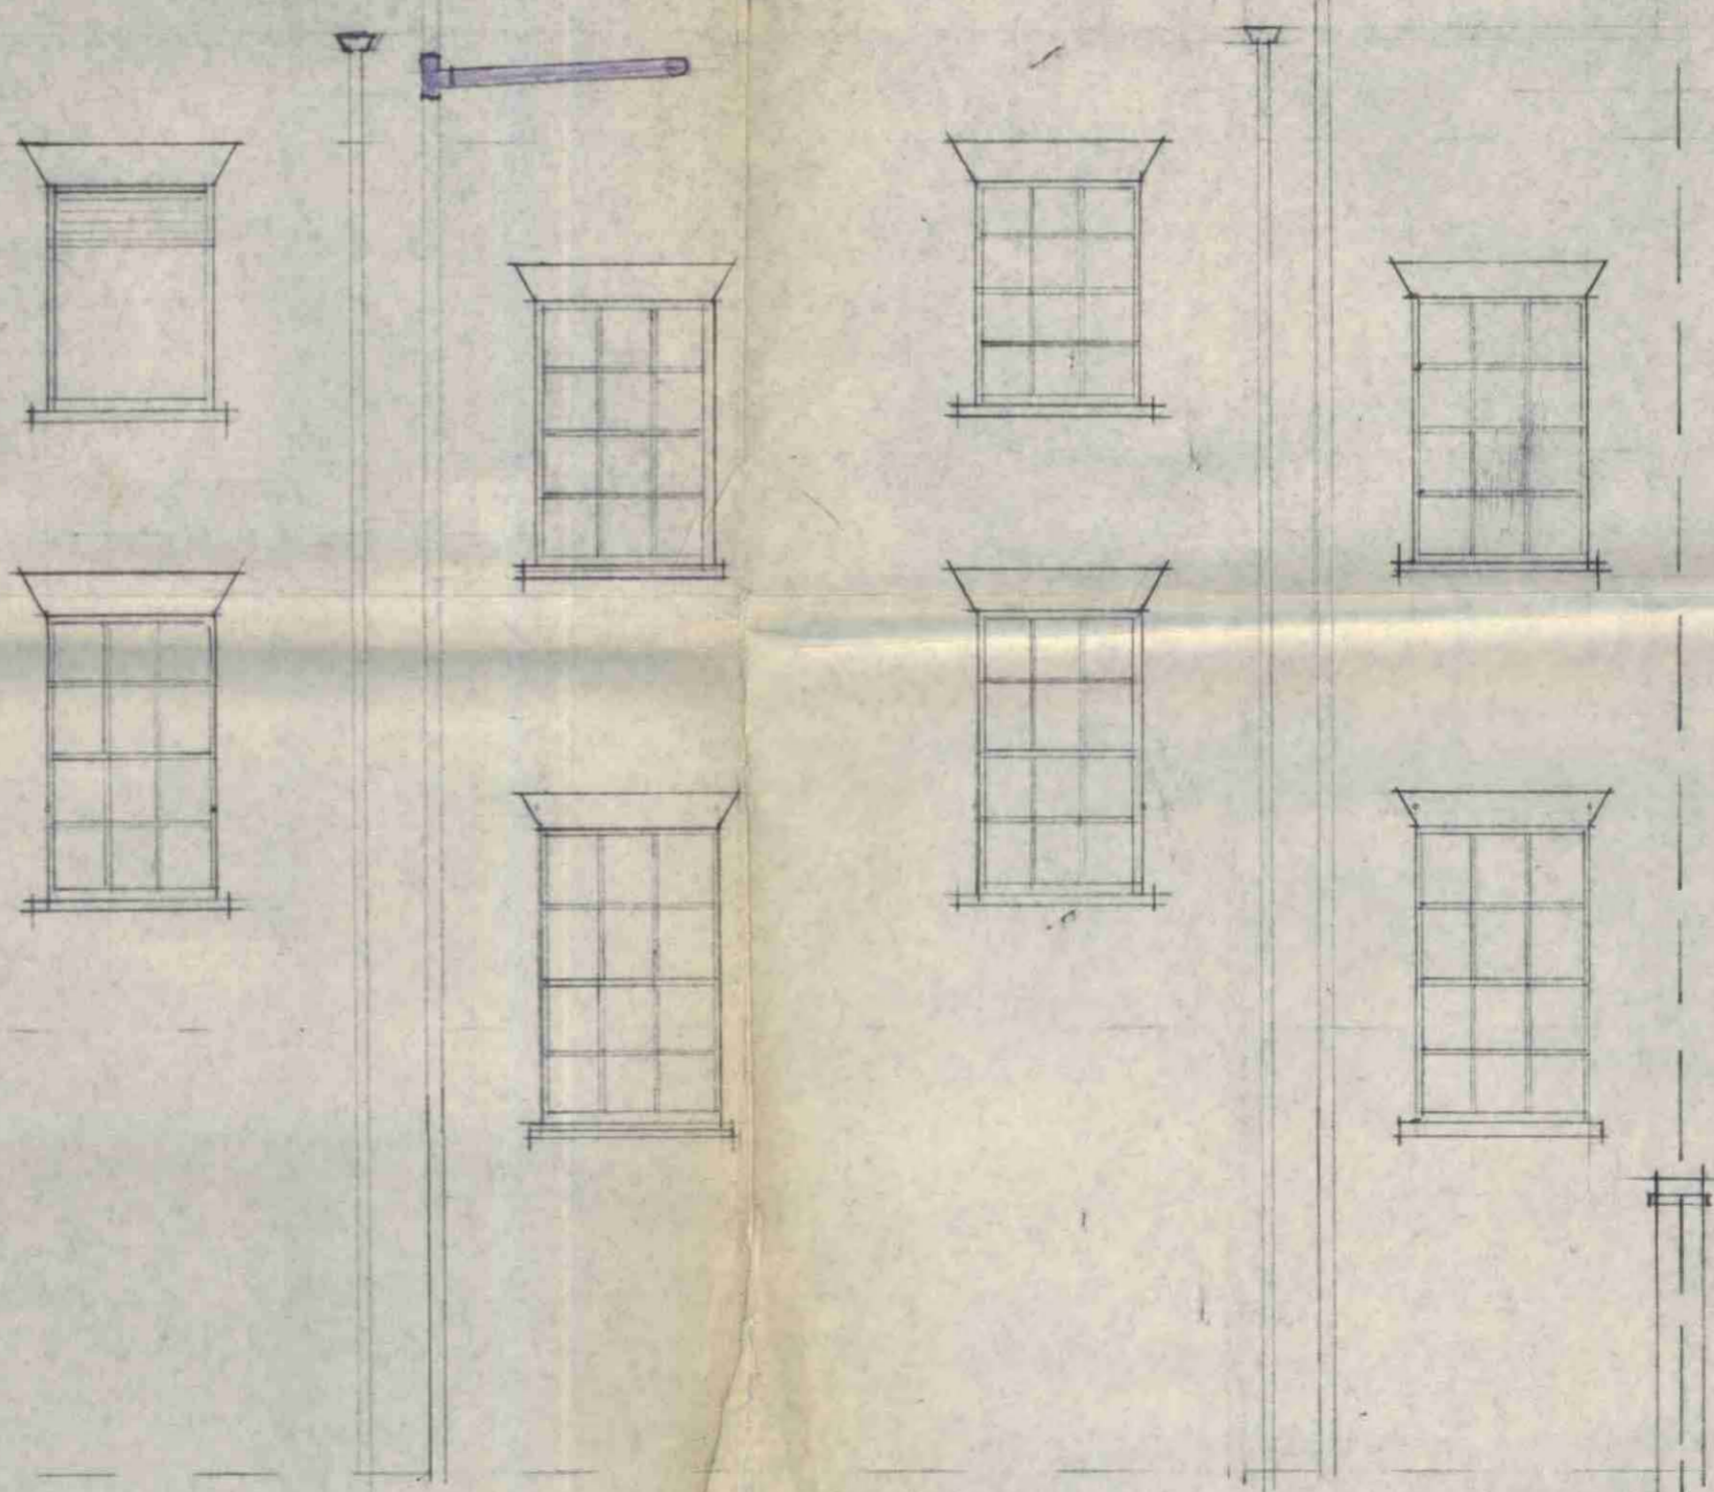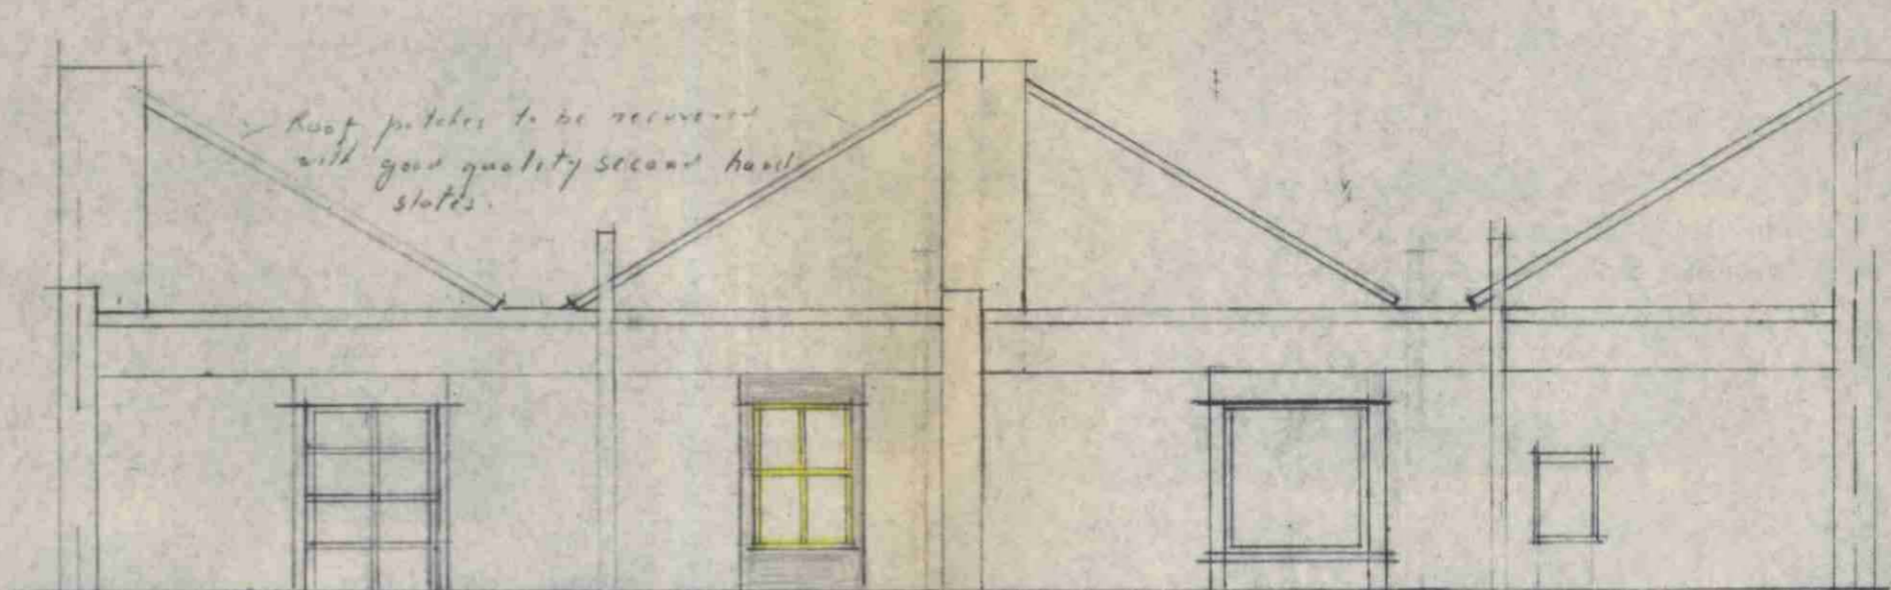

LONDON BOROUGH OF CAMDEN
 TOWN AND COUNTRY PLANNING ACTS
 25 JAN 1983
 APPROVED
 PLANS ~~NOT APPROVED~~
 ON BEHALF OF THE COUNCIL

137
 READ
 135
 ELEVATION

3037(H)
 CTP/M12/29/D / HB3005(K)

SCALE 1/4" - 1'-0"
 DWG NO. EL. 2.A
 DATE - SEPT. 1982.

135 - 137, WHITFIELD STREET, W. 1.

HARMAN HEALY & CO.
 SURVEYORS,
 14, ROGER STREET,
 LONDON, W.C.1.