


This drawing is indicative only and should be read with all other drawings, specifications and related information.

NOTES:

Legend

- - DRINKING WATER FOUNTAIN
- - EXTERNAL BIBTAP
- MANHOLE ACCESS
- - GAS PIPE SERVICES
- - MWS PIPE SERVICES
- - BCWS DRINKING WATER PIPE SERVICES
- - CAT5 WATER PIPE SERVICES

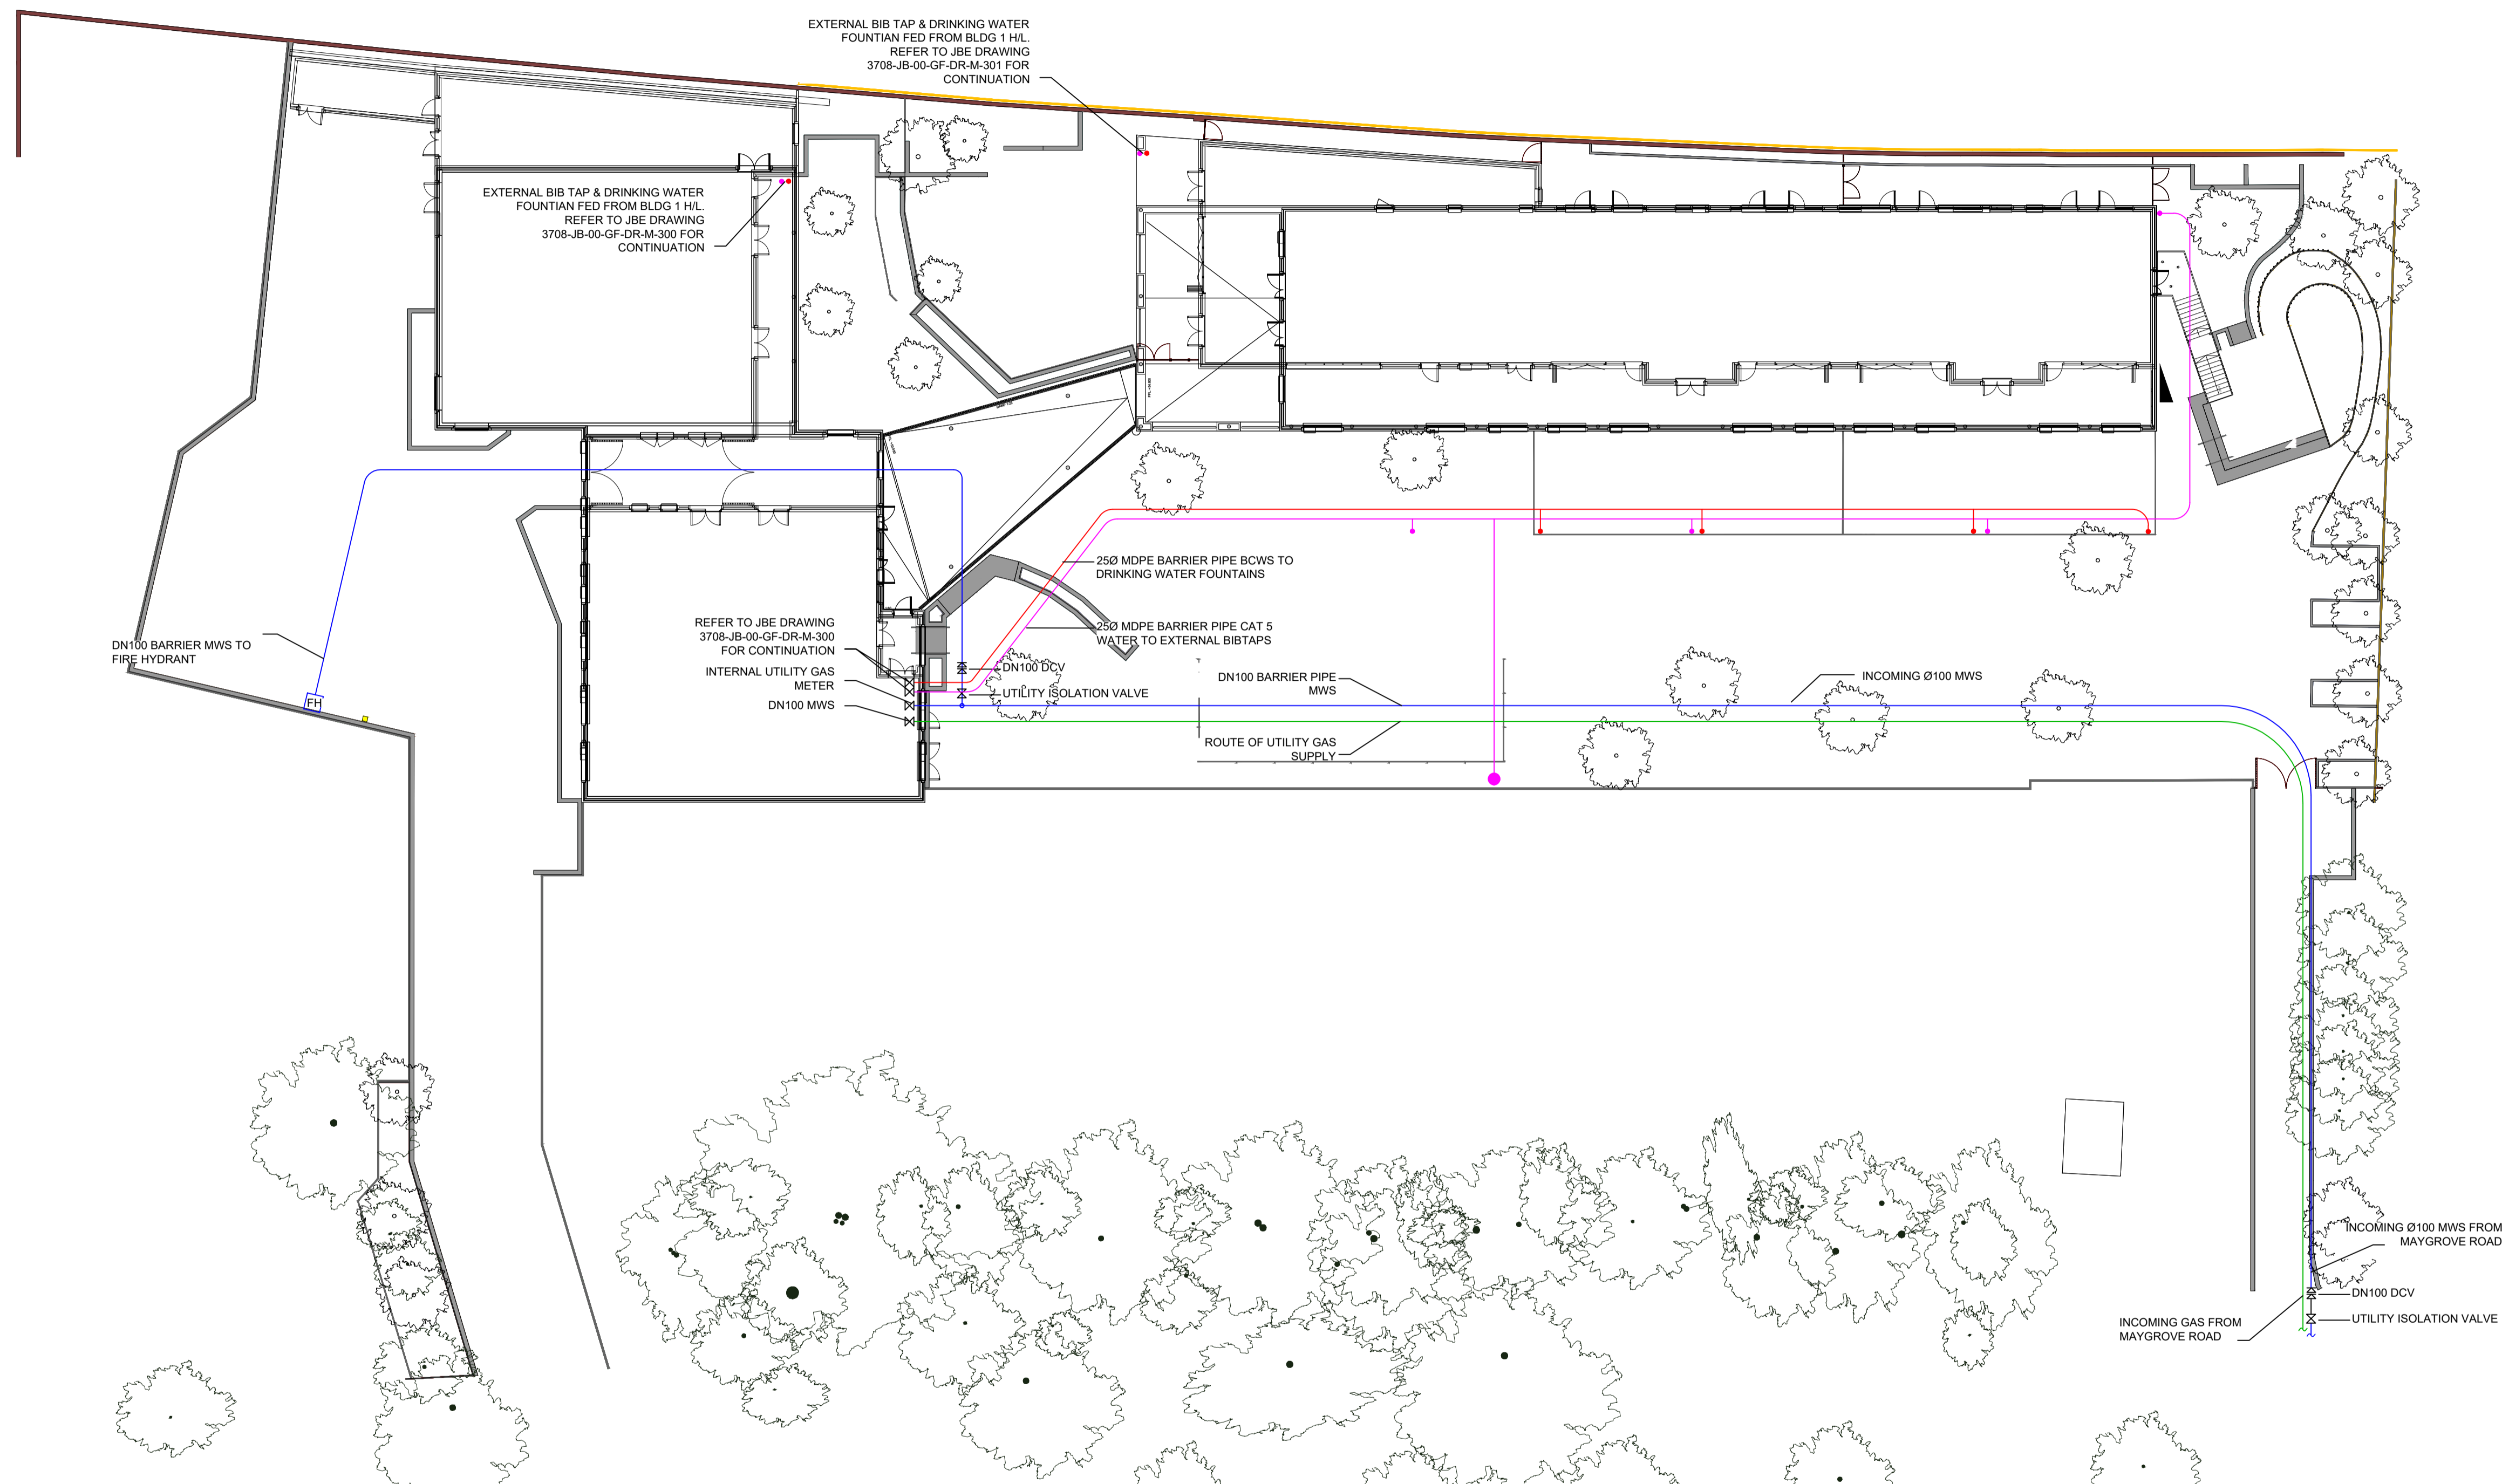

Site - External Services

1 : 250

REV	DESCRIPTION	DATE	DRN	CHK	APP

Building layout for JBE as built drawing based on MacCreanor Lavington Architects' drawing no: N/A

CLIENT:  
**London Borough of Camden**  
**5 Pancras Square London**  
**N1C 4AG**


PROJECT:  
**Kingsgate Primary School**  
**Liddell Road**  
**London NW6**

TITLE:  
**School Buildings 1&2**  
**External Mechanical Site**  
**Services**

SCALE:	SIZE:	DRAWN:	CHECKED:	APP:	DATE:
1:250	A1	MD	TC	CS	15/11/17

STATUS	JBE NO:	DRAWING NO:	REV:
AB	C1400	3708-JB-00-XX-DR-E-281	

DRAWING TYPE: AS BUILT



**Mechanical · Electrical Limited**

Project Contract Managers  
 E: Tom.Caulfield@jbe.com  
 E: Chris.Brown@jbe.com

**Head Office**  
 Lymont House  
 Braid River Business Park  
 105 Railway Street  
 Ballymena  
 BT42 2AF  
 T: +44 (0) 28 2565 8522

**Scotland Office**  
 Unit 10a  
 Grangemouth Centre  
 3 Roseland Hall  
 Grangemouth  
 FK3 8WJ  
 T: +44 (0) 13 2447 1138  
 www.jbe.com