





1 Front Elevation with Awnings in Open Position
Scale: 1:50




2 Front Elevation with Awnings in Closed Position
Scale: 1:50

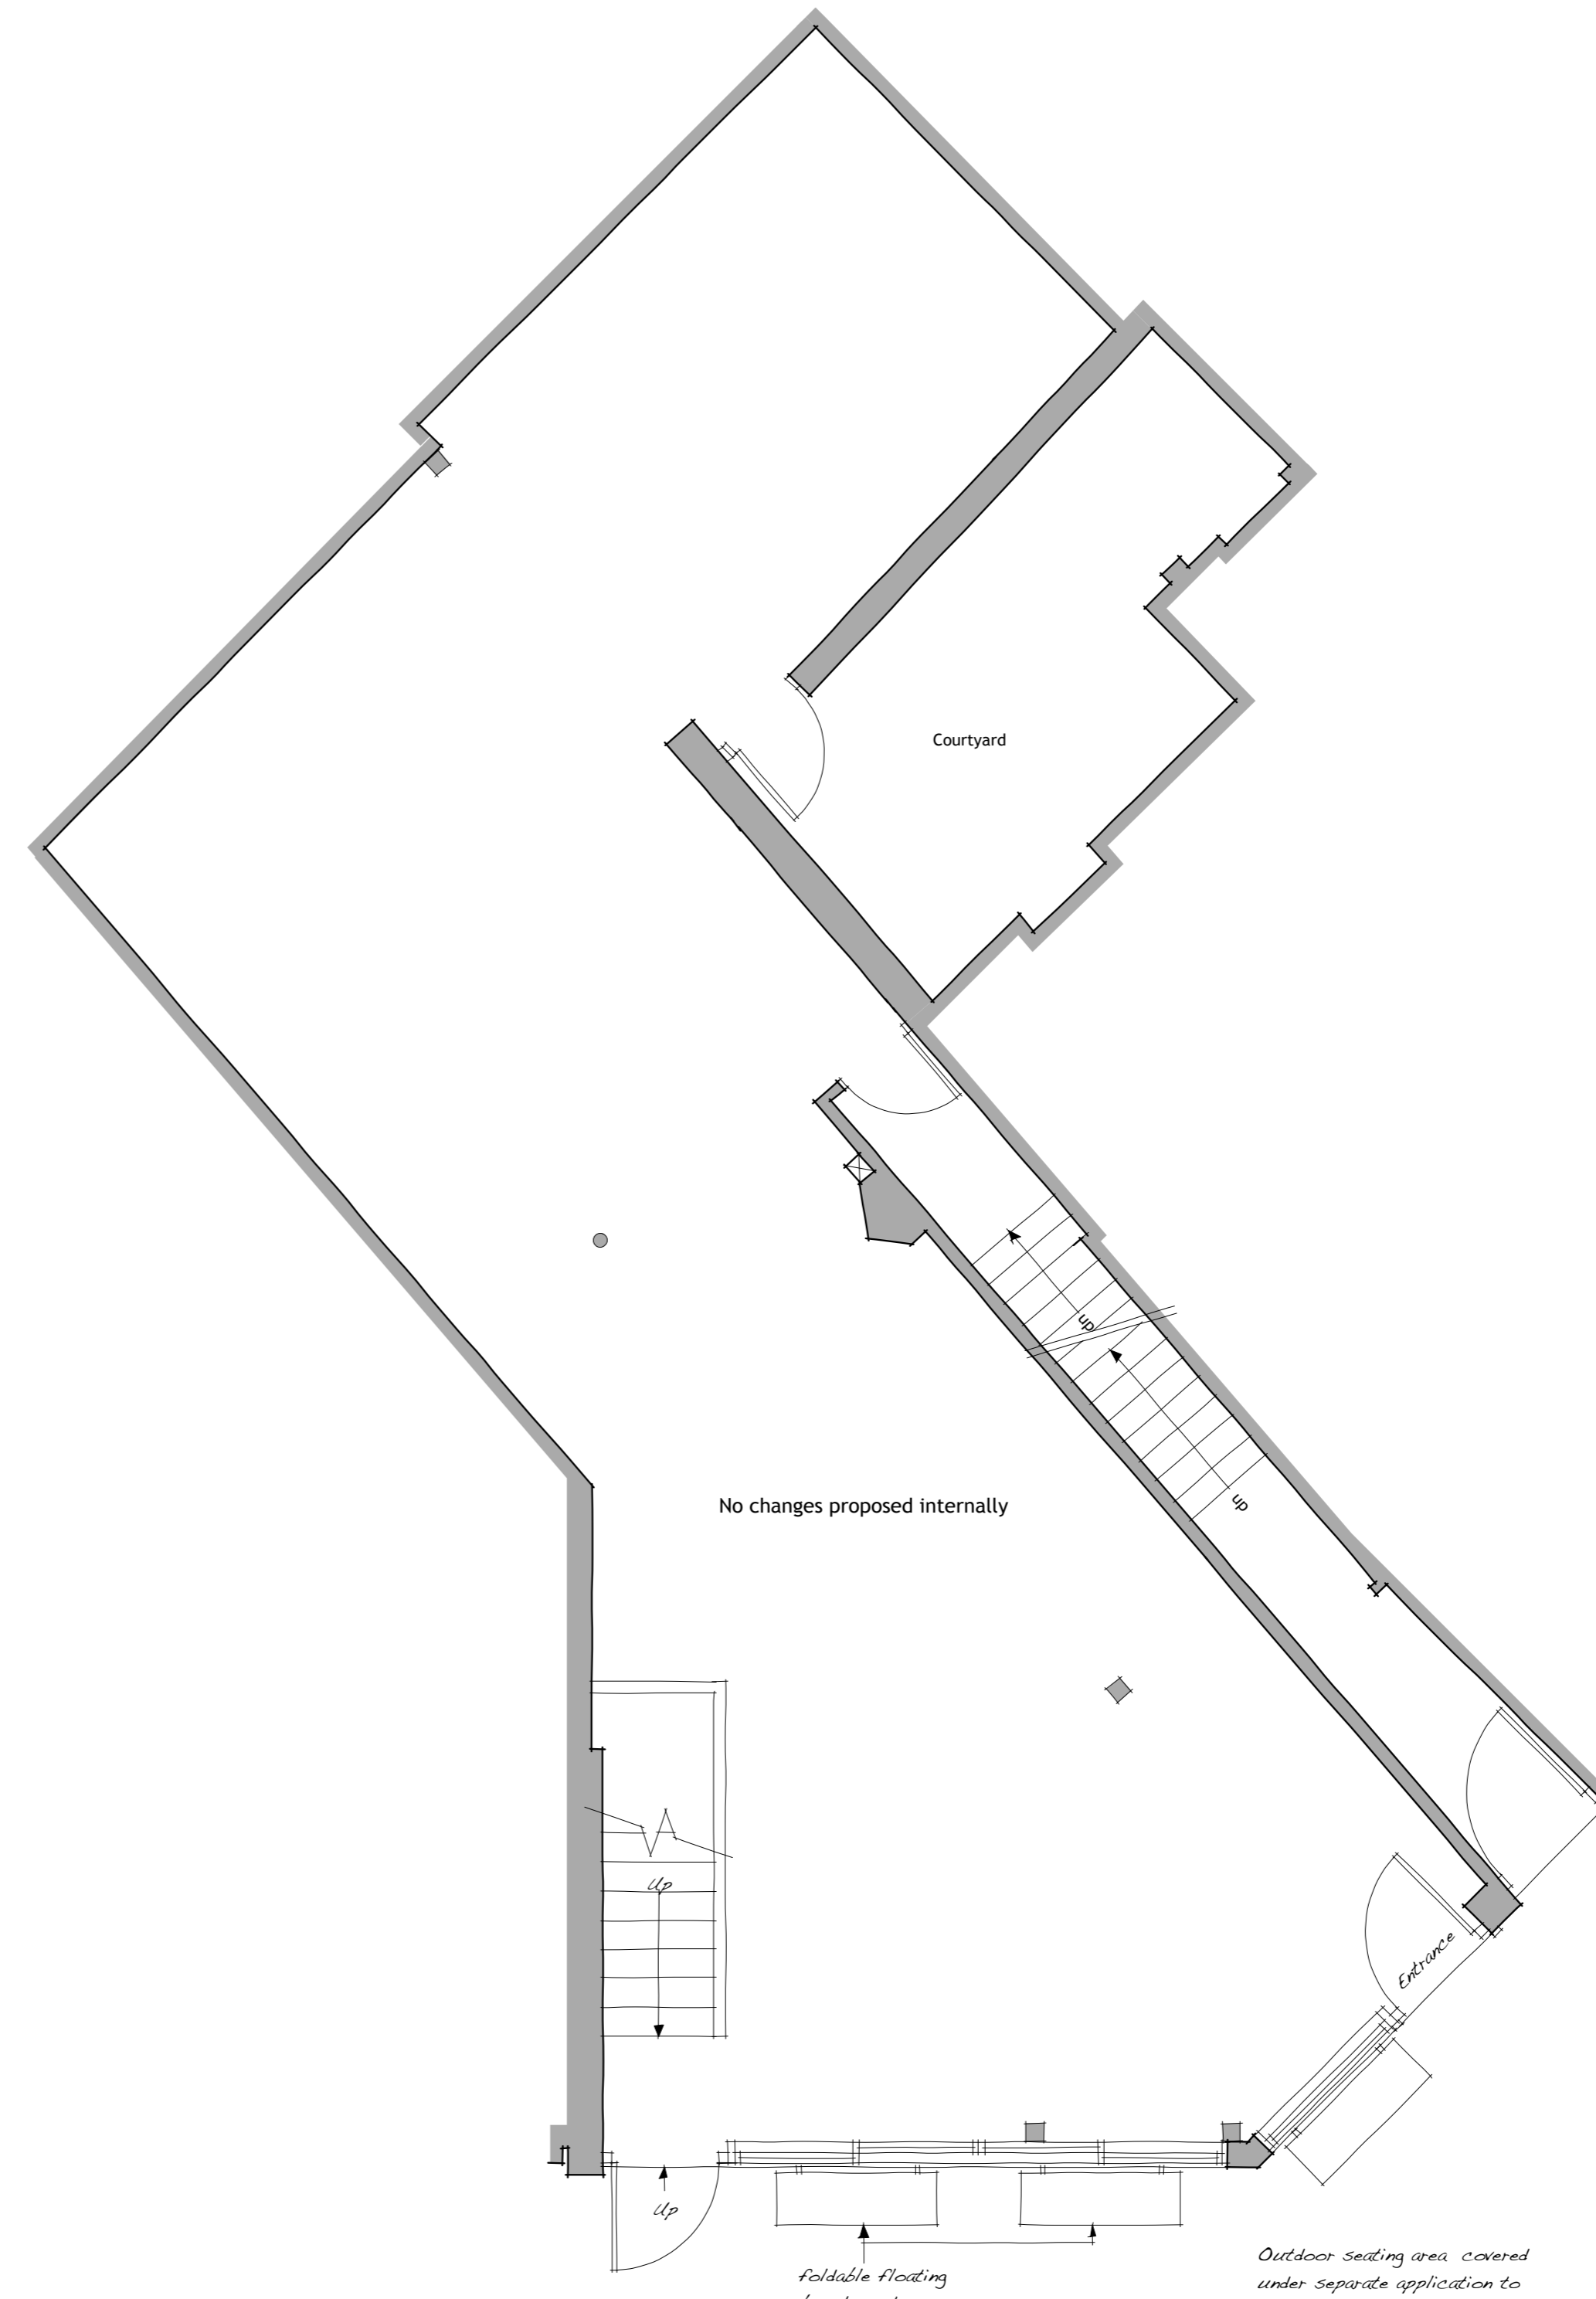


3 Ground Floor Plan (No Changes Proposed)
Scale: 1:50

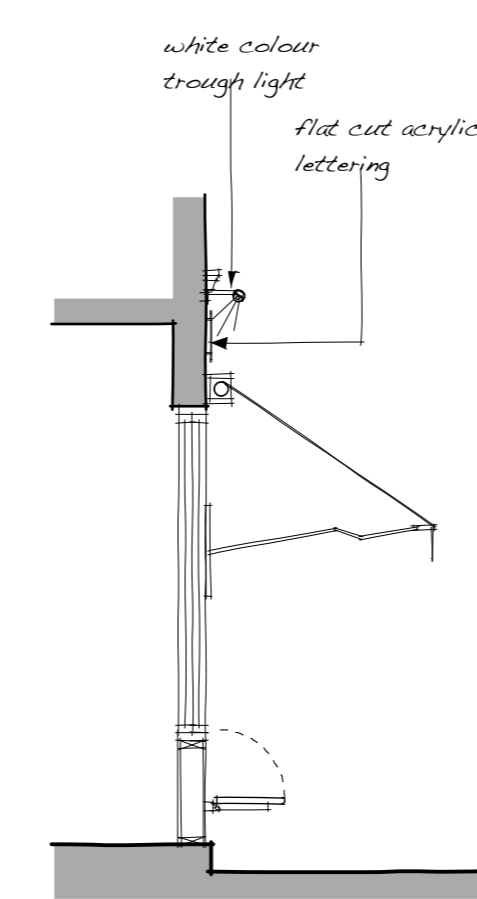


4 Section A-A
Scale: 1:50

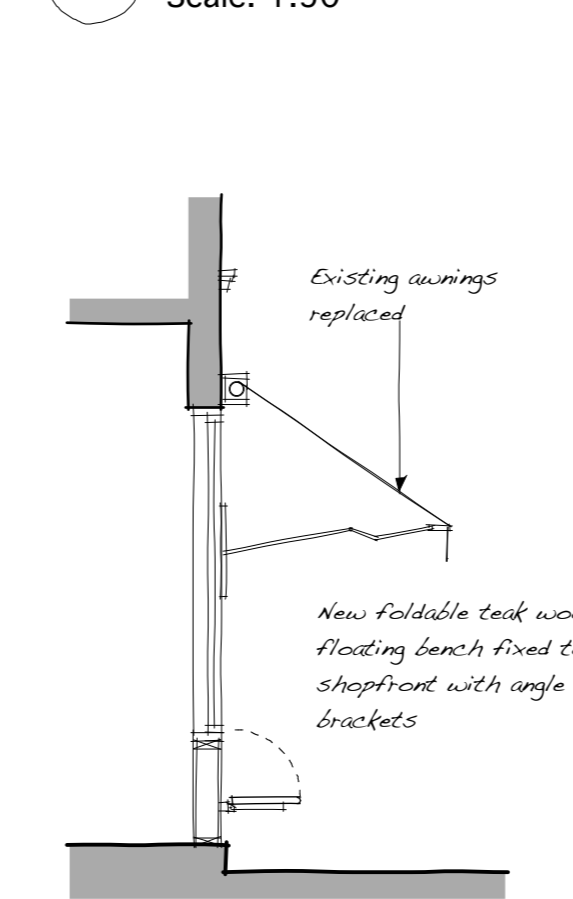

5 Section B-B
Scale: 1:50

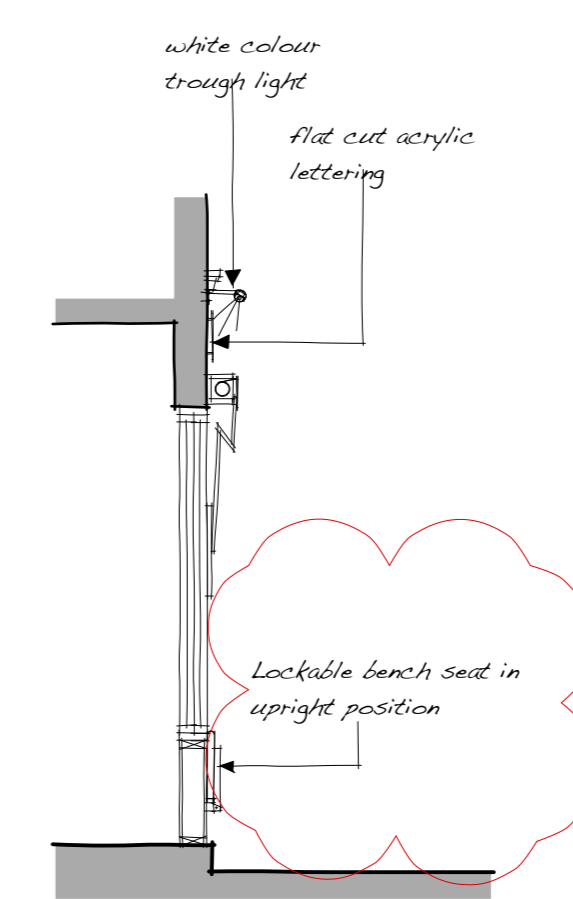


6 Scale: 1:50
Section A'-A'

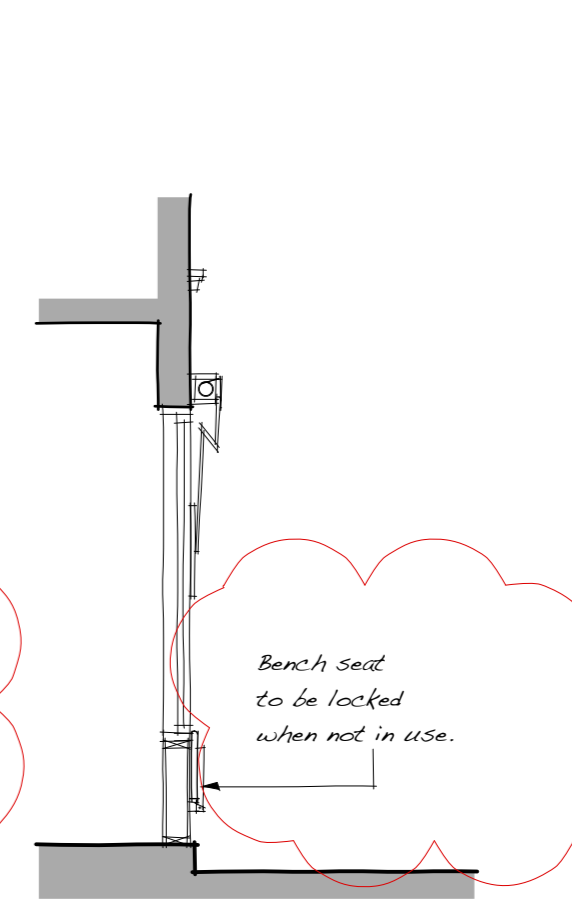

7 Section B'-B'
Scale: 1:50



C	Jan19	New notes added. (See in red cloud)
B	Jan19	Permanent ramp removed.
A	Aug18	Elevation, Section and Plan drawings added.
Rev	Date	Description

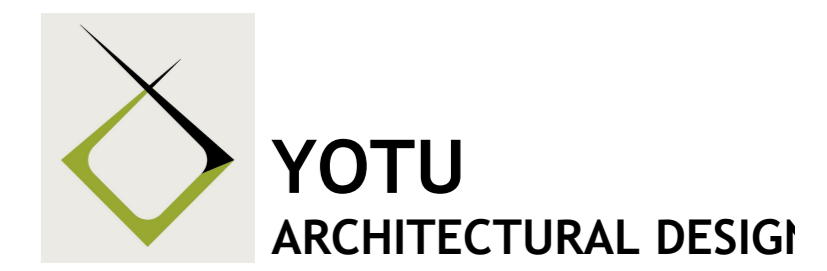

46 Furze Hill House, Furze Hill, Hove East Sussex
E-mail: info@yotu.co.uk Tel: 07880 902 127 - 0747

Client
Mr E C Saglik
Project
Beso
190 Shaftesbury Avenue
London WC2H 8JL

Drawing
Part As Built Part Proposed Plan, Elevation and Sect Drawings

Scale	Status	Date	Drawn	Chc
1:50 @ A1	Planning	Aug 2018	ot	y

Drawing No. Revision

078_P_04 C