




Existing Stair Section

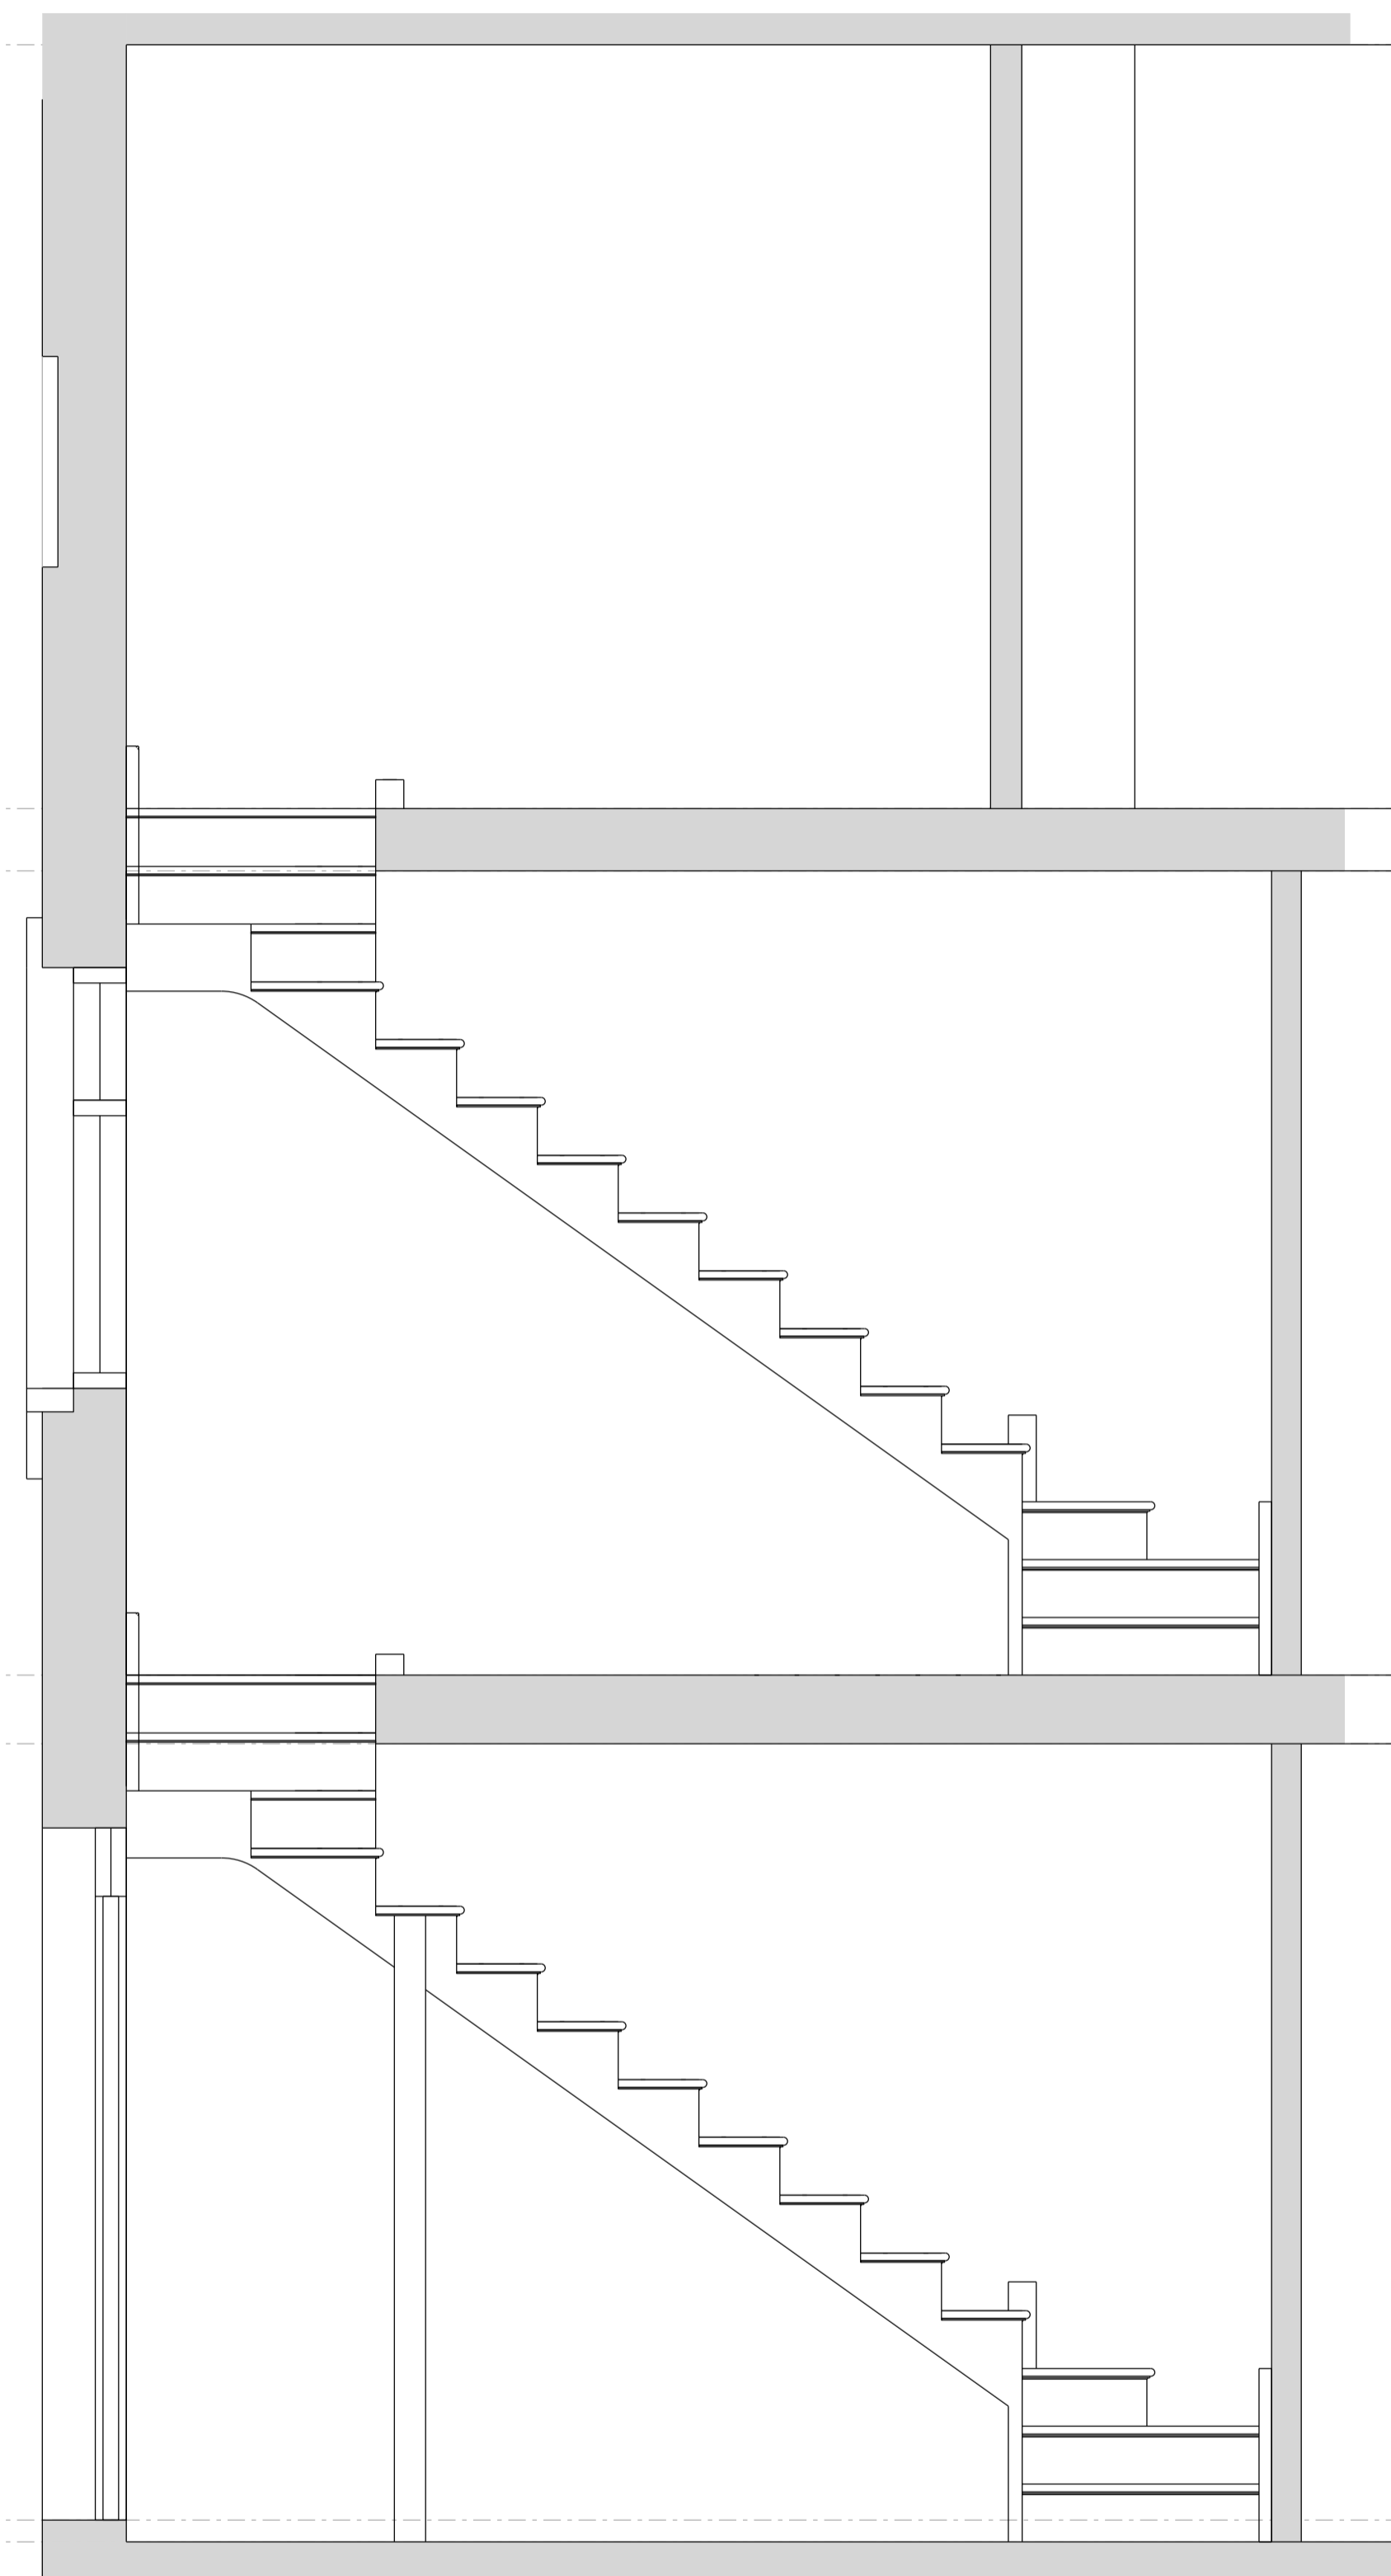

As Built Stair Section

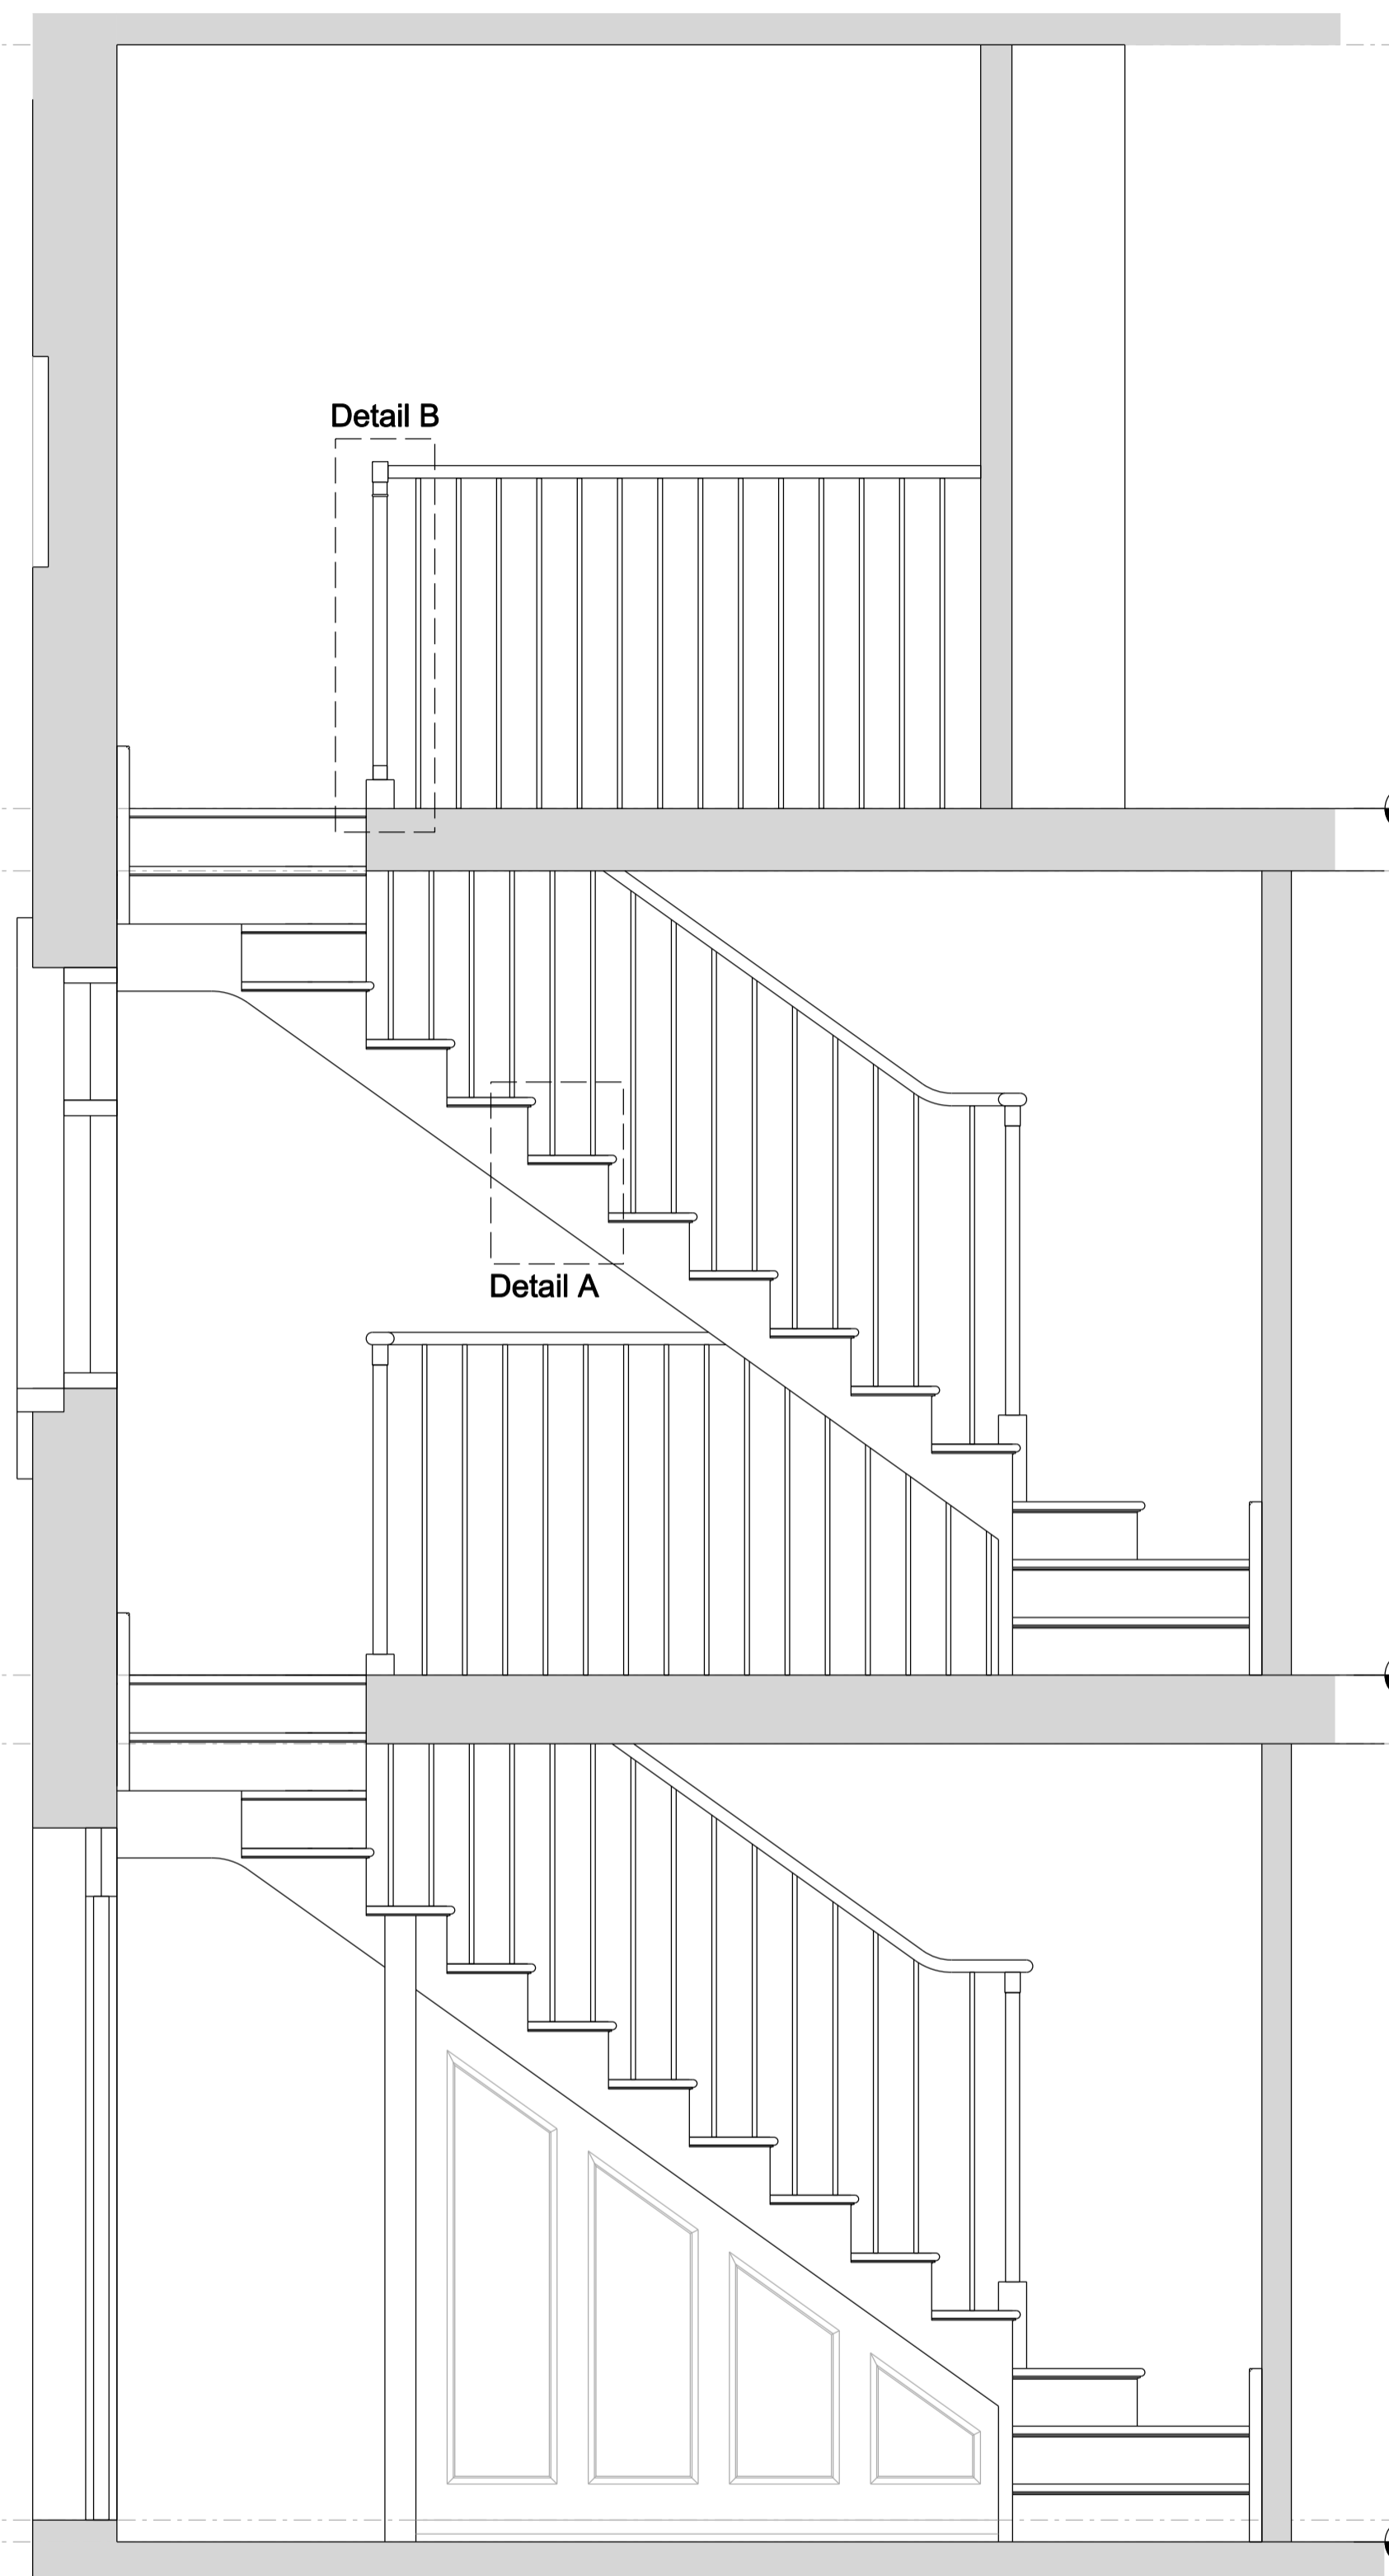

Proposed Stair Section

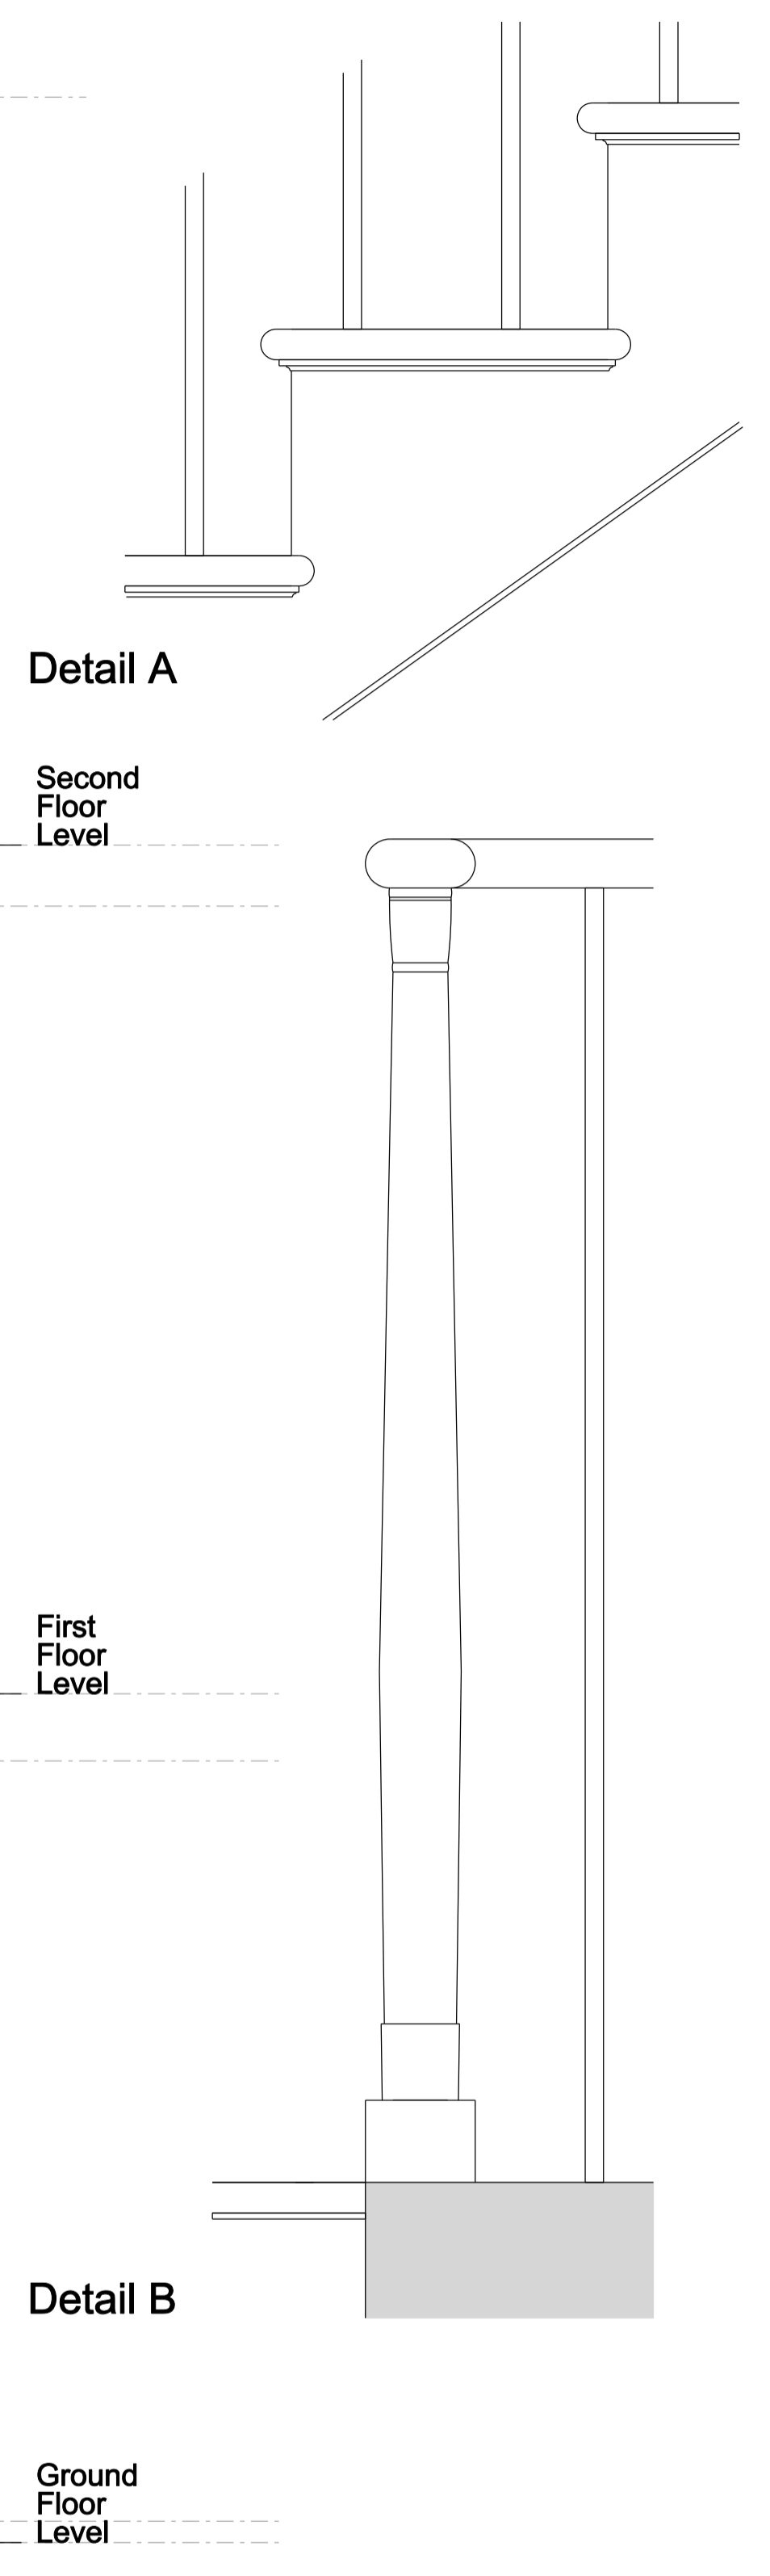

All planning drawings to be read in conjunction with Heritage Statement by Fuller Long.

**pa d**  
 independent architectural services  
 52 Bailey Road Leigh on Sea Essex SS9 3PJ M:07790 069188

Project: 68 Highgate Road London NW5 1PA  
 Client: Duah & Watson  
 Drawing title: Stair Sections & Detail

Scale 1: 20@A1 Drawn by PSA  
 Project number 18 301 Drawing number P1 09  
 Status: Planning & Listed Buildings Approval

All dimensions must be checked on site and not scaled from this drawing.