




Existing Ground Floor Plan

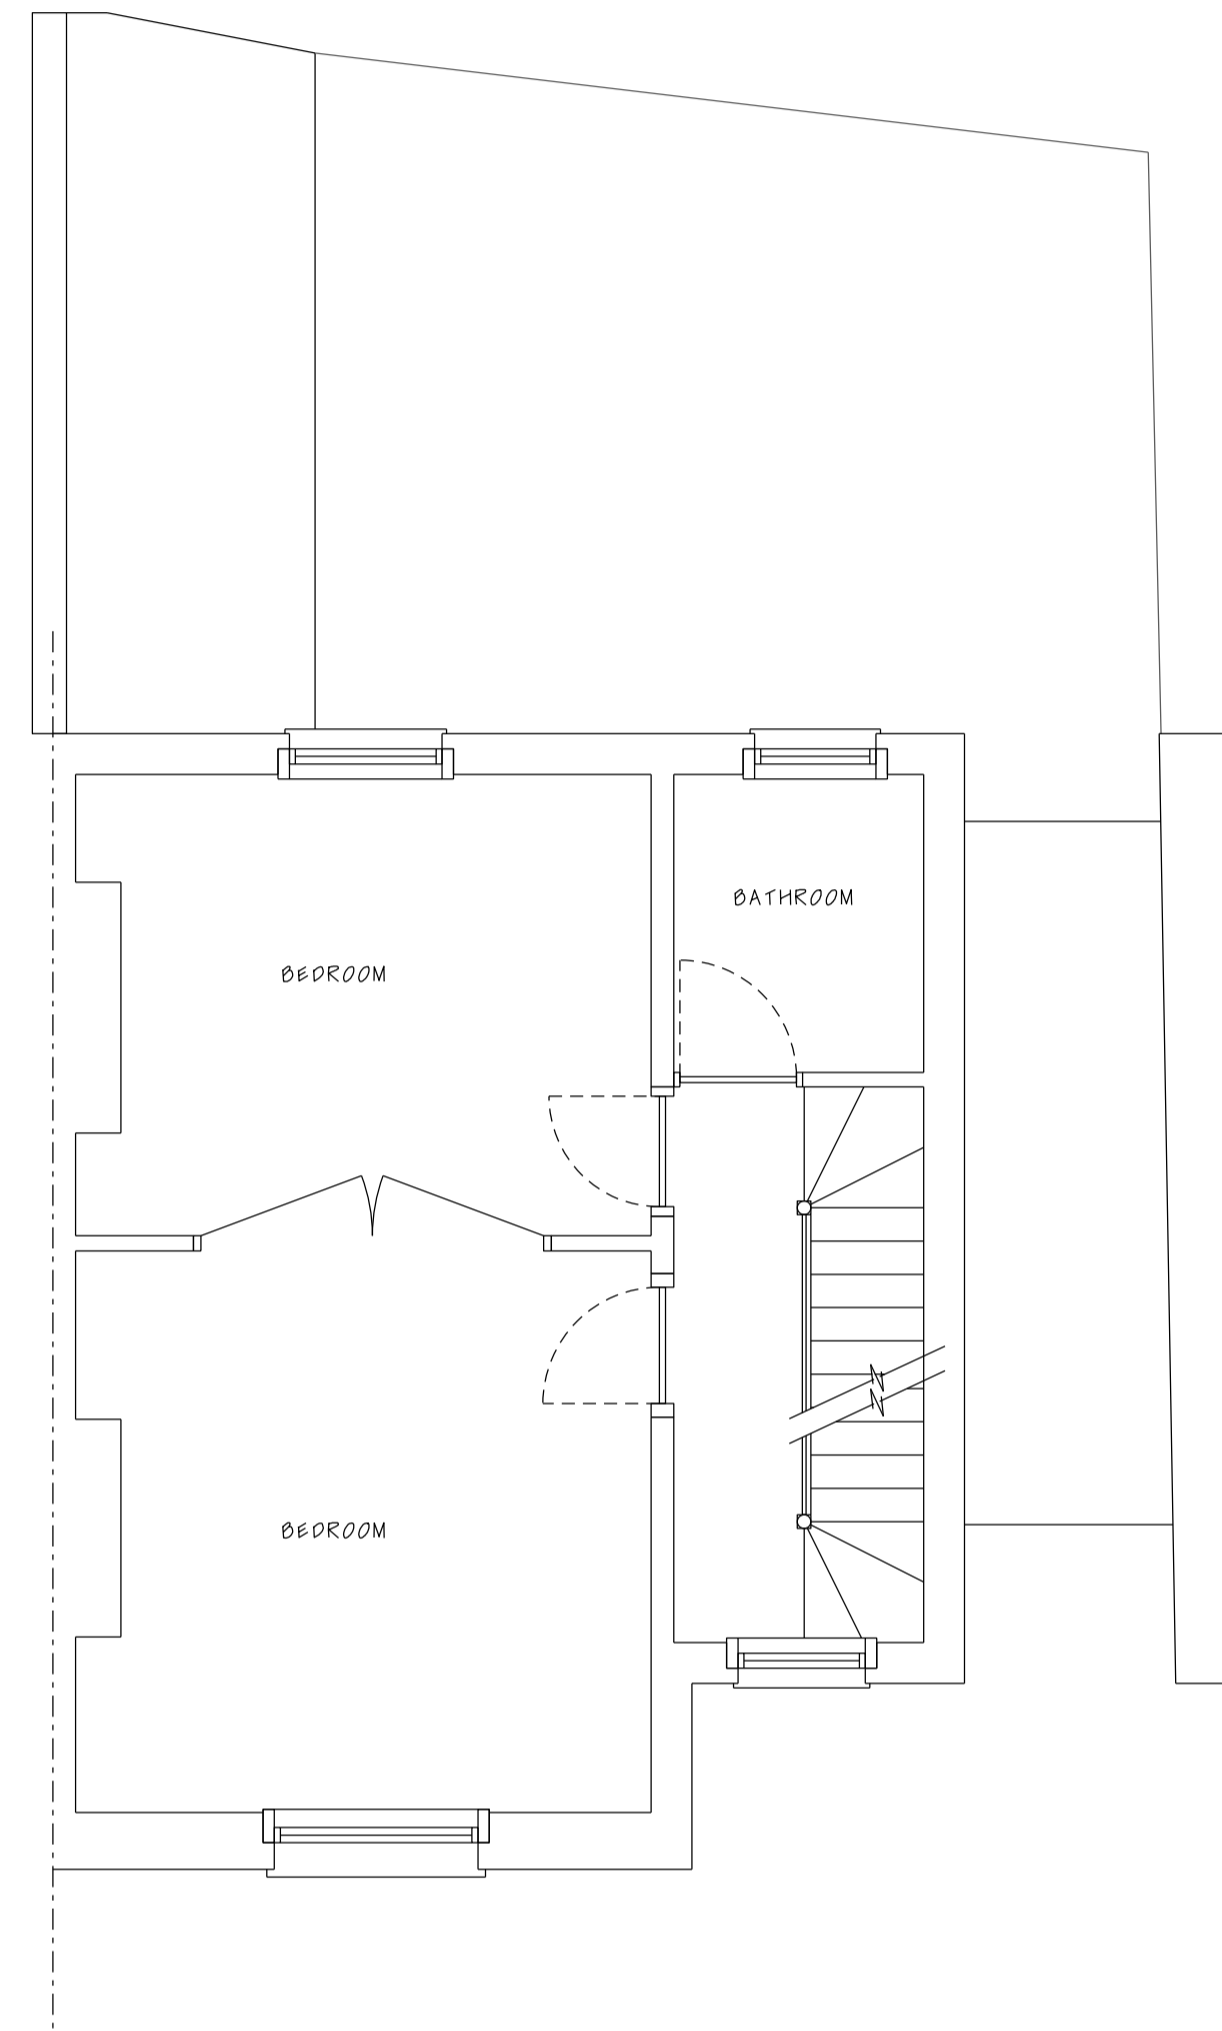

Existing First Floor Plan

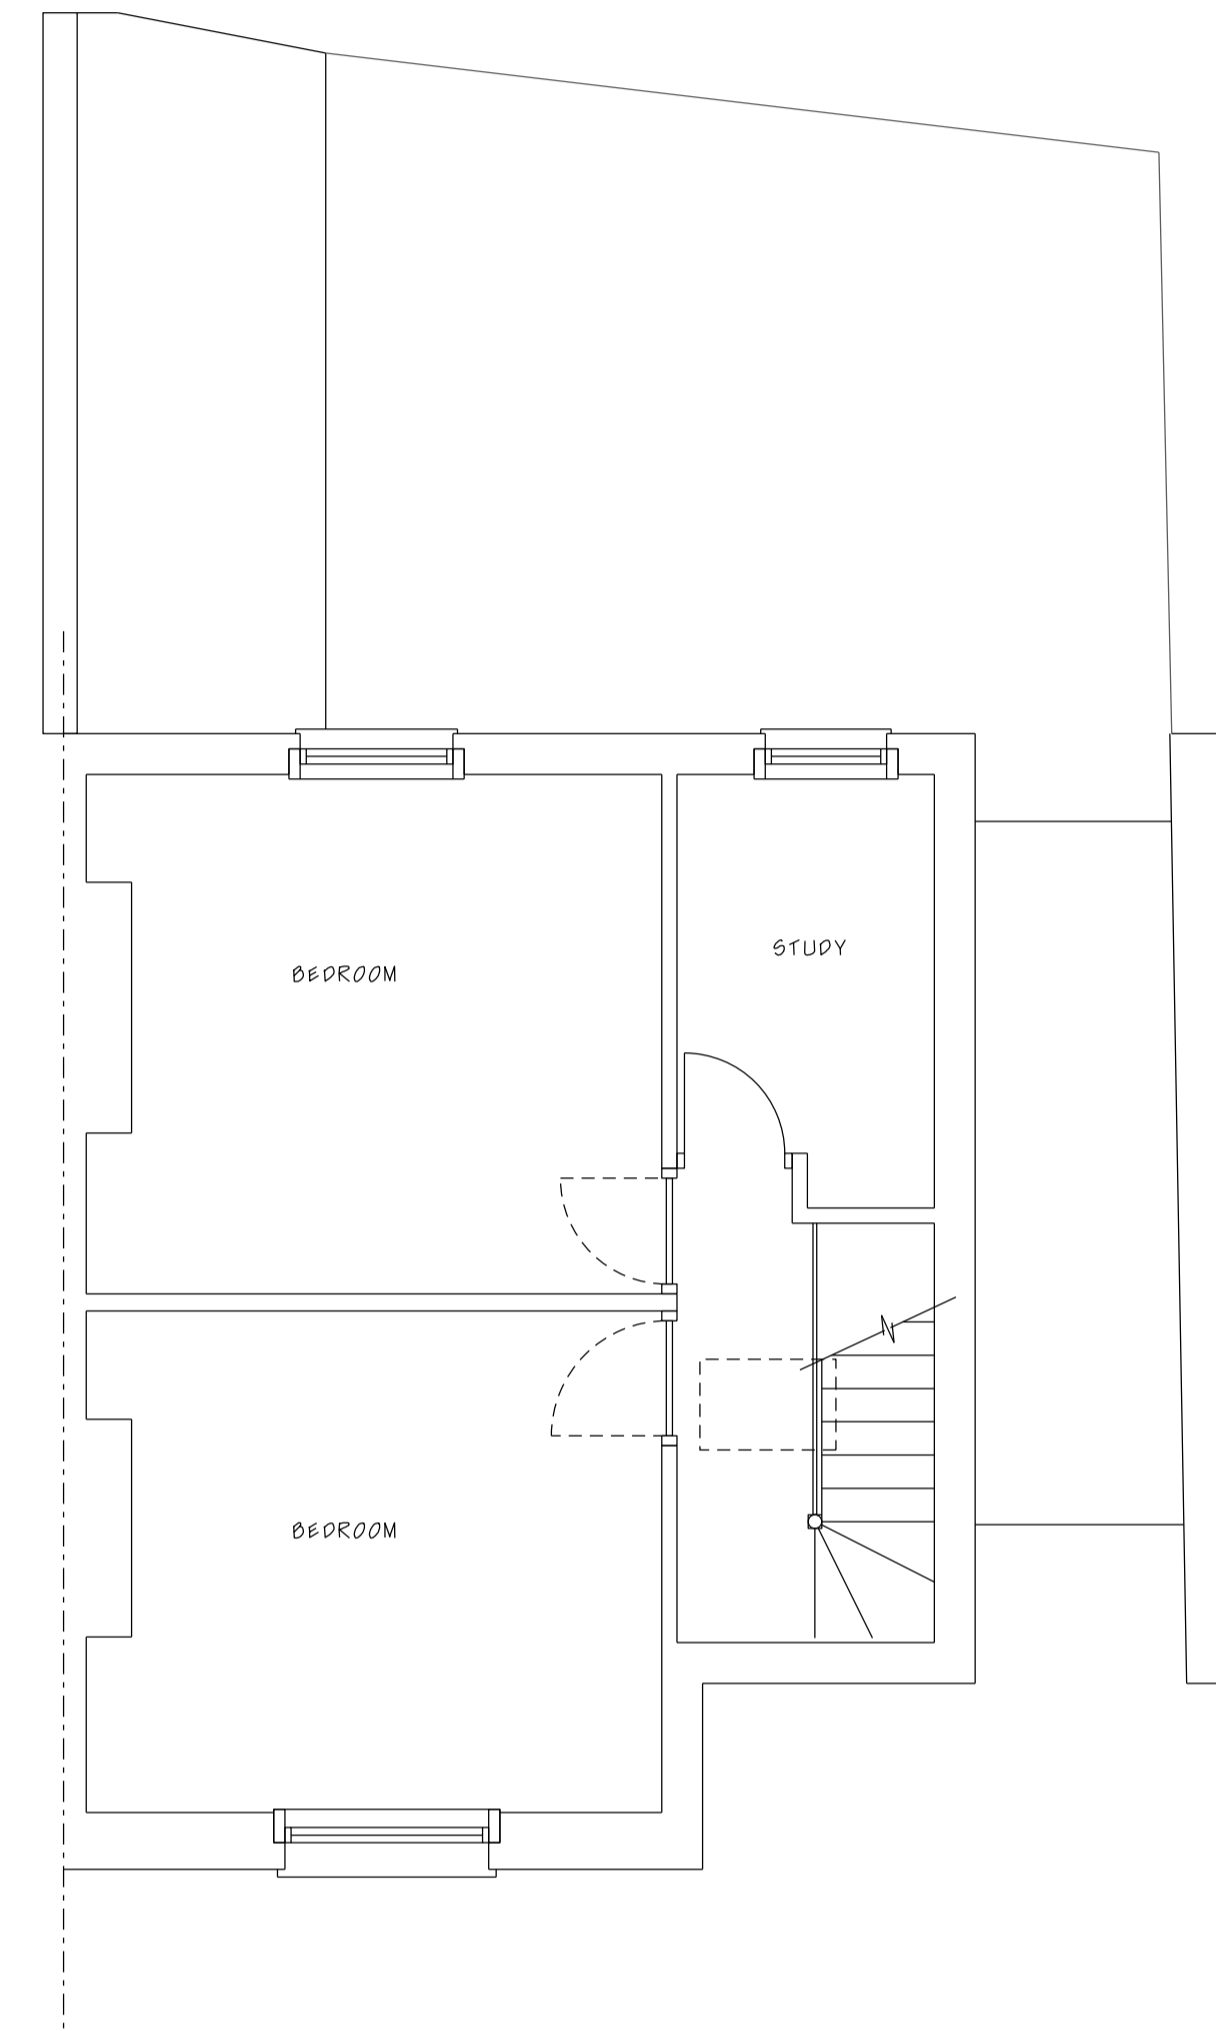

Existing Second Floor Plan

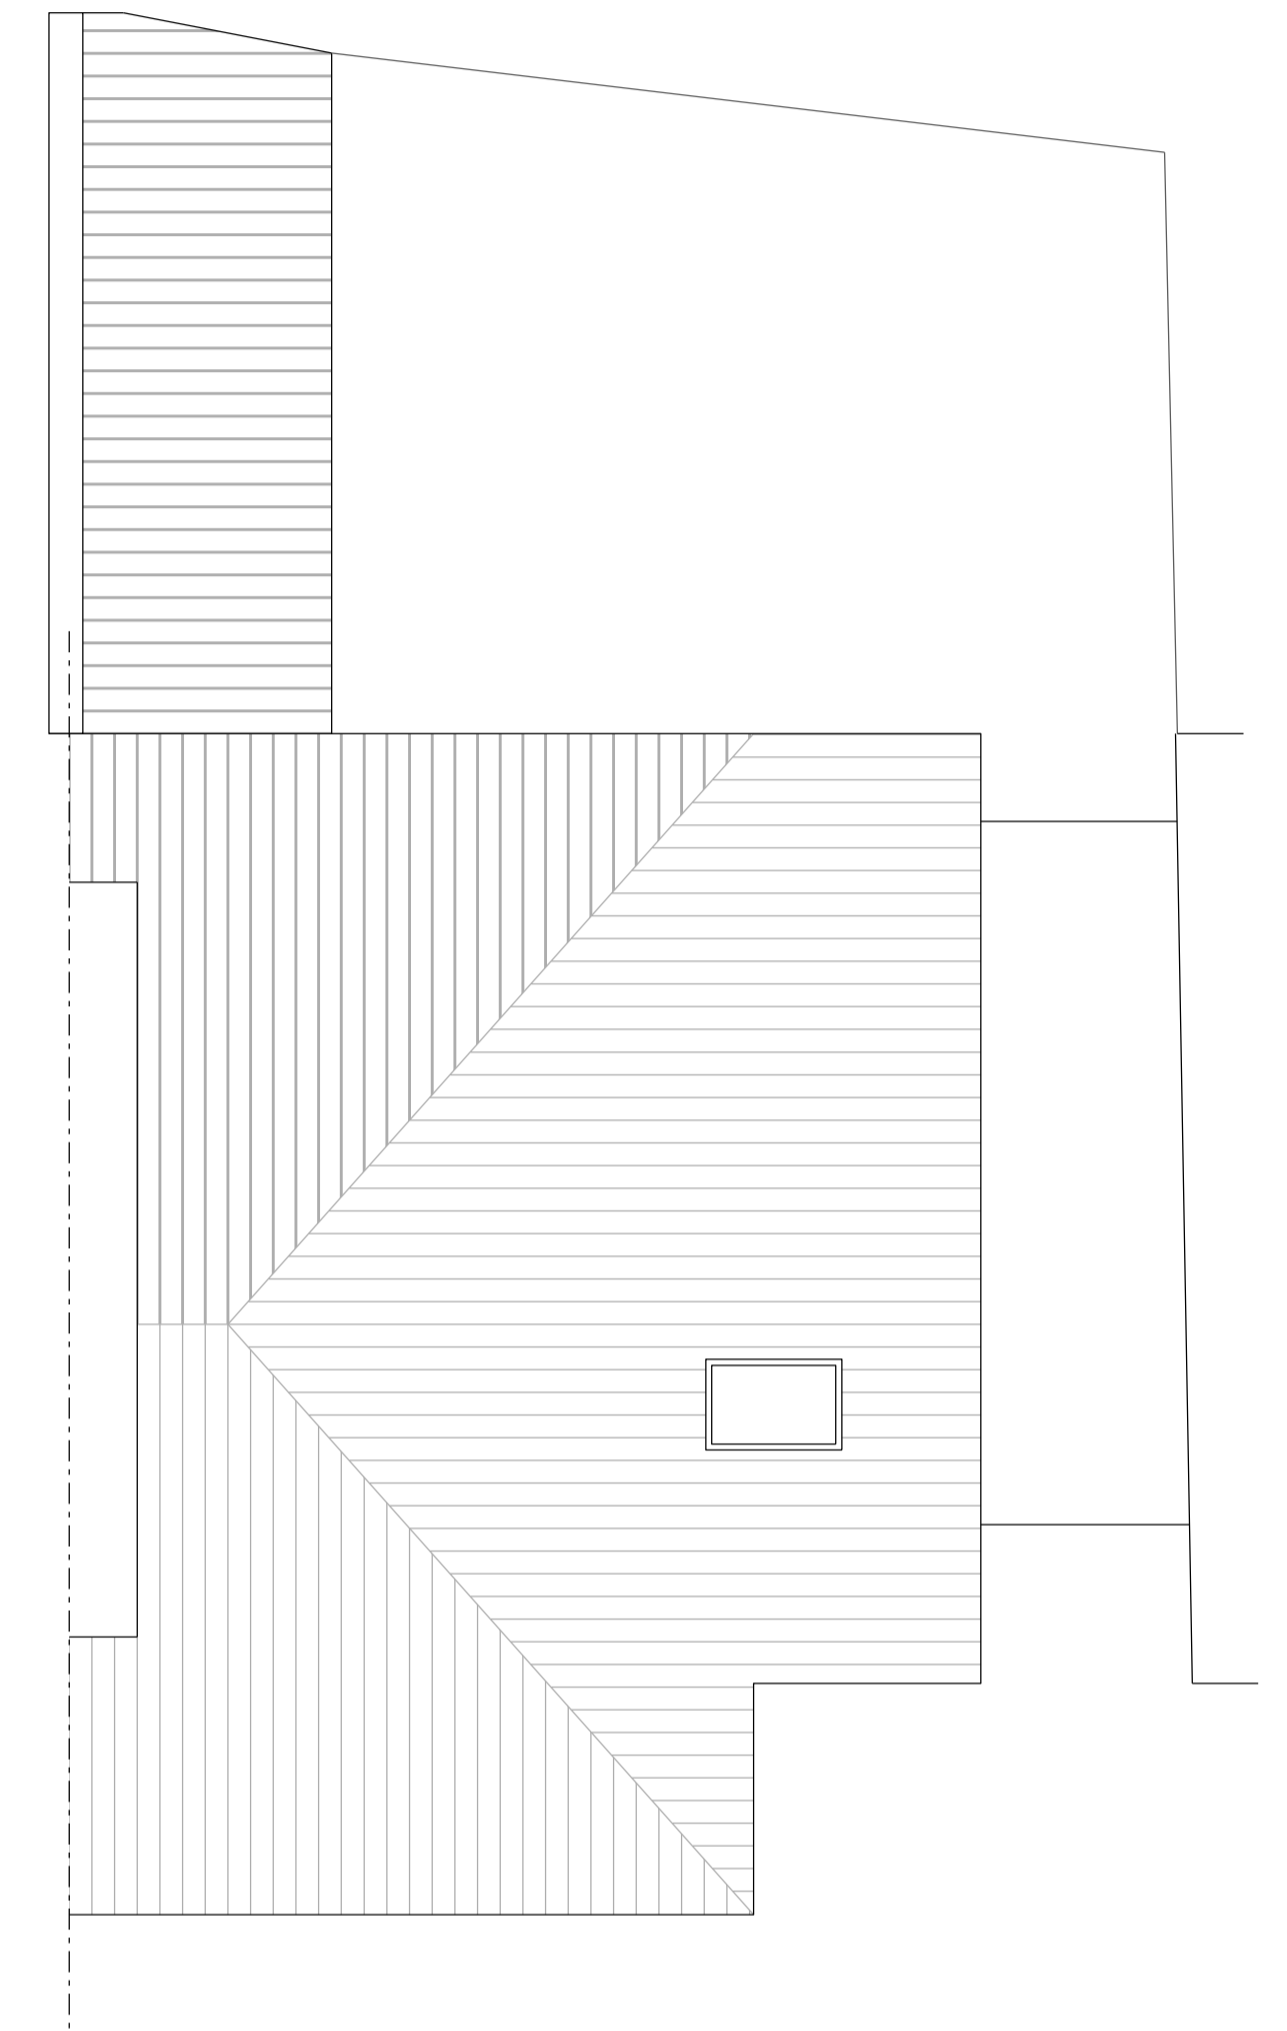

Existing Roof Plan

	Ground	First	Second
Skirting	Replacement skirtings not yet fitted.	Replaced like for like.	Replaced like for like.
Fire places	Front room - fireplace relocated from Second floor front bedroom.	No alterations.	Front room fireplaced moved to ground floor.
Internal Walls	Modern cement and gypsum plaster and skim coat used throughout.	Modern cement and gypsum plaster and skim coat used throughout.	Modern cement and gypsum plaster and skim coat used throughout.
Architraves	Architrave installed throughout.	Architrave installed throughout.	Architrave installed throughout.
Doors	Four panel doors installed.	Four panel doors installed.	Four panel doors installed.
Floors Concrete & Timber	New concrete floor.	Joists retained. chipboard floor installed.	Joists retained. chipboard floor installed.
Roof Light	N/A.	N/A.	Replaced.

All planning drawings to be read in conjunction with Heritage Statement by Fuller Long.

pa d

Independent architectural services
52 Bailey Road Leigh on Sea Essex S39 3PJ M:07790 069188

Project: 68 Highgate Road London NW5 1PA

Client: Duah & Watson

Drawing title: Proposed Single Storey Rear Extension

As Built Floor Plans & Roof Plan

Scale 1: 50@A1

Drawn by PSA

Project number 18 301

Drawing number P1 07

Status: Planning & Listed Buildings Approval

All dimensions must be checked on site and not scaled from this drawing.

As Built