



LEGEND

Built Features		Internal Survey Features	
Building	Survey Station	Beam Height	
Wall	Hard Surface	Door Height	
Edge of Road	Floor Level	Floor to Cill	
Footpath	Edge of Footpath	Cill to Head	
Kerb (bottom)	Parapet	Height	
Kerb (top)	Parapet Height	Fire Door	
Crash Barrier	SOFF	Underside of Soffit	
Railway	Top of Wall Level	Step Level	
Line of Fence	Land Drain	Tree Contourous	
Concrete Base	Tree Contourous	Tree Deciduous	
Surface Change			

20.00	Ceiling Level	Door
20.00	Floor Level	Wardrobe Door
2.76	Ceiling Height	Sliding Door
2.76	False Ceiling Height	Sink / Bath
2.76	Ceiling Slope	Toilets
Arrows point up unless on roofs		Showers
Arched Ceiling		
Roof Access		
Window		
Sash Window		
Radiators		

Description of Features



A/C	Air Conditioner	Ft	Floodlight
AH	Arch Height	F-C	Floor to Cill Height
AL	Arch Level	h	Height
ASH	Arch Spring Height	HR	Handrail
ASL	Arch Spring Level	IC	Inspection Cover
B	Bollard	L	Light
BGP	Break Glass Point	Max	Maximum
BH	Beam Height	Min	Minimum
BBL	Beam Soffit Level	CH	Overhead
C-H	Cill to Head Height	OSBM	Overlance Survey Bench Mark
Conc	Concrete	Rad	Radiator
Cup	Cupboard	RDM	Recessed Door Mat
DH	Door Height	RSJ	Rolled Steel Joist
DP	Down Pipe	RWP	Rain Water Pipe
DC	Drainage Channel	SBM	Site Bench Mark
ESG	Electrical Switchgear	SH	Spring Height
FA	Fire Alarm	SL	Skylight
FE	Fire Extinguisher	V	Vent
FH	Fire Hydrant	VP	Vent Pipe
FHR	Fire Hose Reel	WH	Water Heater

Murphy Surveys Ltd. Disclaimer

The user or recipient of this survey data understands and acknowledges this data may be inaccurate or contain errors or omissions and the user or recipient assumes full responsibility for any risks or damages resulting from arising from, or in connection with any use of or reliance upon data displayed herein. Although significant care has been exercised to produce surveys that satisfy survey accuracy standards, these surveys are only as accurate as the source data from which they were compiled. Although all reasonable steps have been taken to locate all features visible at the time of the survey, there is no guarantee that all will be shown on the drawing, as some above ground features may have been obstructed the survey. Wherever possible, areas unable to be surveyed will be labelled as 'T.T.S'.

The Company shall not be liable for any inaccuracy of the data provided beyond the specified scale or accuracy, or for any matters resulting from their use for purposes other than that stated in the Contract. No liability shall attach to the Surveyor in respect of any consequential loss or damages suffered by the Client.

The Client must promptly notify the Company of any errors in mapping of which it becomes aware. If misleading, inaccurate or otherwise inappropriate information is brought to the Company's attention or the Company itself identifies any such imprecision or error in a survey, it shall use its reasonable endeavours to fix or remove it and if necessary in certain instances, the Company being on notice of any such misleading, inaccurate or otherwise inappropriate information, it will re-conduct the survey and reproduce the data to within the specified scale or accuracy.

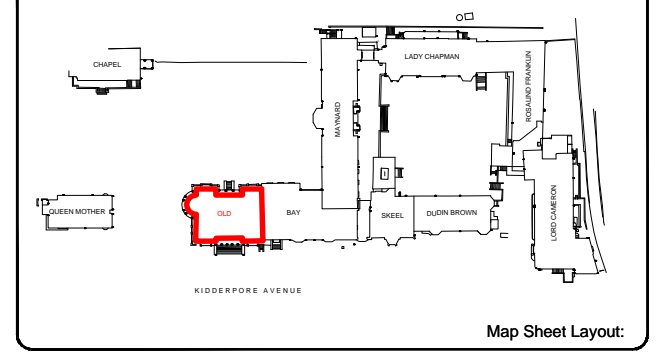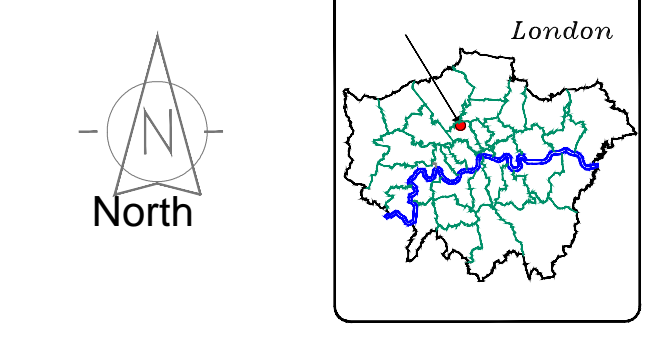

No.	Date	Description
A	22/09/2014	First Issue
B	13/10/2014	Drawing Flattened To 2d
C	10/11/2014	Heights added on windows and doors
D	11/09/2015	Additional Scans - Missing Room

Surveyed by: GB Date: 22/07/2014 Datum: OSGB
 Drawn by: MP Date: 19/09/2014 Grid System: OSGB
 Checked by: NBM Date: 22/09/2014

EUROPEAN GPR ASSOCIATION
 No. 318 FULL MEMBER

murphy SURVEYS
 GLOBAL CONSULTING SURVEYORS

Topographic surveys, Measured Building Surveys,
 Setting Out, As-Built Surveys, Historic Building Surveys, Legal Measures,
 Pipeline Surveys, Services Location, Ground Penetrating Radar,
 Laser Scanning, 3D Photogrammetry

London Glasgow Belfast Cork Kildare

UK Head Office
 9 Devonshire Square London EC2M 4YF
 Phone: (+44) 020 3178 6644
 Email: london@murphysurveys.co.uk

www.murphysurveys.co.uk

Client:	Mount Anvil
Project:	King's College London Kidderpore (Old) House
Date:	11/09/2015
Scale:	1:50@A1
Description:	Floor Plan - Lower Ground Floor
Drawing Number:	MSL9992-OH-FPLG-RevD

© Copyright 2014 MURPHY SURVEYS LTD