


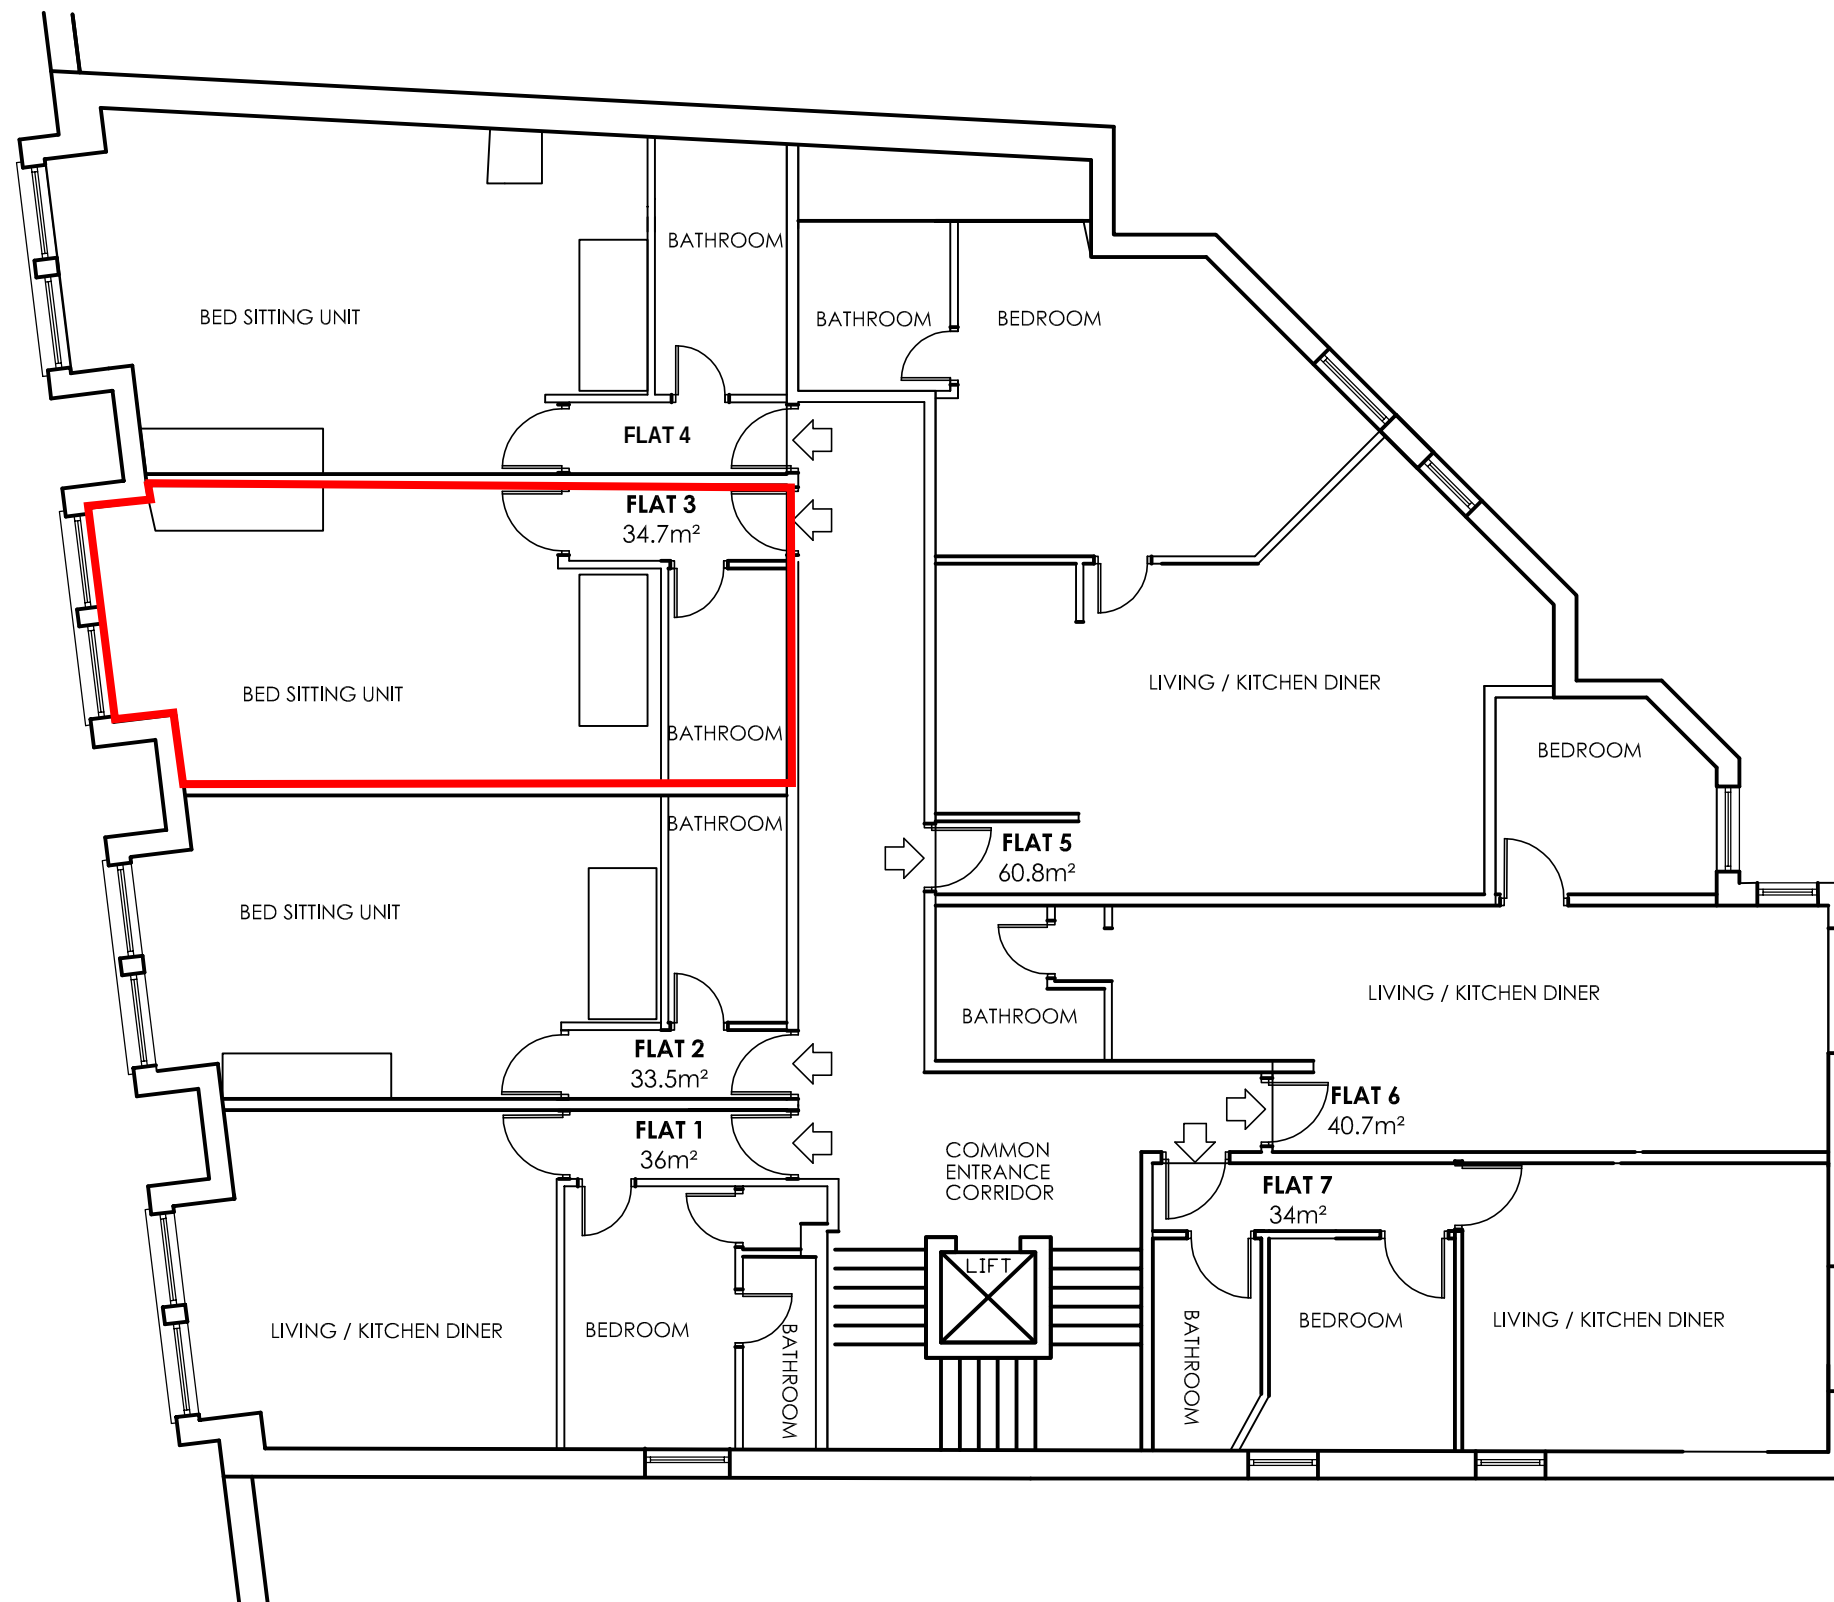

FIRST FLOOR PLAN



rev	description	date
Lawton Duffy		
9 Holtspur Lane, Wooburn Green High Wycombe, Bucks, HP10 0AA Tel: 01628 530 611 grahaml@mail2world.com		
project		
FLAT 3		
240-242 KILBURN HIGH ROAD LONDON NW6 2BS		
title		
AS BUILT FIRST FLOOR PLAN		
scale	drn	rev
1:100	MAD	
date	drn no.	
04/11/09	0455/401	