



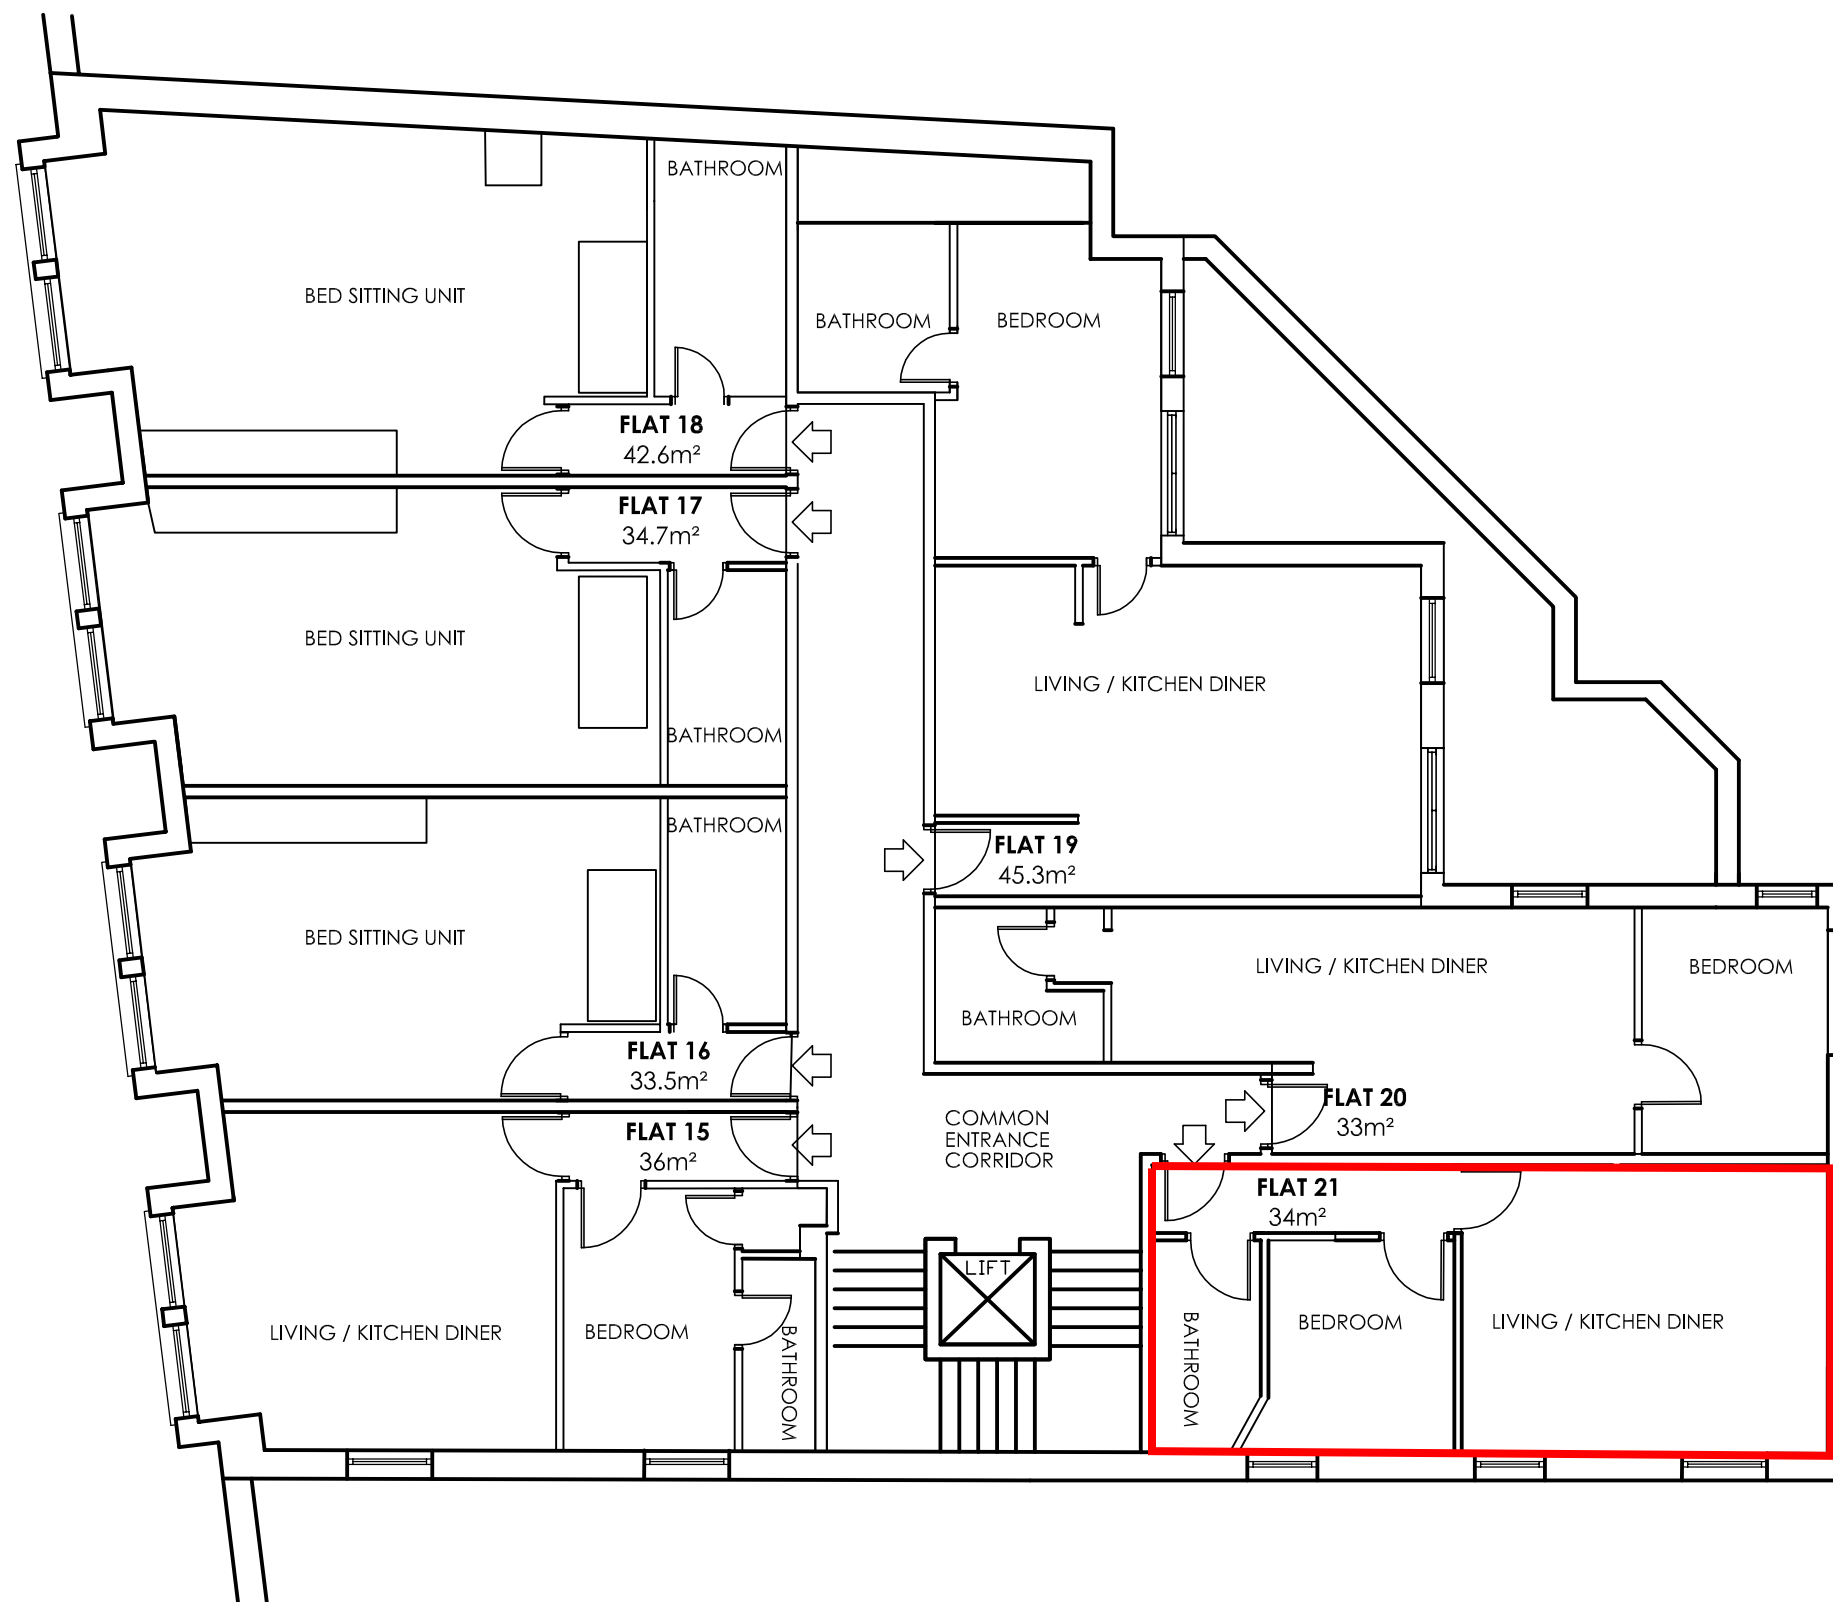

THIRD FLOOR PLAN

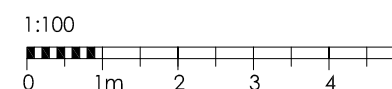

rev	description	date
-----	-------------	------

Lawton Duffy

9 Holtspur Lane, Wooburn Green
High Wycombe, Bucks, HP10 0AA
Tel: 01628 530 611
grahaml@mail2world.com

project

FLAT 21
240-242 KILBURN HIGH ROAD
LONDON NW6 2BS

title
AS BUILT THIRD FLOOR PLAN

scale	drn	rev
1:100	MAD	
date	drg no.	
04/11/09	0455/403	