


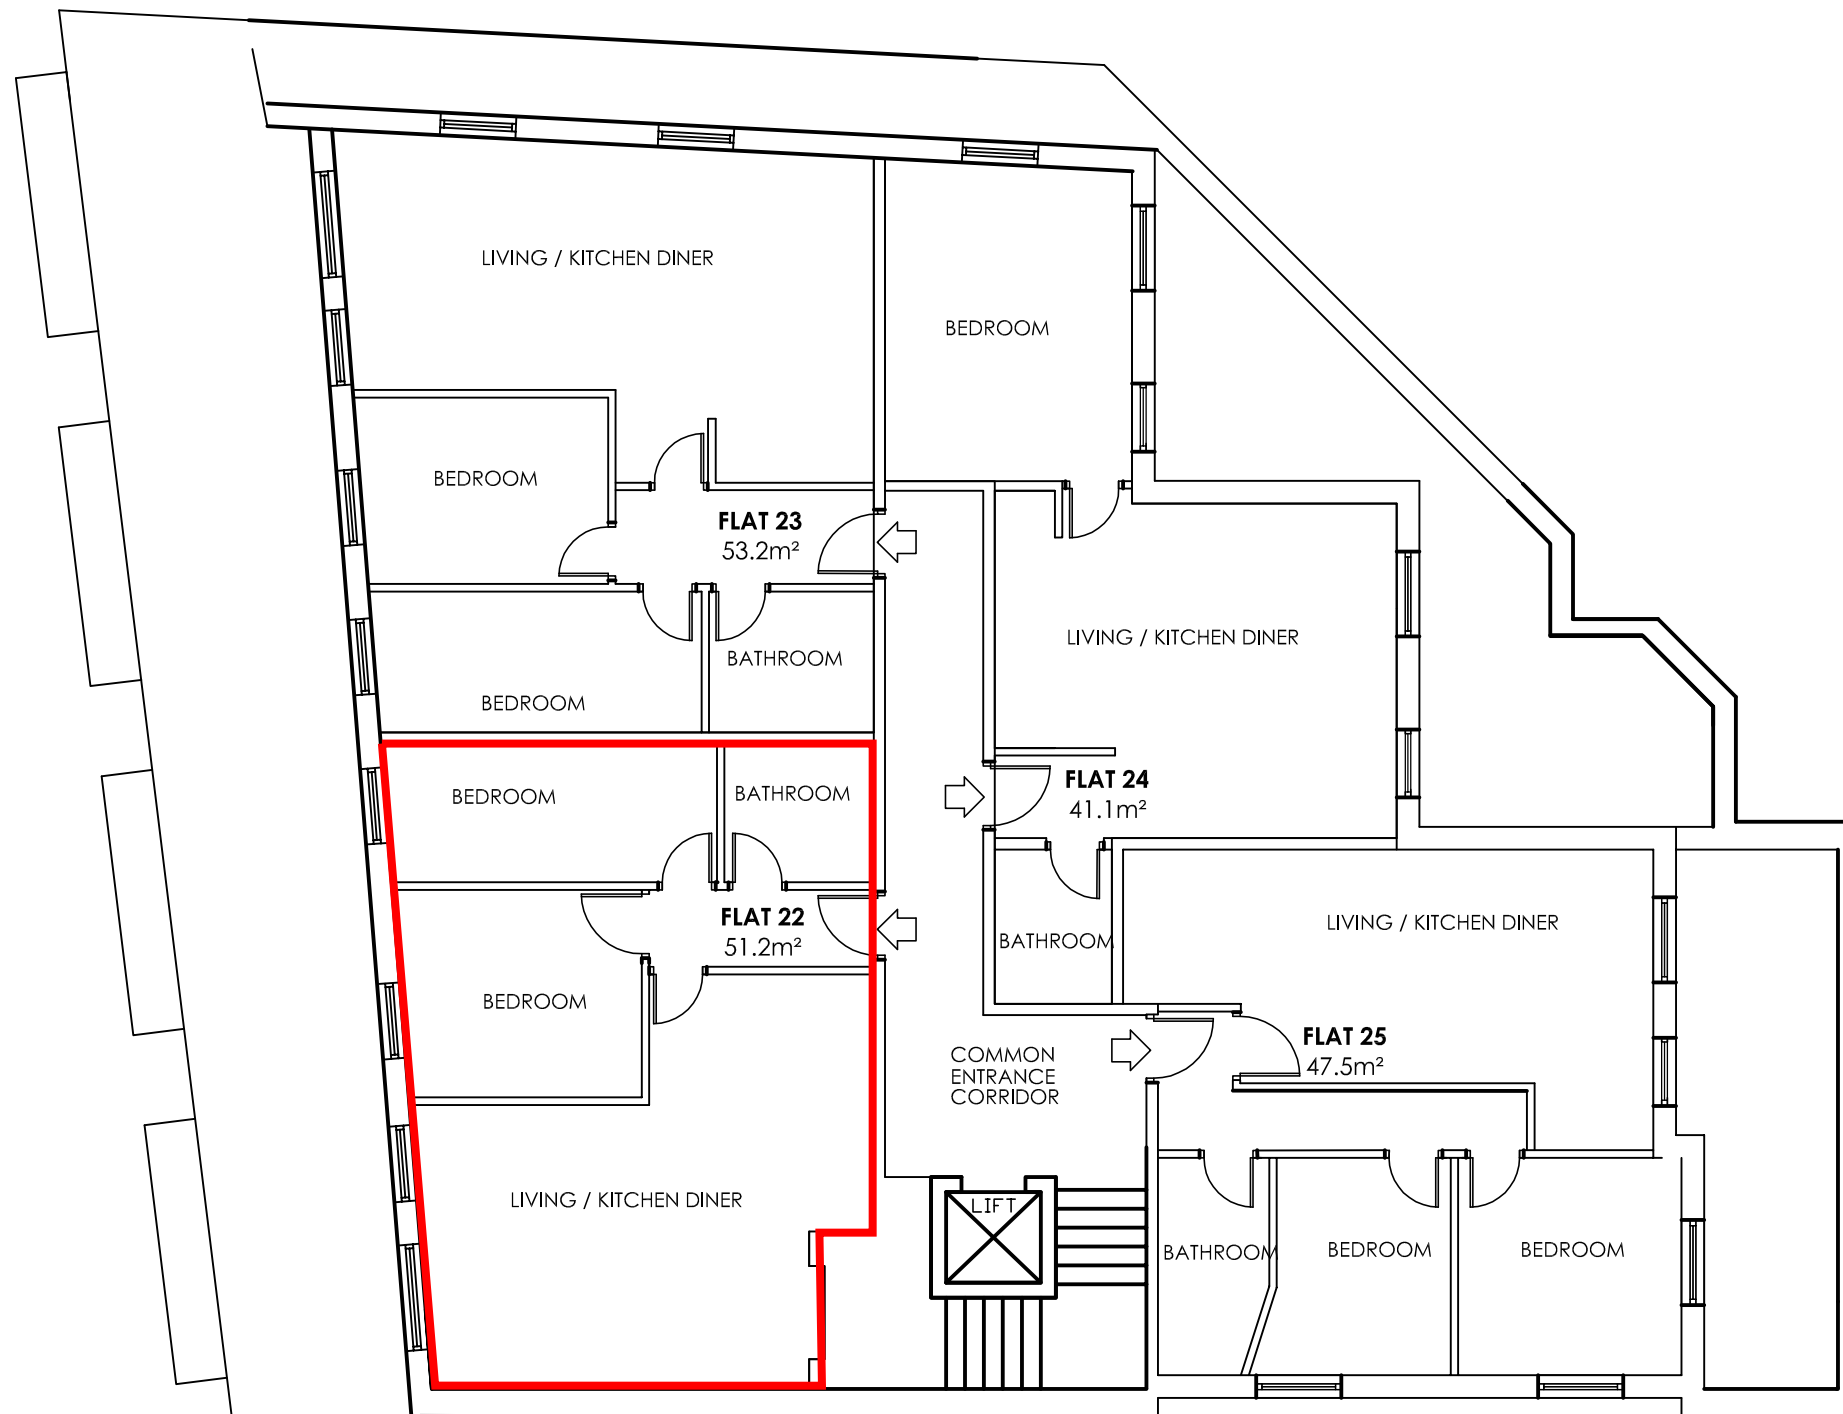

FOURTH FLOOR PLAN



rev	description	date
Lawton Duffy 9 Holtspur Lane, Wooburn Green High Wycombe, Bucks, HP10 0AA Tel: 01628 530 611 grahaml@mail2world.com		
project FLAT 22 240-242 KILBURN HIGH ROAD LONDON NW6 2BS		
title AS BUILT FOURTH FLOOR PLAN		
scale 1:100	drn MAD	rev
date 04/11/09	drg no. 0455/404	