


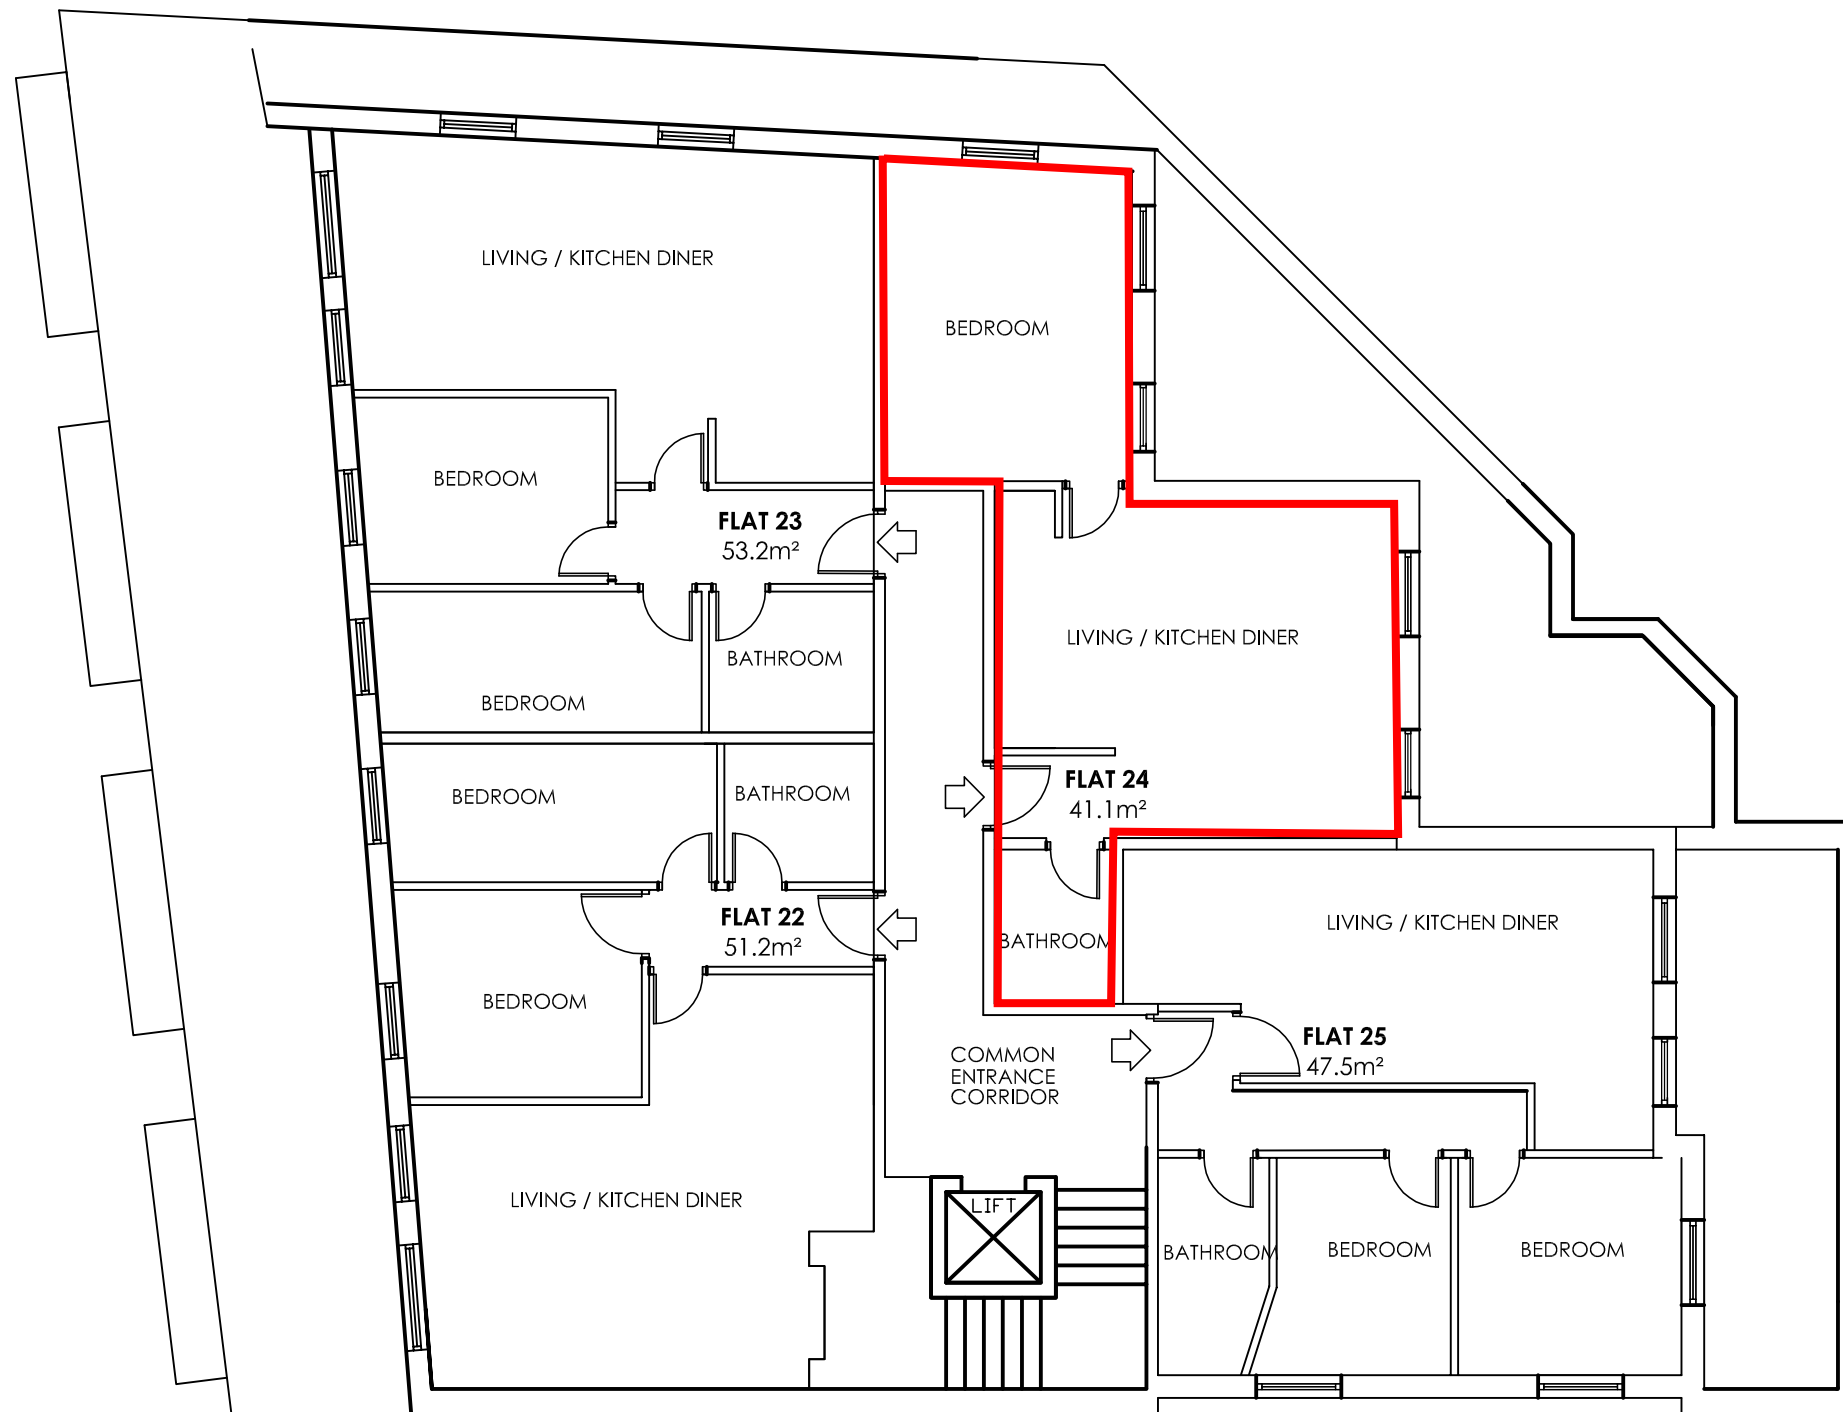

FOURTH FLOOR PLAN



rev	description		date
Lawton Duffy 9 Holtspur Lane, Wooburn Green High Wycombe, Bucks, HP10 0AA Tel: 01628 530 611 grahaml@mail2world.com			
project			
FLAT 24			
240-242 KILBURN HIGH ROAD LONDON NW6 2BS			
title			
AS BUILT			
FOURTH FLOOR PLAN			
scale		drn	rev
1:100		MAD	
date		drn no.	
04/11/09		0455/404	