




PV PANELS ABOVE CONDENSOR COMPOUND, MOUNTED TO SUPPORT FRAME & FIXED TO HIGH LEVEL STEELWORK.

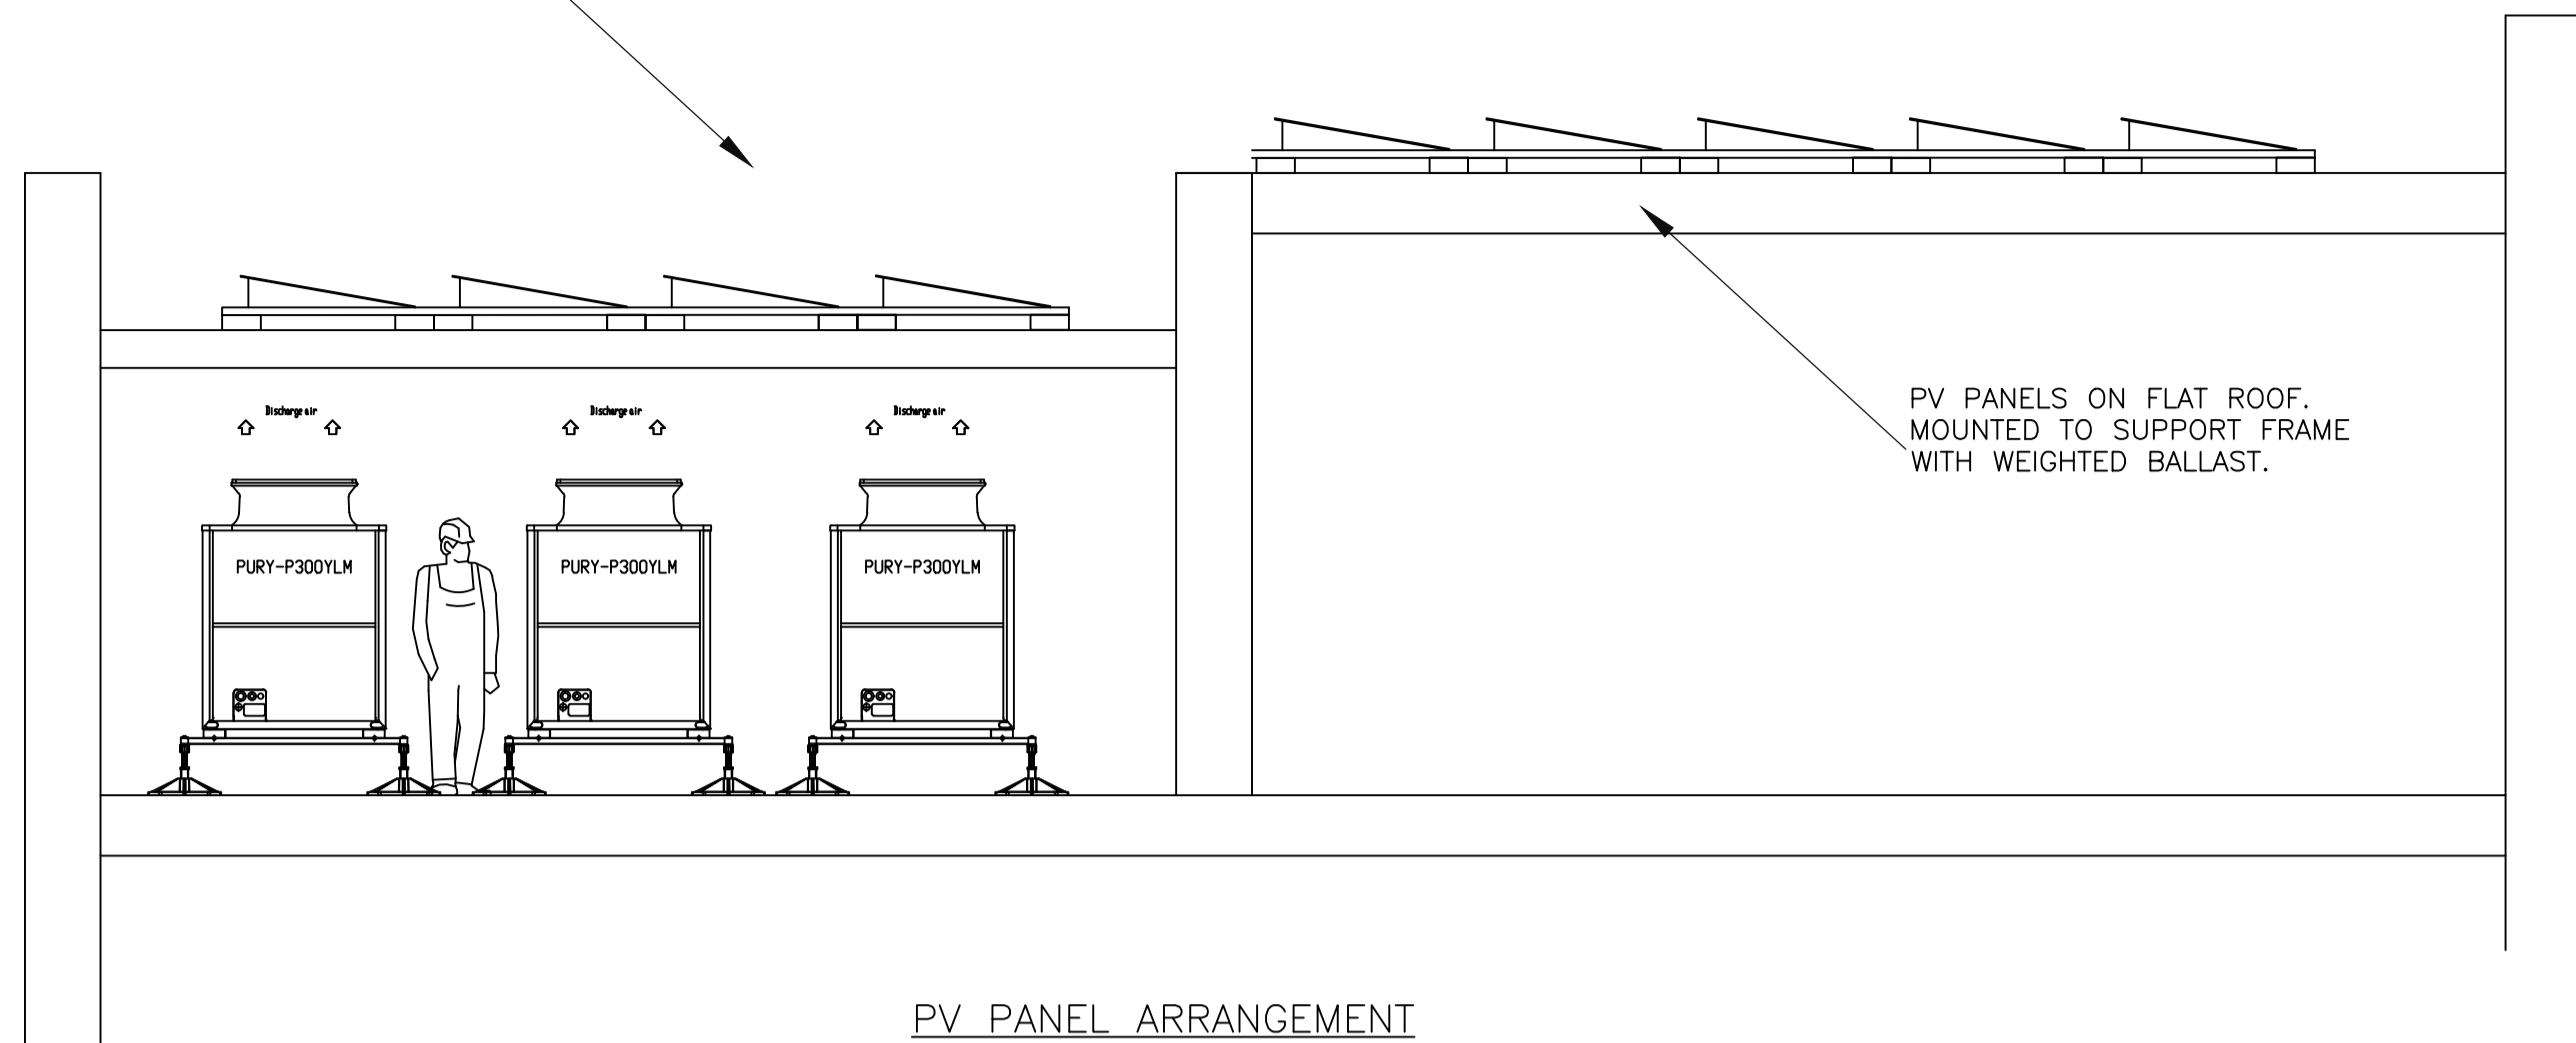

PV PANEL ARRANGEMENT

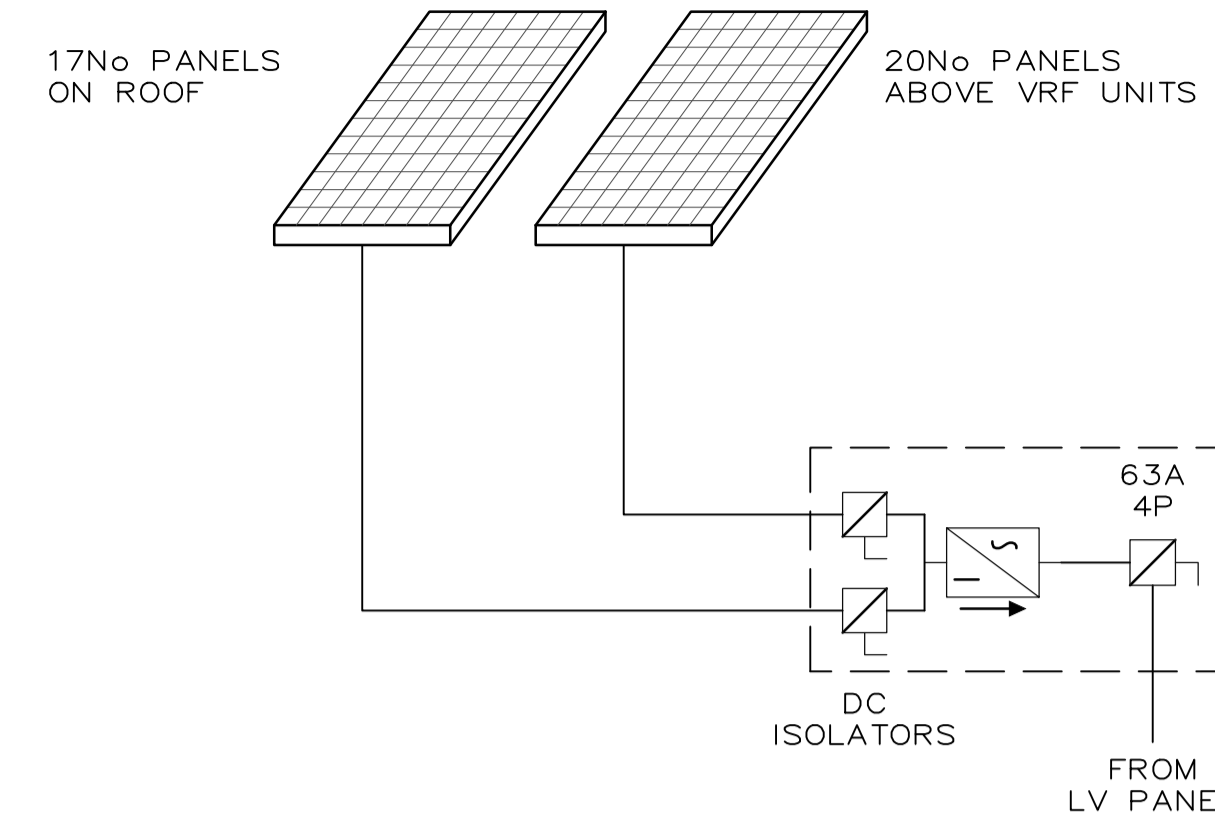

PV WIRING ARRANGEMENT

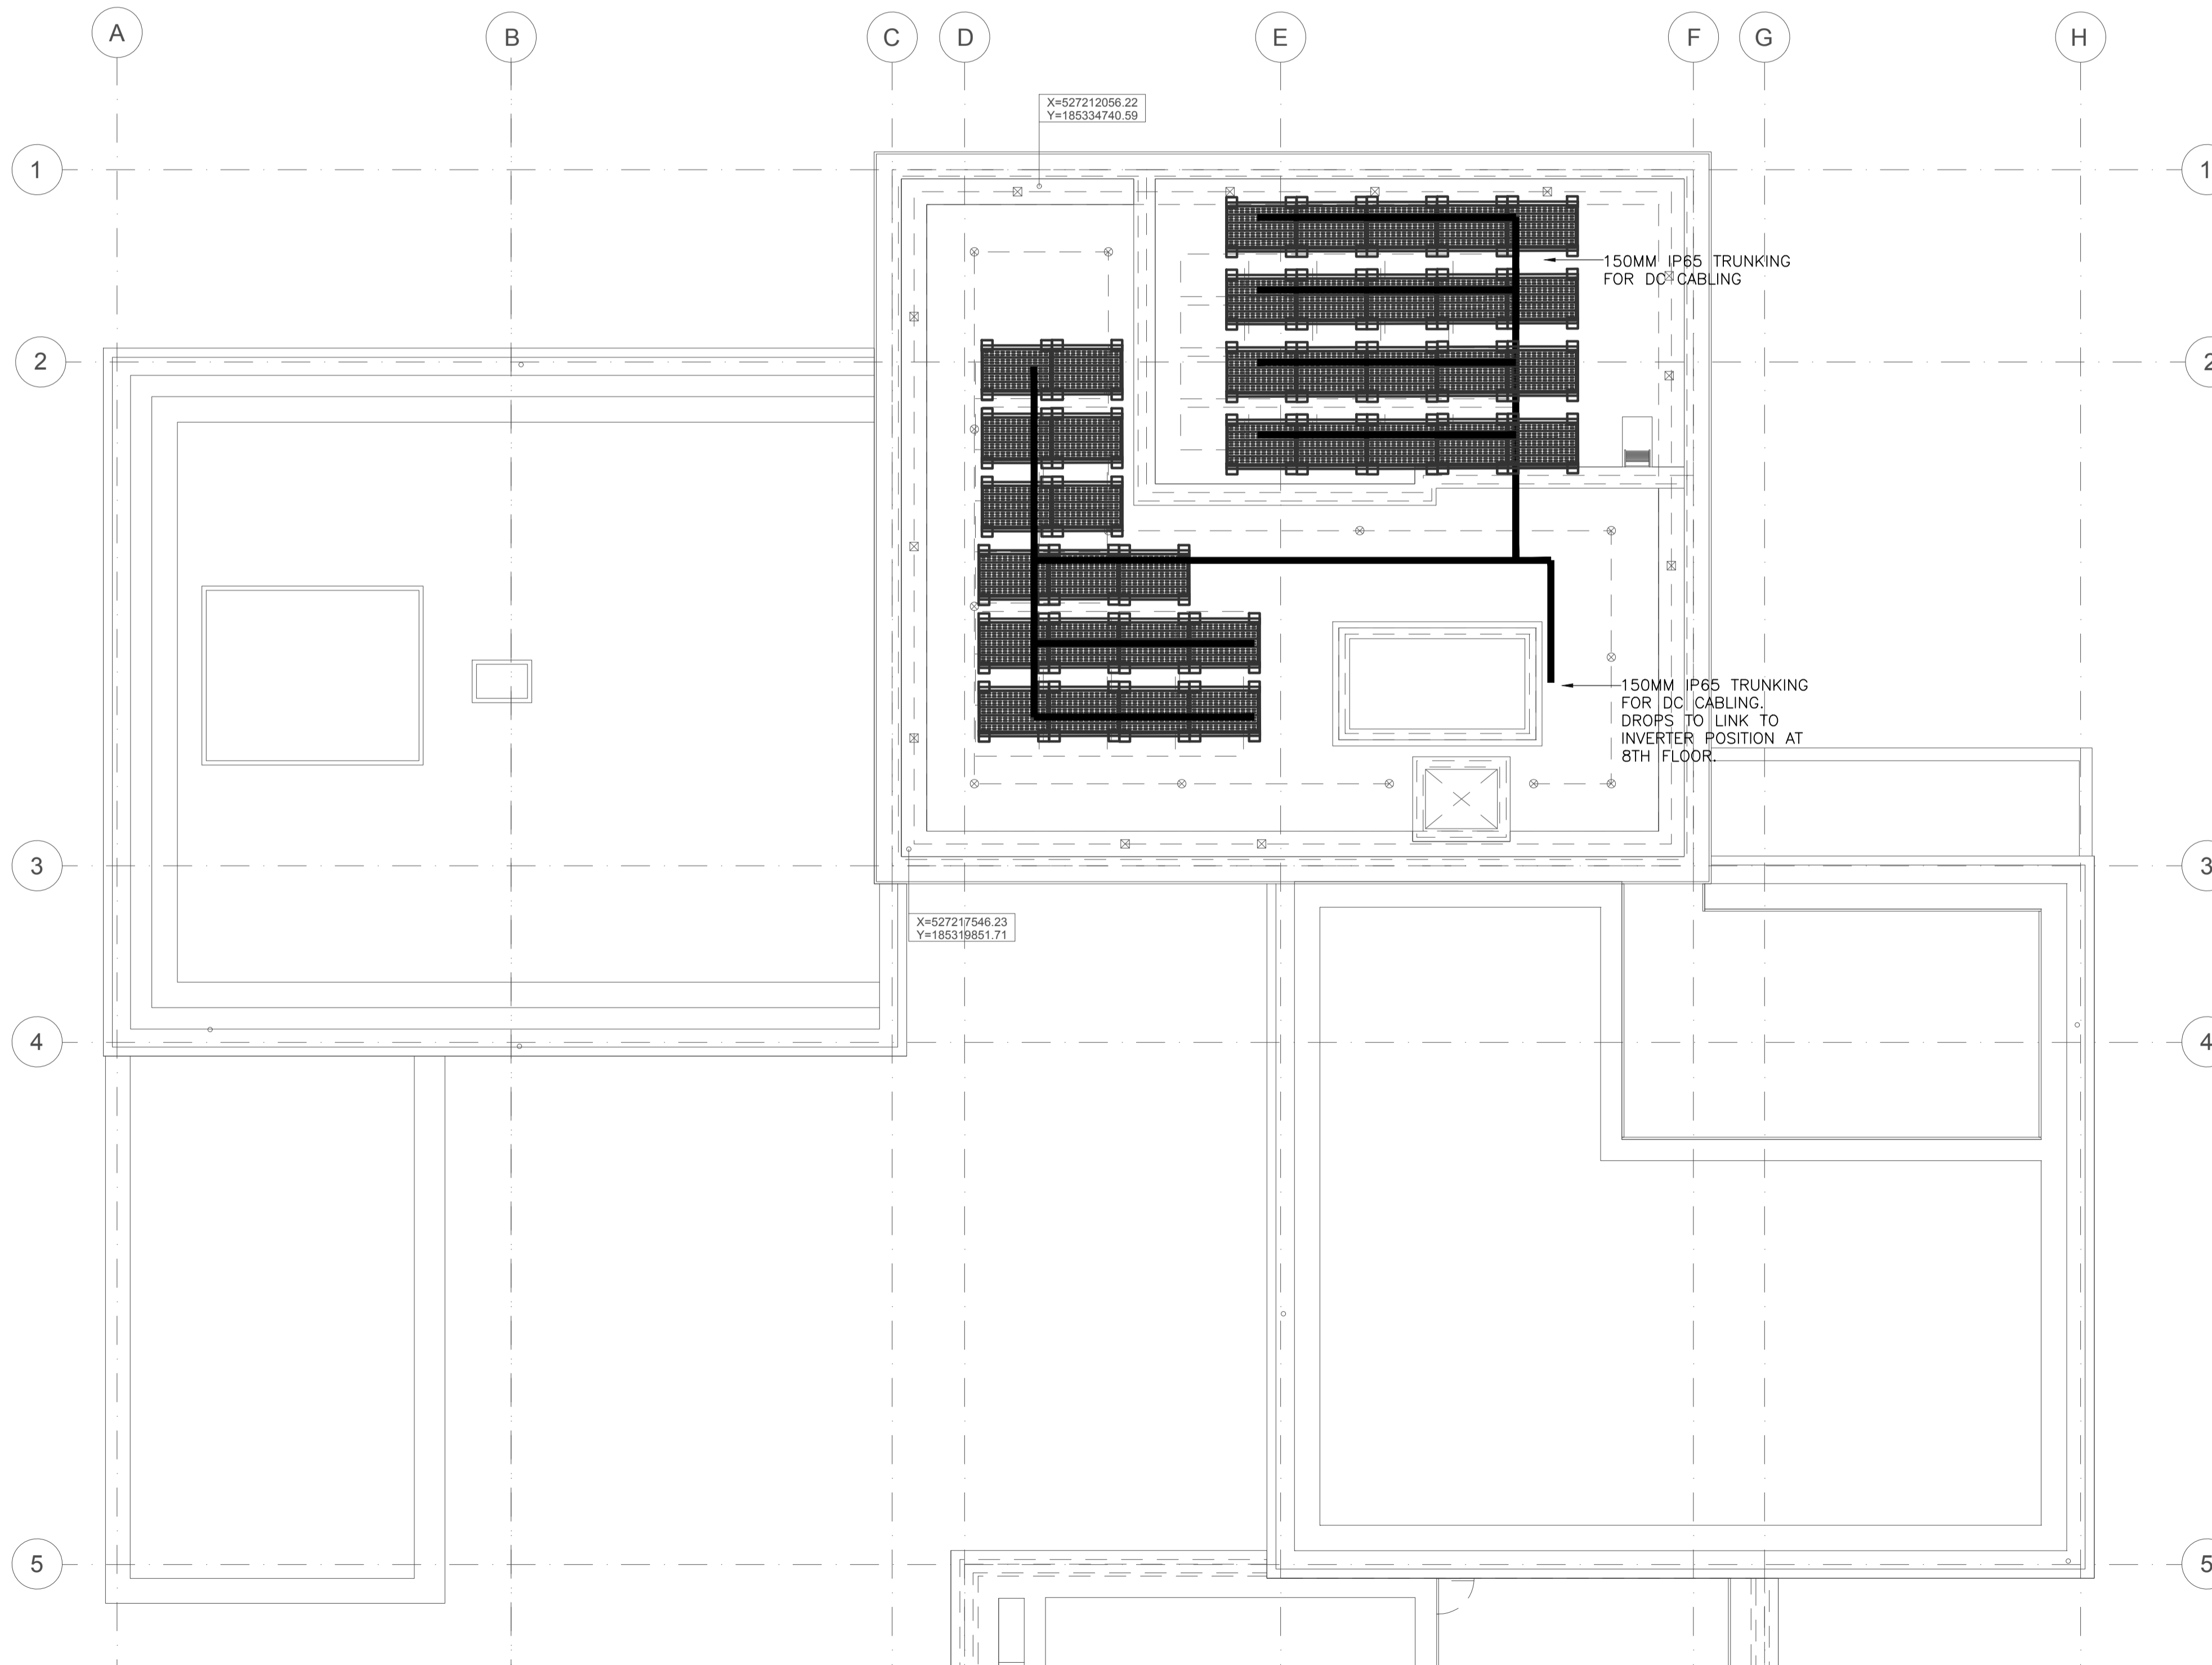

NOTES

REV	DESCRIPTION	DATE	INITIAL	VFIED

DRAWING STATUS:
AS INSTALLED

JSW
J S WRIGHT & CO LTD
EST. 1890
BUILDING SERVICES ENGINEERS

HEAD OFFICE ATLAS BUILDING 16 PORTLAND STREET BIRMINGHAM B6 5JK
 BRISTOL OFFICE TRYM LODGE 1 HENBURY ROAD BRISTOL BS9 3HJ
 LONDON OFFICE JSWRIGHT&CO LTD. 1 NORTHAMBERLAND AVENUE LONDON WC1N 5BH
 TEL: 0121 322 4000 FAX: 0121 322 4001 EMAIL: JSWRIGHT@JSWRIGHT.CO.UK
 TEL: 0117 959 6416 FAX: 0117 959 6415 EMAIL: LONDON@JSWRIGHT.CO.UK
 TEL: 0207 872 5522 FAX: 0121 322 4001 EMAIL: LONDON@JSWRIGHT.CO.UK
 WEBSITE: WWW.JSWRIGHT.CO.UK

CONTRACT:
HAMPSTEAD GREEN
LONDON

TITLE:
ROOF LEVEL
ELECTRICAL SERVICES
LAYOUT

DATE: OCT '16	DRAWN: J.E
SCALE: 1:100	VERIFIED: N.B
SHEET SIZE: A1	JOB NO: 9552
DRAWING No.: JSW/SW/R/FP/E/211	REV AF

ARCHITECTS DRG. No.: