
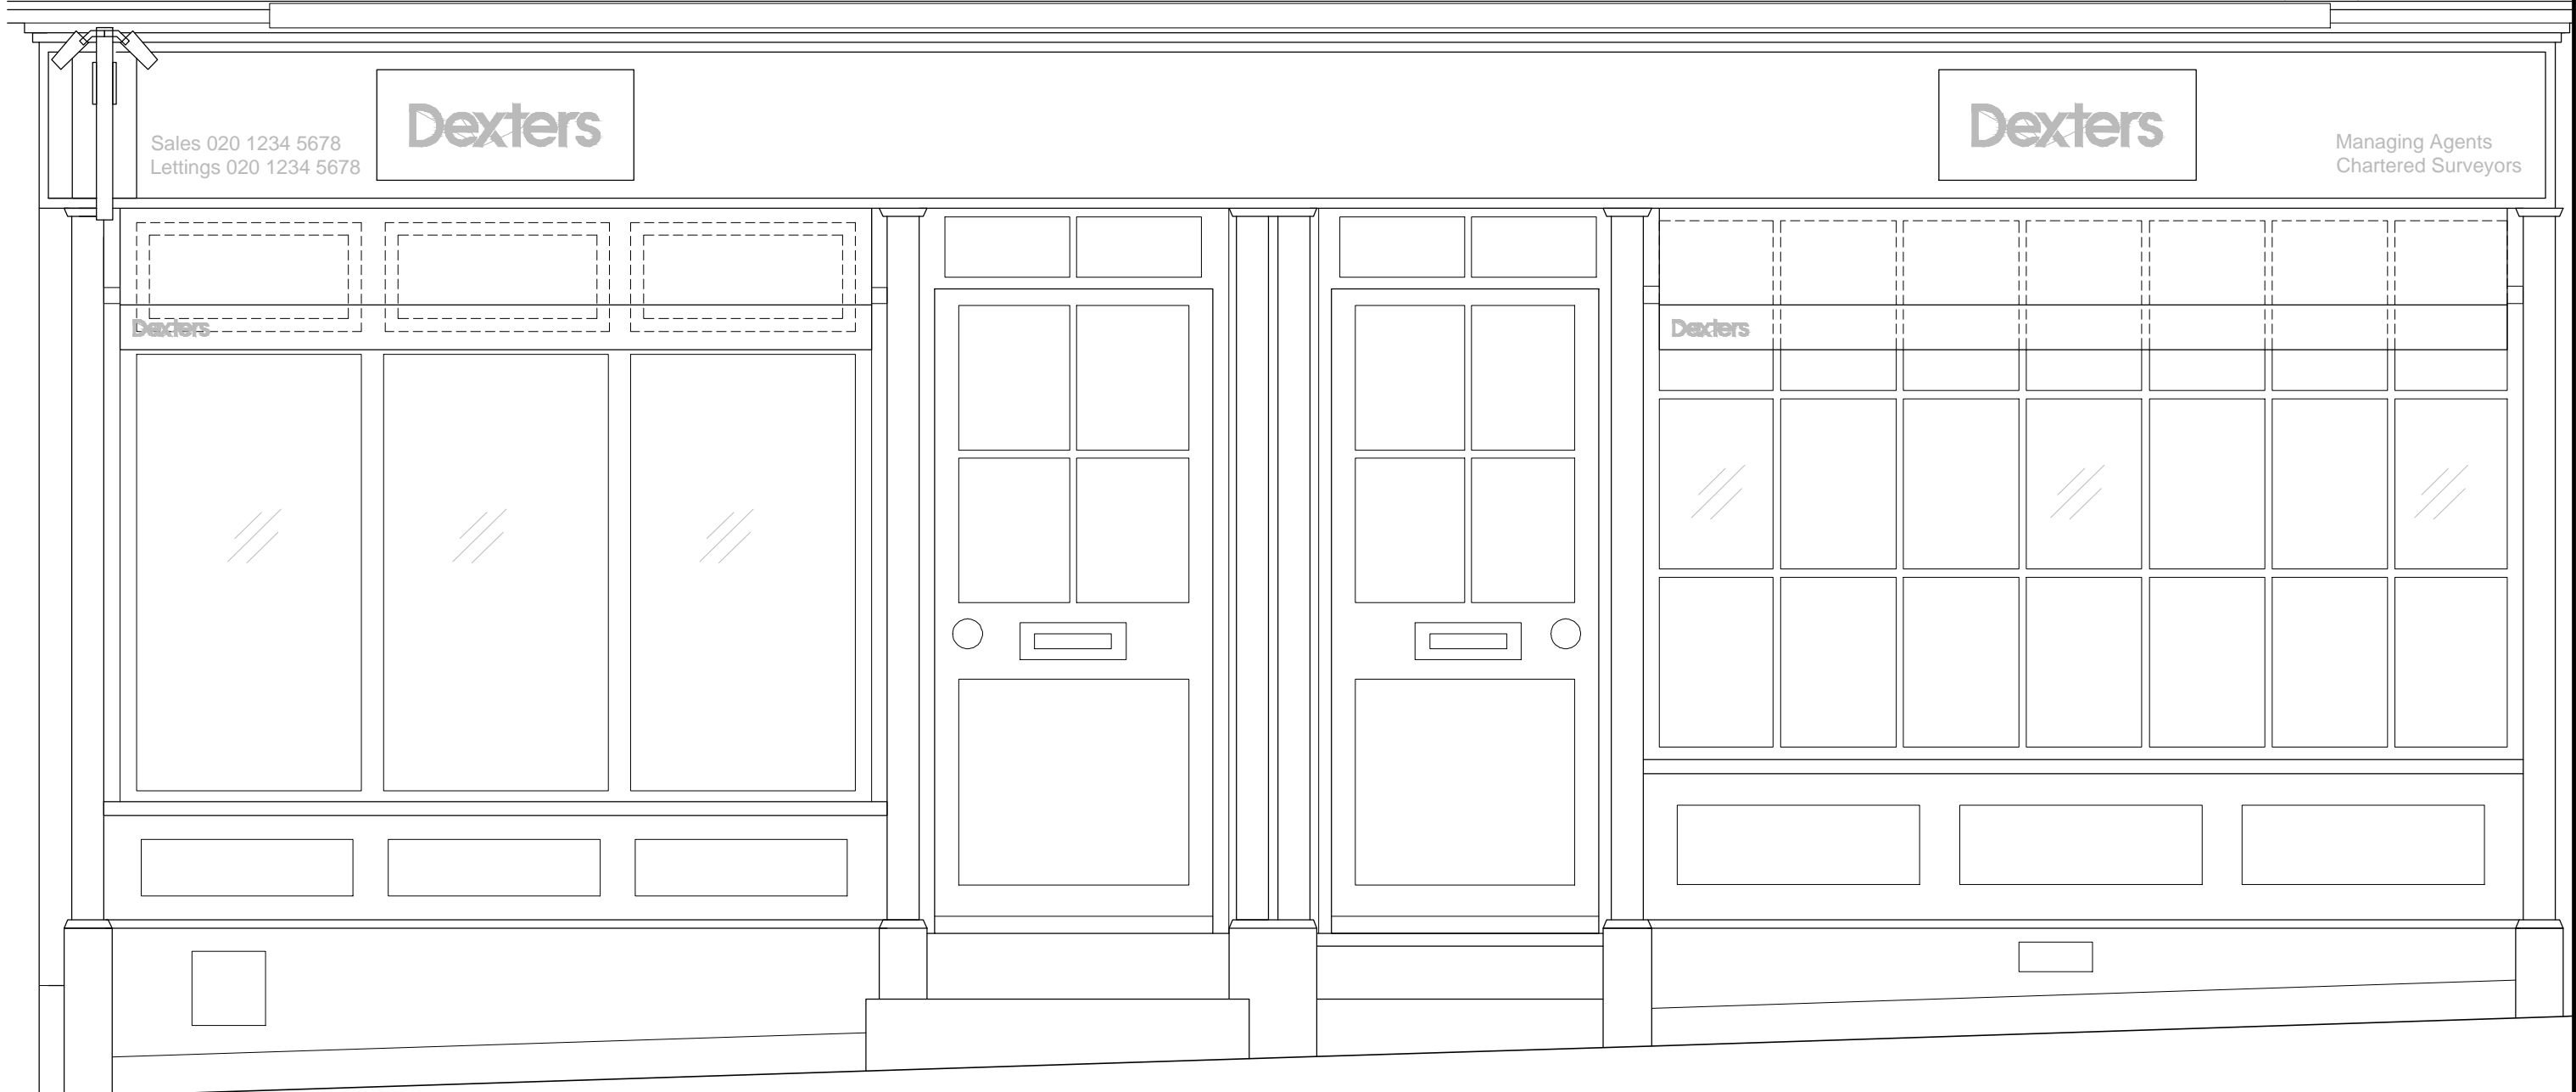
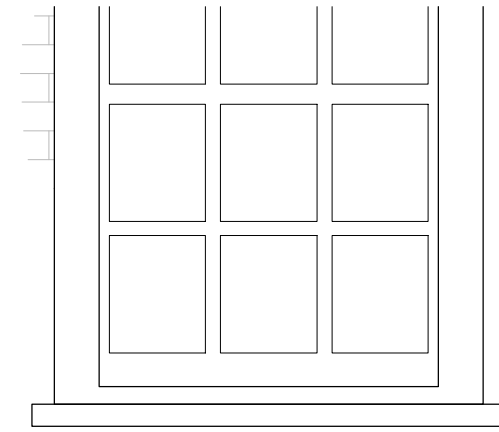
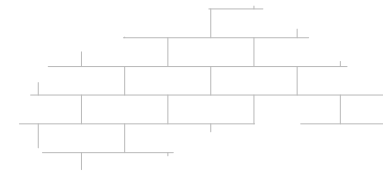


0m 0.5m 1m 1.5m 2m

Scale 1:20

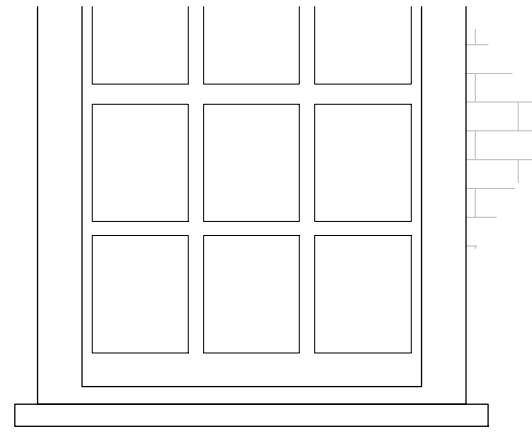

1 / Front Elevation

Job Title:

New Shopfront

Drawing Title:

As Built Elevation

Revision Notes:

-

CLIENT : Dexters LTD

SITE: 35 Highgate High Street, London, N6 5JT

-

-

This drawing must not be reproduced in whole or part without written consent. Do not scale this drawing. Written dimensions to be checked on site. Electronic issue to be confirmed by paper copy only.



Ideal Planning and Design Ltd.  
Hyde Park House  
5 Manfred Road,  
London, SW15 2RS  
Tel: 0208 8230750  
Web: www.idealplanningdesign.co.uk  
Email: info@idealpd.co.uk

Scale: 1:20 @ A3

Date: 25/02/2019

Drawn By: AB

Checked By: CG

PROJECT  
1422

Drawing No  
10

Rev