


Existing Front Elevation



Existing Rear Elevation

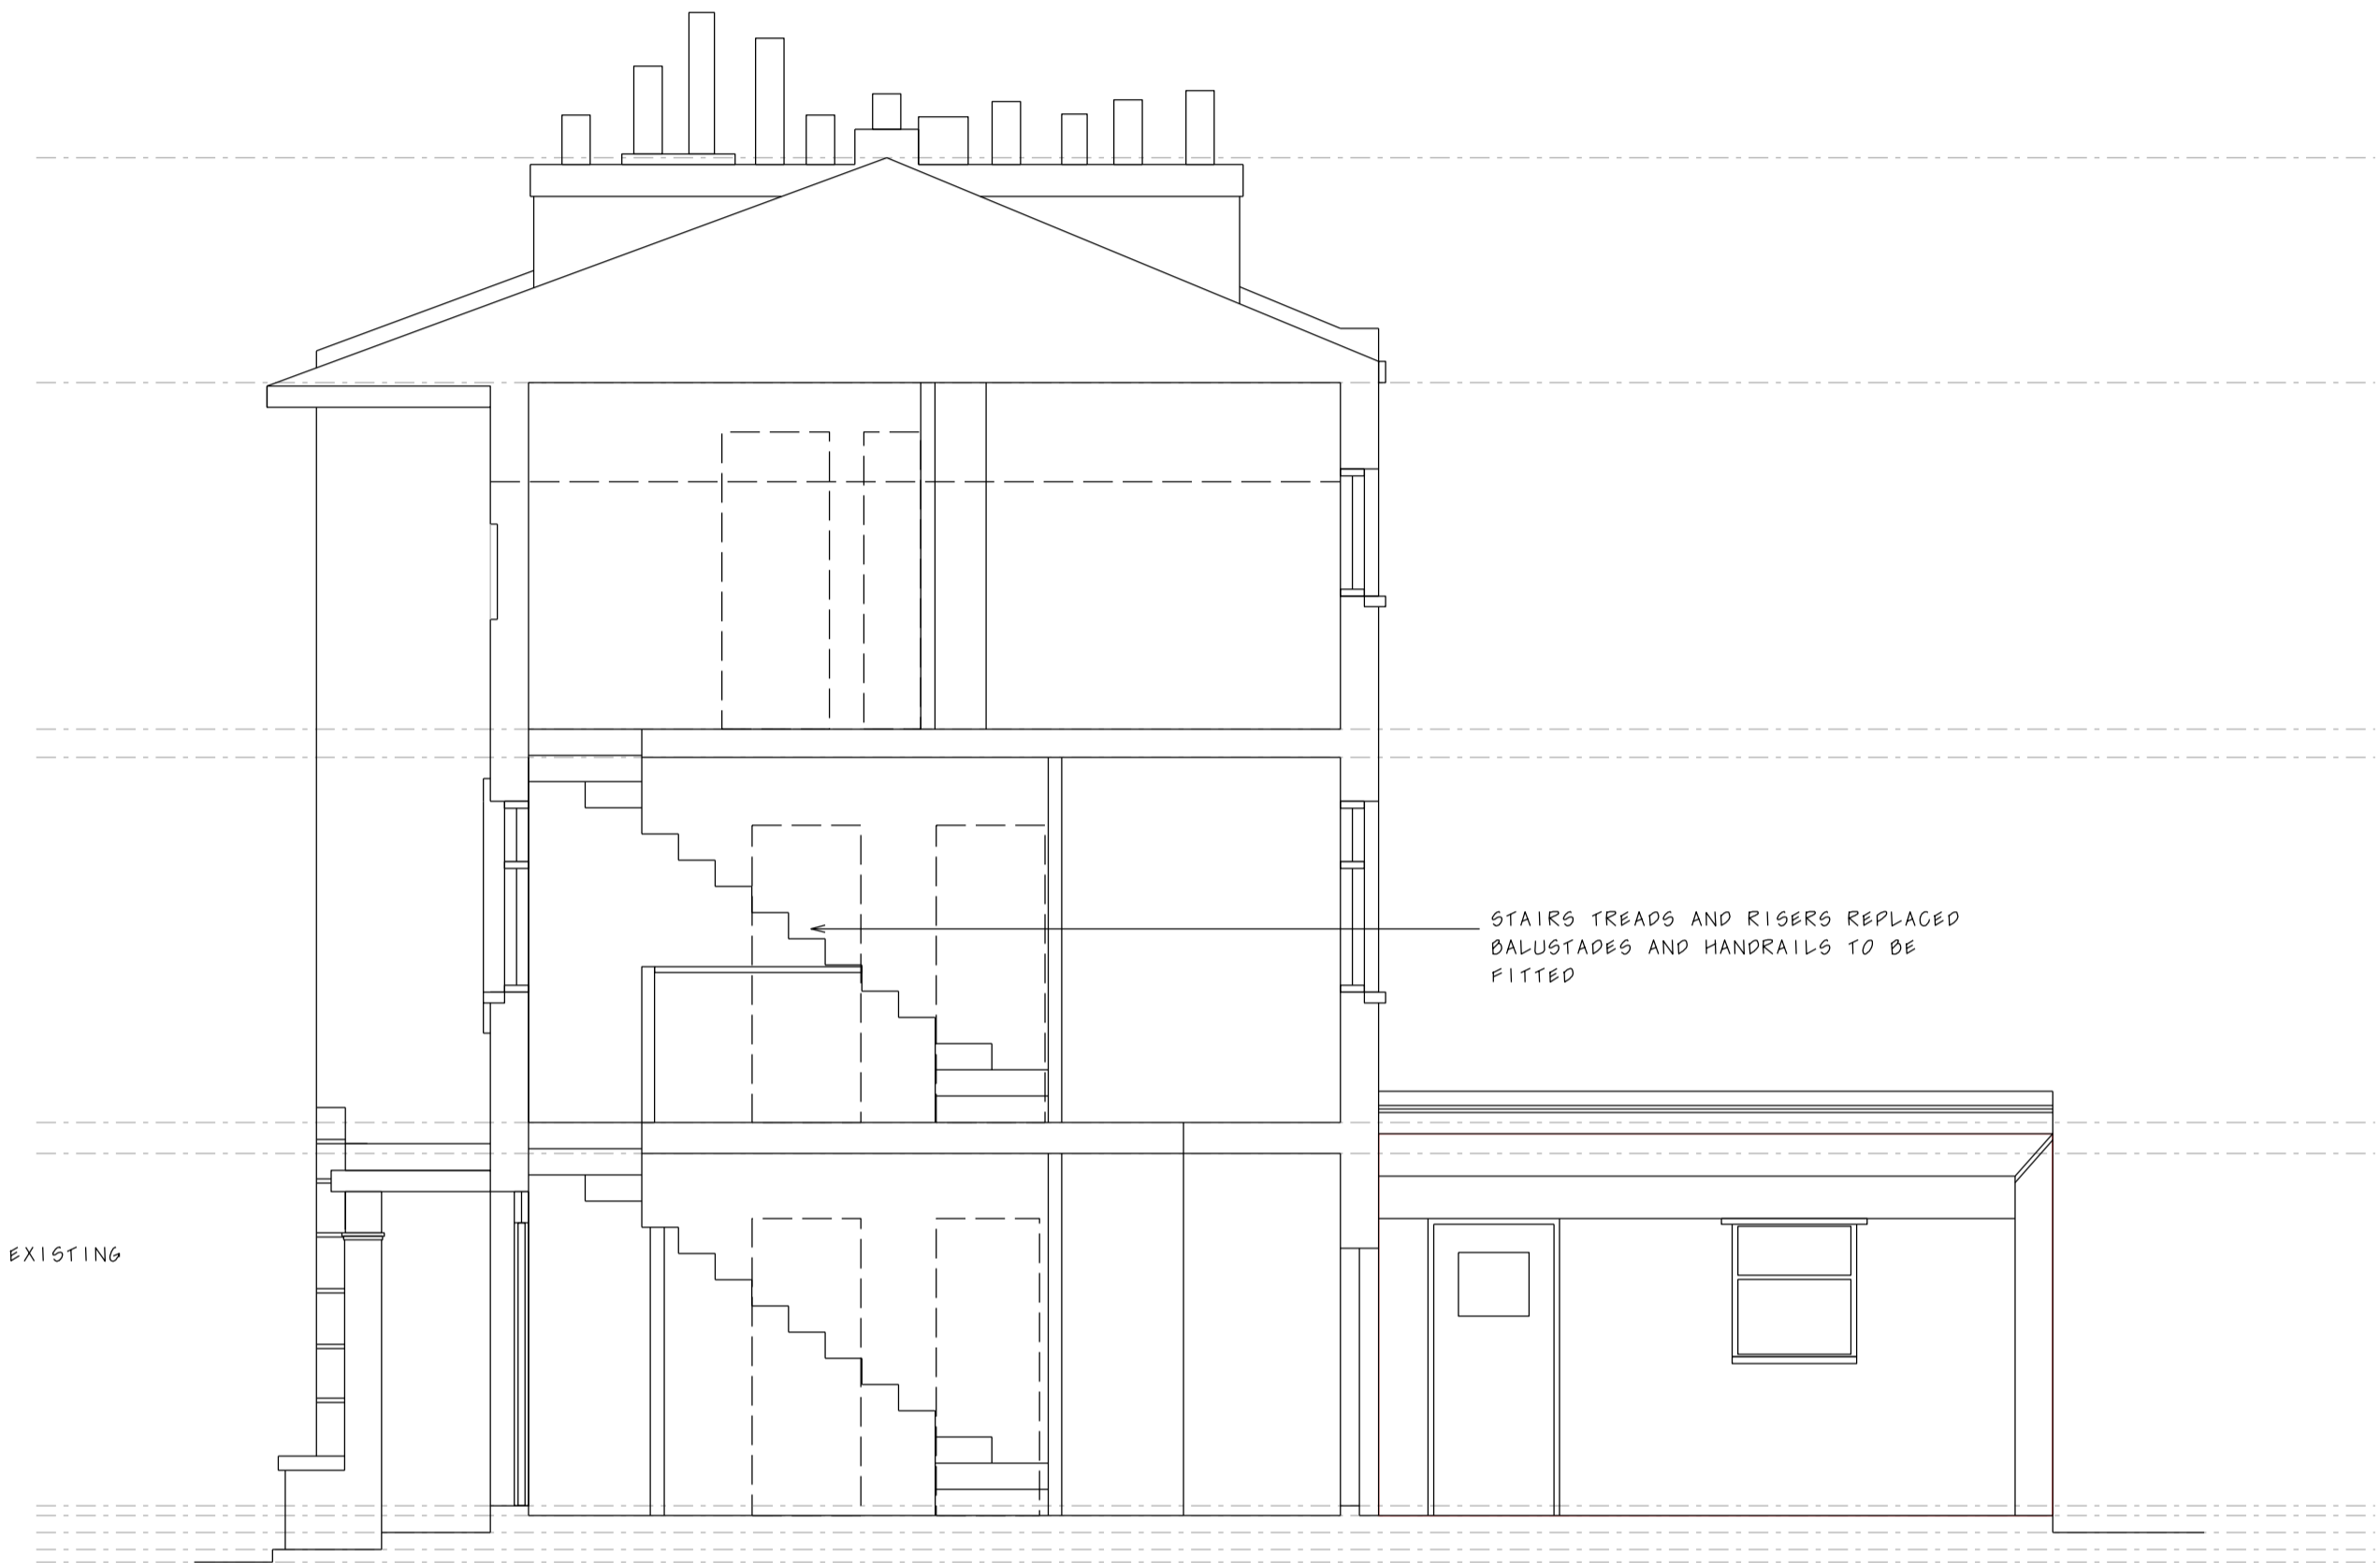

Existing Cross Section / Elevation

Rev A Height of infill roof amended. 25.02.19

All planning drawings to be read in conjunction with Heritage Statement by Fuller Long.

pa d

Independent architectural services
52 Bailey Road Leigh on Sea Essex SS9 3PJ M:07790 069188

Project: 68 Highgate Road London NW5 1PA

Client: Duah & Watson

Drawing title: Proposed Single Storey Rear Extension

As Built Elevations & Section

Scale 1: 50@A1

Drawn by PSA

Project number 18 301 Drawing number P1 08 A

Status: Planning & Listed Buildings Approval

All dimensions must be checked on site and not scaled from this drawing.

As Built