


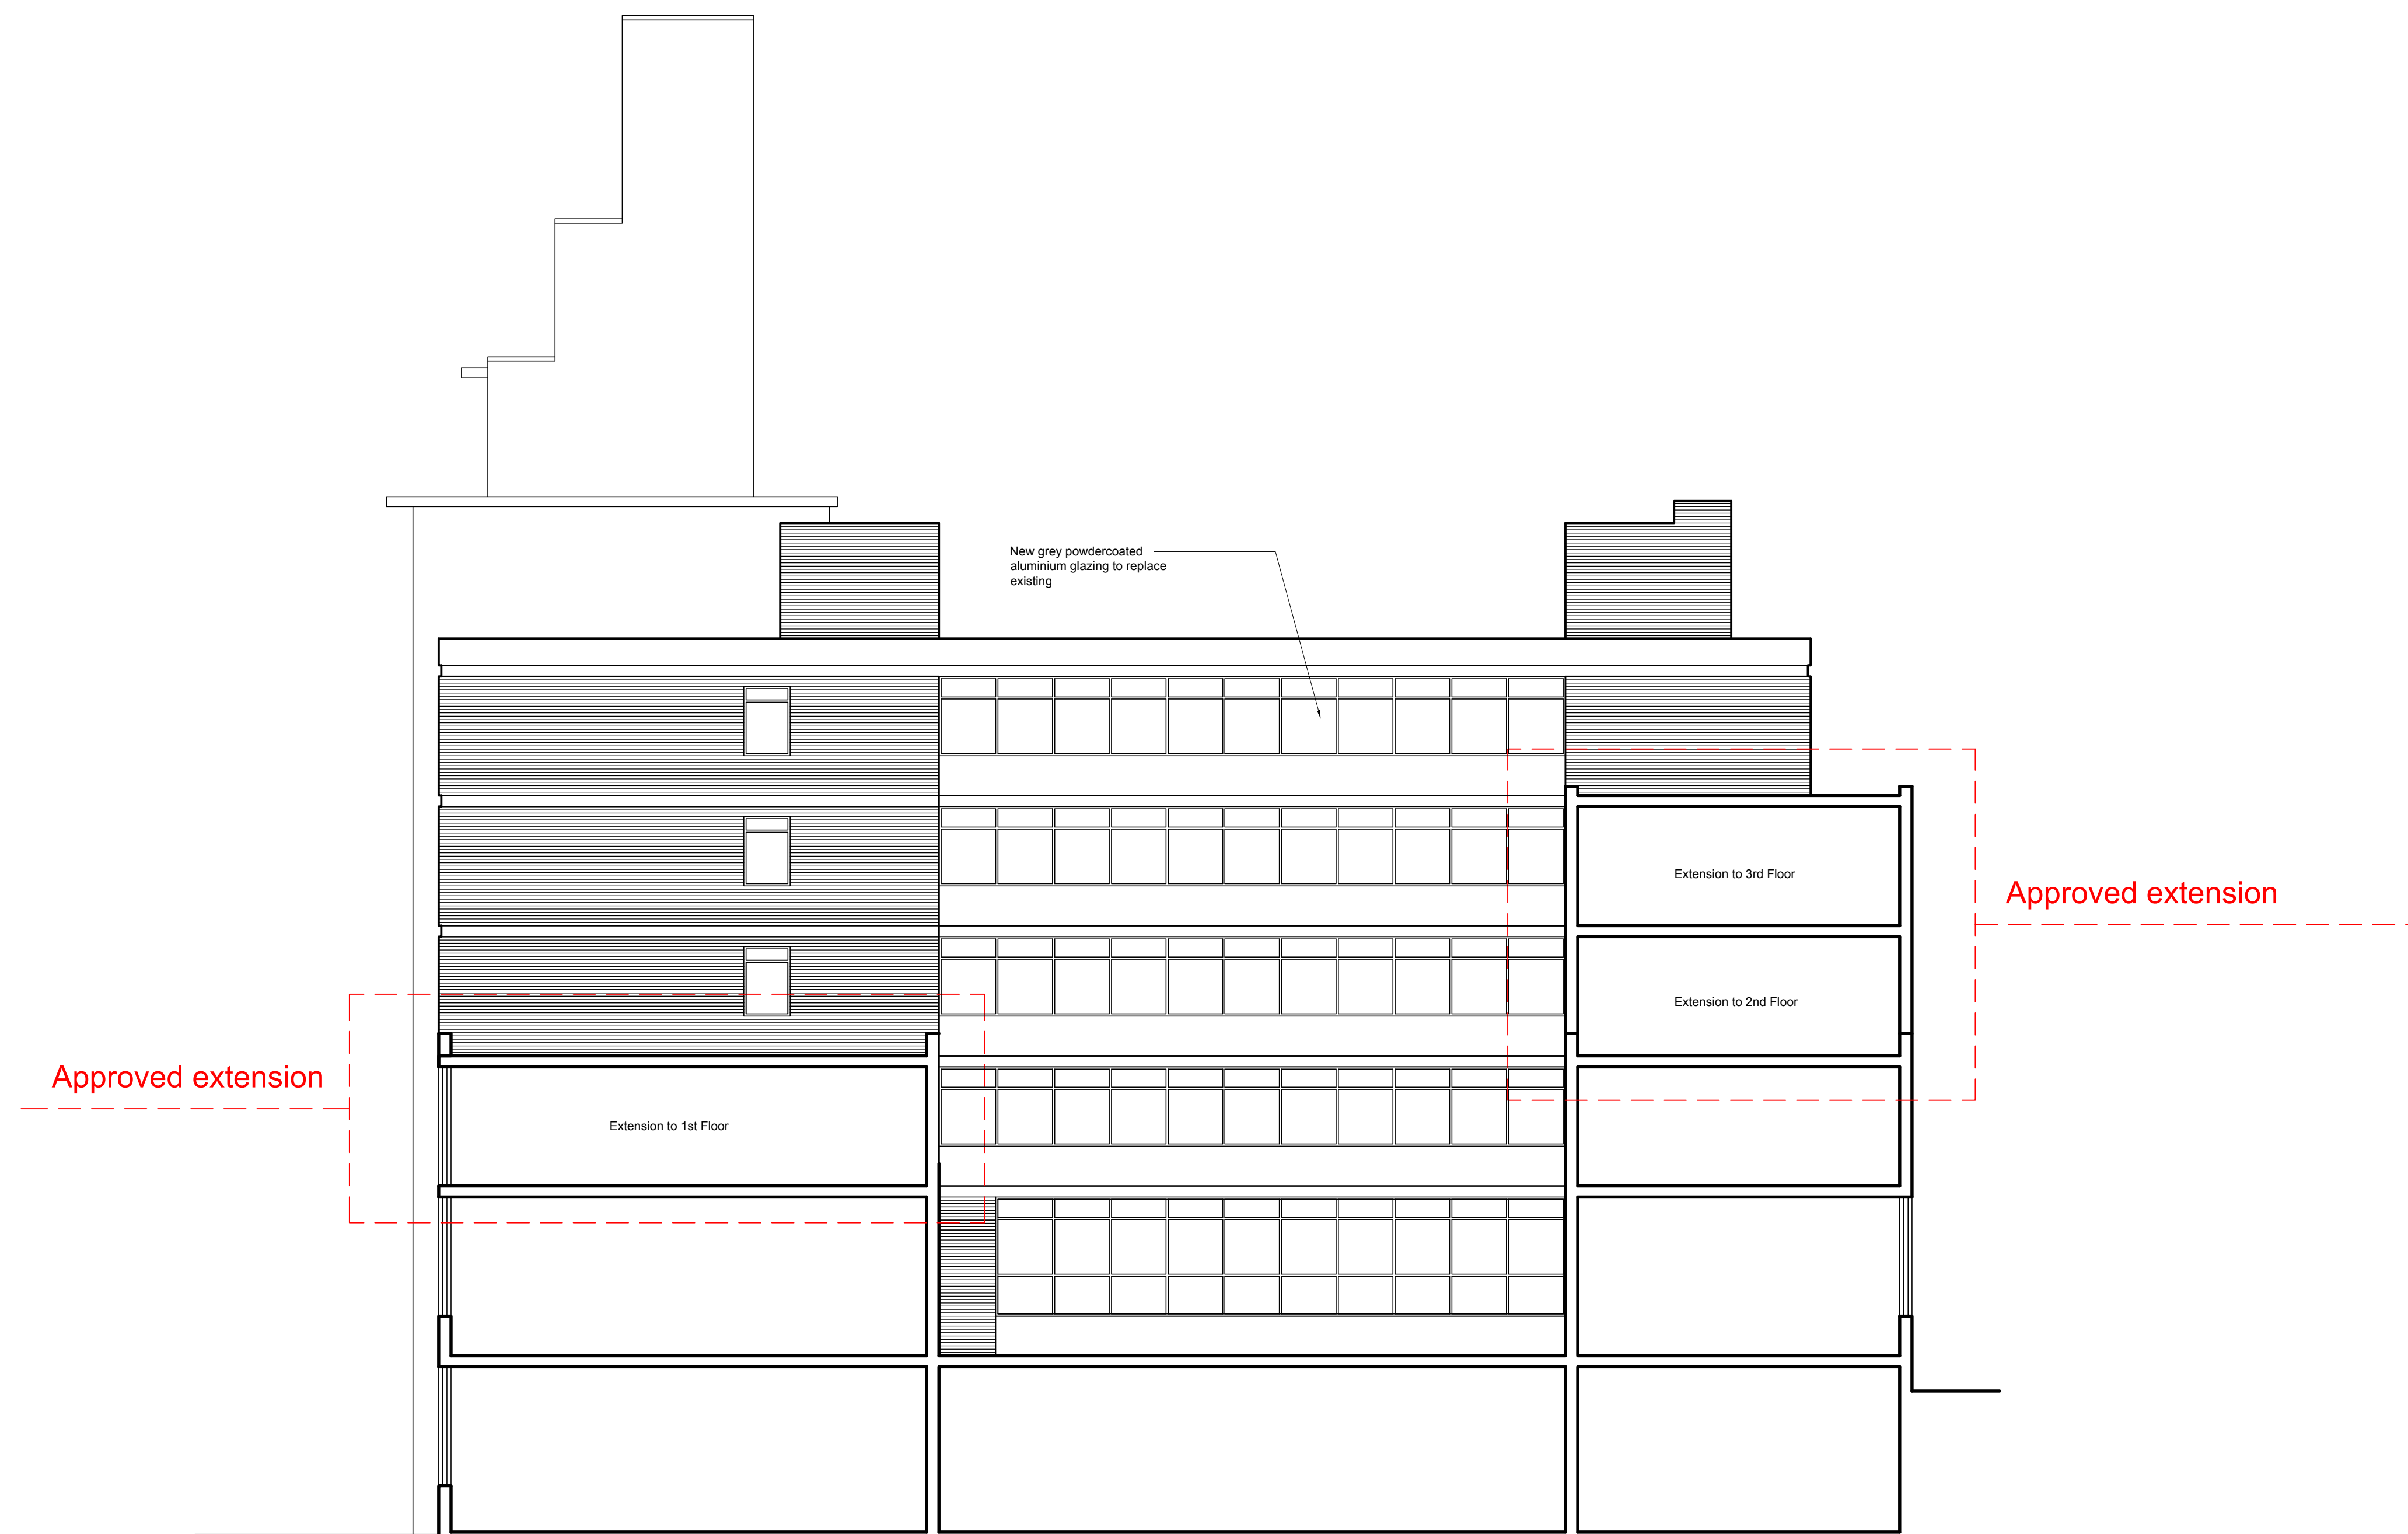

Side Elevation

revisions

ALL FIGURED DIMENSIONS TO BE CHECKED ON
SITE BY CONTRACTOR BEFORE COMMENCING
WORK.
NO DIMENSIONS SCALED FROM THIS DRAWING



client

NYRAFF LTD.

job

67 - 74 SAFFRON HILL
LONDON
EC1N 8QX

title

SIDE ELEVATION
AS BUILT

dwg no.

1500/AB4

scale 1:100 @ A1 date JAN 2017
1:200 @ A3