


6 EXISTING ELEVATION
Scale: 1:100




1 AS BUILT ELEVATION
Scale: 1:100


7 PHOTO SHOWING ORIGINAL ARRANGEMENT

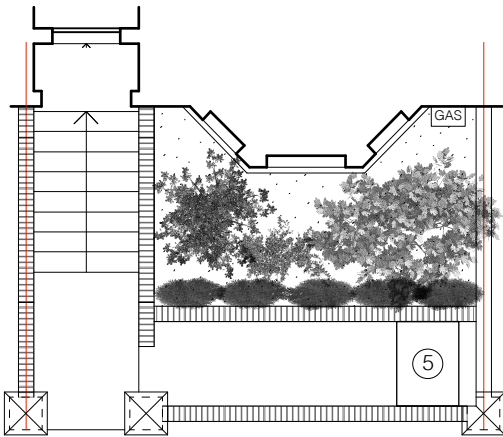


5 EXISTING PLAN - UPPER
Scale: 1:100

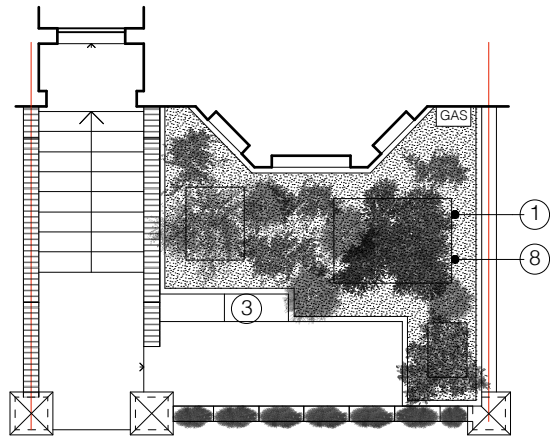

3 AS BUILT PLAN - UPPER
Scale: 1:100

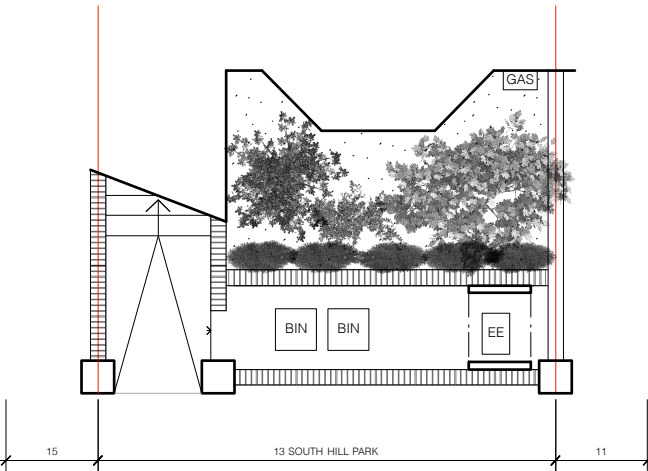

4 EXISTING PLAN - LOWER
Scale: 1:100

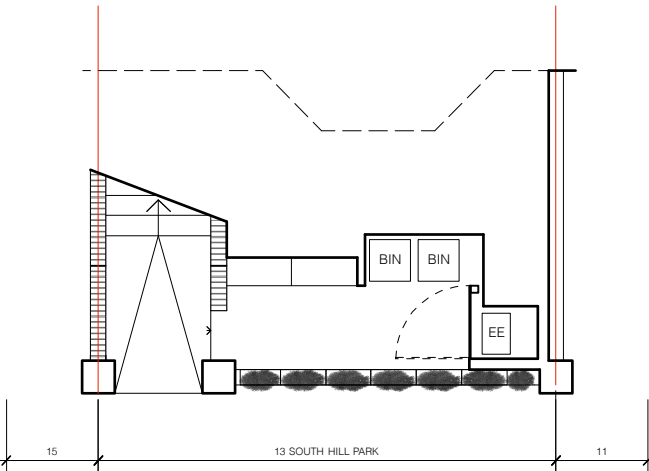

2 AS BUILT PLAN - LOWER
Scale: 1:100

PLANNING

DIMENSIONS: This drawing has been prepared from a survey provided by the Client. As a result, no warranty is given as to the precision of the dimensions indicated or illustrated. While this drawing can be used as a base drawing for construction and quotation purposes, due to the nature of the measurements, on which it is based, it is VERY IMPORTANT that all dimensions are checked carefully before any work commences. Construction is set out or any materials are ordered. If any discrepancies are noticed between this drawing and any other contract document then please contact StateStudio Ltd. immediately.

NOTES

1. BUILT-UP LEVEL FINISHED IN GRAVEL (ALLOWING SOAKAWAY)
2. DARK GREY PAINTED TIMBER PLANKS
3. SLATE TOP
4. BLOCK
5. CONCRETE SLAB
6. WHITE PAINTED RENDER
7. EXISTING BRICK
8. DEEP BEDS FOR MATURE PLANTING
9. DARK GREY PAINTED EAVES

REV	DATE	ISSUER	COMMENTS
-----	------	--------	----------

CLIENT:
A. SCRIVENER
PROJECT ADDRESS:
13 SOUTH HILL PARK, LONDON, NW3 2ST
PROJECT CODE:
A069

DRAWING NAME:
**EXISTING & PROPOSED
PLANS & FRONT ELEVATION**

DRAWING NO.: **PA1-002** REVISION: **-** DATE: **MAR 2019** DRAWN: **JBB** CHECKED: **JBB**

SCALE:
1:100 @ A3

StateStudio

statestudiolt.com
0203 637 2922
architecture@statestudiolt.com
12 Crown Works
Temple Street
London E2 6QQ

© STATESTUDIO LIMITED 2019
The design and drawings remain the property of StateStudio Ltd. The client for this project will be licensed to use this design and documents on this site only upon full payment of architectural fees. This license is non-transferable. The design and drawings shall not be reproduced, uploaded to the internet or traced without the permission of StateStudio Ltd.
DIMENSIONS
This drawing has been prepared from a survey provided by the Client. As a result, no warranty is given as to the precision of the dimensions indicated or illustrated. While this drawing can be used as a base drawing for construction and quotation purposes, due to the nature of the measurements, on which it is based, it is VERY IMPORTANT that all dimensions are checked carefully before any work commences. Construction is set out or any materials are ordered. If any discrepancies are noticed between this drawing and any other contract document then please contact StateStudio Ltd. immediately.