

No. 61

No. 63

65
Fitzjohns
Avenue

63
Fitzjohns
Avenue

NETHERHALL GARDENS

CASE COPY

LONDON BOROUGH OF CAMDEN
TOWN AND COUNTRY PLANNING ACTS

8 JUN 1982

PLANS ~~NOT~~ APPROVED
ON BEHALF OF THE COUNCIL

CTP/F7/6/3/33804(21)

DDA

DINERMAN DAVISON ASSOCIATES
Chartered Architects

22 Perrins Walk Hampstead London NW3 6TJ 01-435 0038-9-0

revisions *new wall moved 10" in to give garden access* *28/2/82* *DP* *dates*
new & altered wall marked on

63 NETHERHALL GARDENS N.W.3

proposed new house - basement plan

drawn by
btd
date
Sept 81


drawing no.
848/8
scale
1/8"



FRONT ELEVATION




SIDE ELEVATION

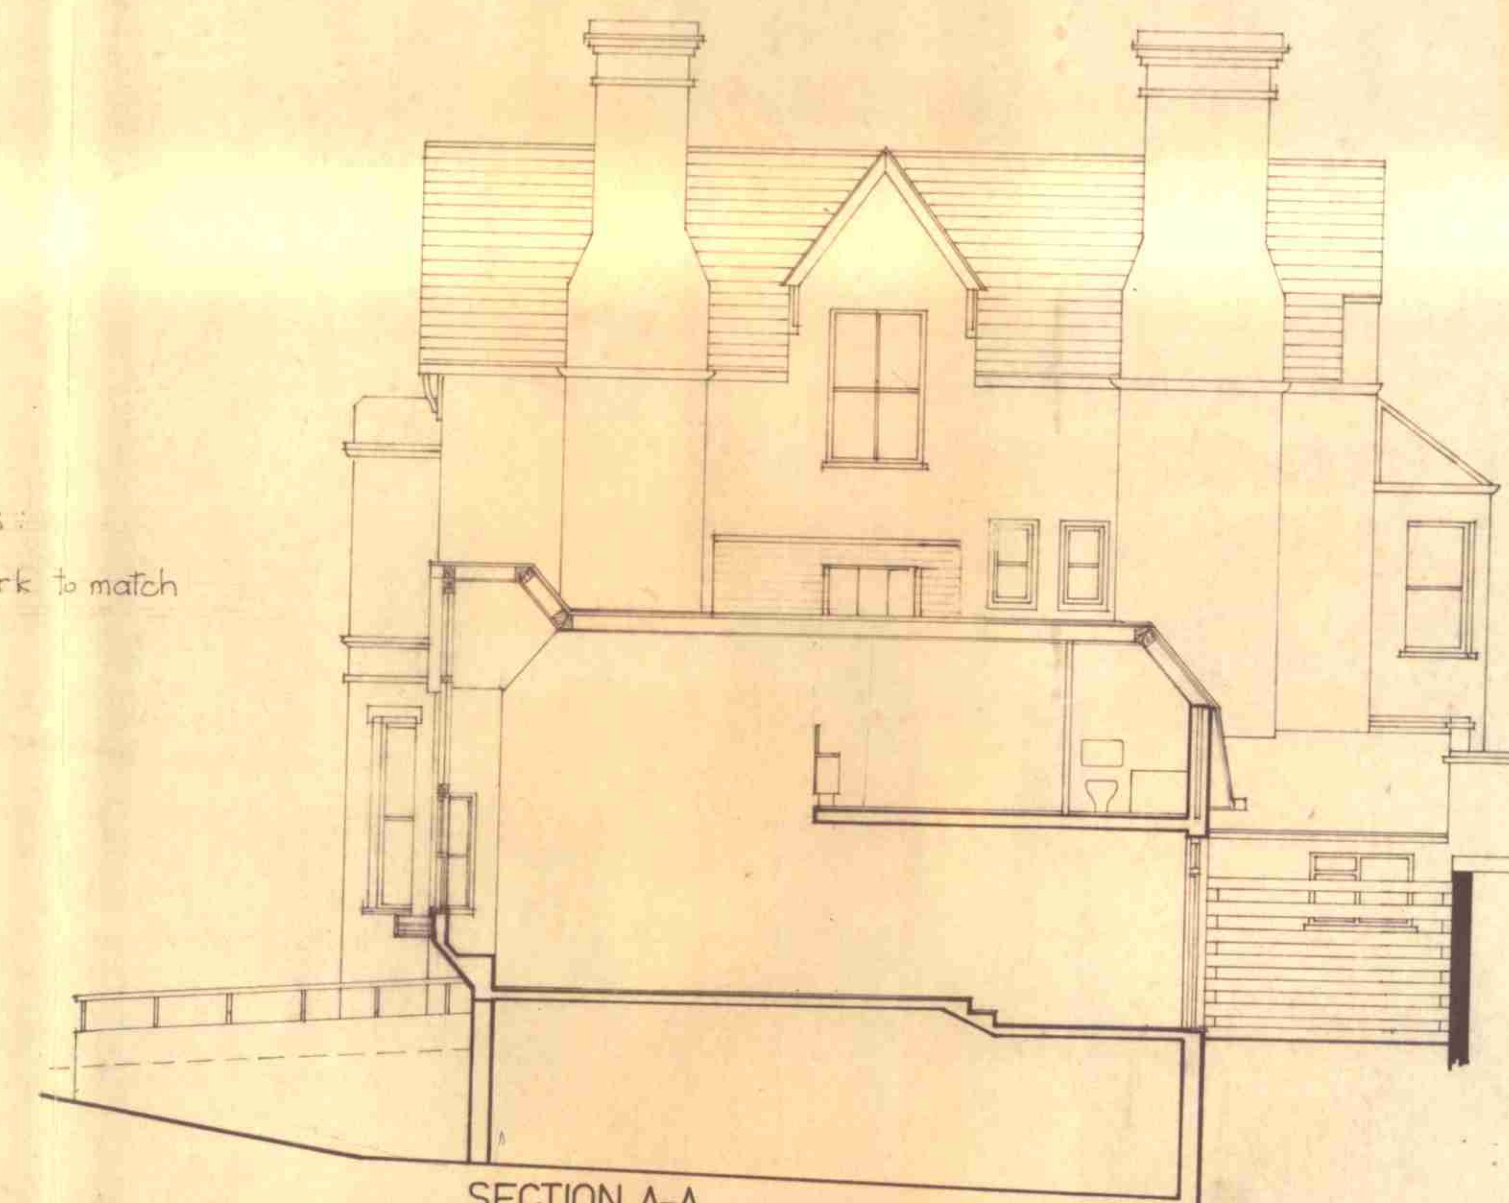


SECTION A-A

MATERIALS:
slate roof;
red brickwork to match
existing

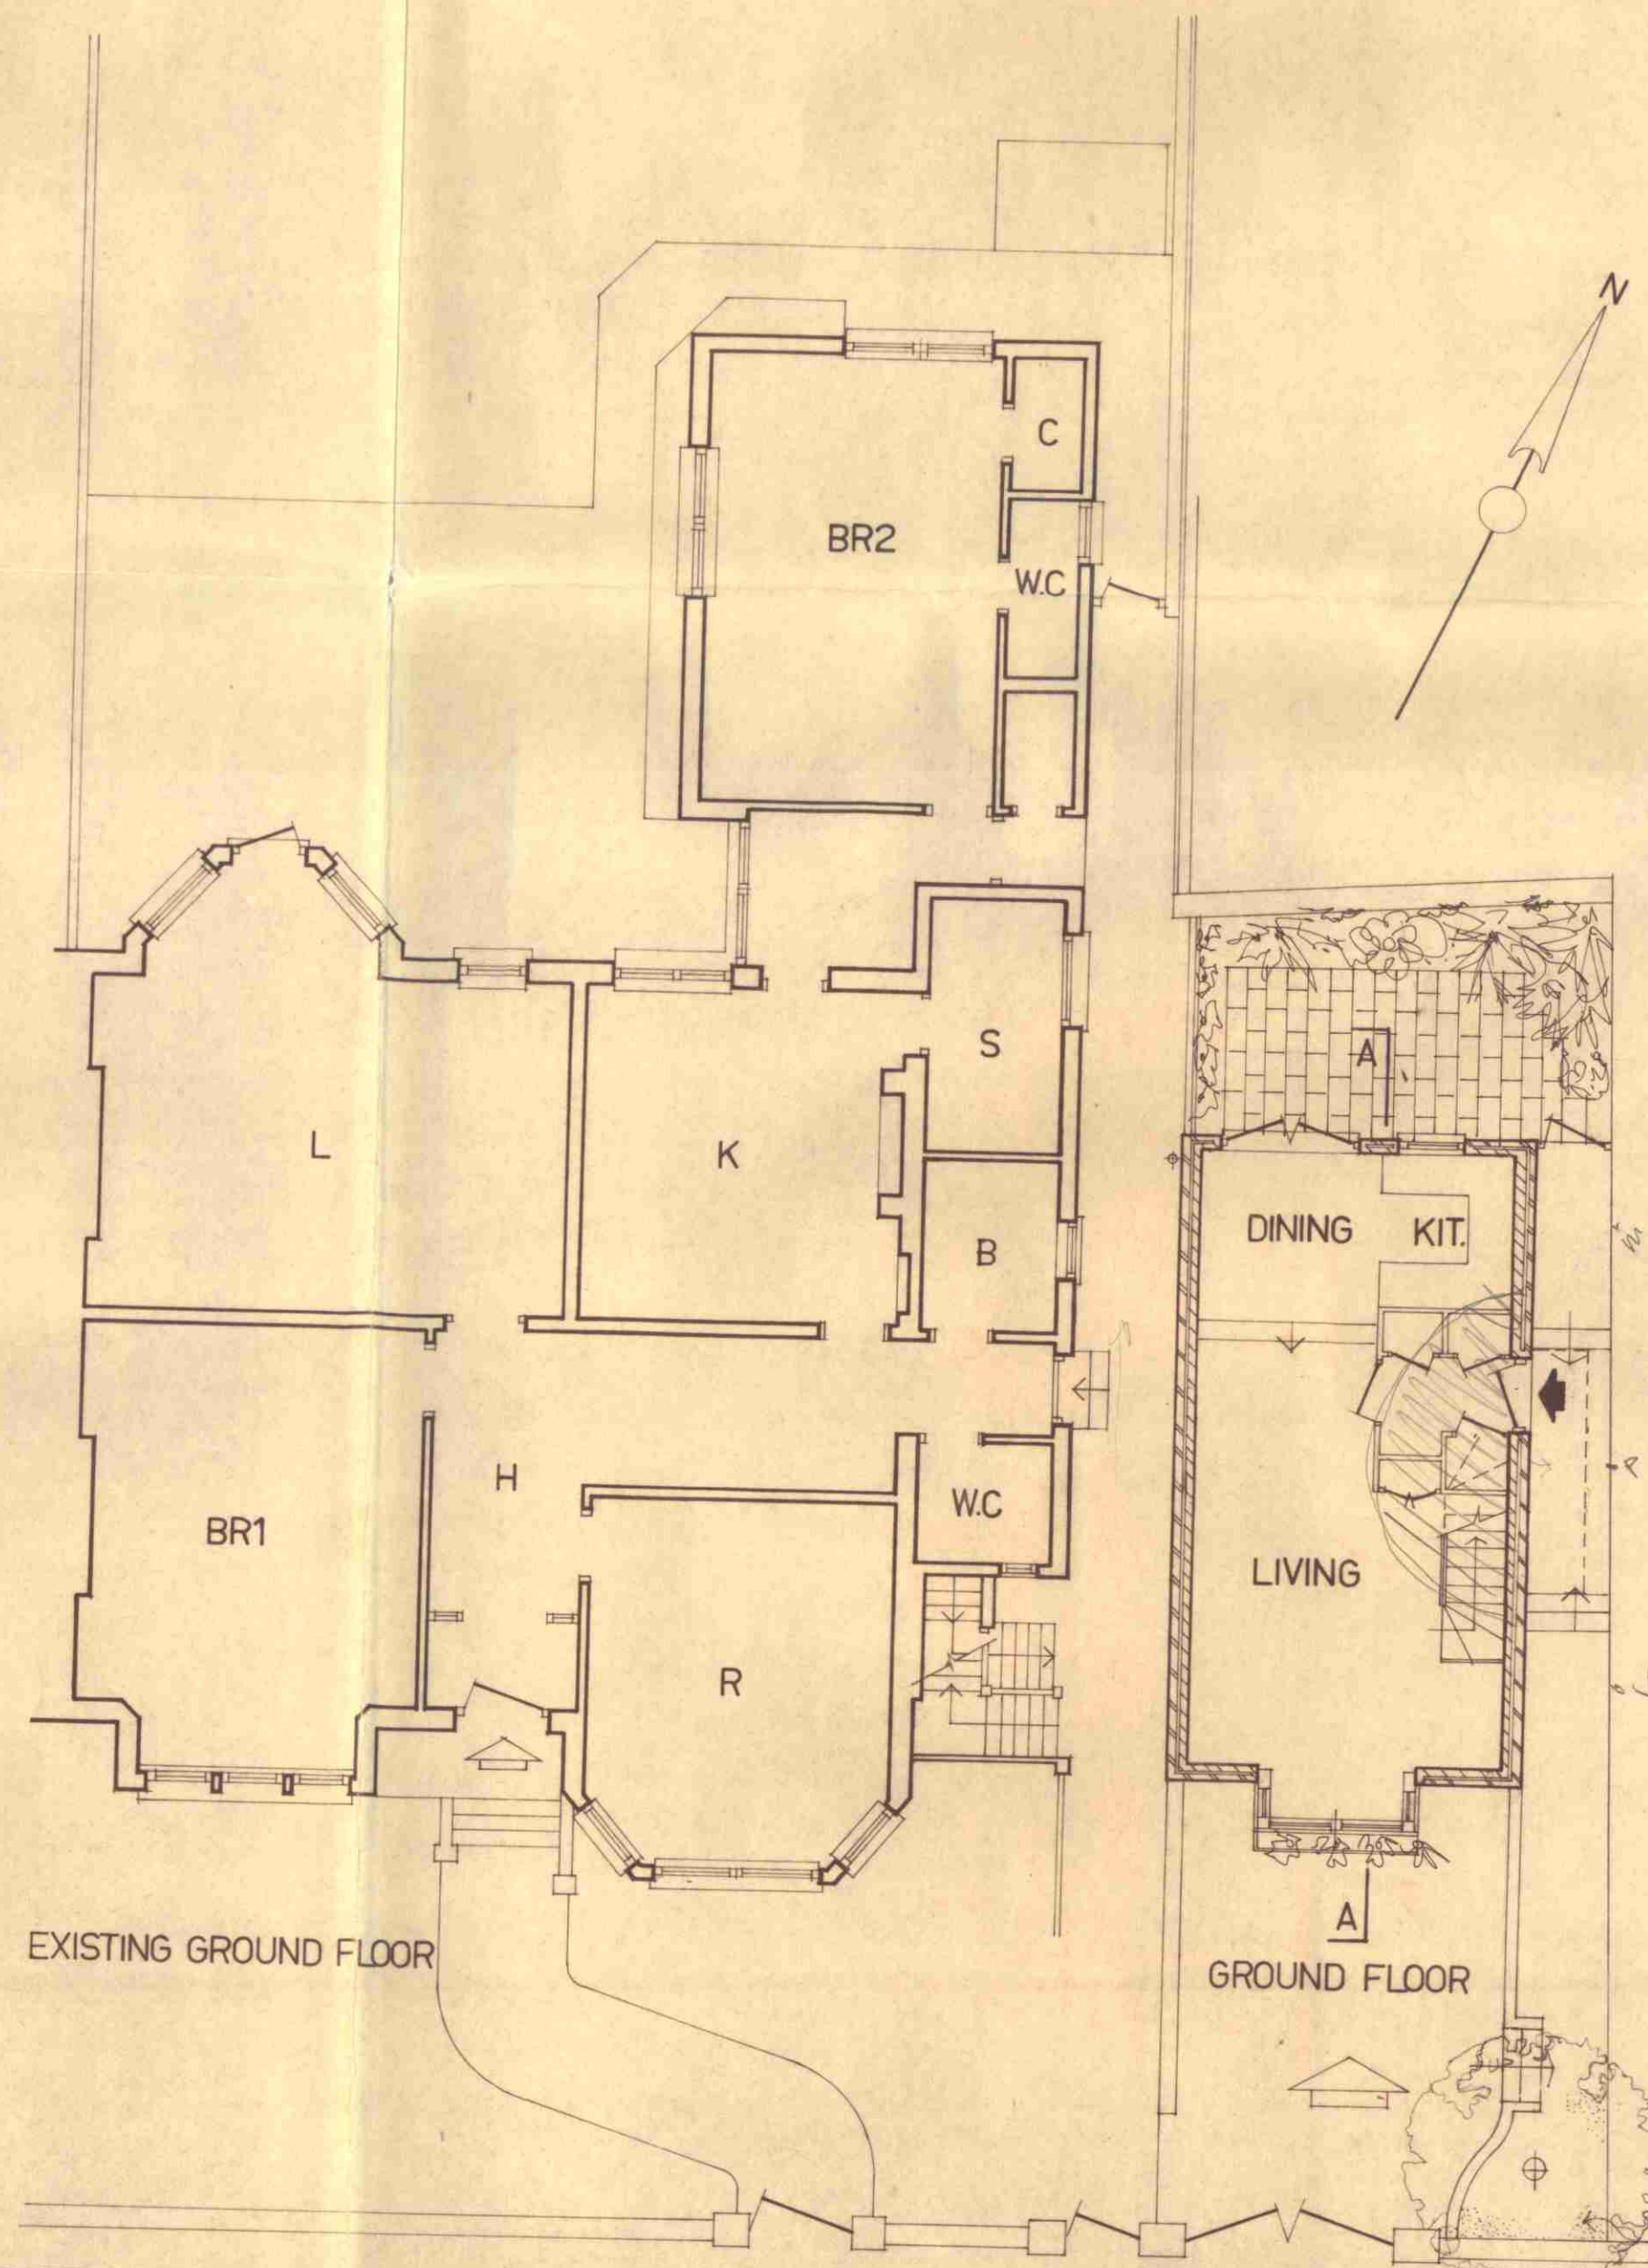


EXISTING GROUND FLOOR

GROUND FLOOR

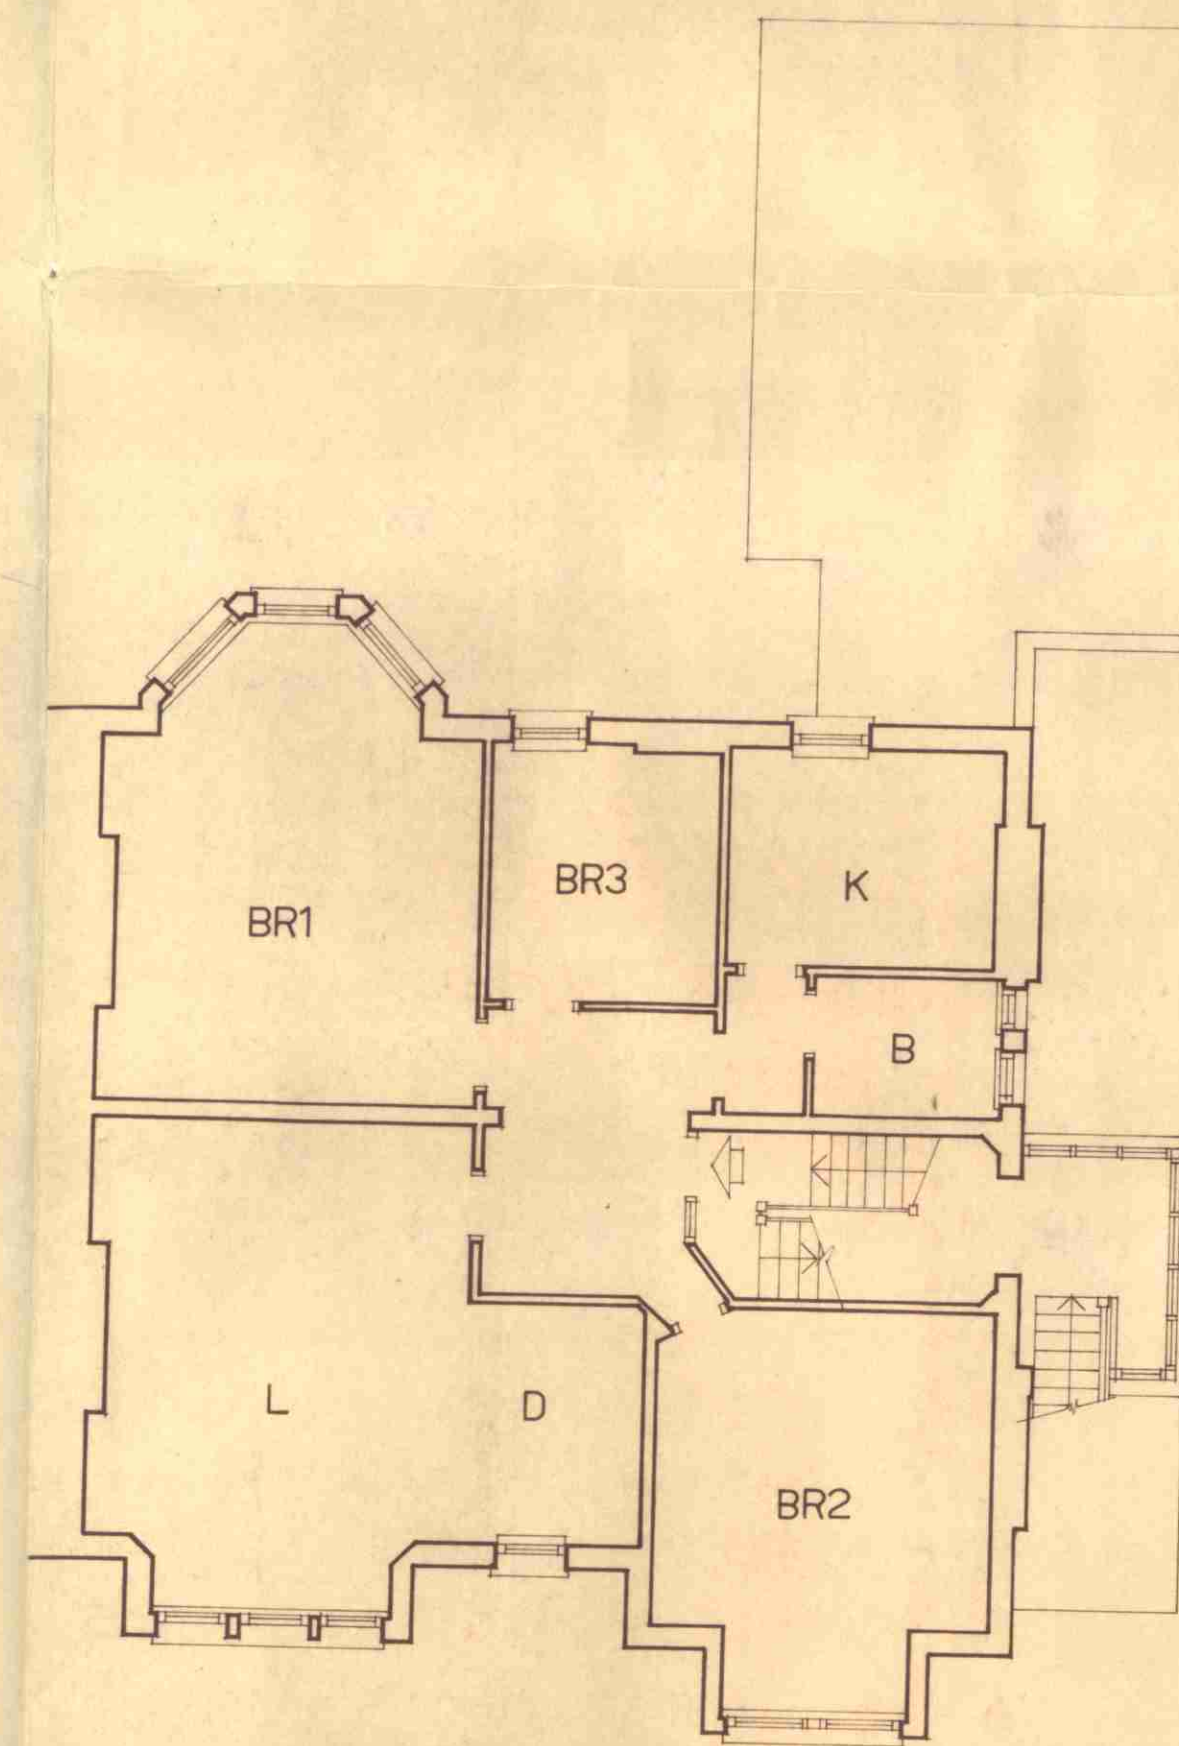

EXISTING FIRST FLOOR

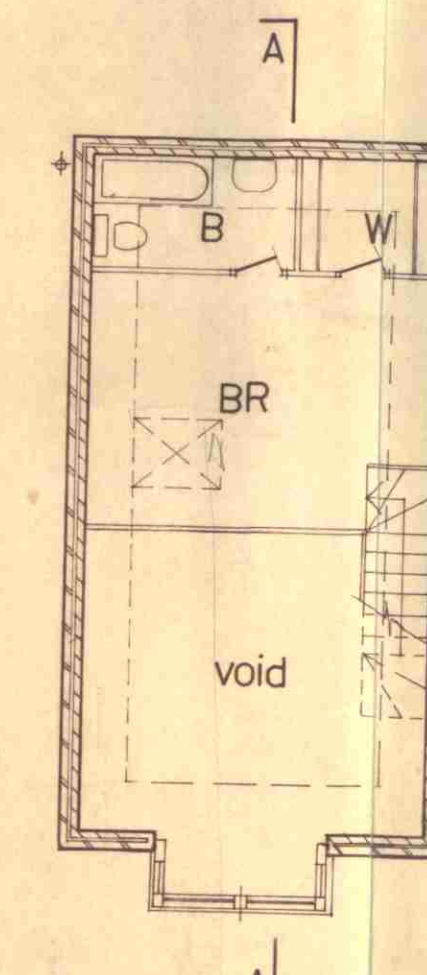

FIRST FLOOR

CASE COPY
LONDON BOROUGH OF CAMDEN
TOWN AND COUNTRY PLANNING ACTS
8 JUN 1982
PLANS ~~NOT~~ APPROVED
ON BEHALF OF THE COUNCIL

CTP/F7/6/3/33804(2)

DDA

DINERMAN DAVISON ASSOCIATES
Chartered Architects

22 Perrins Walk Hampstead London NW3 6TJ 01-435 0038-9-0

revisions A new stone finish omitted; house plan requested
B. 1981. 1981. 1981. 1981. 1981.
C. 1982. 1982. 1982. 1982. 1982.

dates
28/6/82 JPD
28/4/82 JPD

revisions

dates

63 NETHERHALL GARDENS, N.W.3

proposed new studio house

drawn by
jem
date
25/2/82

drawing no.
848/9 A
scale
1/8"