
## AS BUILT



## ILLUMINATION NOT TO EXCEED 400 CANDELAS

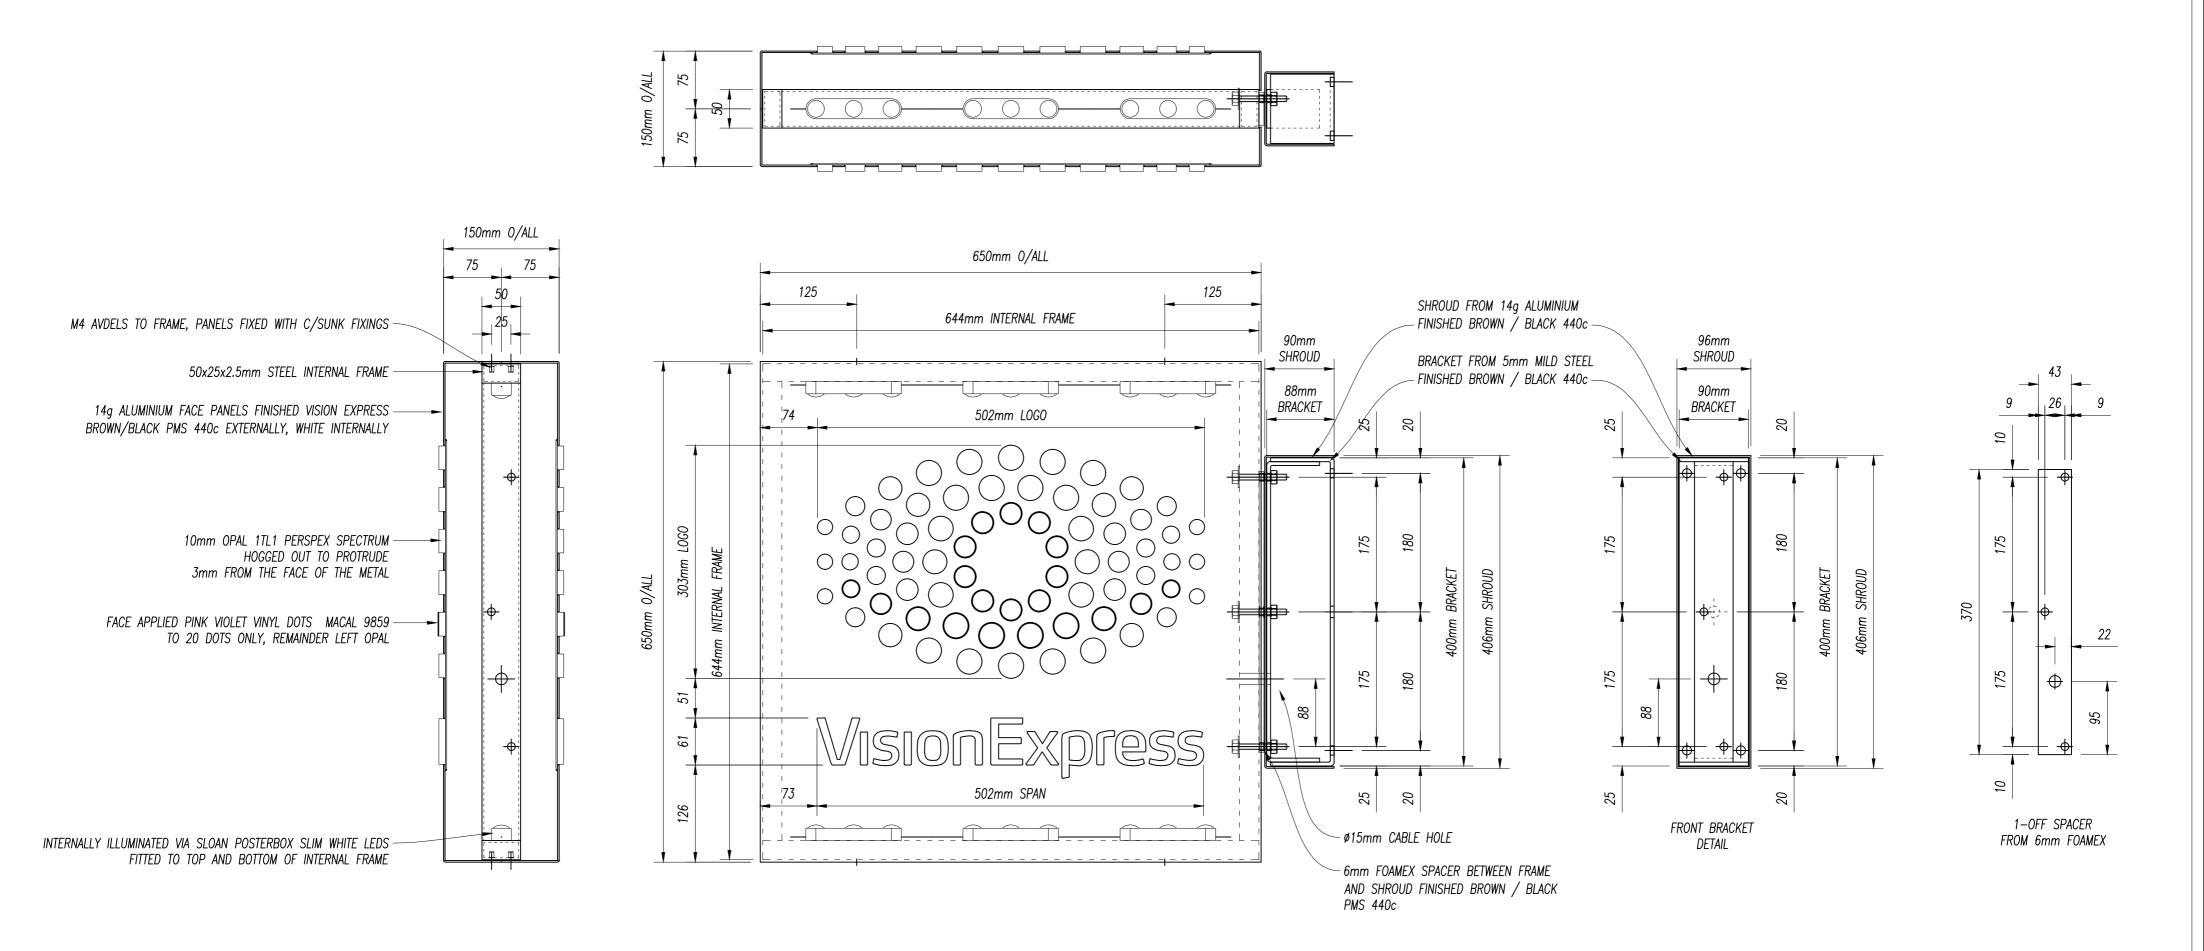

Job Title Drawing No. TWO Scale Drawn By Blaze Date VISION EXPRESS SWISS COTTAGE 1:5 @ A2 27:MARCH:2019 P.MAYER Revisions LONDON SONS OR TO BE USED FO