


ELEVATION @ 'A'


SOUTH WEST ELEVATION SHOWING SECTION OF NURSERY EXTENSION

SOUTH EAST ELEVATION OF NURSERY EXTENSION


NORTH EAST ELEVATION OF LIBRARY

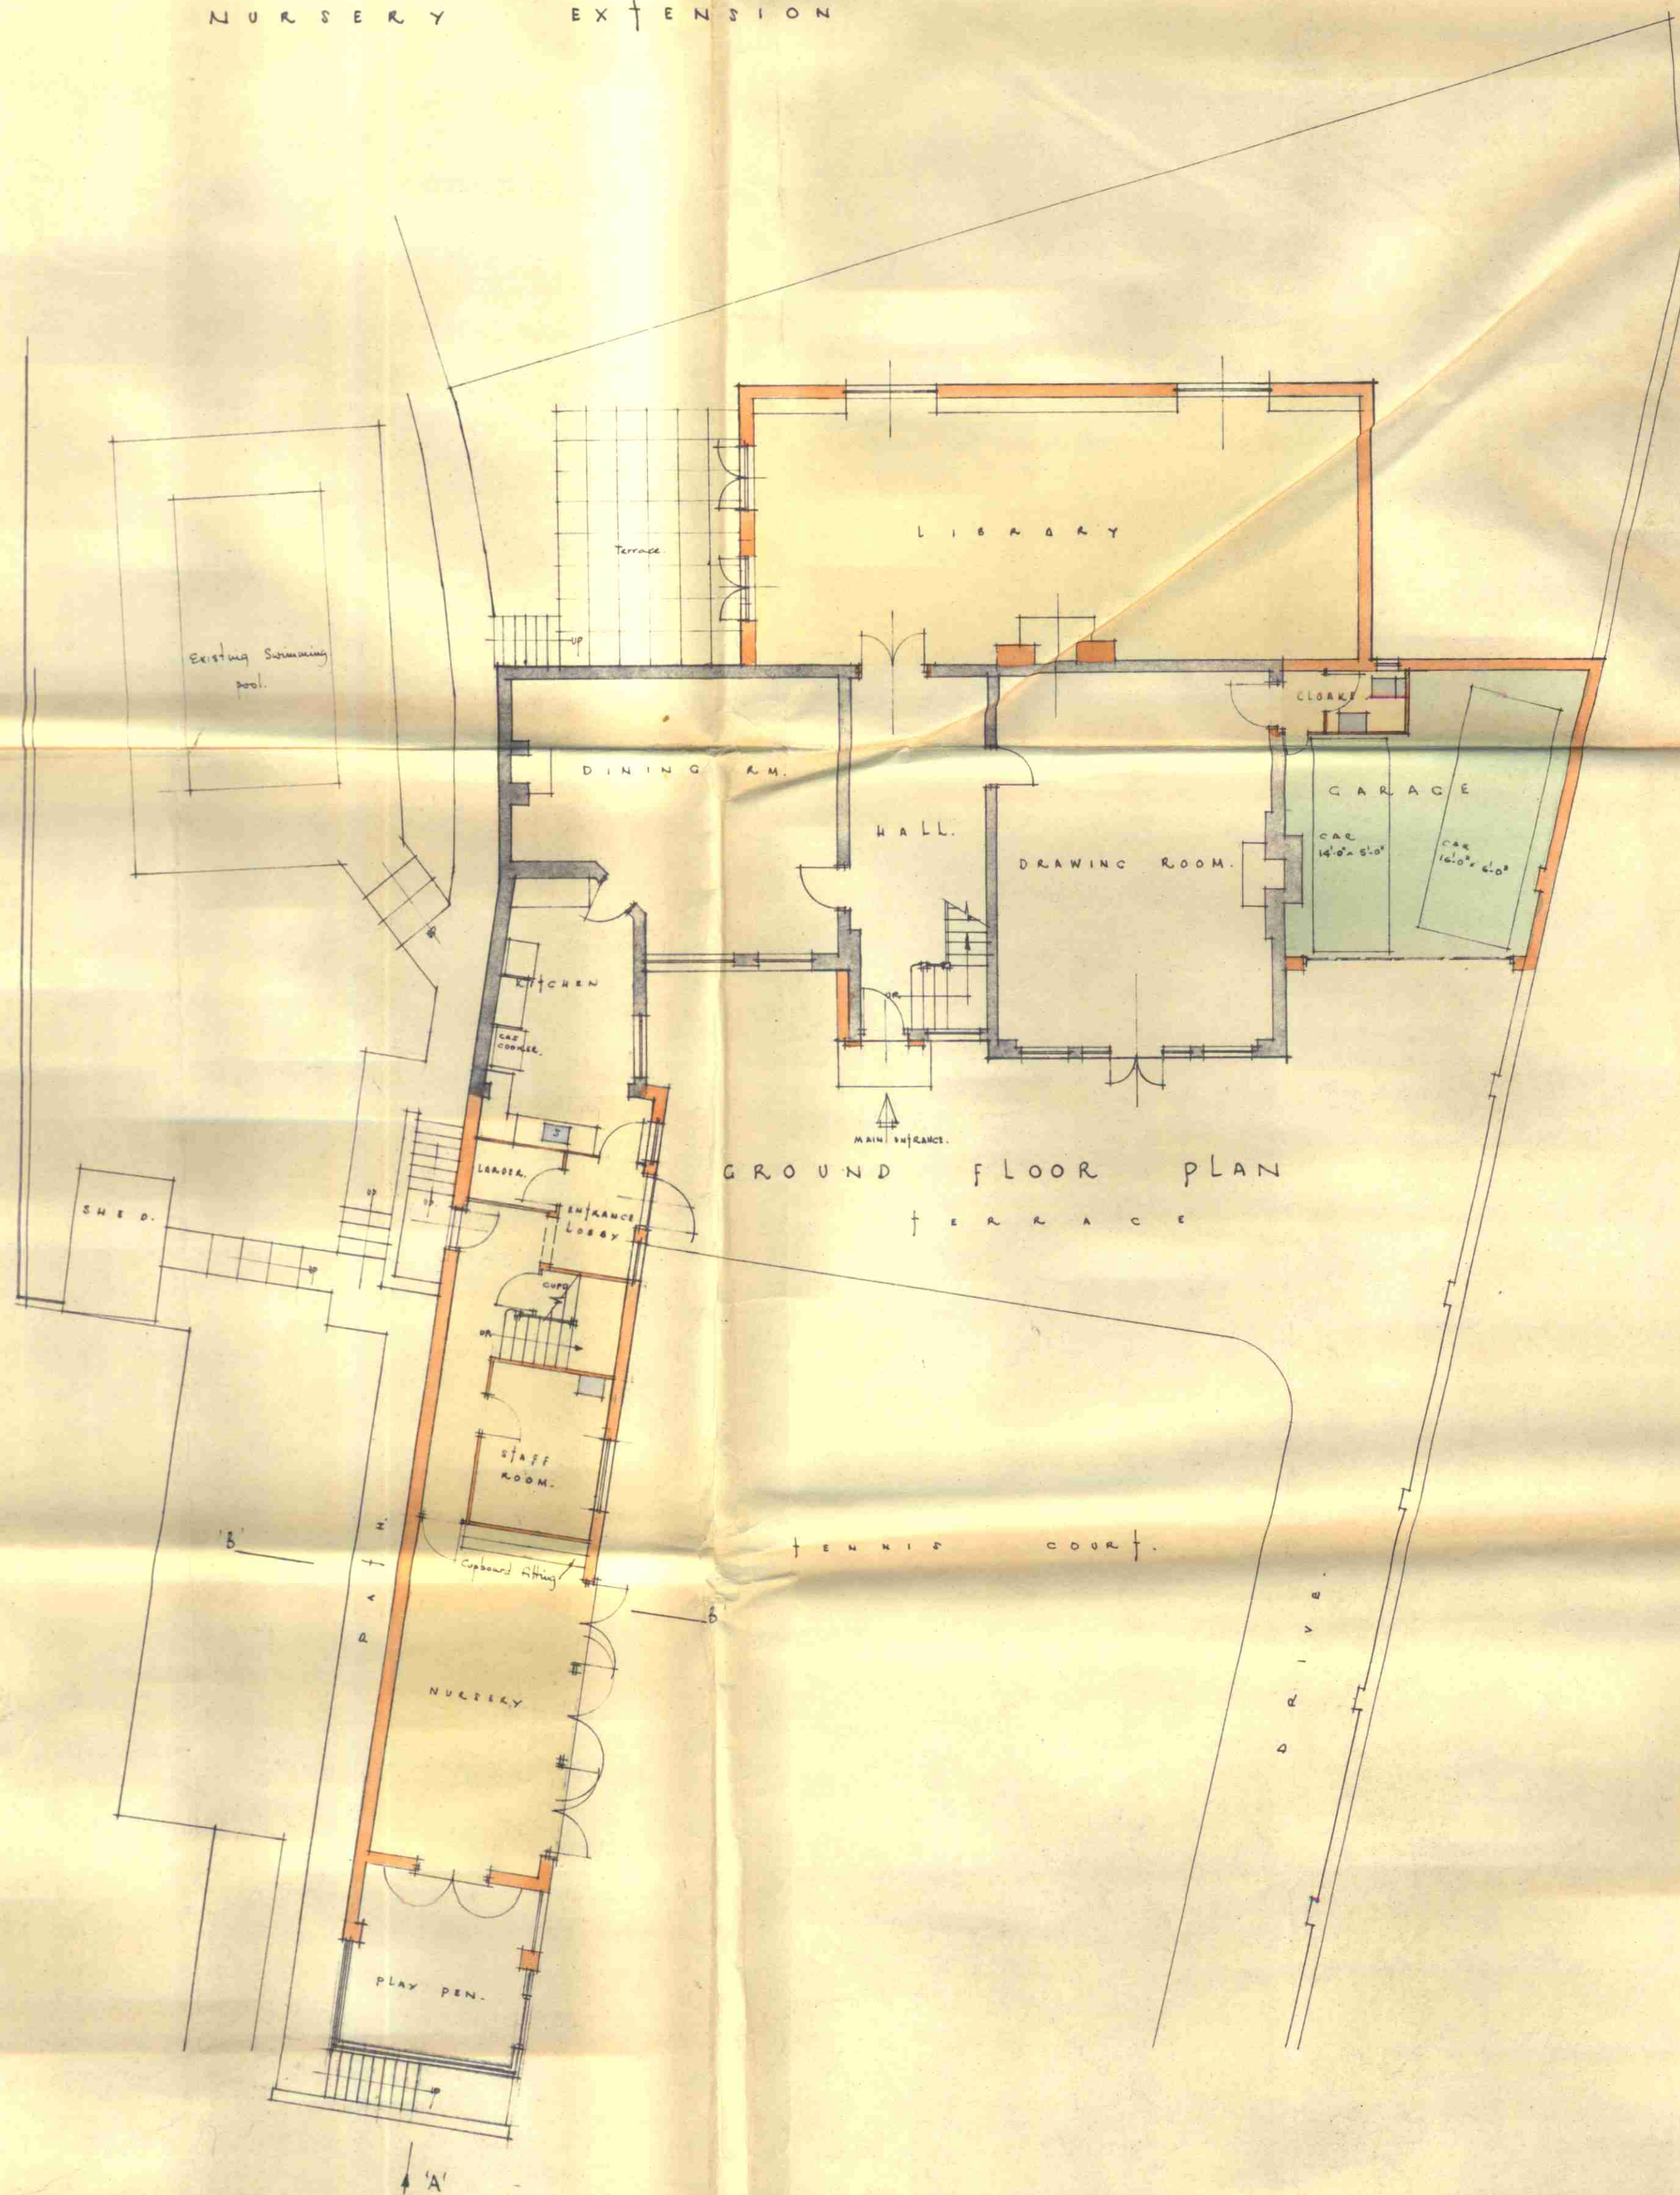


GROUND FLOOR PLAN

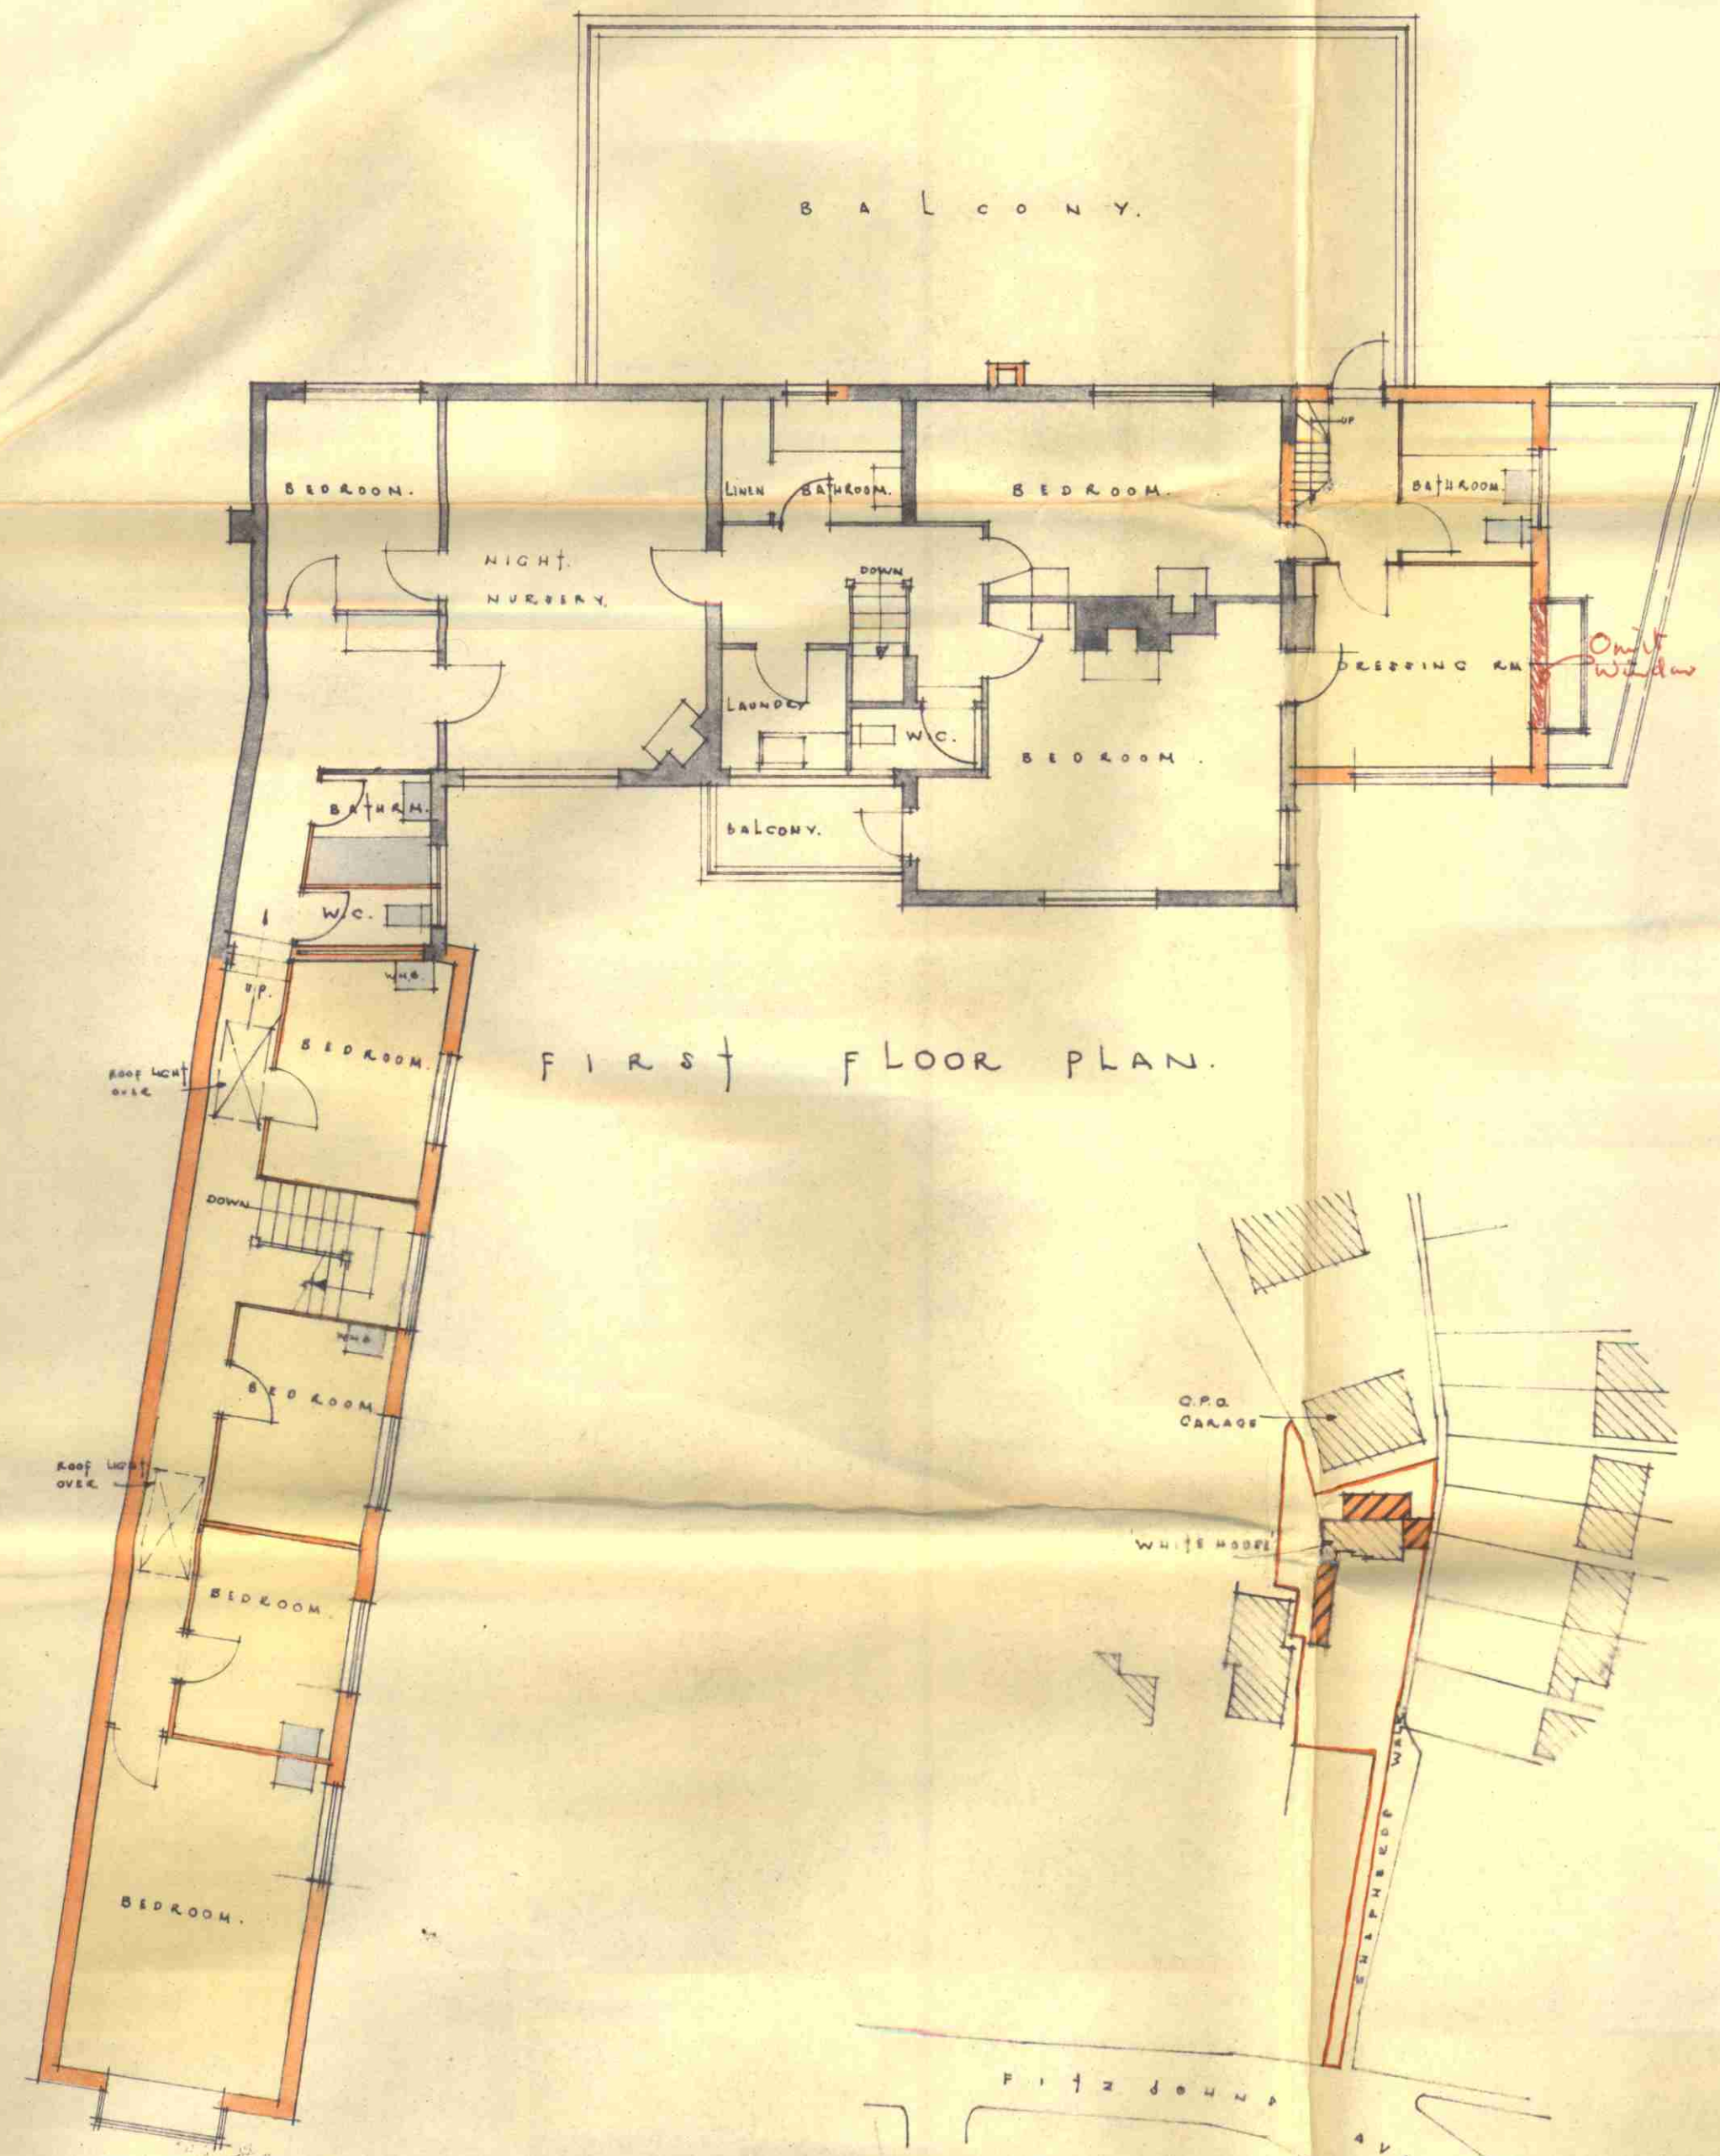

FIRST FLOOR PLAN

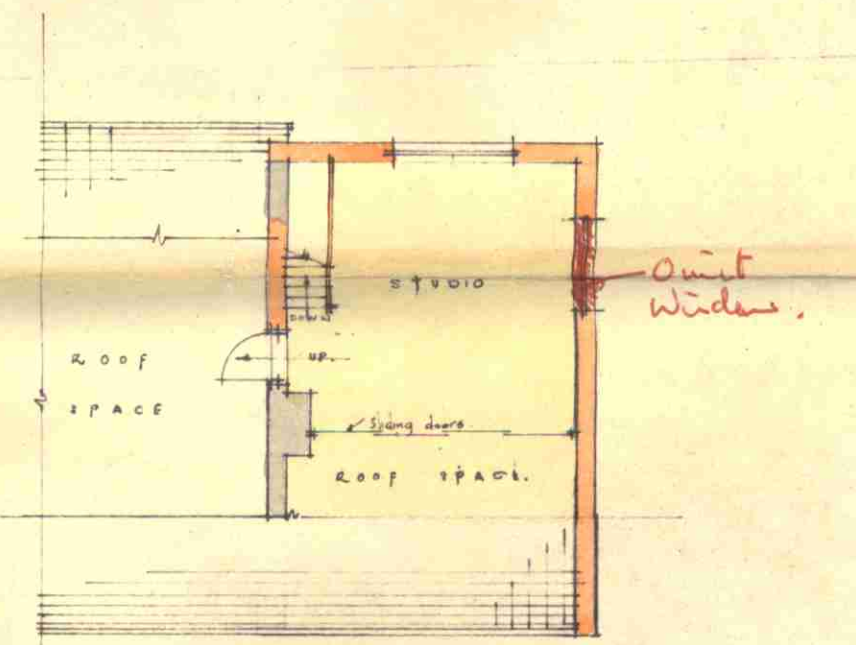

SECOND FLOOR PLAN

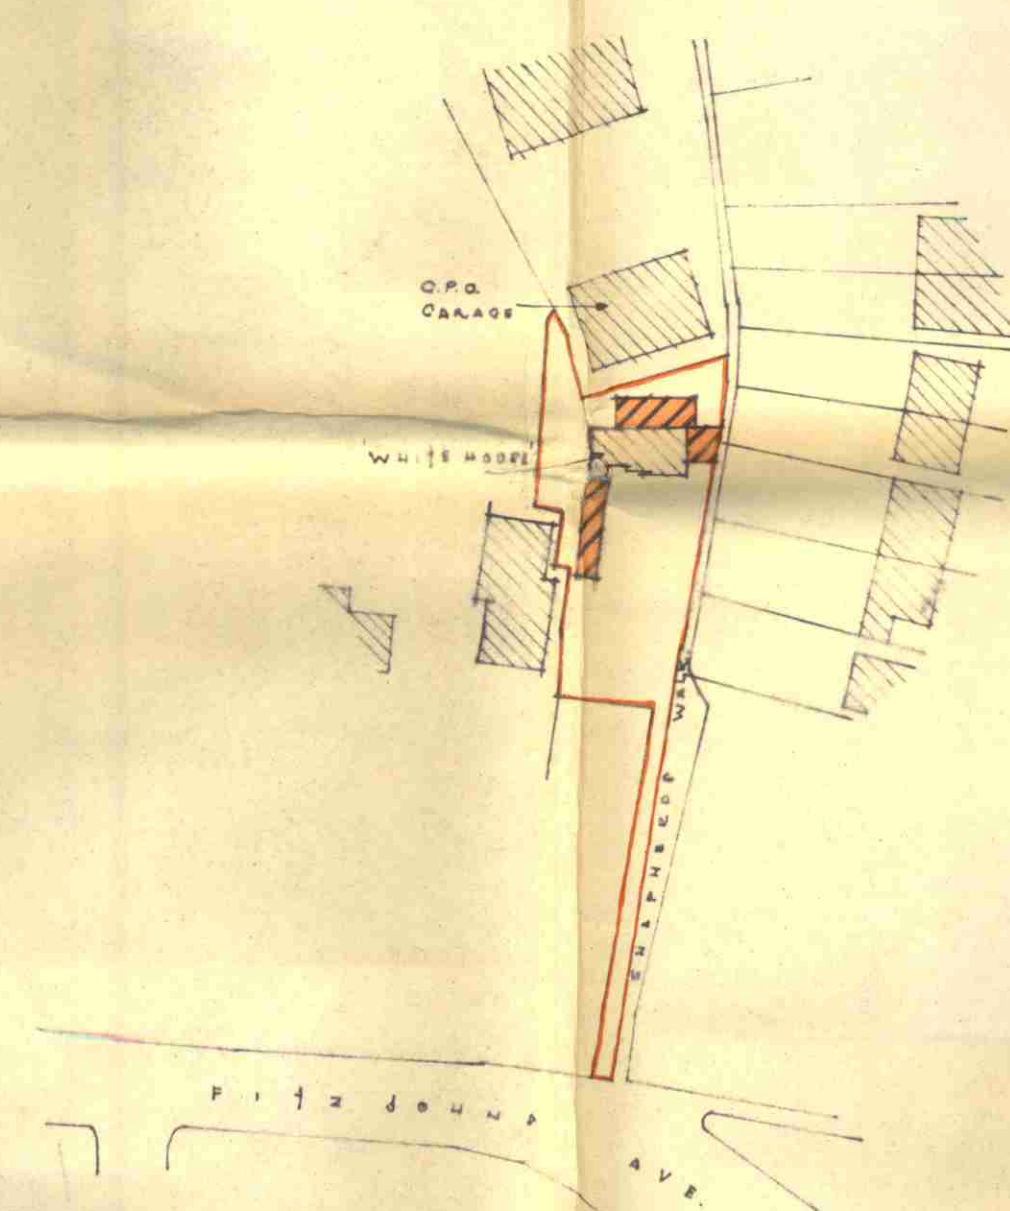

BLOCK PLAN
SCALE: 1/1250

Amendment Red Ink.
P. Thorne
for Richardson & McLaughlan
5th April 1960

26454

1 MAR 1960

DRAWING NUMBER
55122/55 15 250
SCALE: 1/1250
OCT 28 1959

PROPOSED EXTENSIONS & ALTERATIONS FOR J. W. LOVERIDGE ESQ.,
AT THE WHITE HOUSE, FITZJOHNS AVENUE, HAMPSHIRE, N. W. 3.

RICHARDSON & McLAUGHLAN
CHARTERED ARCHITECTS
15 MADEFIELD STREET,
LONDON W.1.