




01 ELEVATION A
1:50 @ A1 1:100 @ A3

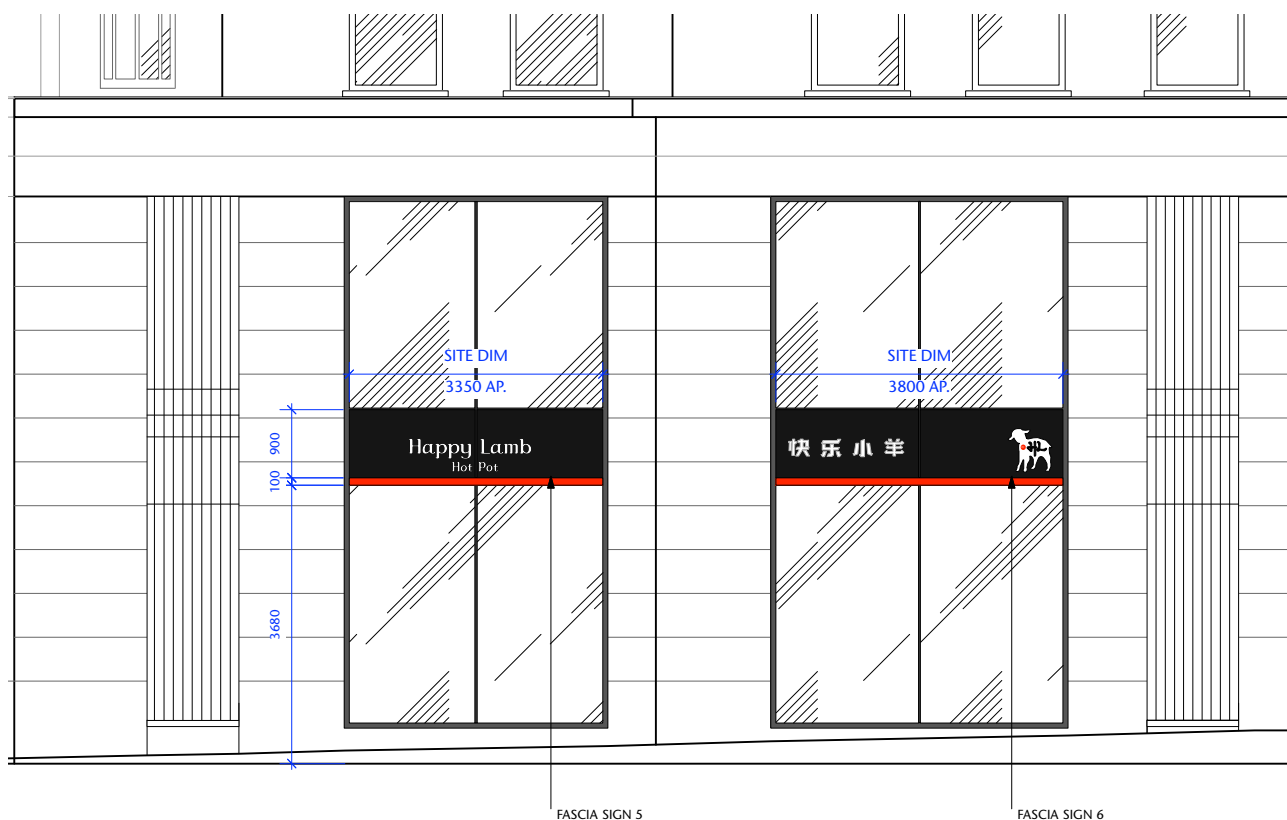

02 ELEVATION B
1:50 @ A1 1:100 @ A3

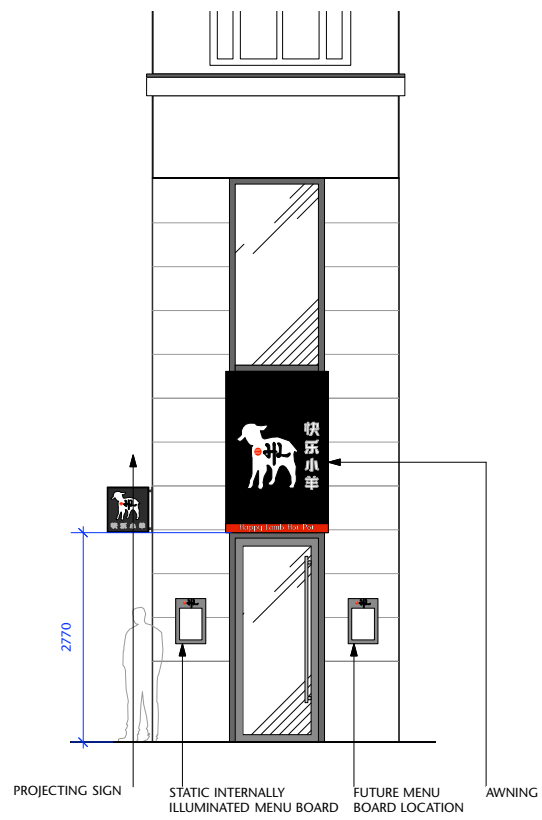

03 ELEVATION C
1:50 @ A1 1:100 @ A3

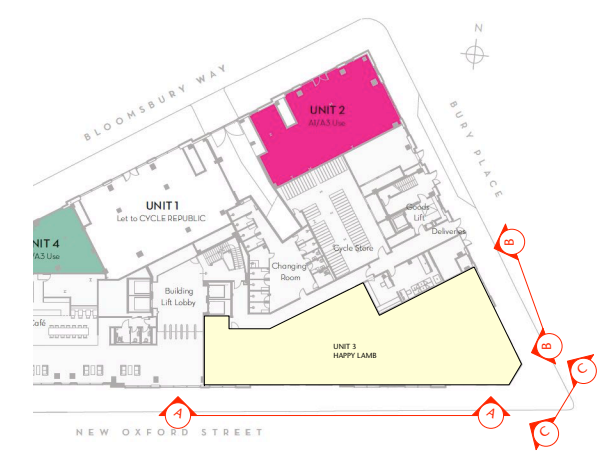

04 KEY PLAN
NTS

Notes
This drawing should not be scaled. The contractor is to verify all dimensions and conditions on site. This drawing is the property of Fusion and they reserve the copyright. It is issued on the understanding that it will not be copied, reproduced or disclosed in whole or in part to any unauthorised party without written permission from Fusion.

L	27.03.19	BLACK VINYL REPLACED WITH WINDOW FILM
K	26.03.19	SIGNAGE REDUCED, LANDSCAPE VINYL REMOVED
J	01.03.19	FASCIA'S AMENDED AS PER CLIENT COMMENT
H	28.02.19	HAPPY LAMB HOT POT FASCIA AMENDED
G	27.02.19	HAPPY LAMB HOT POT FASCIA LAYOUT AMENDED, WHITE SOLID LAMB ADDED TO AWNING, MENU BOX STATIC
F	25.02.19	LANDSCAPE DESATURATED
E	22.02.19	WORDING AMENDED
D	15.02.19	DIMENSIONS AND FONT REVISED. GRAPHIC UPDATED
C	30.01.19	SECOND MENU BOARD ADDED
B	14.01.19	ENTRANCE AWNING AMENDED.
A	16.11.18	GENERAL UPDATED TO SIGNAGE LOCATIONS AND DIMENSIONS

FUSION
design and architecture

4 Ribborough Street London SE1 0HE
Tel: 020 7928 9982 Fax: 020 7928 9994
email: mail@fusiondna.co.uk

Job Name: **HAPPY LAMB**
Site Address: **UNIT 3
10 BLOOMSBURY WAY
LONDON
WC1**
Dwg Name: **PROPOSED SHOPFRONT**
Status: **AS BUILT**

Drawn by: EC/LS
Scale: 1:50@A1 1:100@A3
Checked by:
Date: OCT 2018

Job/Dwg No: **161-01-301-L**