


NOTES

DO NOT SCALE FROM THIS DRAWING

PLANNING

NOTE:

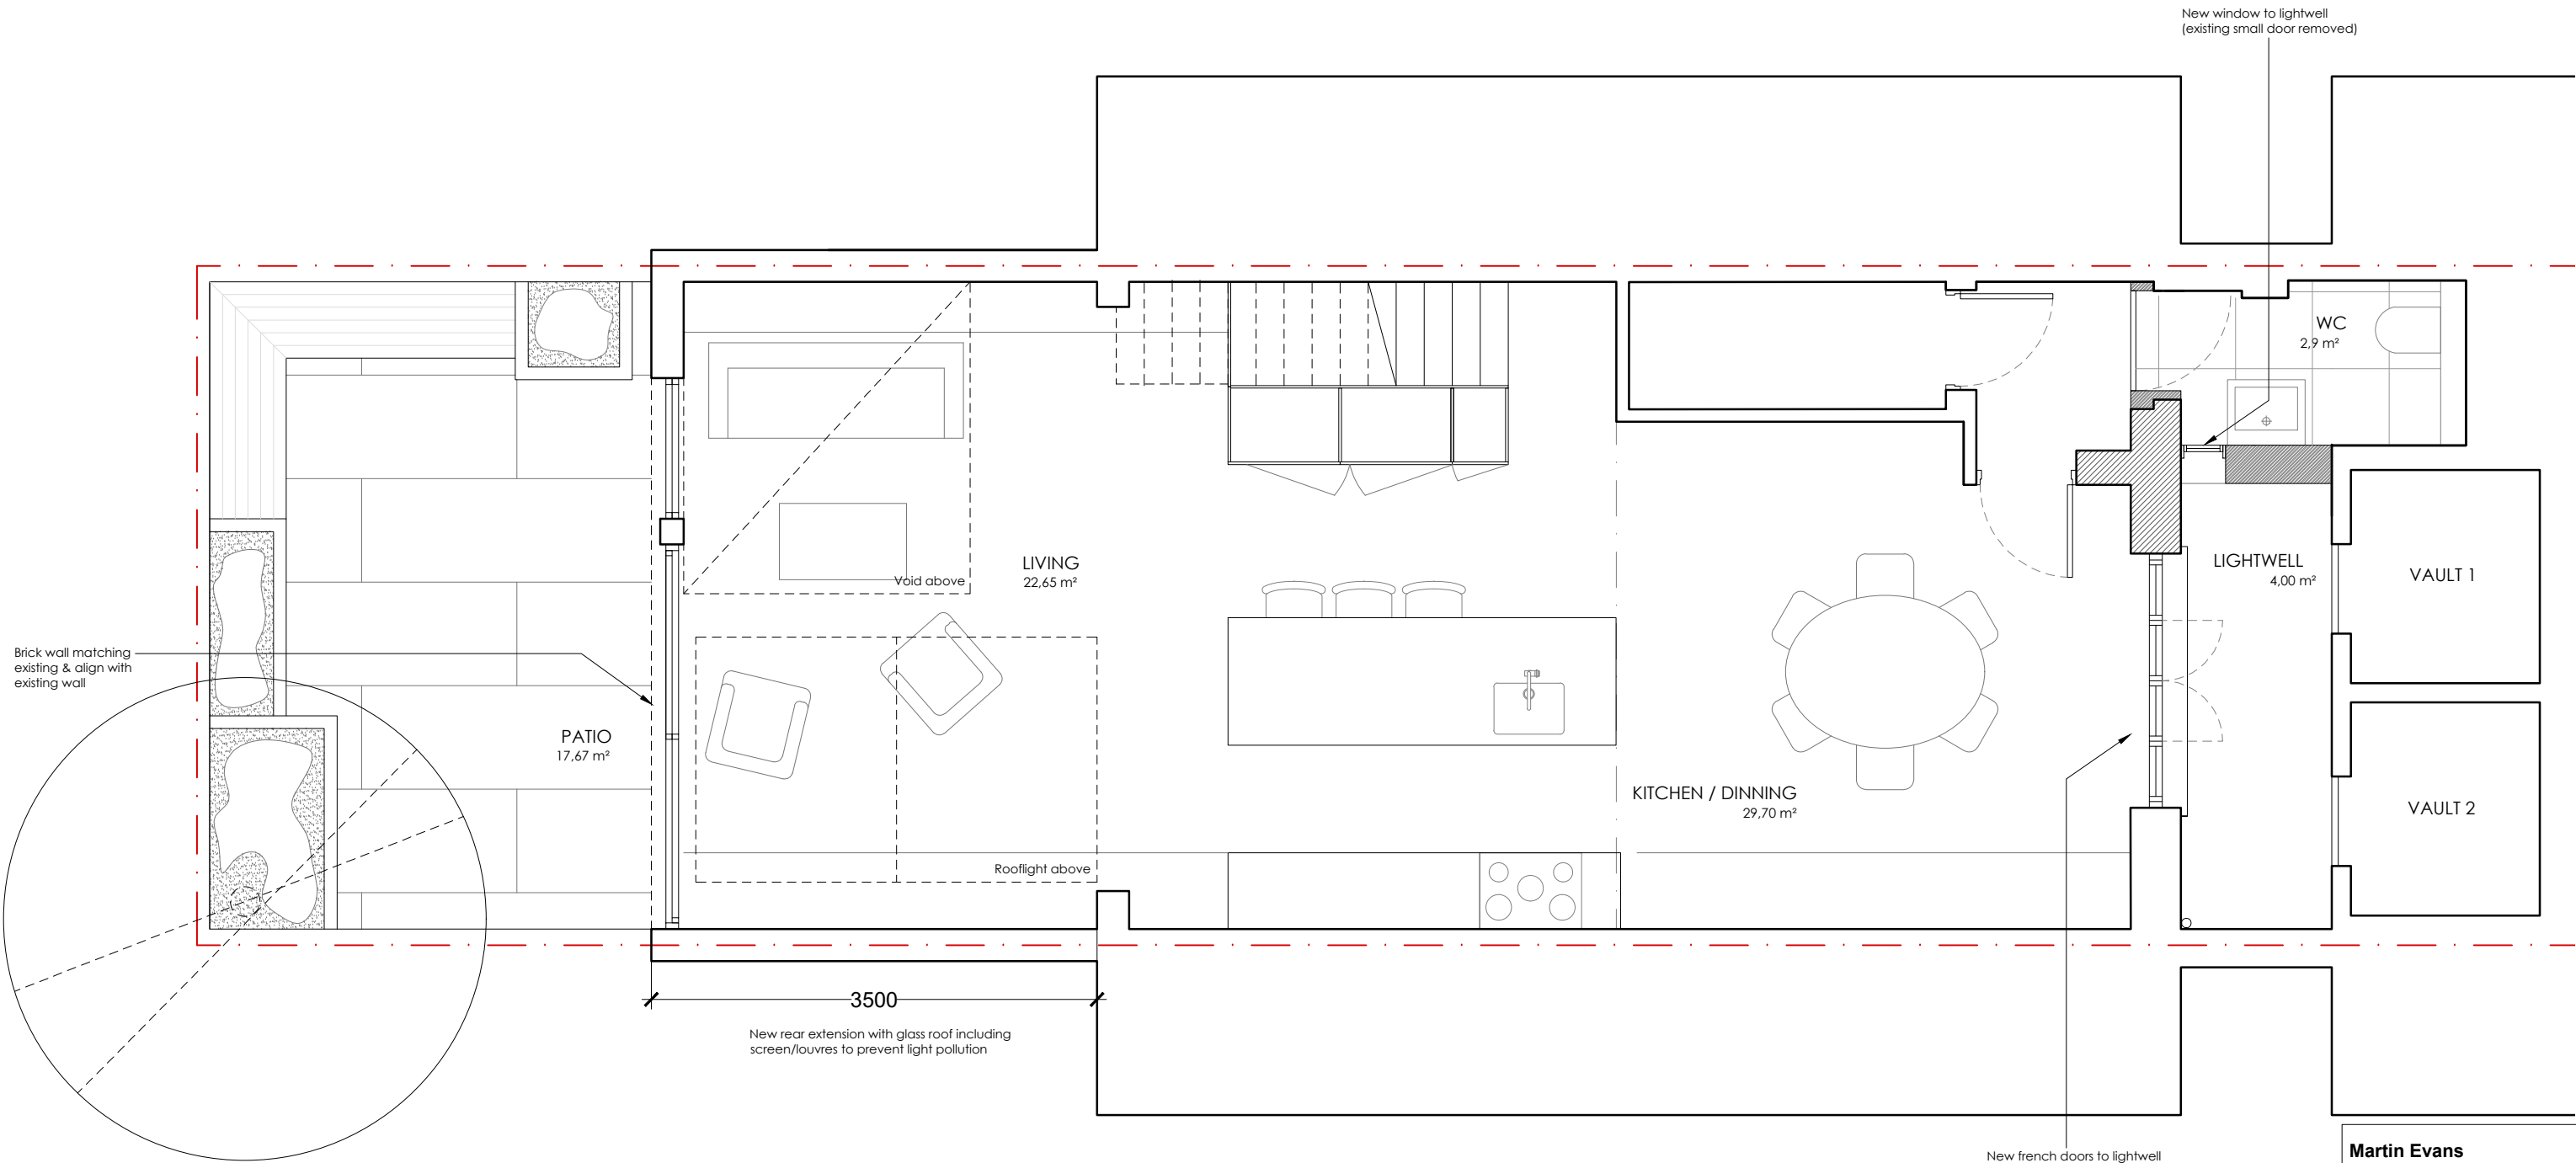

Martin Evans
Architects

18 Charlotte Road
London EC2A 3PB
tel 020 7729 2474

JOB

17, EDIS STREET
NW1 8LE
LONDON

TITLE

BASEMENT AS BUILT

DATE

20.02.2014

SCALE

1:50 @ A3

DRAWN

C.F.

DRAWING NO. EDI-PL-GA-01