



Notes:
 This drawing is protected by copyright. No part of this document may be reproduced, altered, or transmitted in any form or by any means without permission.
 Do not scale off these drawings for construction purposes. If any discrepancies are found, please contact Proctor Watts Cole Rutter.





Ground Floor Plan
 Scale 1:100

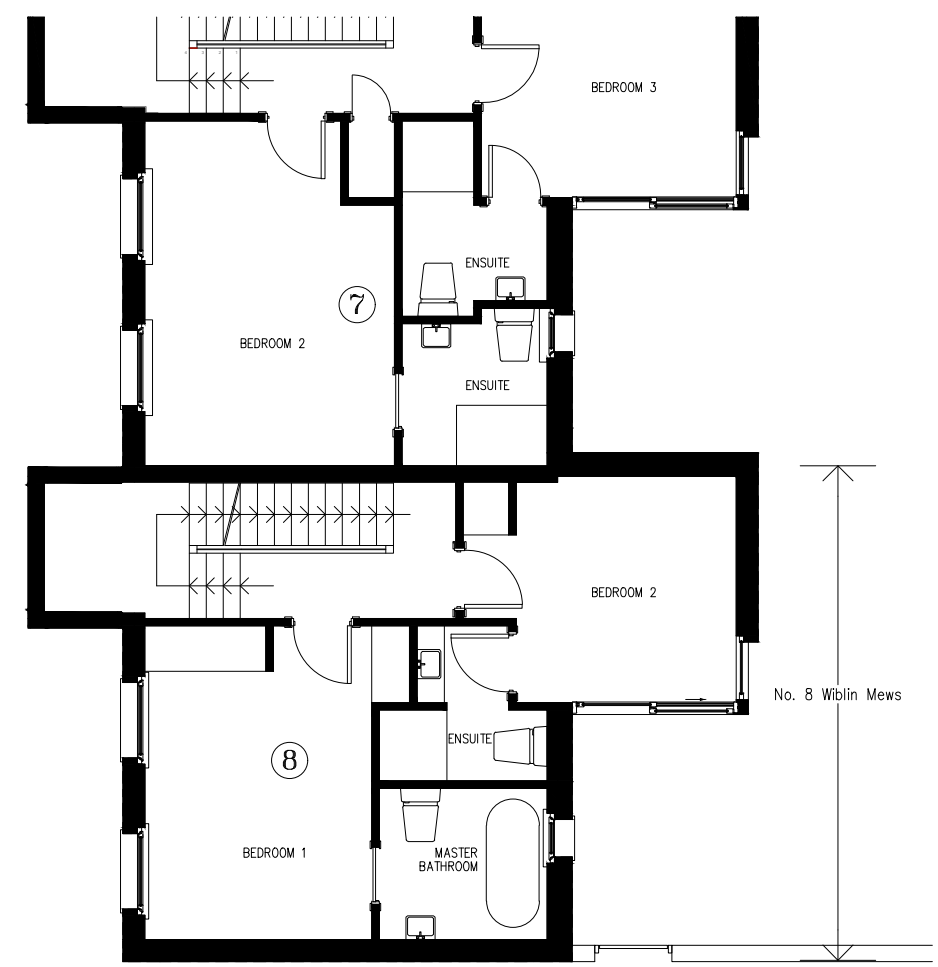

First Floor Plan
 Scale 1:100

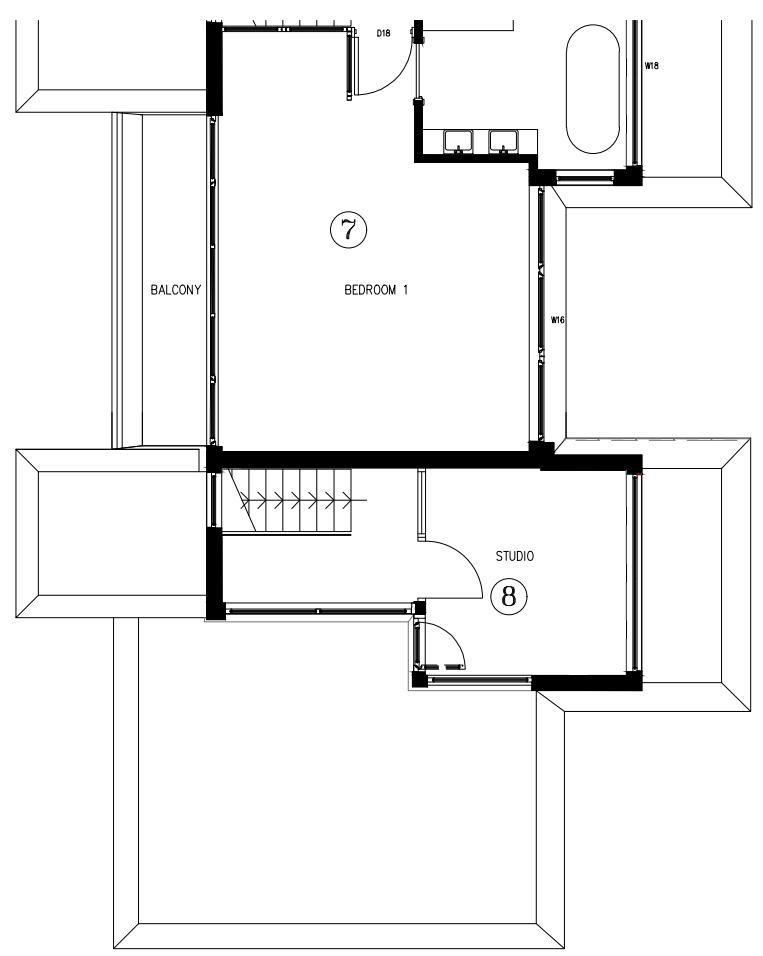


Second Floor Plan
 Scale 1:100

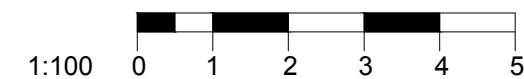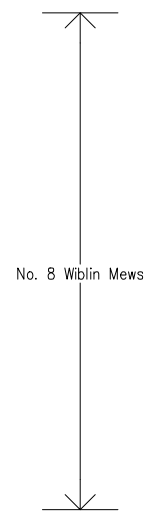

Rev.	Description:	By	Date
-	-	-	-
Client: Mr A Blow		Drawn By: JP	
Title: As Built Floor Plans		Checked By: GC	
Project: 8 Wiblin Mews, College Lane, Kentish Town, London		Scale: 1:100@A3	Date: 03 April 2019
Job No: 4672(18)	Dwg No: S21	Revision: -	

Proctor Watts Cole Rutter
 Chartered Architects & Town Planners
 Grosvenor House, Bleke Street, Shaftesbury, Dorset, SP7 8AW.
 Phone: 01747 851881 Fax: 01747 851081
 mail@pwcr.co.uk www.pwcr.co.uk


Notes:
 This drawing is protected by copyright. No part of this document may be reproduced, altered, or transmitted in any form or by any means without permission.
 Do not scale off these drawings for construction purposes. If any discrepancies are found, please contact Proctor Watts Cole Rutter.

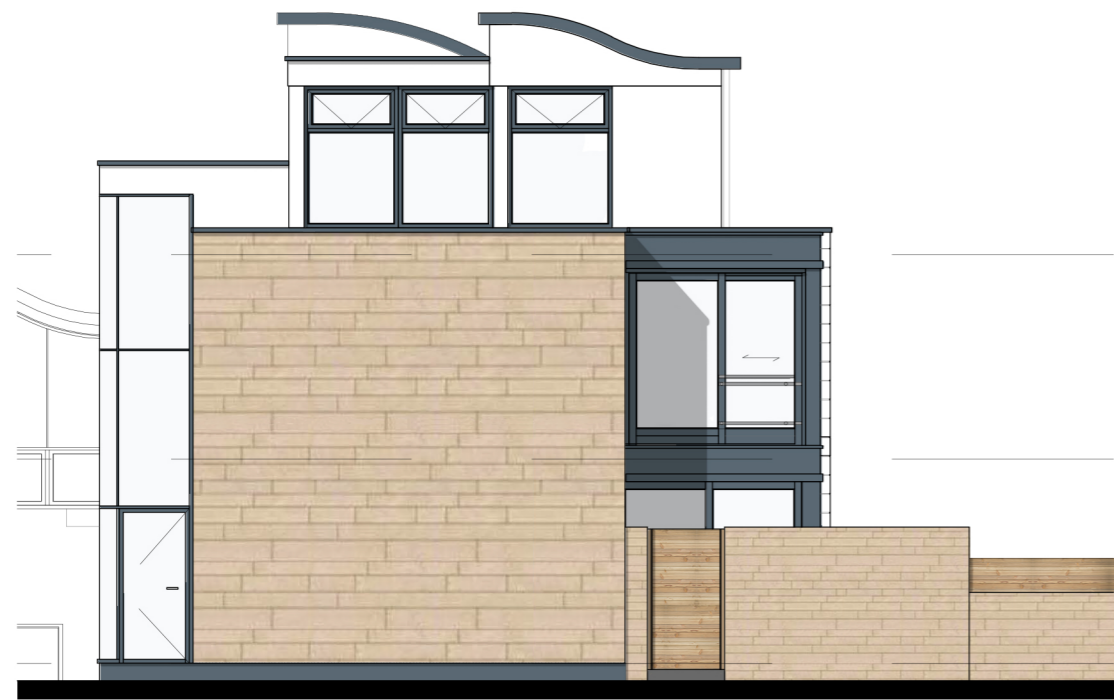

South West Elevation
 Scale 1:100



South East Elevation
 Scale 1:100

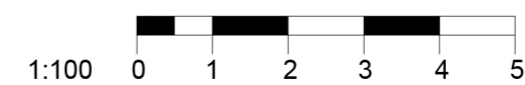

Rev.	Description:	By	Date
		Drawn By:	JP
Client:		Mr A Blow	
Title:		As Built Elevations	
Project:		8 Wiblin Mews, College Lane, Kentish Town, London	
Job No:		Dwg No:	Revision:
4672(18)		S22	-
Checked By:		GC	
Scale:		1:100@A3	
Date:		03 April 2019	

Proctor Watts Cole Rutter
 Chartered Architects & Town Planners
 Grosvenor House, Bleke Street, Shaftesbury, Dorset, SP7 8AW.
 Phone: 01747 851881 Fax: 01747 851081
 mail@pwcr.co.uk www.pwcr.co.uk