


Second Floor  
GIA = 63.14 Sq. m

Flat 4 NIA = 32.74 Sq. m  
Flat 5 NIA = 24.02 Sq. m

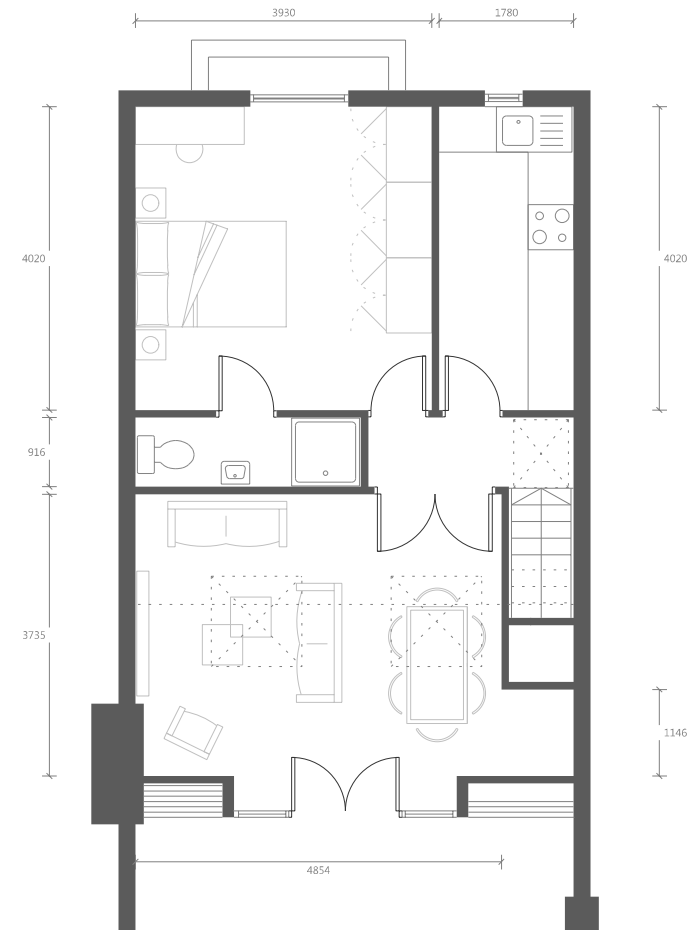

Third Floor  
GIA = 52.81 Sq. m

Flat 5 NIA = 52.81 Sq. m

Total Flat 5  
NIA = 76.83 Sq. m

Total GIA = 328.41 Sq. m



Revision	Description	Date
<p><b>Pelican</b> Building Contractors Ltd 4 South Ealing Road W5 4QA T: 020 8567 2489 F: 020 8566 2961 xenia@pelicancontractors.com</p>		
<p>Project 41 Denning Road NW3 1ST</p>		
<p>Drawing As Built Plans Second &amp; Third Floors</p>		
Drawing Reference		Drawn By
DR41_AsB_P_012-013		XC
Version	Revision	Scale
01	-	A3 1:100
		Date
		Apr 13