





Red lines indicate existing timber  
frame size

Flats 3 and 24  
Flat 1 and 4 handed  
Flat 23 same details

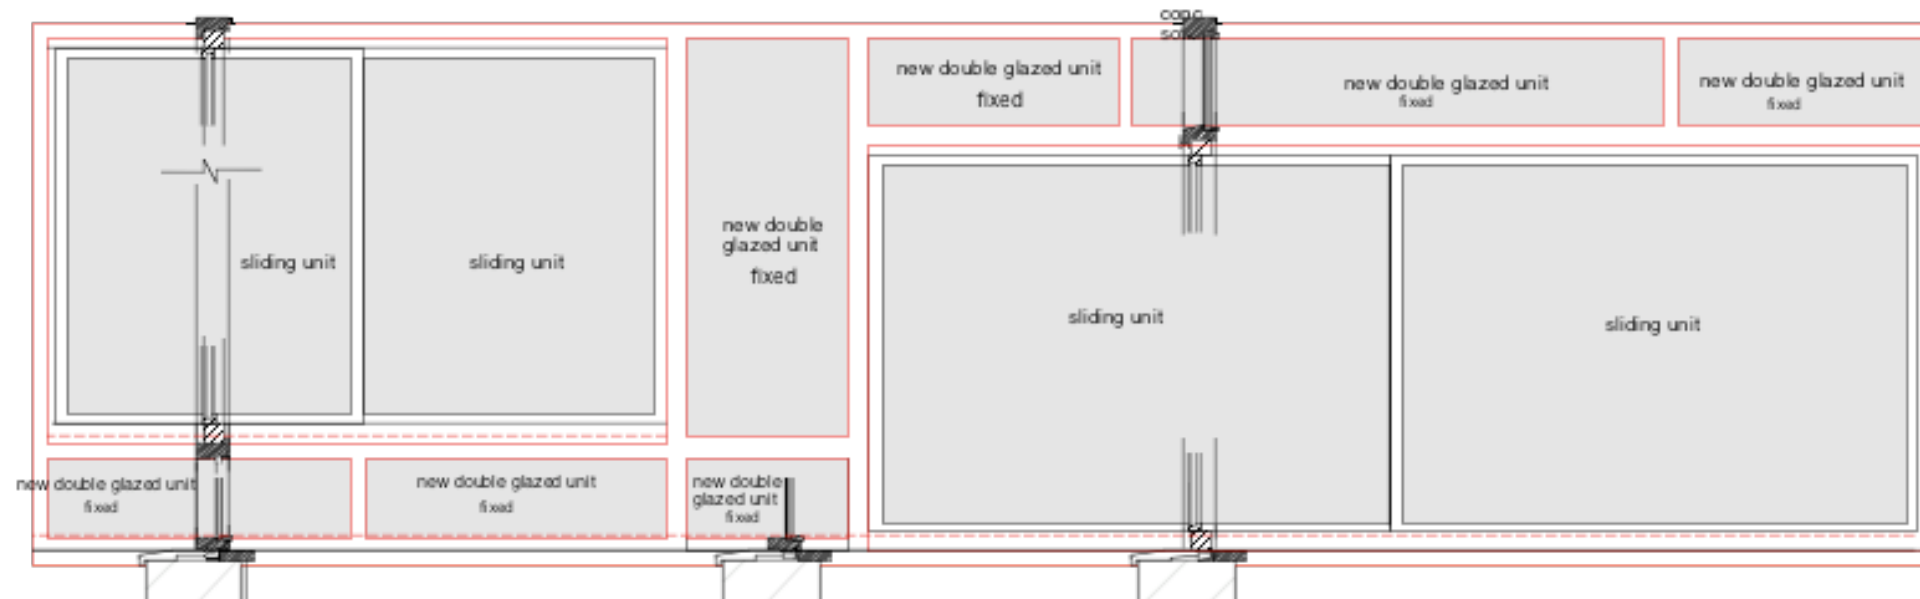

Flat 23 West elevation

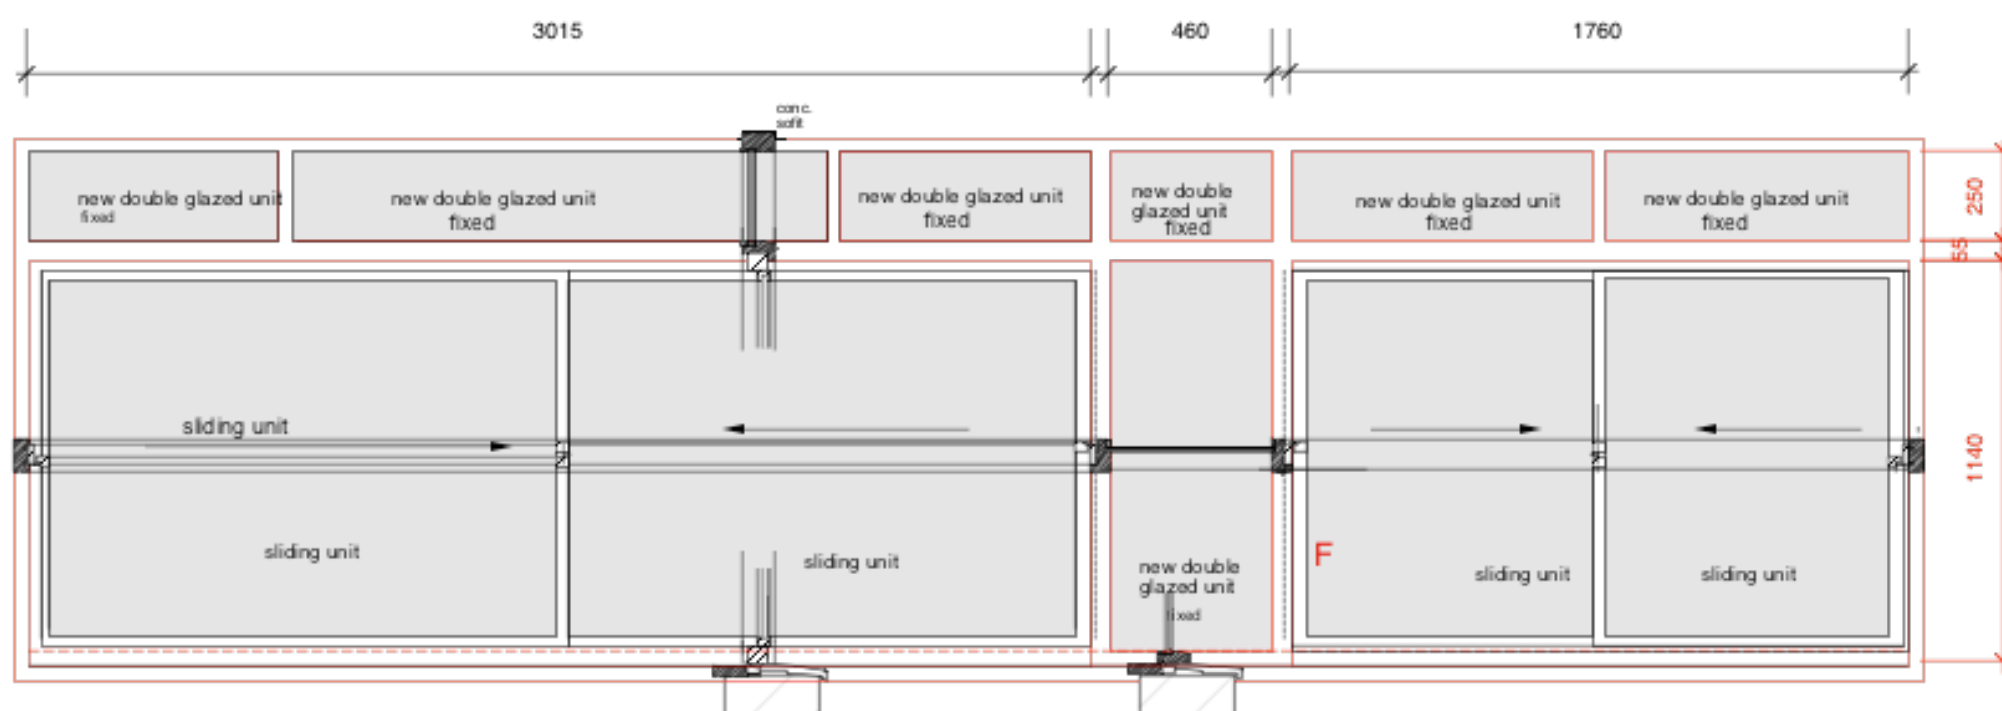

Red lines indicate existing timber  
frame size

Flat 53



Romney Court  
Haverstock Hill  
London NW3

Architects and Project Managers  
53 Romney Court  
141 Haverstock Hill  
London NW3 4RX  
Tel: 020 7483 3979  
mob: 07770 450054  
E Mail: tim.drewitt@btinternet.com

Rev D : Detail of windows flats 1, 3, 4 and 23 added.  
Windows manufacturers ref. Duration Heavy Duty. Jan 2018  
Rev C: Detail of windows from ground to 4th added July '14  
Rev B: Duration Prime windows + alumin. cill. May 14  
Rev A: Duration Prime windows. May 14

Drwg:

Replacement Aluminium windows  
Elevation of unit + new details  
Ground to 5th floor

Scale  
1:20 @ A3

Date:  
Jan 2018

Drwg No:  
RC/W/07/D