


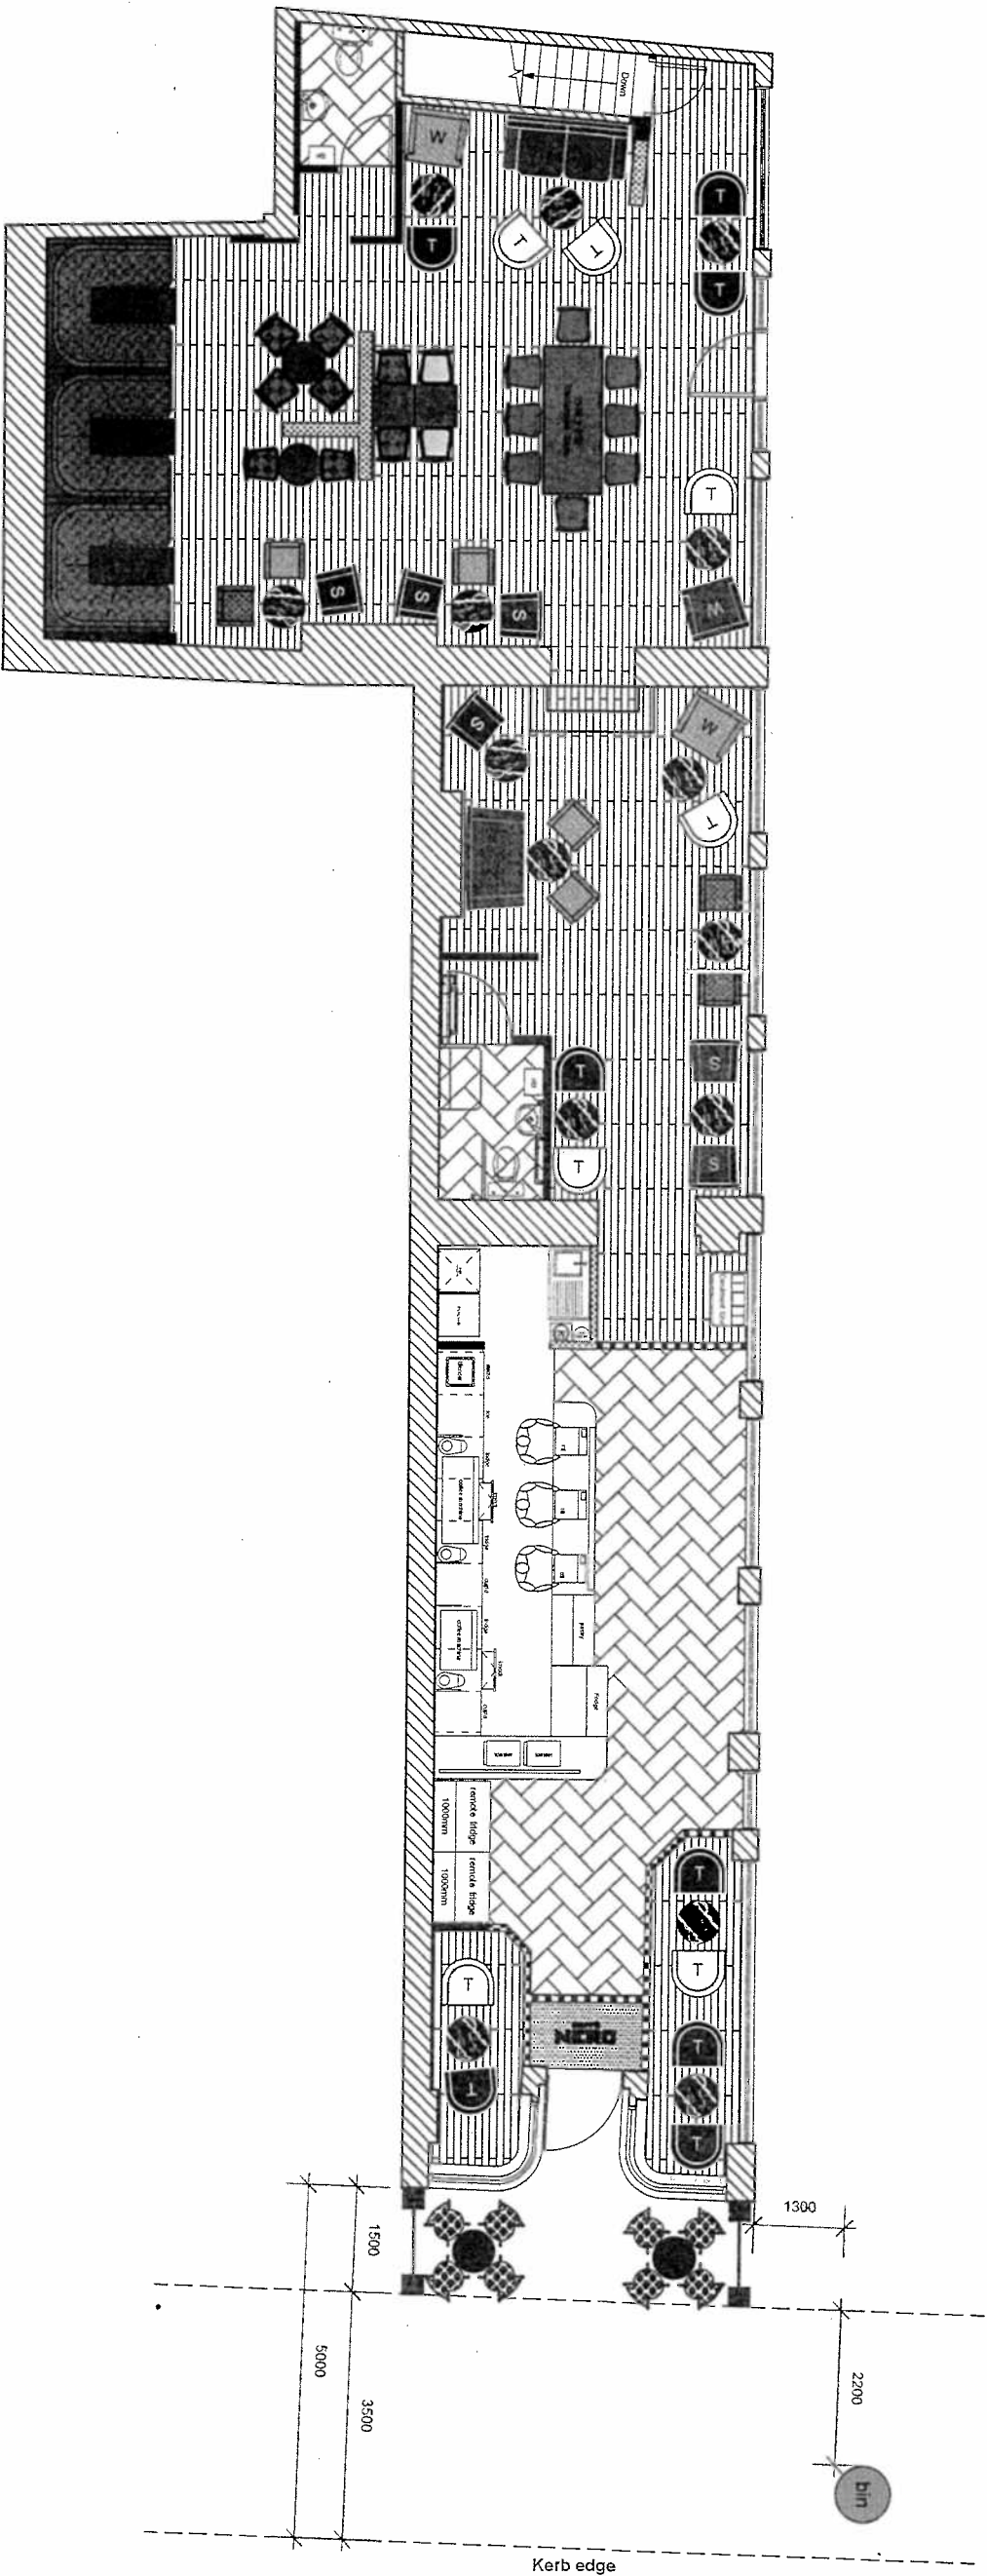

bedrock Bedrock Design Consultants Ltd 2nd Floor, 39 Gold Street, Nottingham, NN1 1PA T: 01604 250002 F: 01604 250003 info@bedrockdesign.co.uk		Client Caffe Nero		Scale 1:100@A3	Drawn by RW	Date 26.02.2016	Rev. N°	Description	Drawn by	Date	AS BUILT		Notes This drawing represents a performance guide upon which the contractor/subcontractor must base his/her working drawings & details. Include all necessary tolerances prior to manufacture and installation.	Contractor to must undertake a full survey of the area to establish all dimensions & ensure accurate setting out. Advise on suitability of all details shown to ensure structural stability, ease and economy of construction Refer to digital master artwork in regard to all graphic work shown				
Project 126 Tottenham Court Road		Drawing N° CN724 - 701		Revision														
Description Exernal Seating																		
This drawing is the copyright of Bedrock Design Consultants Ltd. This drawing cannot be copied, reproduced, retained or disclosed to any unauthorised person without prior permission in writing from the designer.																		