


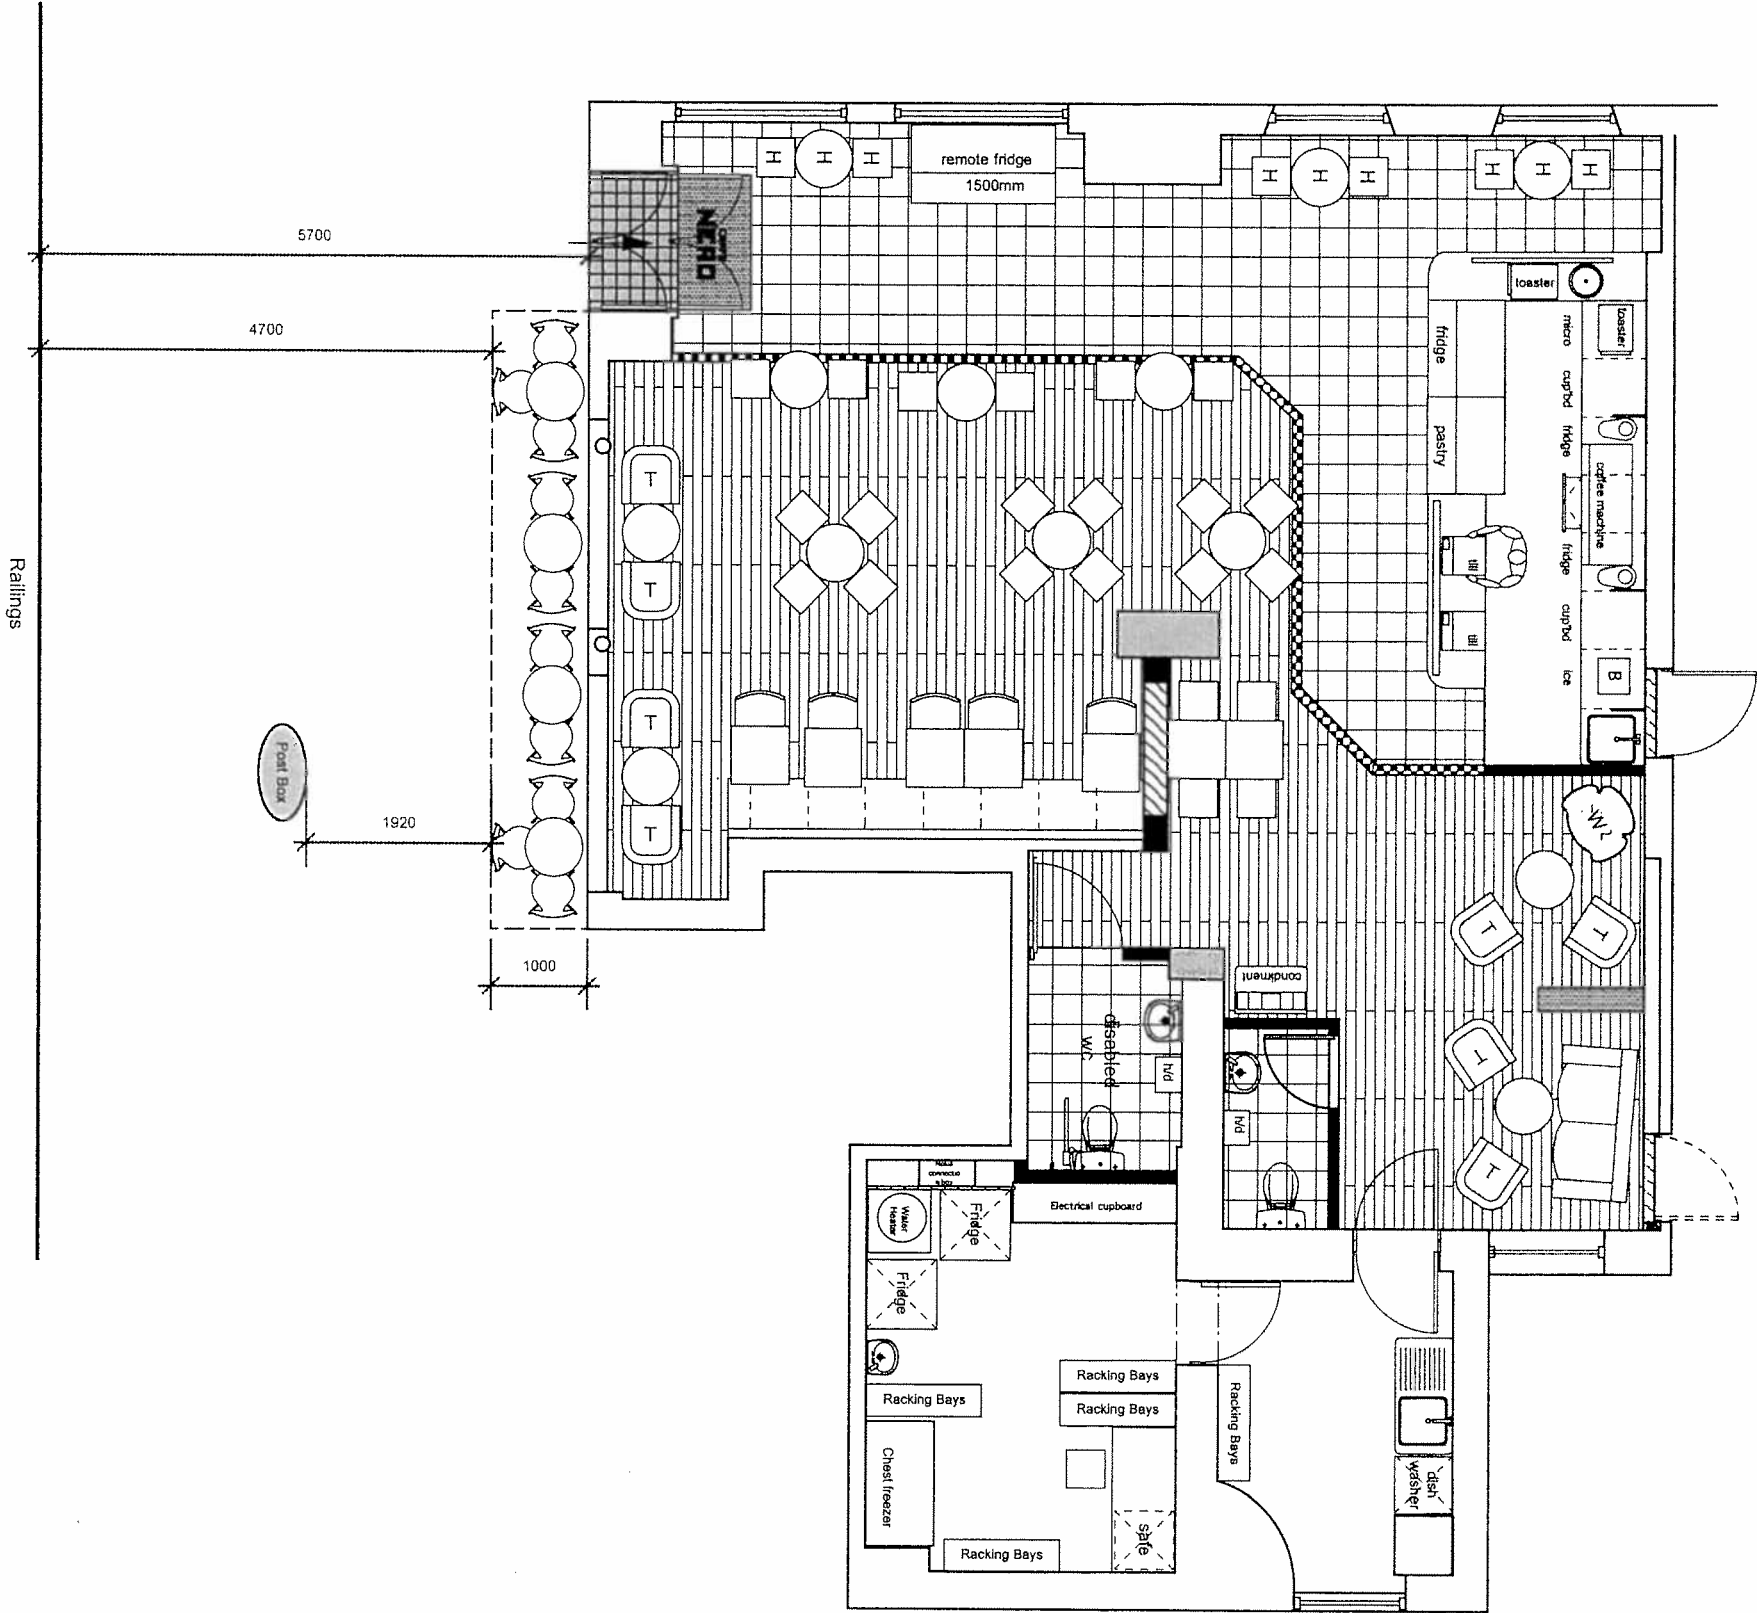

Rev	Yr	Description	Date

Notes

This drawing represents a performance guide upon which the contractor/subcontractor must base his/her working drawings & details. Include all necessary tolerances prior to manufacture and installation.

Contractor to must undertake a full survey of the area to establish all dimensions & ensure accurate setting out.

Advise on suitability of all details shown to ensure structural stability, ease and economy of construction.

Refer to digital master artwork in regard to all graphic work shown

AS BUILT

bedrock

Bedrock Design Consultants Ltd
1st Floor, 37 Hulton Garden, London,
EC1N 8HT
T 020 3116 0120
F 020 3116 0121
info@bedrockdesign.co.uk

Client	Caffe Nero
Project	Theobolds Road
Description	External Seating
Scale	1/75@A3
Drawn by	RW
Date	26/02/16
Drawing N°	CN341-001
Revision	

This drawing is the copyright of Bedrock Design Consultants Ltd. This drawing cannot be copied, reproduced, retained or disclosed to any unauthorised person without prior permission in writing from the designer.