

Rev No	Description	Drawn By	Date
A	ISA & BSA of New Installation	RW	25/05/14
B	Finalised Planning and Survey	RW	15/07/14
C	New detailed ground floor plan 1000mm grid	CS	28/07/14
D	Finalised report for A. Shawley	CS	01/08/14
E	Finalised report signed	CS	11/08/14


Notes

This drawing represents a performance guide upon which the contractor/subcontractor must base his/her working drawings & details. Include all necessary tolerances prior to manufacture and installation.

Contractor to must undertake a full survey of the area to establish all dimensions & ensure accurate setting out.

Advise on suitability of all details shown to ensure structural stability, ease and economy of construction.

Refer to digital master artwork in regard to all graphic work shown.

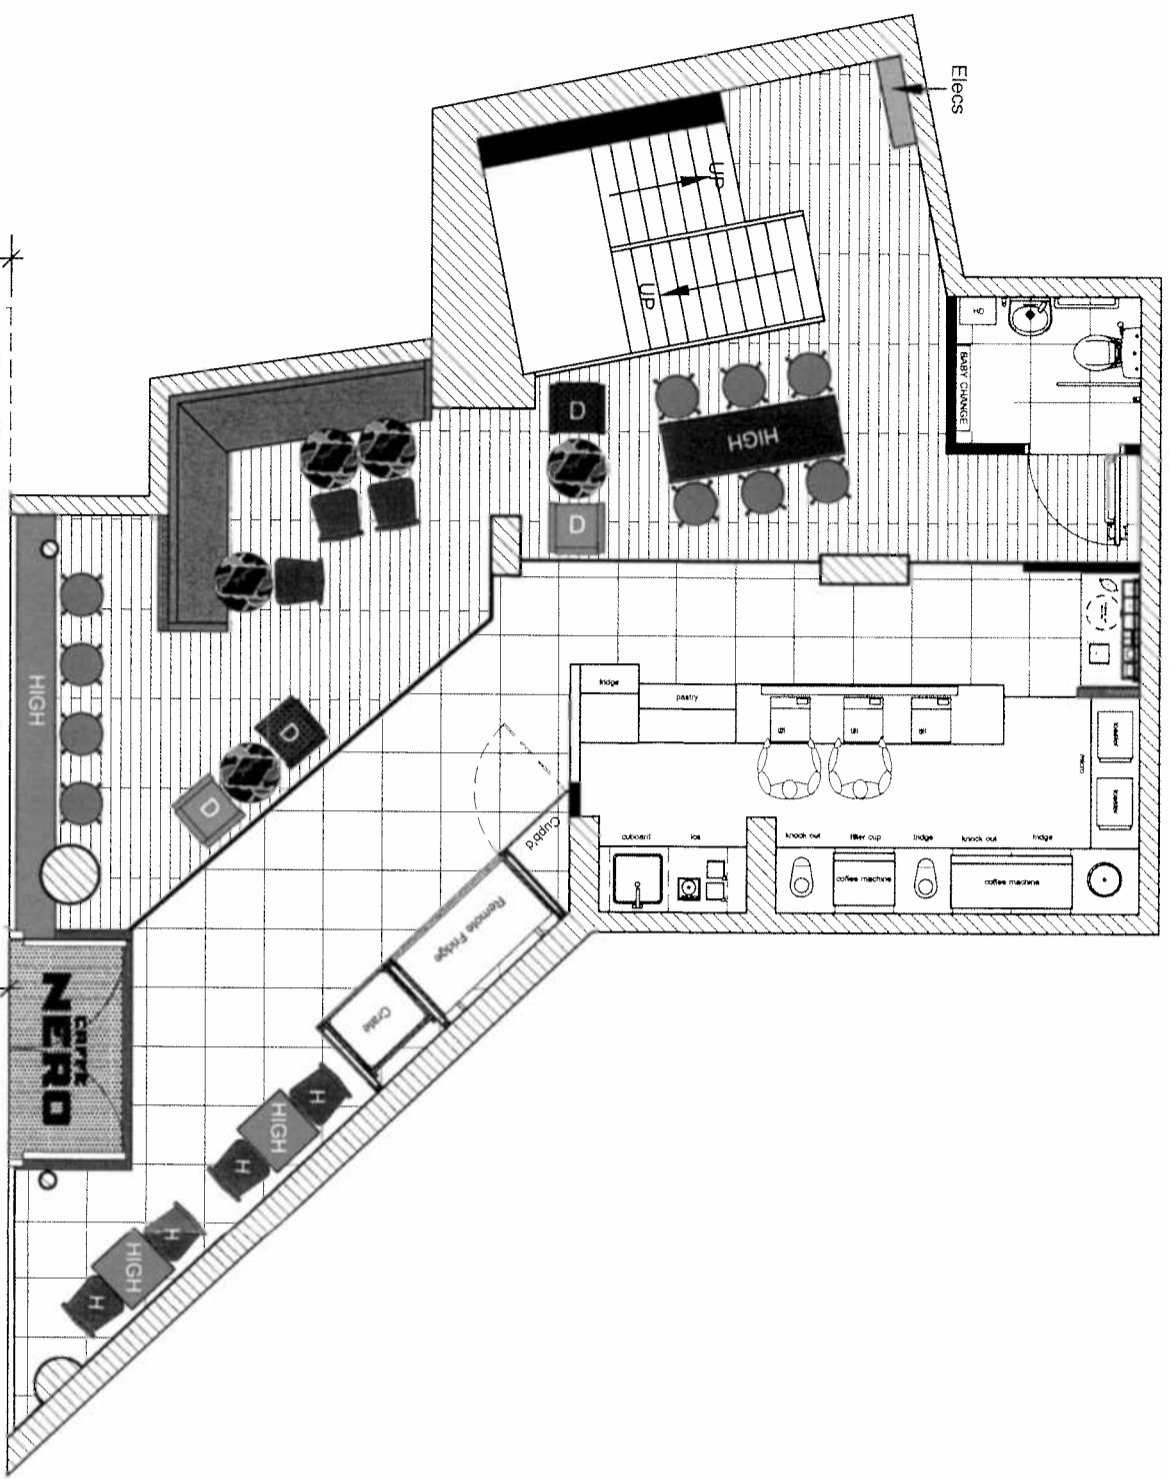

GROUND FLOOR
24 Seats

PAVEMENT EDGE

AS BUILT



Bedrock Design Consultants Ltd
2nd Floor, 39 Gold Street, Northampton,
NN1 1PA
T 01604 250002
F 01604 250003
info@bedrockdesign.co.uk

Client
Café Nero

Project
Holborn

Description
External Seating

Scale
1:75@A3
Drawing No
CN640 - 100

Drawn by
CA
Date
23/03/17

Revision
E

This drawing is the copyright of Bedrock Design Consultants Ltd. This drawing cannot be copied, reproduced, related or disclosed to any person without prior permission in writing from the design.