


This drawing is protected under Copyright and at no time must any portion of this drawing be reproduced or copied in anyway without the permission of Morgan Lovell.

All dimensions must be checked on site and NOT scaled from this drawing.

SUBJECT TO SITE SURVEY
 CHECK SURVEY UNDERTAKEN ONLY
 BUILDING PARAMETERS TAKEN FROM DRAWINGS PROVIDED
 BUILDING PARAMETERS TAKEN FROM AS BUILT DRAWINGS PROVIDED

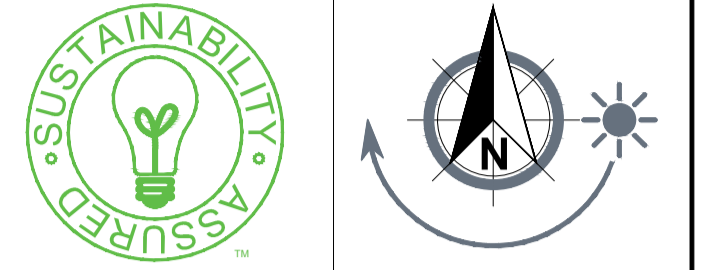

FLOOR SQUARE FOOT = XXXX (XXXsq m)

Square foot shown is based on supplied building shell and includes all columns - subject to site survey

GENERAL CEILING HEIGHT = VARIES mm
 BEAM HEIGHT = 2795 - 2745mm

FLOOR VOID = 105mm incl floor tile
 Clear floor void approx 75mm

CEILING VOID = VARIES mm
 Clear ceiling void approx VARIES mm

BEAM HEIGHT = 2795 - 2745mm

FLOOR TO CILL HEIGHT = 80 - 225mm

WINDOW HEIGHT = 2315 - 2355mm


Morgan Lovell
 Inspiring office transformation
 Morgan Lovell
 16 Noel Street
 London W1F 8DA
 Telephone: 0207 734 4466 Fax: 0207 734 2968
 Email: contact@morganelovell.co.uk
 http://www.morganelovell.co.uk

Client Approved : _____

Date : _____

ML Approved : _____

Date : _____

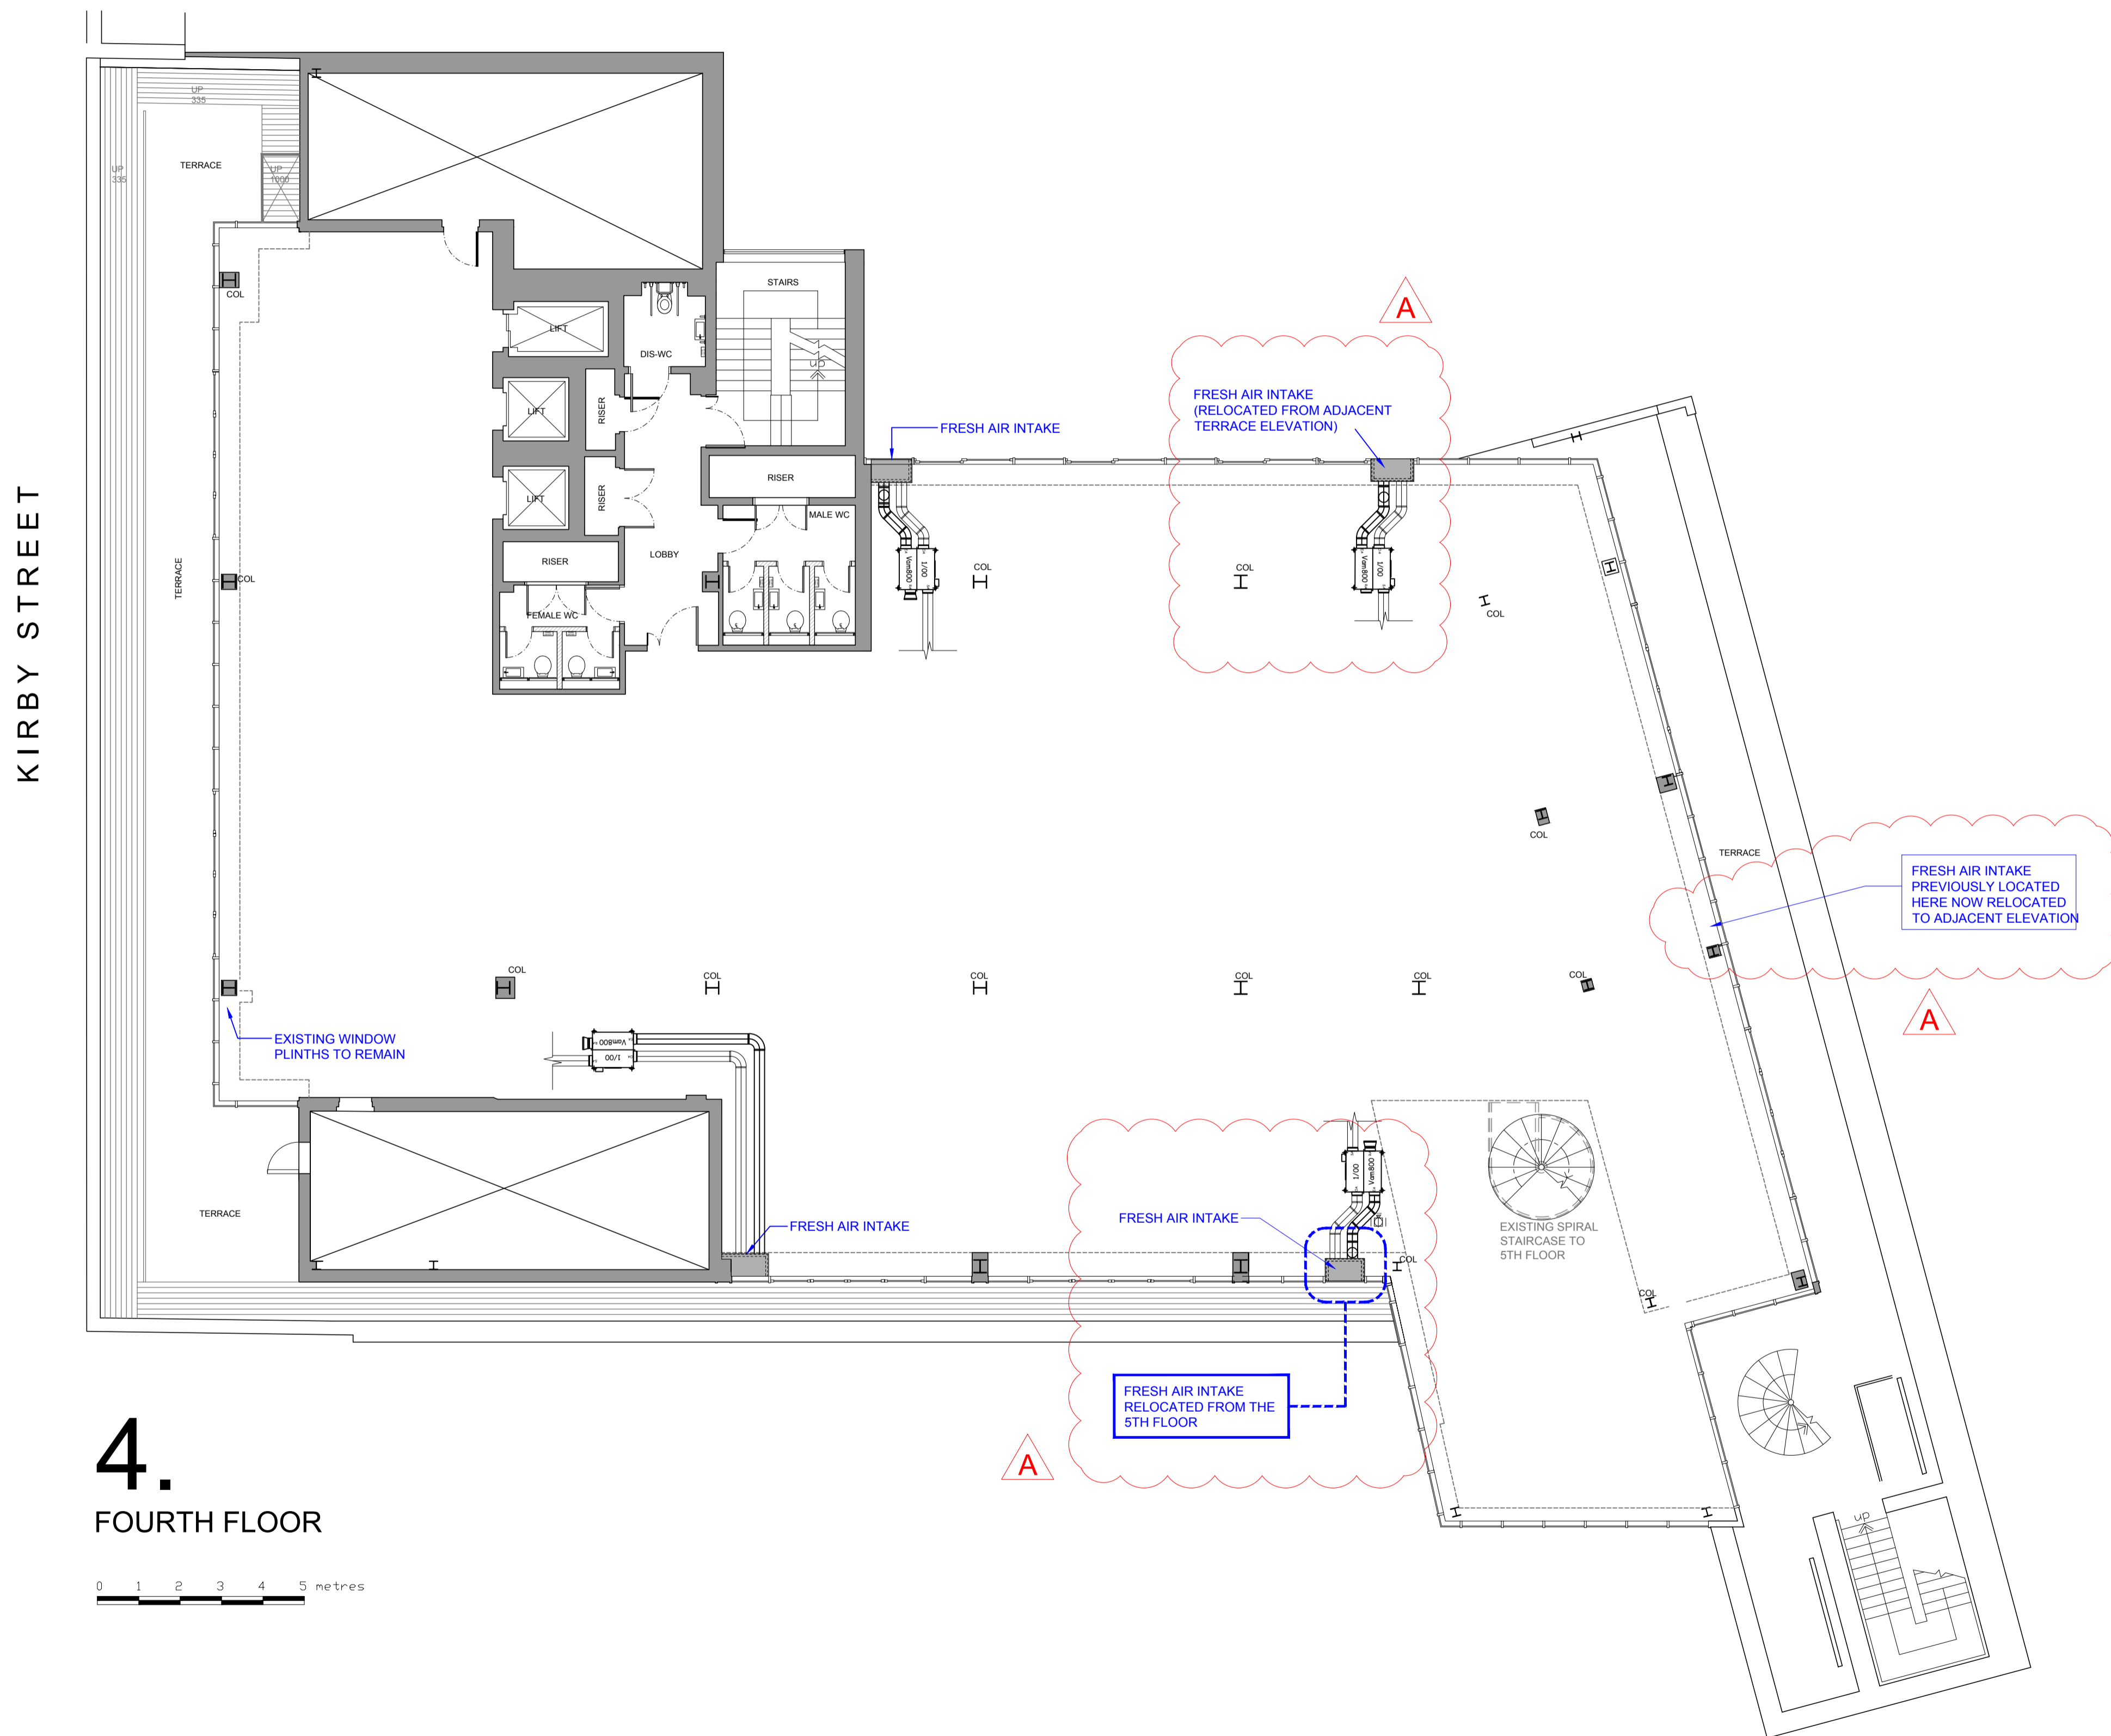

4.
 FOURTH FLOOR



Revision	By	Date
A	TK	15.05.19
	TK	13.05.19

FOR PLANNING

Morgan Lovell

16 Noel Street London W1F 8DA
 T: 0207 734 4466 F: 0207 734 2968 E: contact@morganelovell.com
 W: http://www.morganelovell.com

Client
SAFFRON HOUSE

Project
 6-10 KIRBYSTREET
 LONDON
 EC1N 8TS

Title
**4TH FLOOR
 AIR INTAKE LOUVRE LOCATIONS**

Scale	Date	Designer/Drawn By	Checked By / Date
1:100 @ A1	03.12.18	MP/TK	

Drawing Number			
Project No.	Floor	Drawing No.	Rev
ML2918	04	911	A

AIR INTAKE LOUVRE LOCATIONS

