


This drawing is protected under Copyright and at no time must any portion of this drawing be reproduced or copied in anyway without the permission of Morgan Lovell.

All dimensions must be checked on site and NOT scaled from this drawing.

SUBJECT TO SITE SURVEY  
 CHECK SURVEY UNDERTAKEN ONLY  
 BUILDING PARAMETERS TAKEN FROM DRAWINGS PROVIDED  
 BUILDING PARAMETERS TAKEN FROM AS BUILT DRAWINGS PROVIDED

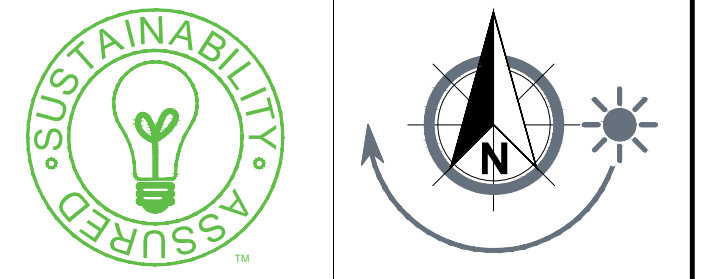

FLOOR SQUARE FOOT = XXXX (XXXsq m)

Square foot shown is based on supplied building shell and includes all columns - subject to site survey

GENERAL CEILING HEIGHT = VARIES mm  
 BEAM HEIGHT = 2795 - 2745mm

FLOOR VOID = 105mm incl floor tile  
 Clear floor void approx 75mm

CEILING VOID = VARIES mm  
 Clear ceiling void approx VARIES mm

BEAM HEIGHT = 2795 - 2745mm

FLOOR TO CILL HEIGHT = 80 - 225mm

WINDOW HEIGHT = 2315 - 2355mm

**Morgan Lovell**  
 Inspiring office transformation


Morgan Lovell  
 16 Noel Street  
 London W1F 8DA  
 Telephone: 0207 734 4466 Fax: 0207 734 2968  
 Email: contact@morganlovell.co.uk  
 http://www.morganlovell.co.uk

Client Approved:

Date:

ML Approved:

Date:

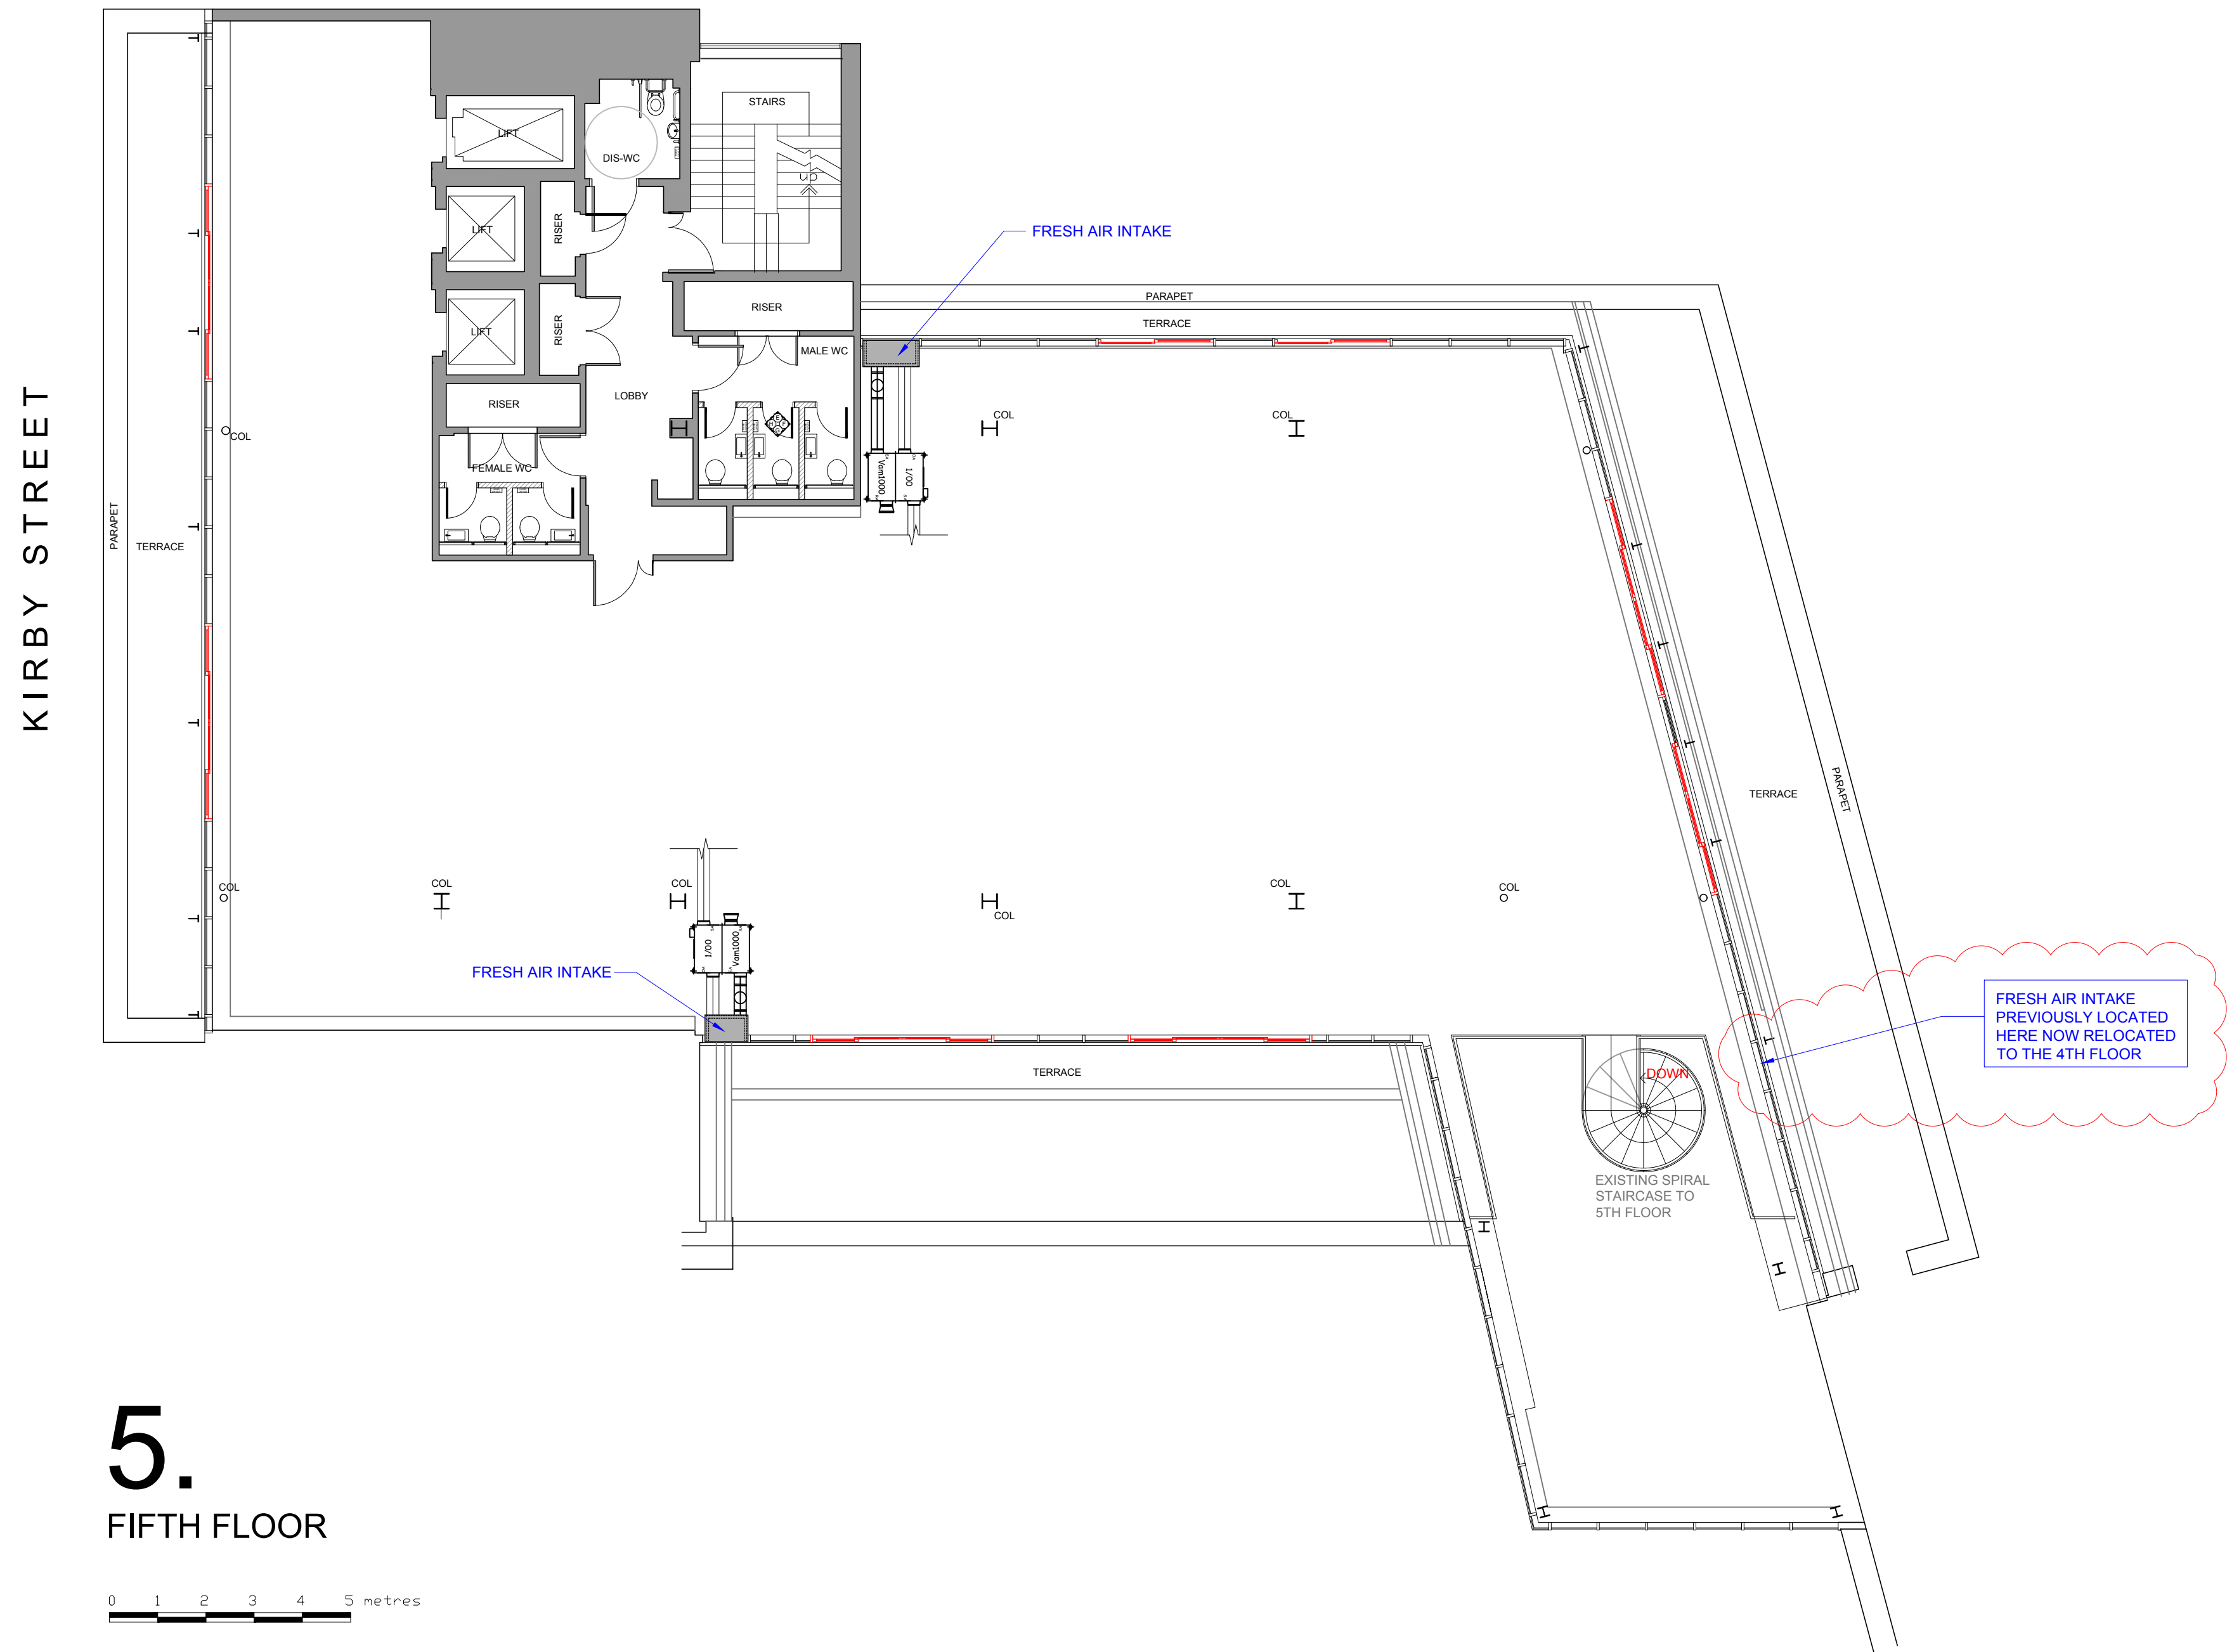

**5.**  
 FIFTH FLOOR

0 1 2 3 4 5 metres

FIRST ISSUE FOR PLANNING REVIEW	TK	19.05.19
Revision	By	Date

**FOR PLANNING**

**Morgan Lovell**

16 Noel Street London W1F 8DA  
 T: 0207 734 4466 F: 0207 734 2968 E: contact@morganlovell.com  
 W: http://www.morganlovell.com

Client  
**SAFFRON HOUSE**

Project  
 6-10 KIRBYSTREET  
 LONDON  
 EC1N 8TS

Title  
**5TH FLOOR  
 AIR INTAKE LOUVRE LOCATIONS**

Scale	Date	Designer/Drawn By	Checked By / Date
1:100 @ A1	03.12.18	MP/TK	

Drawing Number			
Project No.	Floor	Drawing No.	Rev
ML2918	05	912	.

**AIR INTAKE LOUVRE LOCATIONS**

0m 1m 2m 3m 4m 5m 6m 7m 8m 9m 10m