


PROPOSED SIDE ELEVATION (D)

1:50 @ A1




This drawing is protected under Copyright and at no time must any portion of this drawing be reproduced or copied in anyway without the permission of Morgan Lovell.  
 All dimensions must be checked on site and NOT scaled from this drawing.

SUBJECT TO SITE SURVEY  
 CHECK SURVEY UNDERTAKEN ONLY  
 BUILDING PARAMETERS TAKEN FROM DRAWINGS PROVIDED  
 BUILDING PARAMETERS TAKEN FROM AS BUILT DRAWINGS PROVIDED

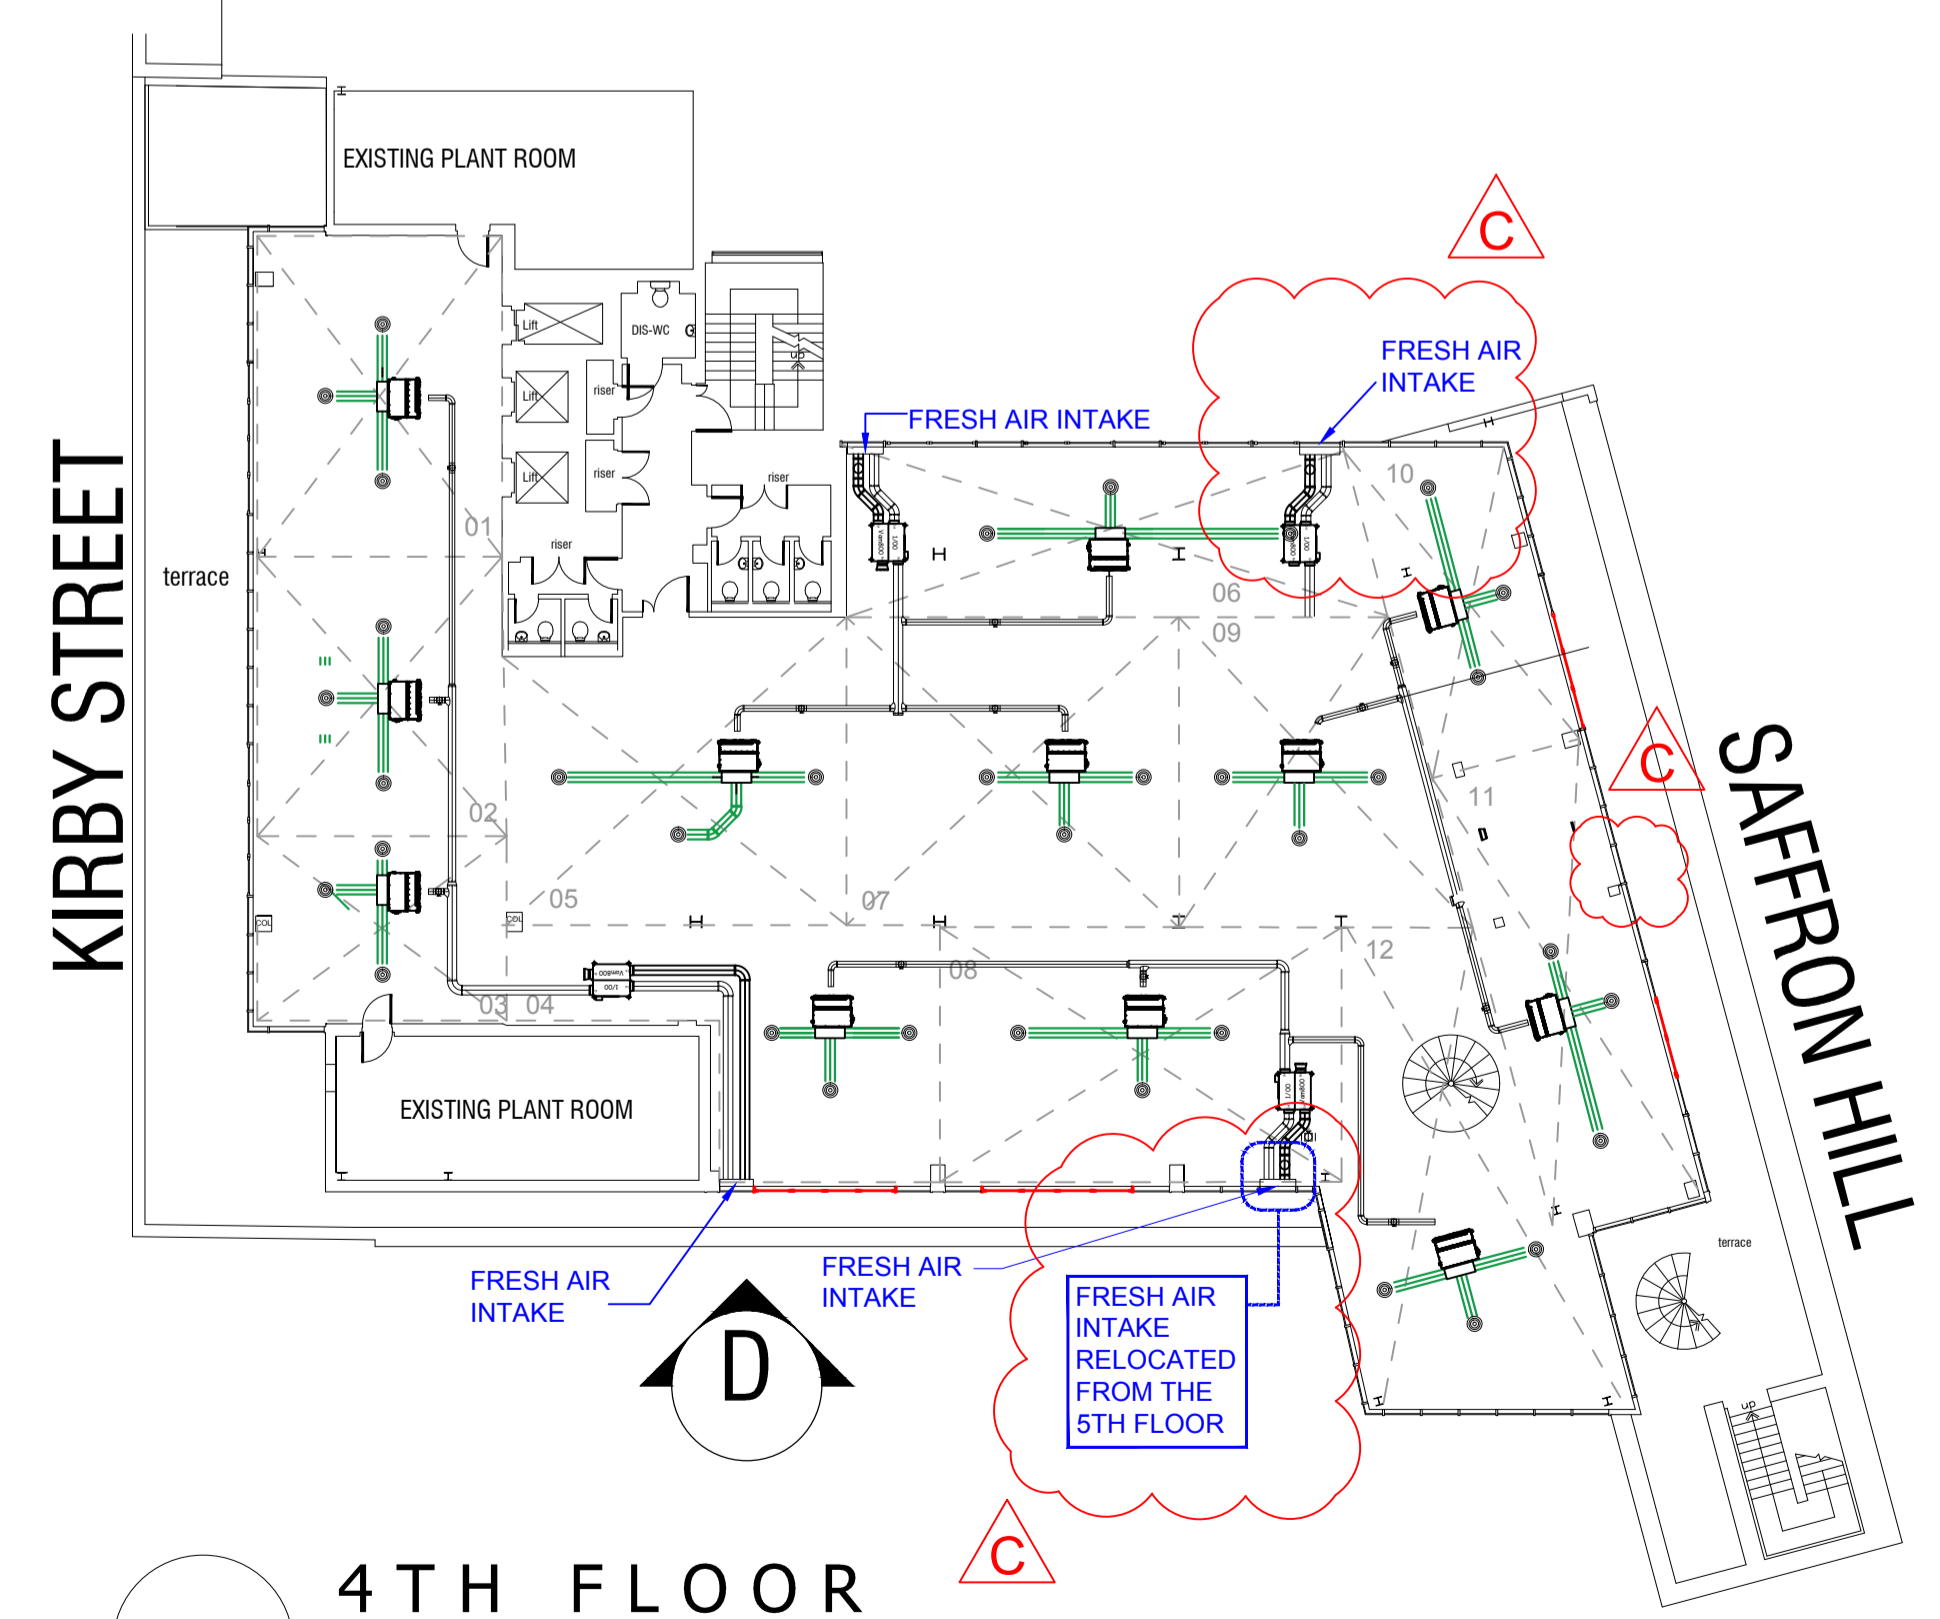

4TH FLOOR

1:200 @ A1

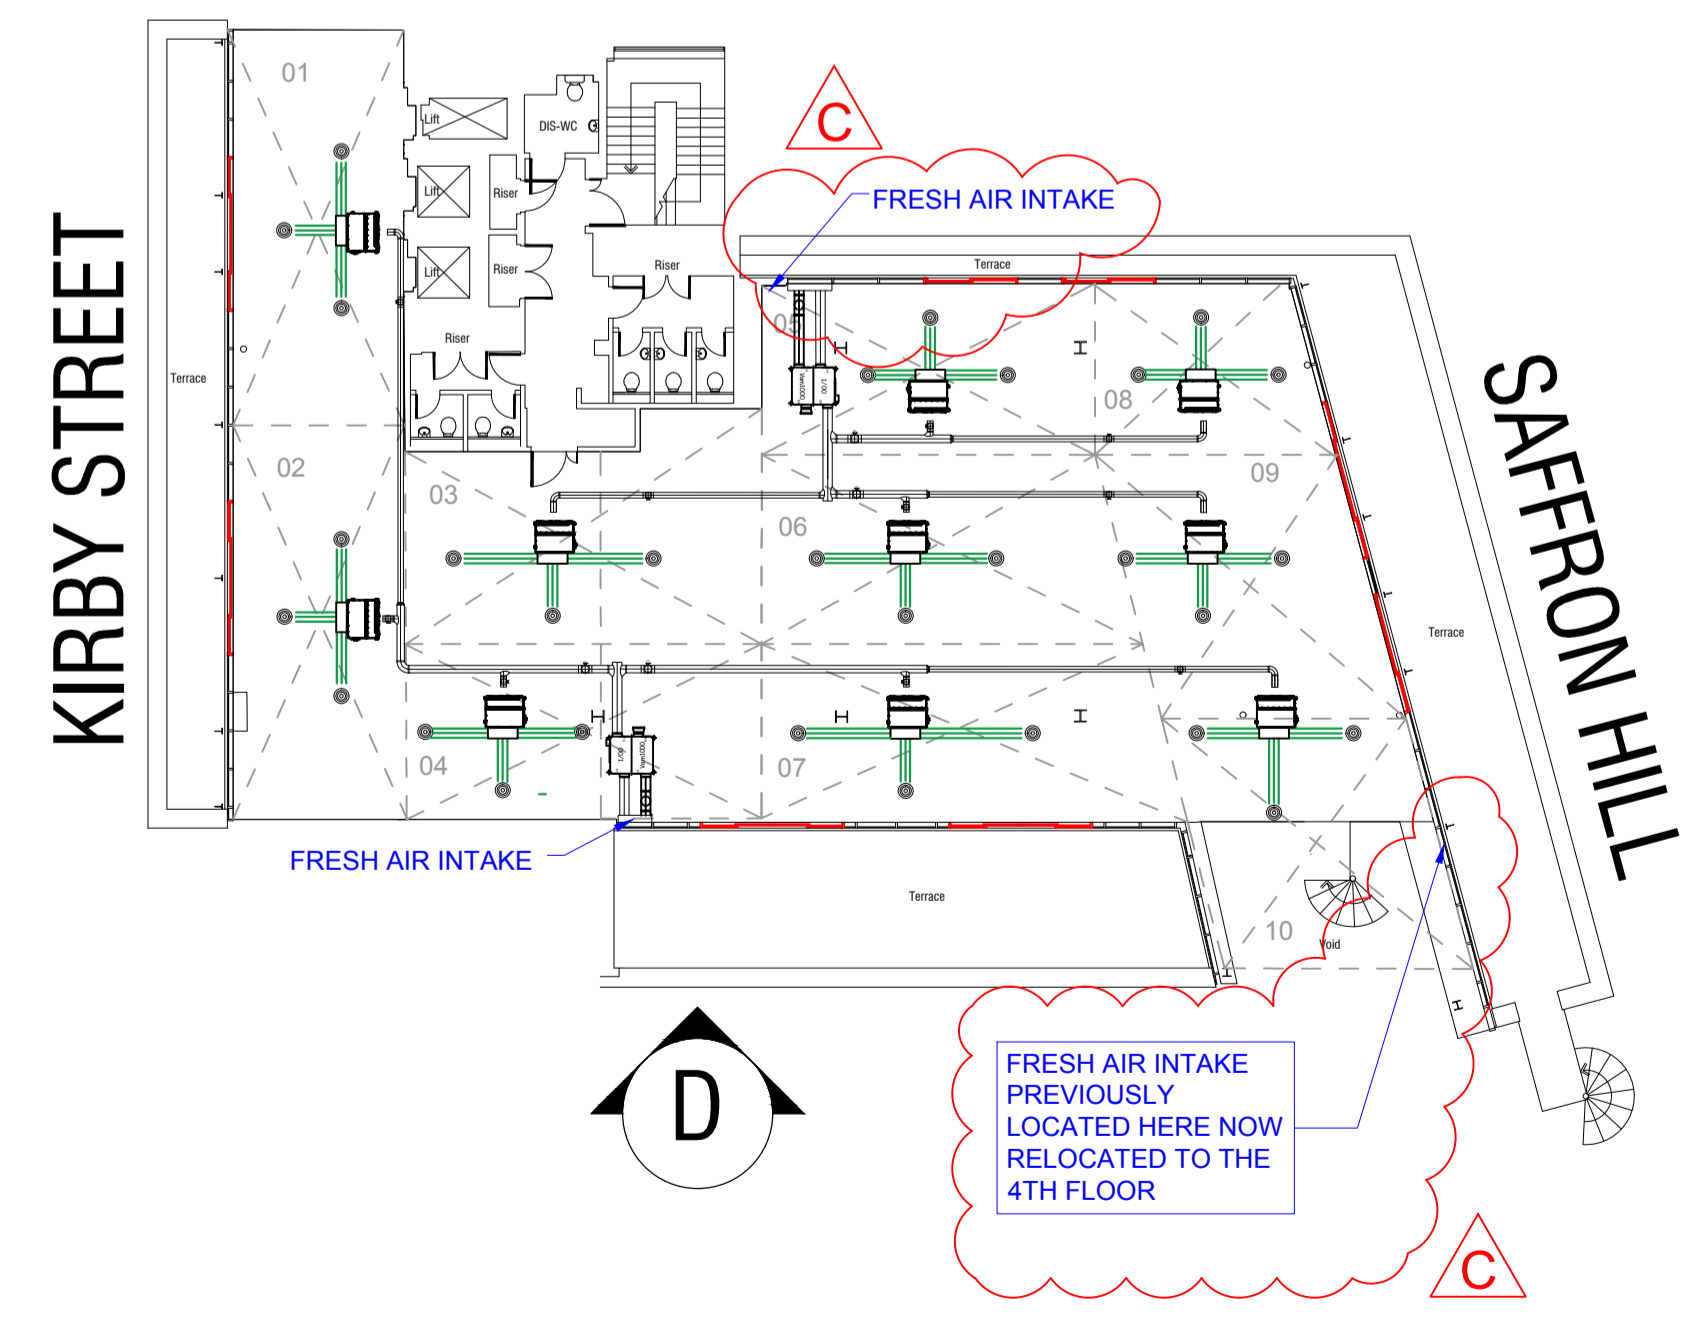

5TH FLOOR

1:200 @ A1

EXISTING PHOTOGRAPHS

Rev	Revision	By	Date
C	AIR INTAKE LOUVRE RELOCATED FROM 4TH FLOOR SAFFRON HILL ELEVATION - REFER TO DRAWING ML2918_G-5_903	TK	15.05.18
B	AIR INTAKE LOUVRE RELOCATED FROM 5TH FLOOR	TK	15.05.18
A	REVISED TO SUIT PLANNING OFFICERS COMMENTS	NS	07.08.18
-	DRAWING FIRST ISSUED	TC	16.05.18

FOR PLANNING

Morgan Lovell

16 Noel Street London W1F 8DA  
 T: 0207 734 4466 F: 0207 734 2968 E: contact@morganlovell.com  
 W: http://www.morganlovell.com

Client  
**SAFFRON HOUSE**

Project  
 6-10 KIRBY STREET  
 LONDON  
 EC1N 8TS

Title  
**4TH & 5TH PROPOSED SIDE ELEVATION (D)**

Scale	Date	Designer/Drawn By	Checked By / Date
1:50@A1	26.06.18	TC/TC	

Drawing Number			
Project No.	Floor	Drawing No.	Rev
ML2918	4-5	907	C