


Existing plan

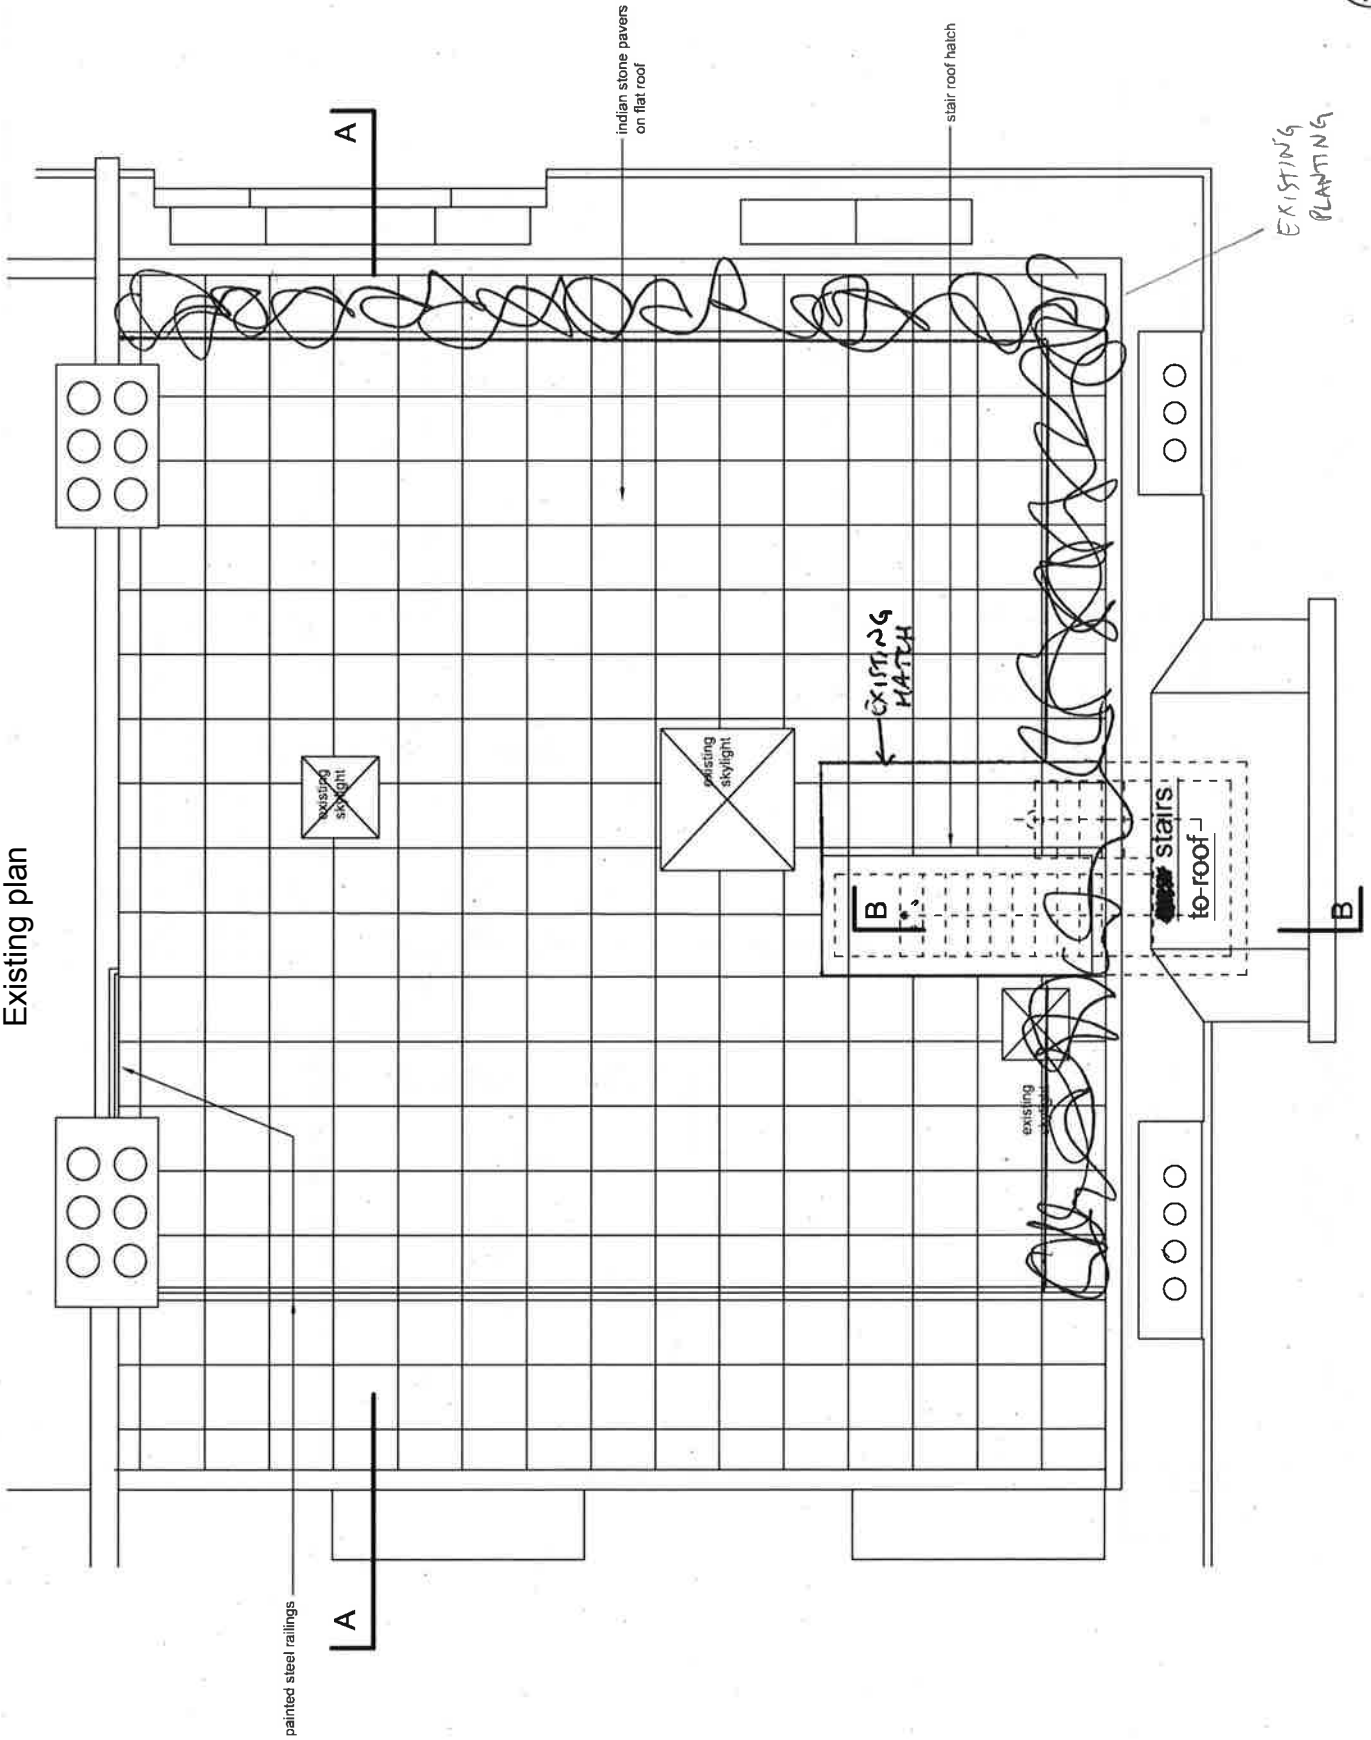

NOT TO SCALE UNLESS  
PRINTED ON A3 PAPER


Timothy Gale AIA  
Summer Court, 10oley Road  
Harrrogate HV2 8TG

**Flat 4**  
**70 Aberdare Gdns.**  
**London NW6**

Roof Plan

Date: Nov. 2011  
Page No: 2  
Number: A  
Scale: 1:50

Proposed plan

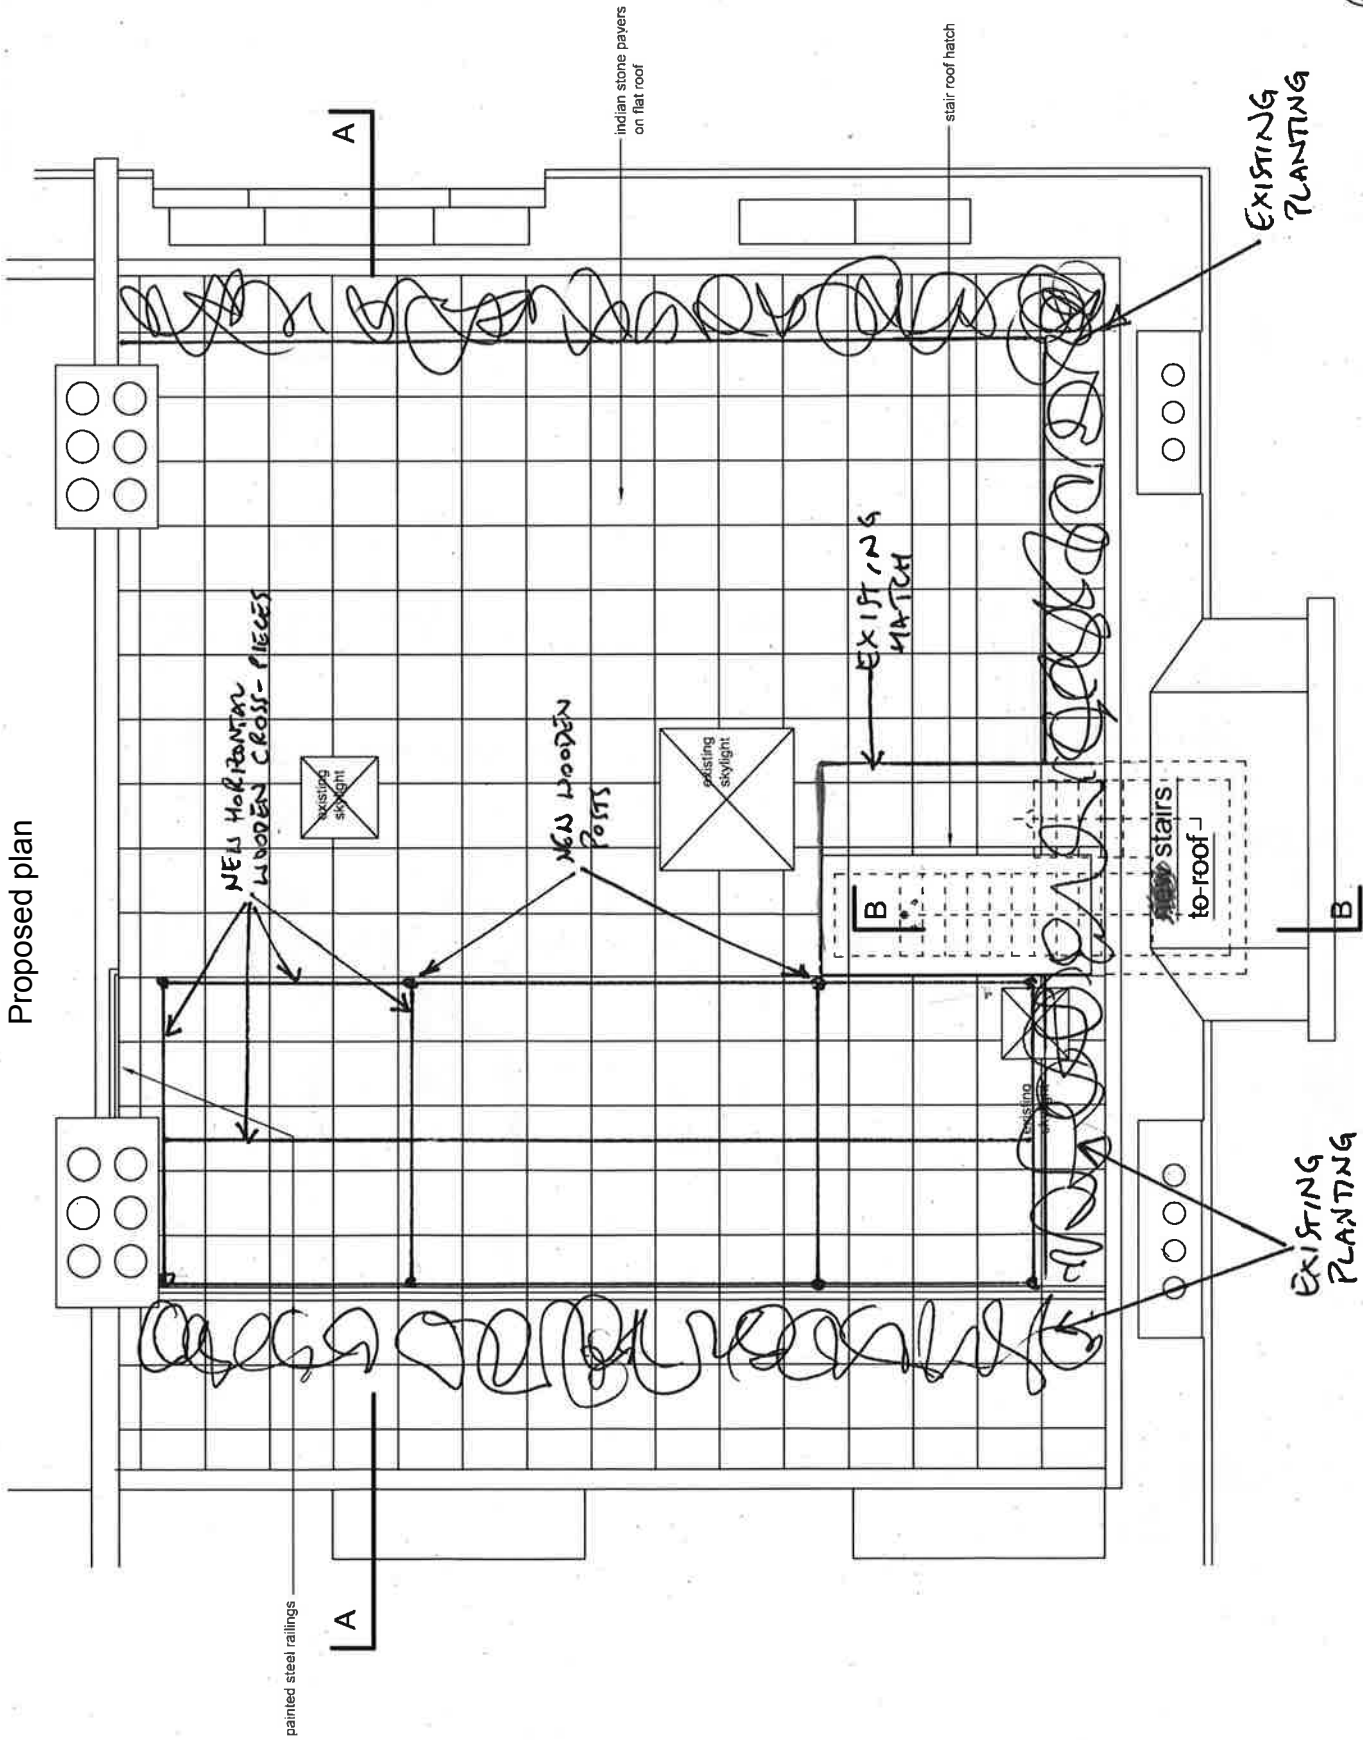

Painted steel railings

Indian stone pavers on flat roof

stair roof hatch

EXISTING PLANTING

EXISTING PLANTING



NOT TO SCALE UNLESS PRINTED ON A3 PAPER

Timothy Gale AIA  
Summer Court, 10 Play Road  
Harrogate, N52 8TG

Flat 4  
70 Aberdare Gdns  
London NW6

Roof Plan


date	revision
Nov. 2011	2
scale	1:50
A	

EXISTING  
PLASTERING

EXISTING  
PLASTERING

~~NOTE:~~  
Elevation not  
changed

East elevation existing

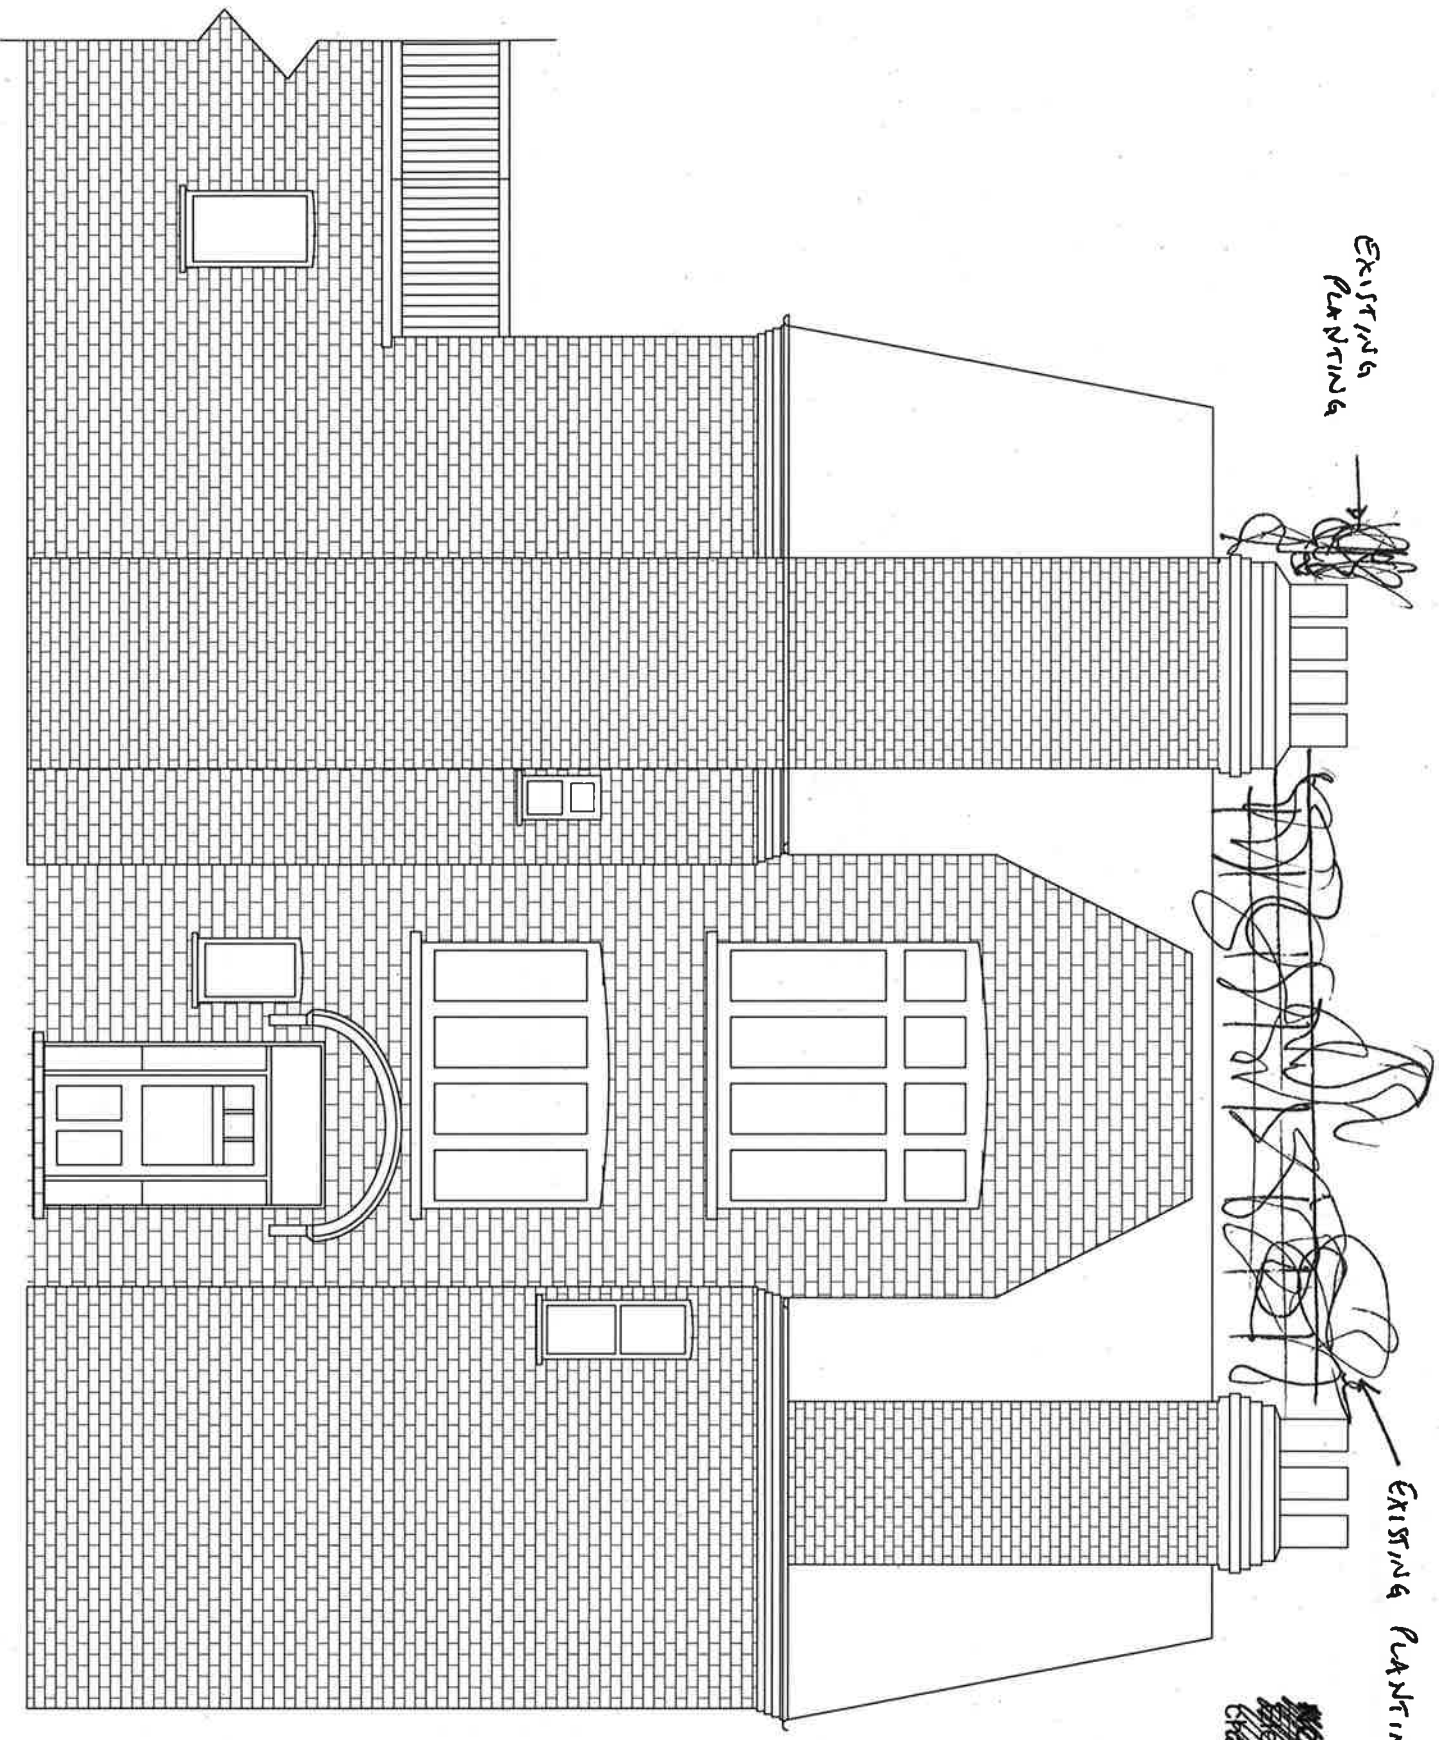

NOT TO SCALE UNLESS  
PRINTED ON A3 PAPER

Timothy Gale AIA  
Summer Court, 10 Hey Road  
Harringay, N52 8TG

Flat 4  
70 Aberdare Gdns.  
London NW6

East Elevation

Date: Nov 2011  
Scale: 1:50  
Sheet: 4  
Project: A


EXISTING RANTING

NOTE:  
~~EXISTING RANTING~~  
changed

NEW ABOVE  
FLAME

EXISTING  
RANTING

East elevation proposed

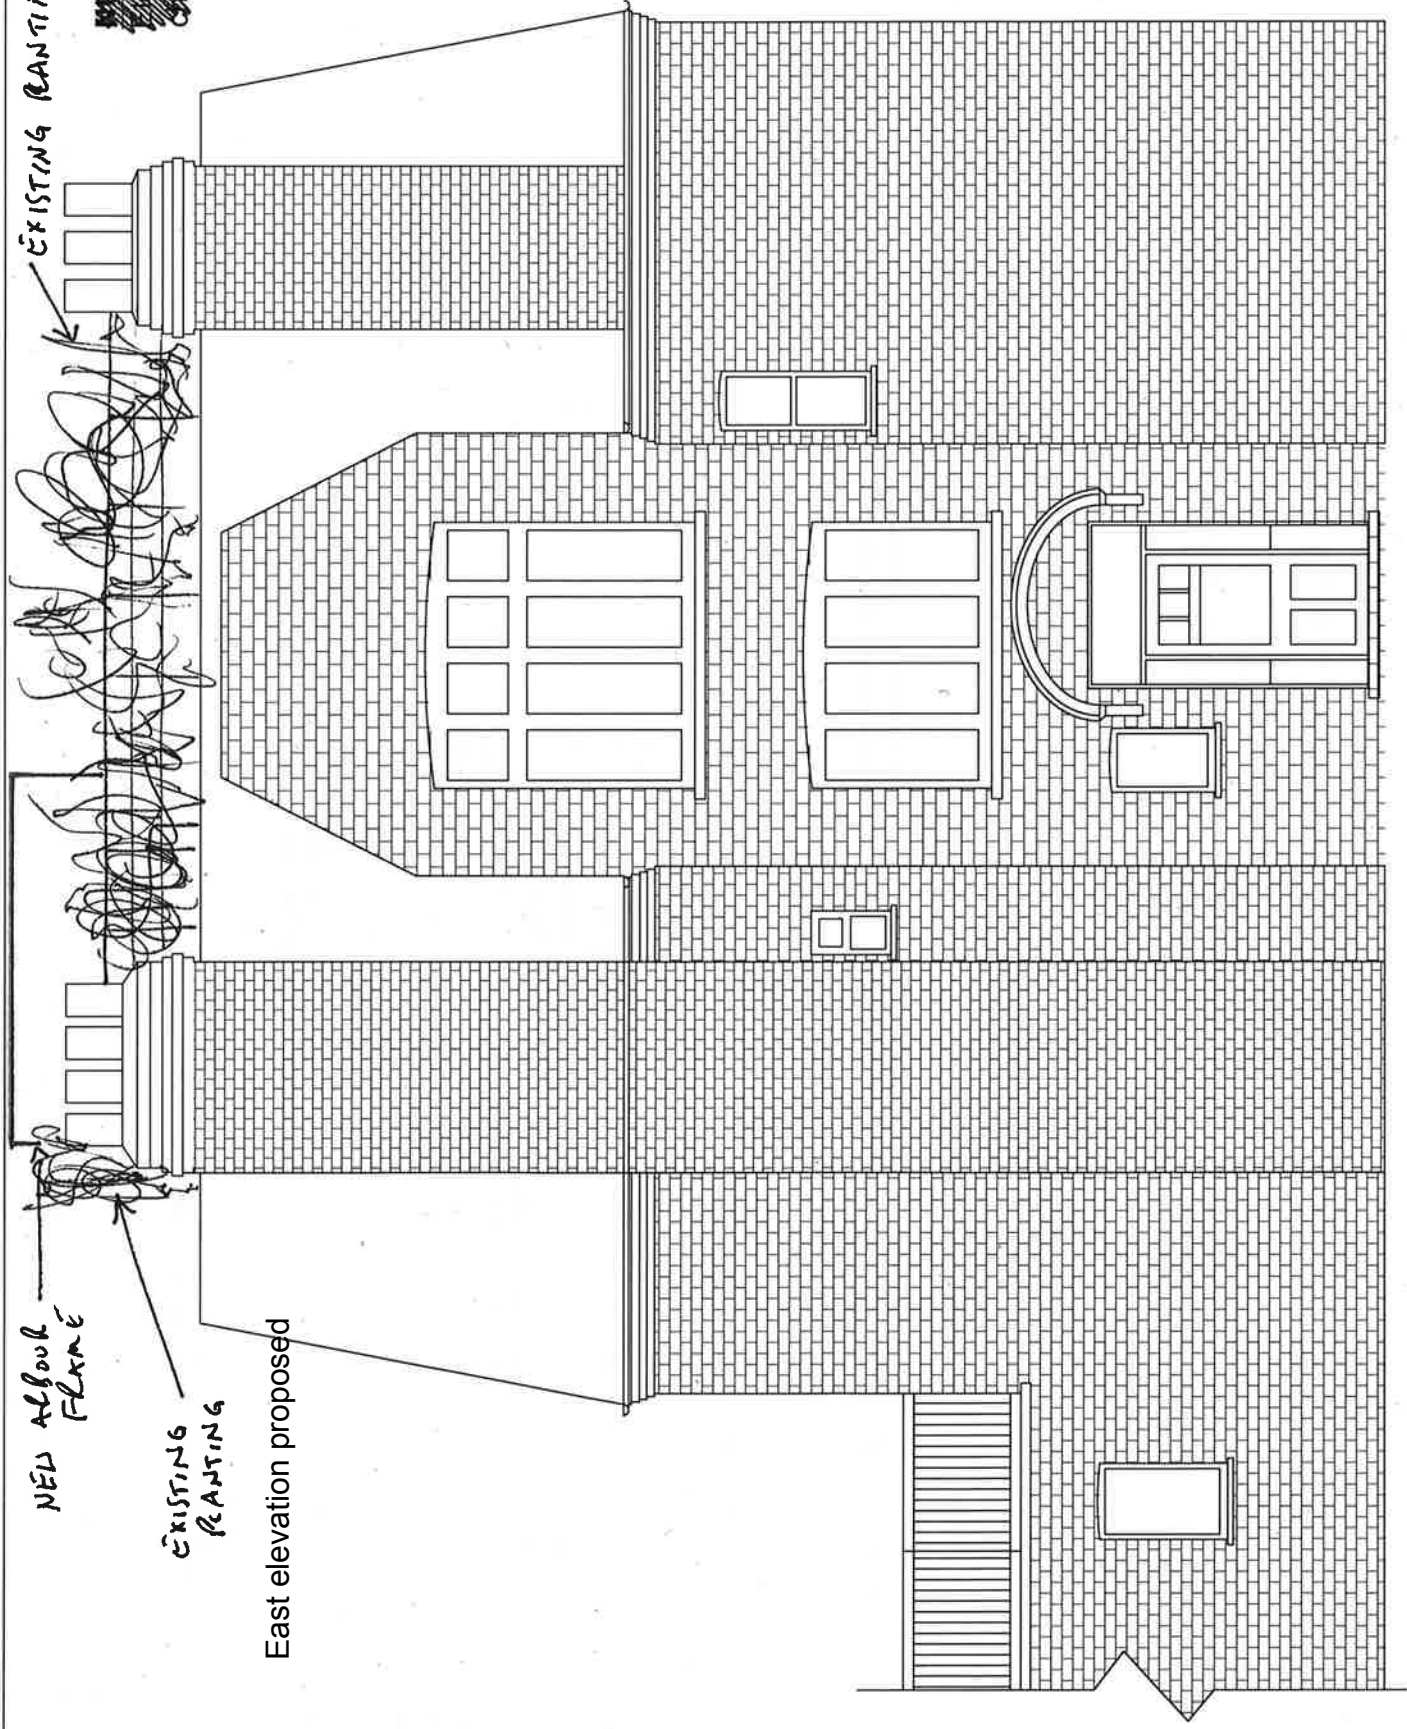

NOT TO SCALE UNLESS  
PRINTED ON A3 PAPER

NO.	DESCRIPTION	DATE
A		


Timothy Gale AIA  
Summer Court, 1 Orley Road  
Harrogate, W52 8TG

Flat 4  
70 Aberdare Gdns.  
London NW6

East Elevation

DATE	NO.	REVISION
Nov. 2011	4	A
SCALE		1:50

South elevation existing

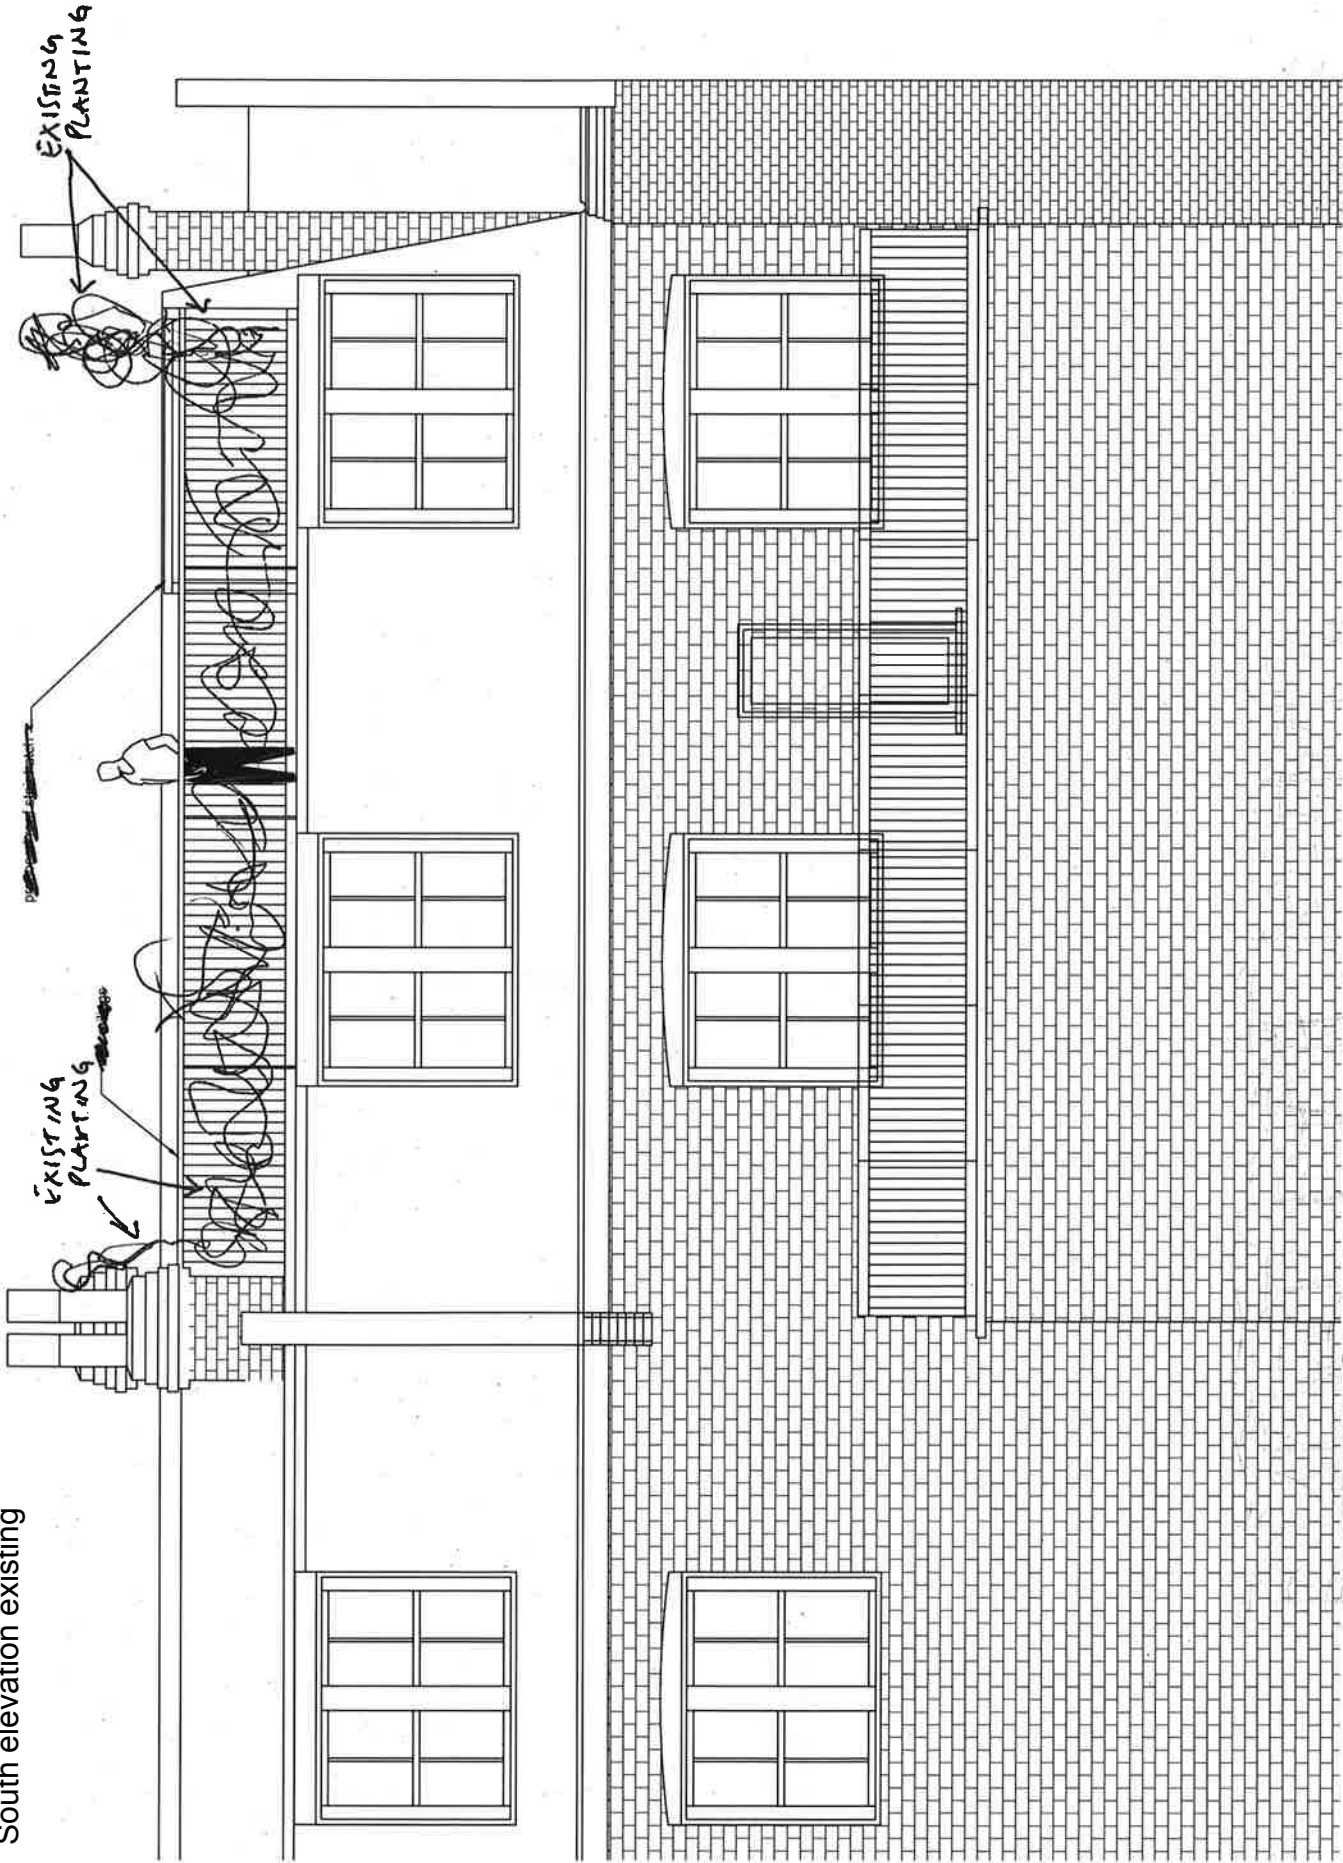

NOT TO SCALE UNLESS  
PRINTED ON A3 PAPER

A	
REV	
DATE	

Timothy Gale AIA  
Summer Court, 1 Otley Road  
Harrrogate IV32 8TG

**Flat 4**  
**70 Aberdare Gdns.**  
**London NW6**


South Elevation

Date	Nov. 2011
Page No.	5
Sheet	A

1:50



South elevation proposed

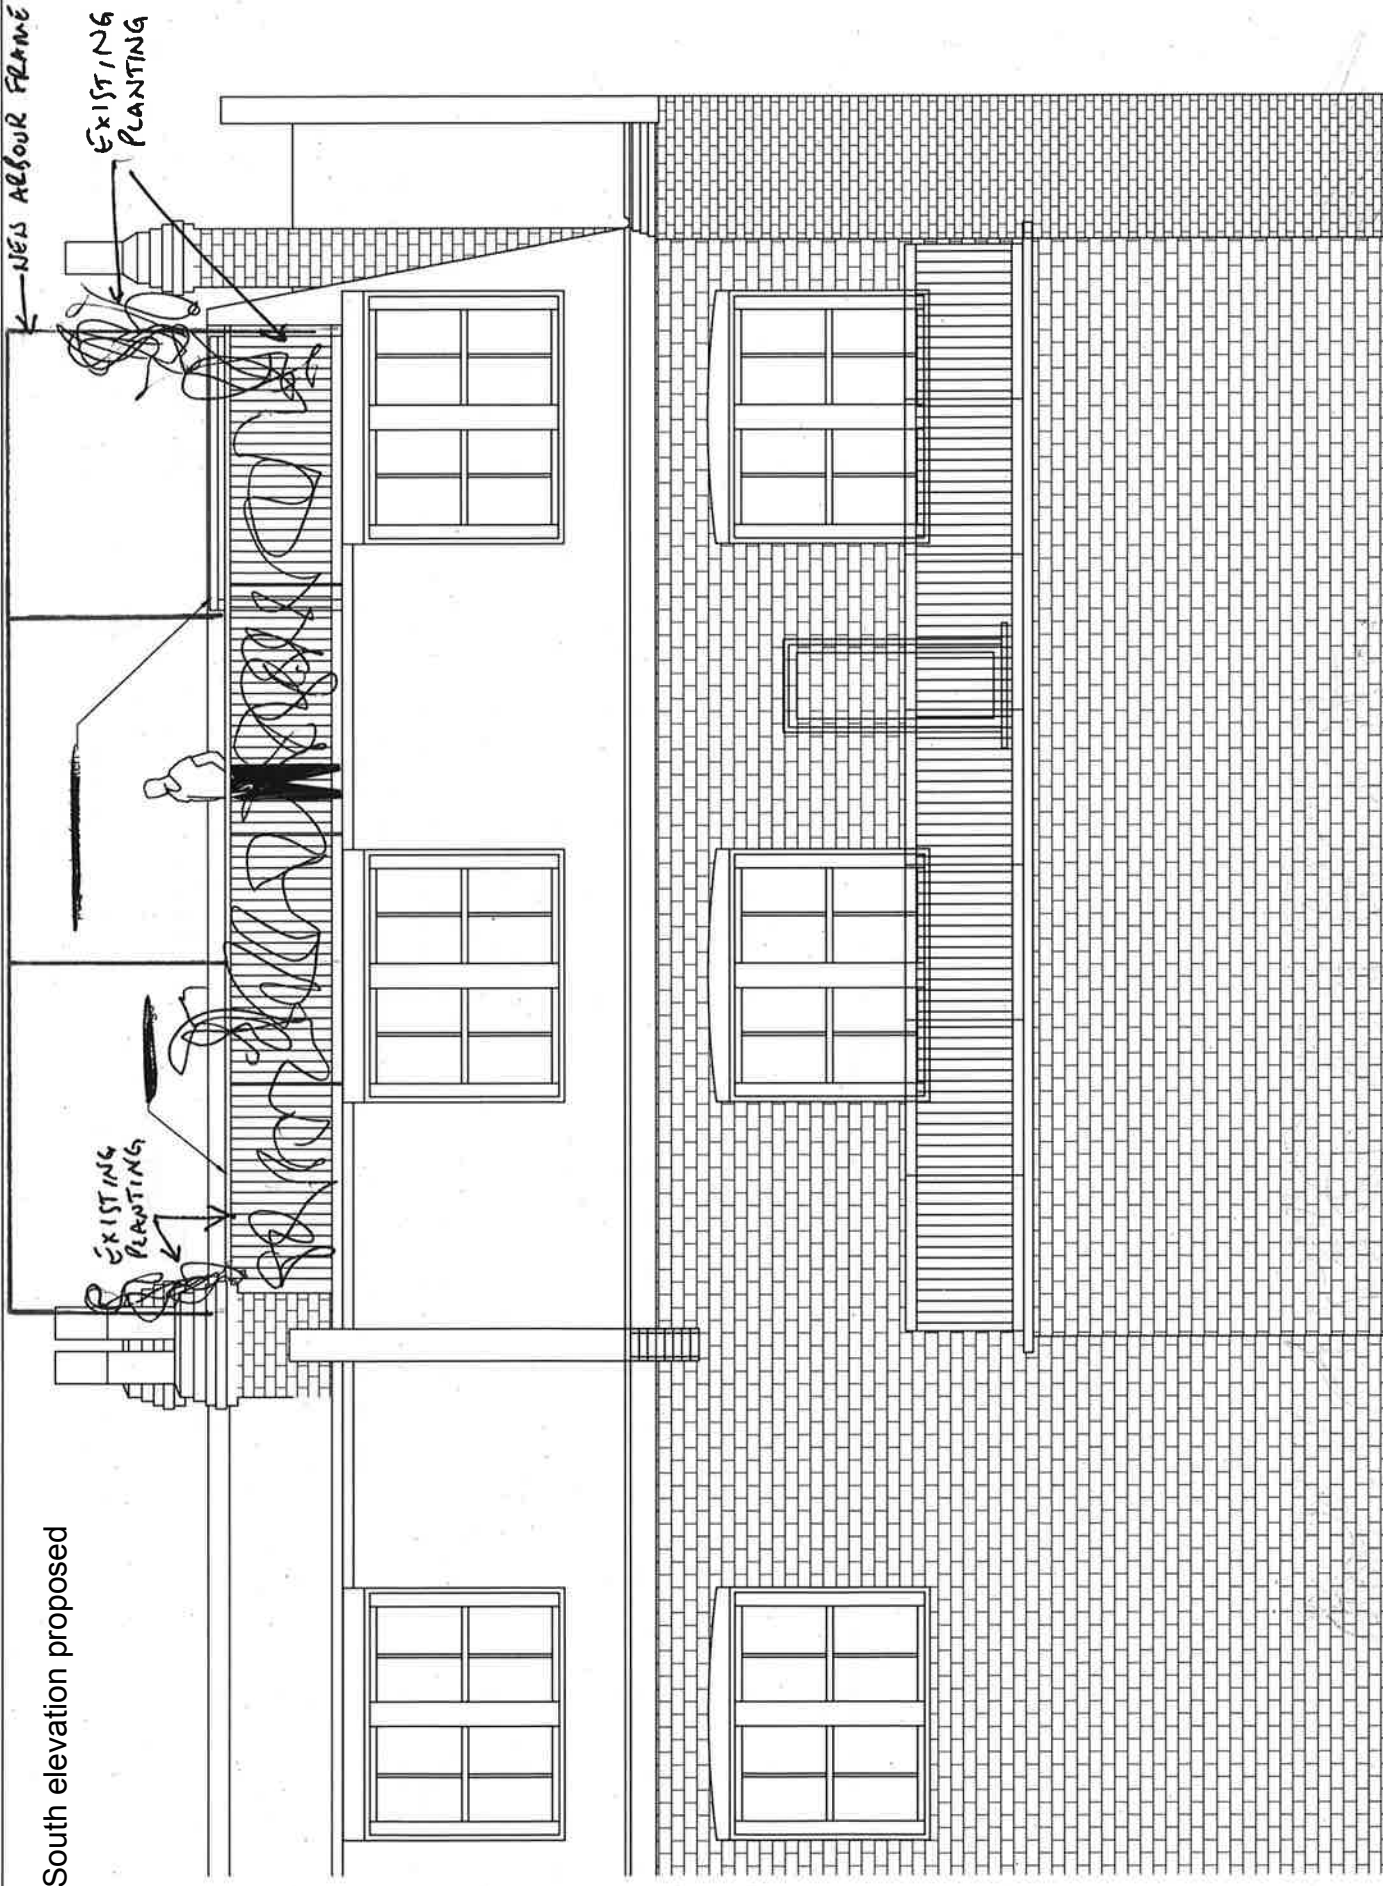

NOT TO SCALE UNLESS  
PRINTED ON A3 PAPER

no.	changes	date
A		


Timothy Gale AIA  
Summer Court, 1 Clifley Road  
Harrogate IV52 8TG

**Flat 4**  
**70 Aberdare Gdns.**  
**London NW6**

South Elevation


date	drawn no.	revision
Nov. 2011	5	A
scale		
1:50		

North elevation existing

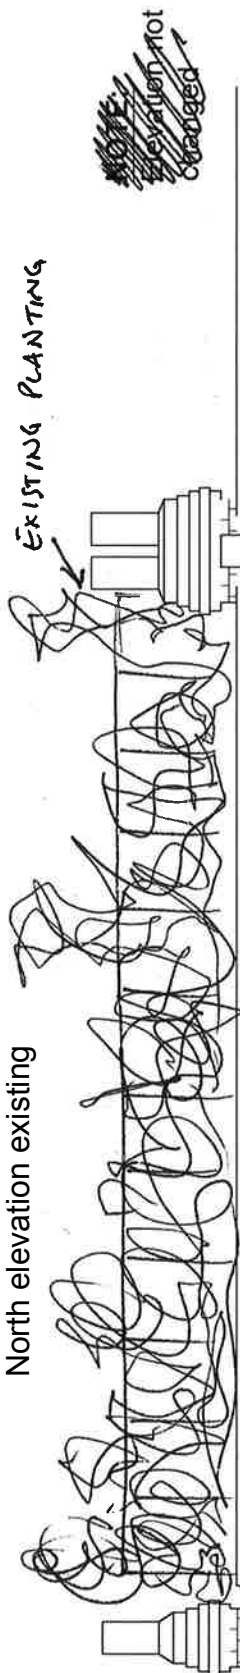

EXISTING PLANTING

~~Elevation not changed~~

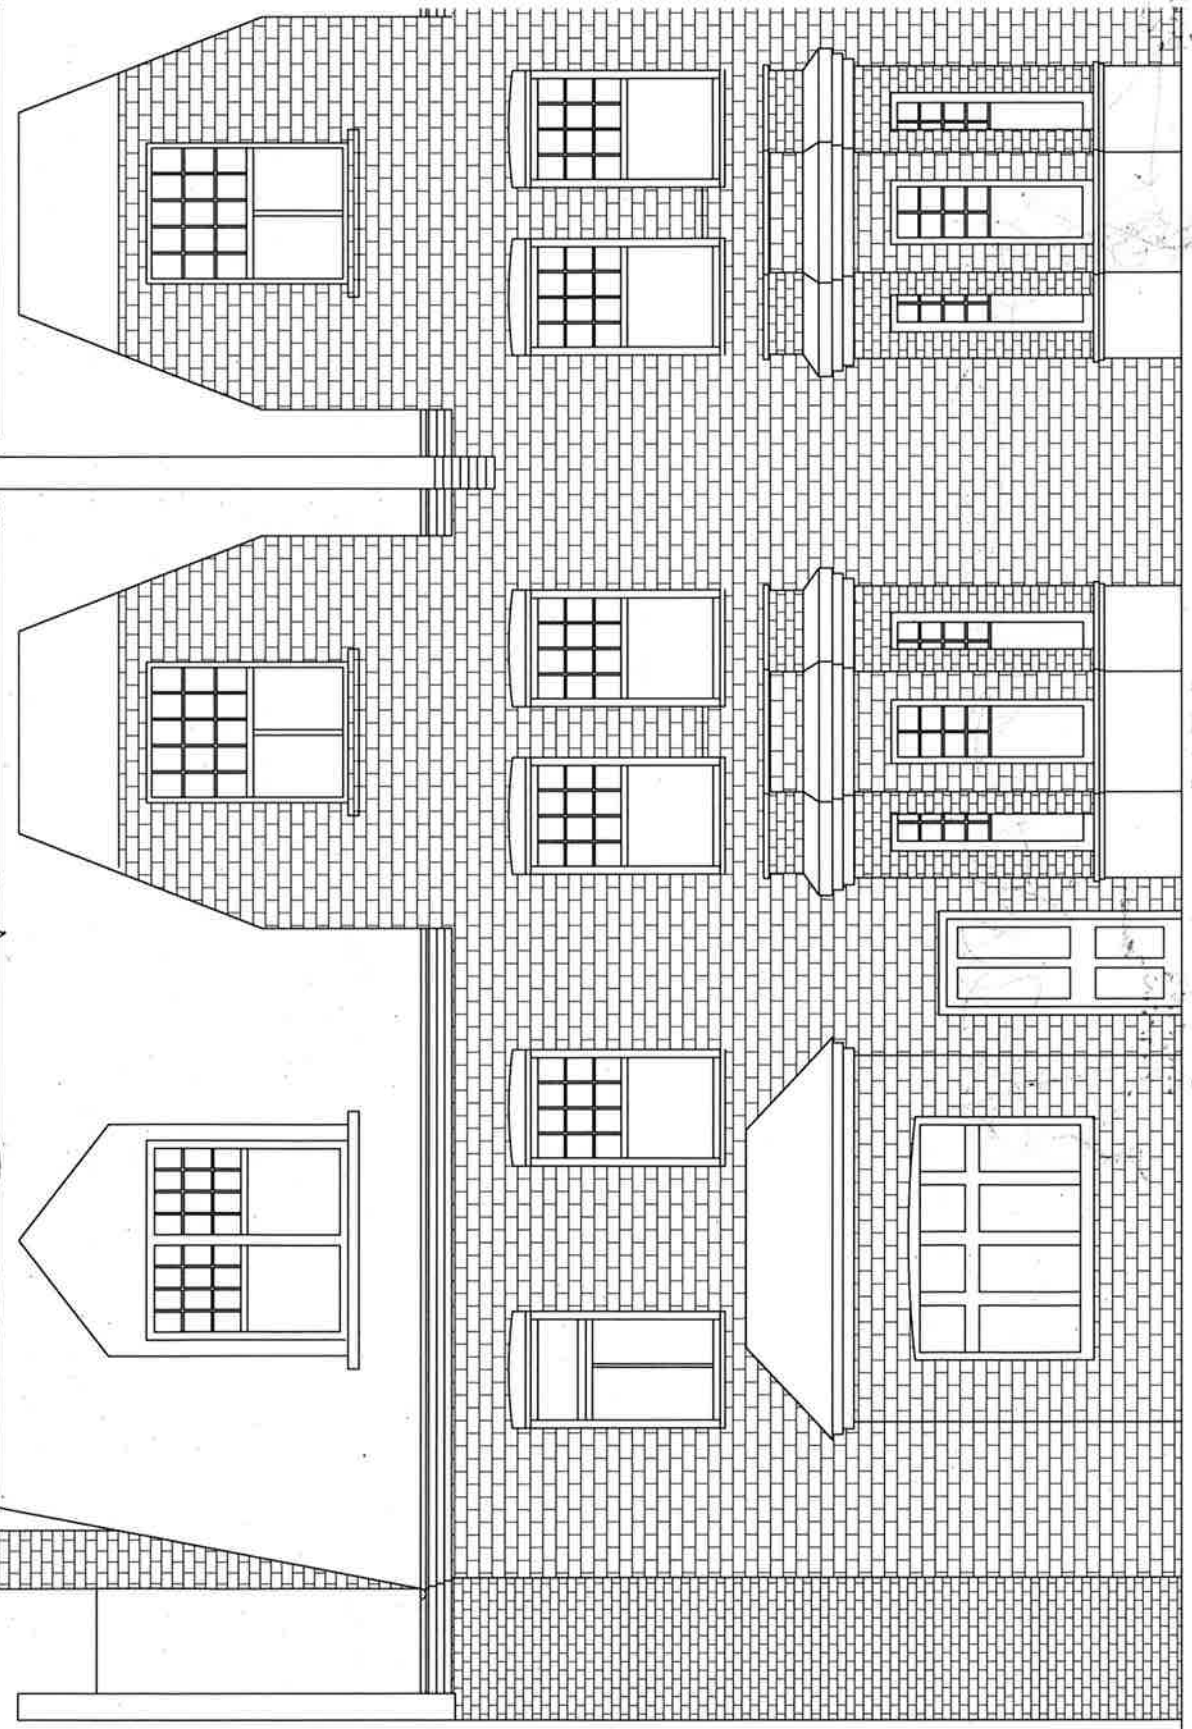

NOT TO SCALE UNLESS  
PRINTED ON A3 PAPER

A		
Rev	Drawn by	Scale


Timothy Gale AIA  
Summer Court, 10 Hey Road  
Harrogate HG2 8TG

**Flat 4**  
**70 Aberdare Gdns.**  
**London NW6**

North Elevation

Nov 2011  
Page No. **6**  
1:50  
**A**

North elevation proposed

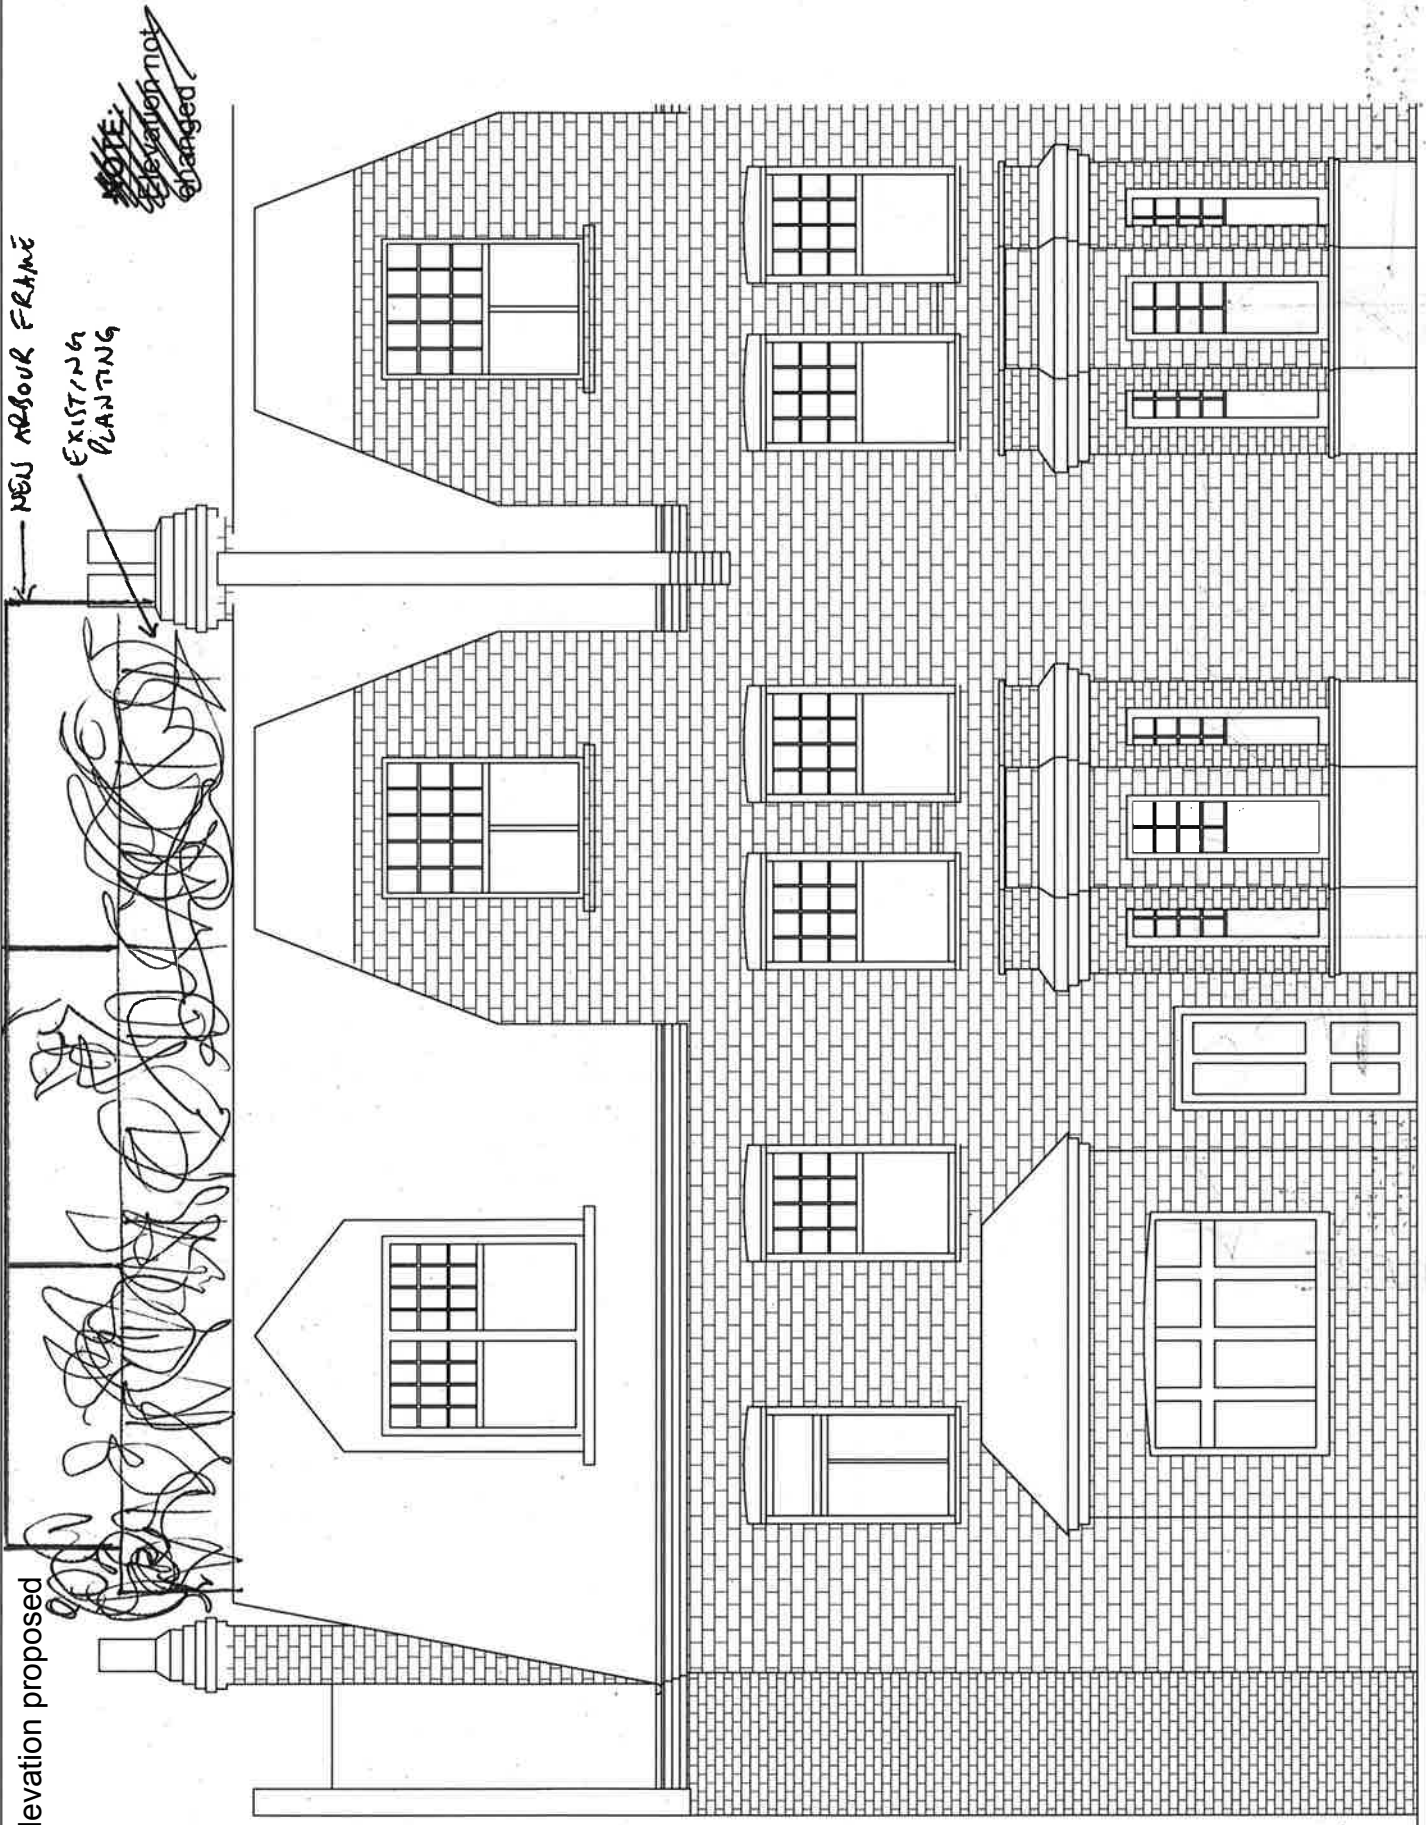

NOT TO SCALE UNLESS  
PRINTED ON A3 PAPER

A	REV	DATE

Timothy Gale AIA  
 Summer Court, 10 Oley Road  
 Harrogate, W52 8TG

**Flat 4**  
**70 Aberdare Gdns.**  
**London NW6**  
 North Elevation

DATE	NOV. 2011
NO. OF SHEETS	6
SCALE	1:50

A