


 Existing tree to be protected as per arborist information and recommendation

Red line denotes extent of existing buildings

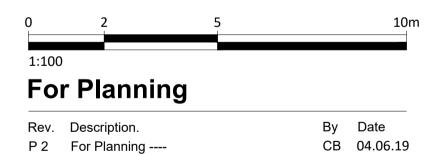

Cogress Ltd

Droiget

24-26 Redington Gardens

Title

Drawing No.

No. 25-26 Proposed Basement Plan


A101			P 2
Project No.	Scale	1:100 @ A1	1:200 @ A3
000	Drawn	Checked	Date
020	СВ	СВ	10.05.2019

Do not scale from this drawing. All dimensions should be checked and confirmed on site before the commencement of work. All discrepancies must be reported. Subcontractors must verify all dimensions on site before making a shop drawing or commencing manufacturing. This drawing is subject to copyright. ©




Unit 5, Sayer House Horseshoe Close, London, NW2 7JN T +44 (0)20 8450 5747 E info@myconstruction.co.uk

Rev.

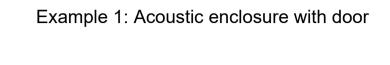

Example 2: Acoustic louvred wall

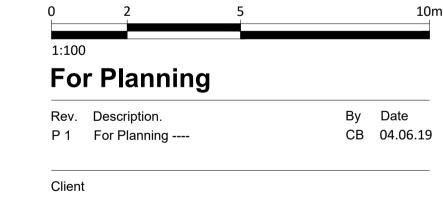

Cogress Ltd

Project

24-26 Redington Gardens

Title


Drawing No.


No. 25-26 Proposed Lower Ground Floor Plan


A110			P 1
Project No.	Scale	1:100 @ A1	1:200 @ A3
	Drawn	Checked	Date
020	СВ	СВ	10.05.2019

Do not scale from this drawing. All dimensions should be checked and confirmed on site before the commencement of work. All discrepancies must be reported. Subcontractors must verify all dimensions on site before making a shop drawing or commencing manufacturing. This drawing is subject to copyright. ©



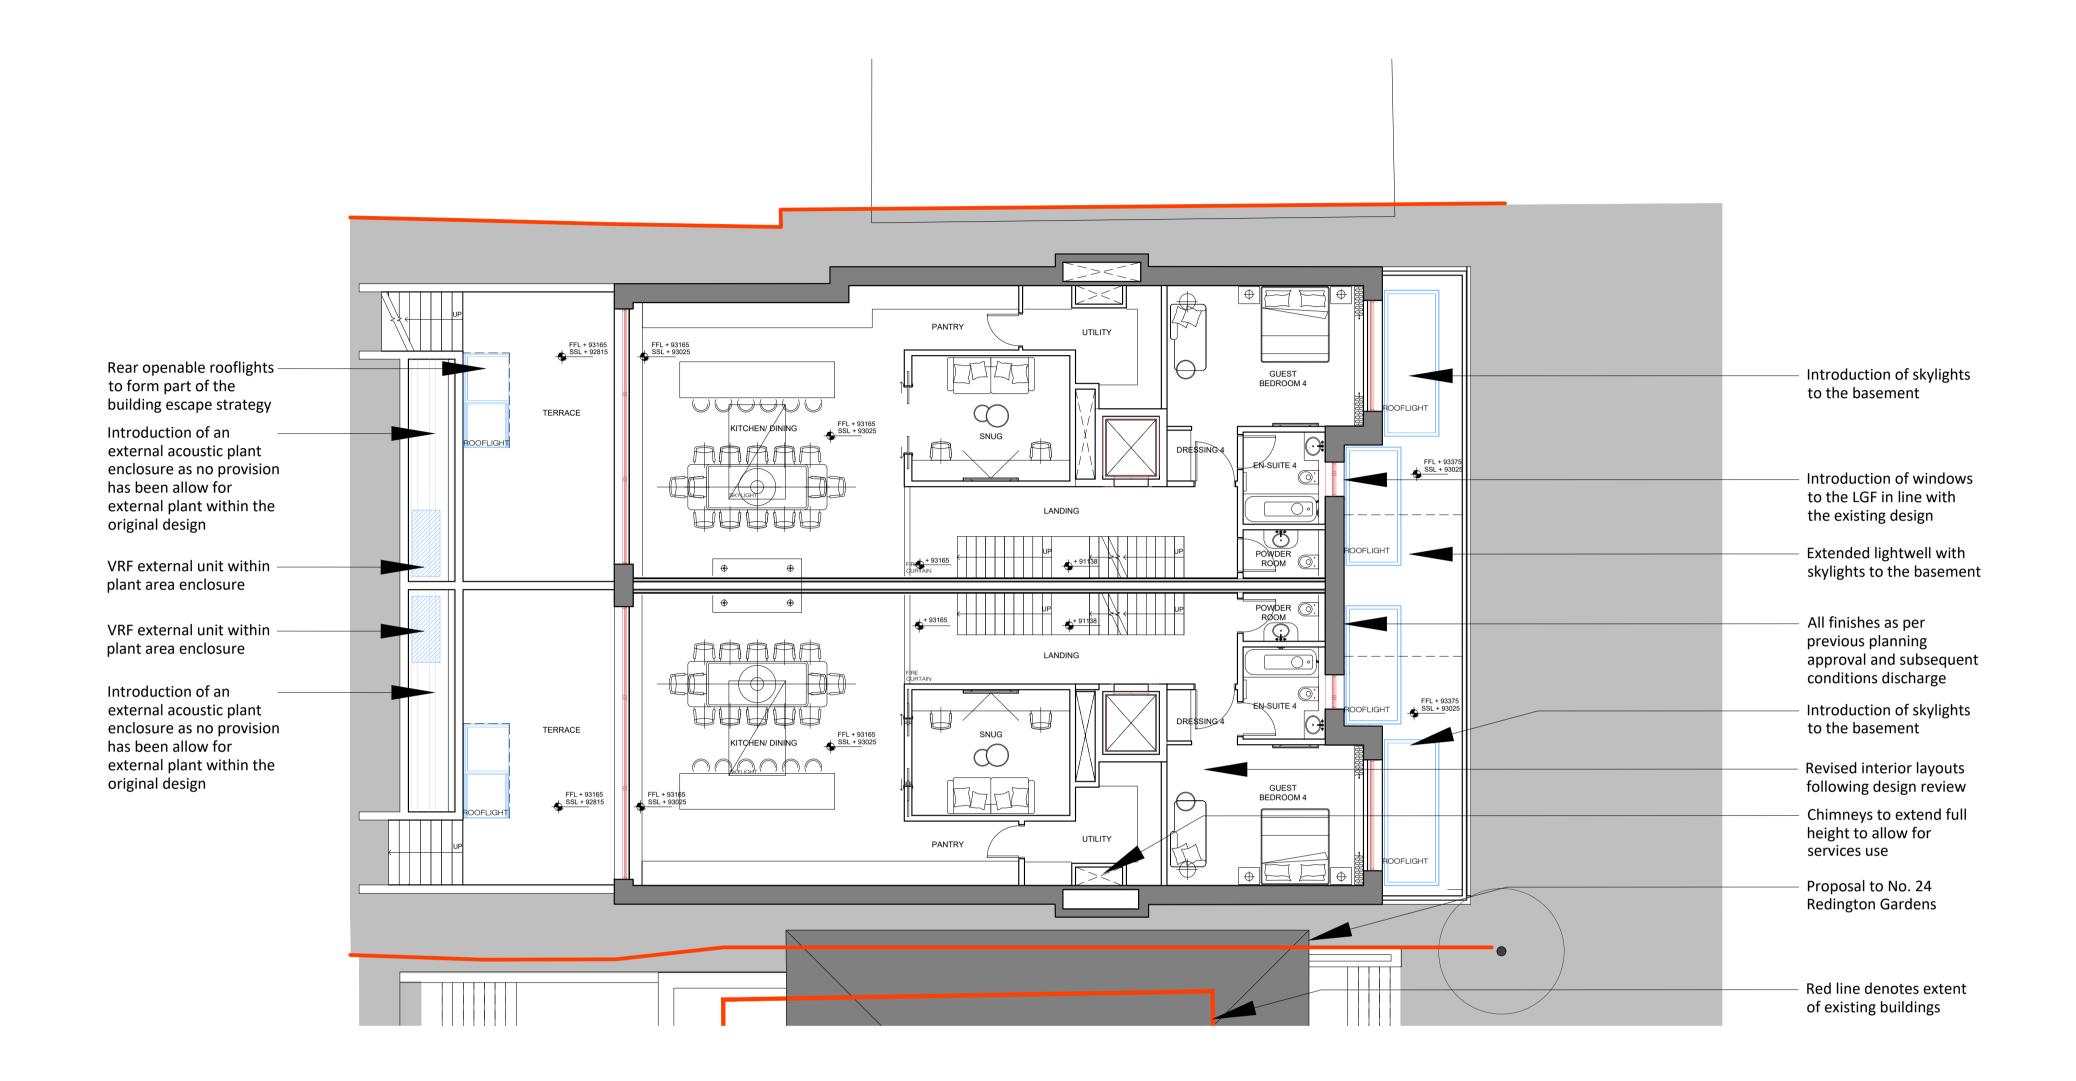

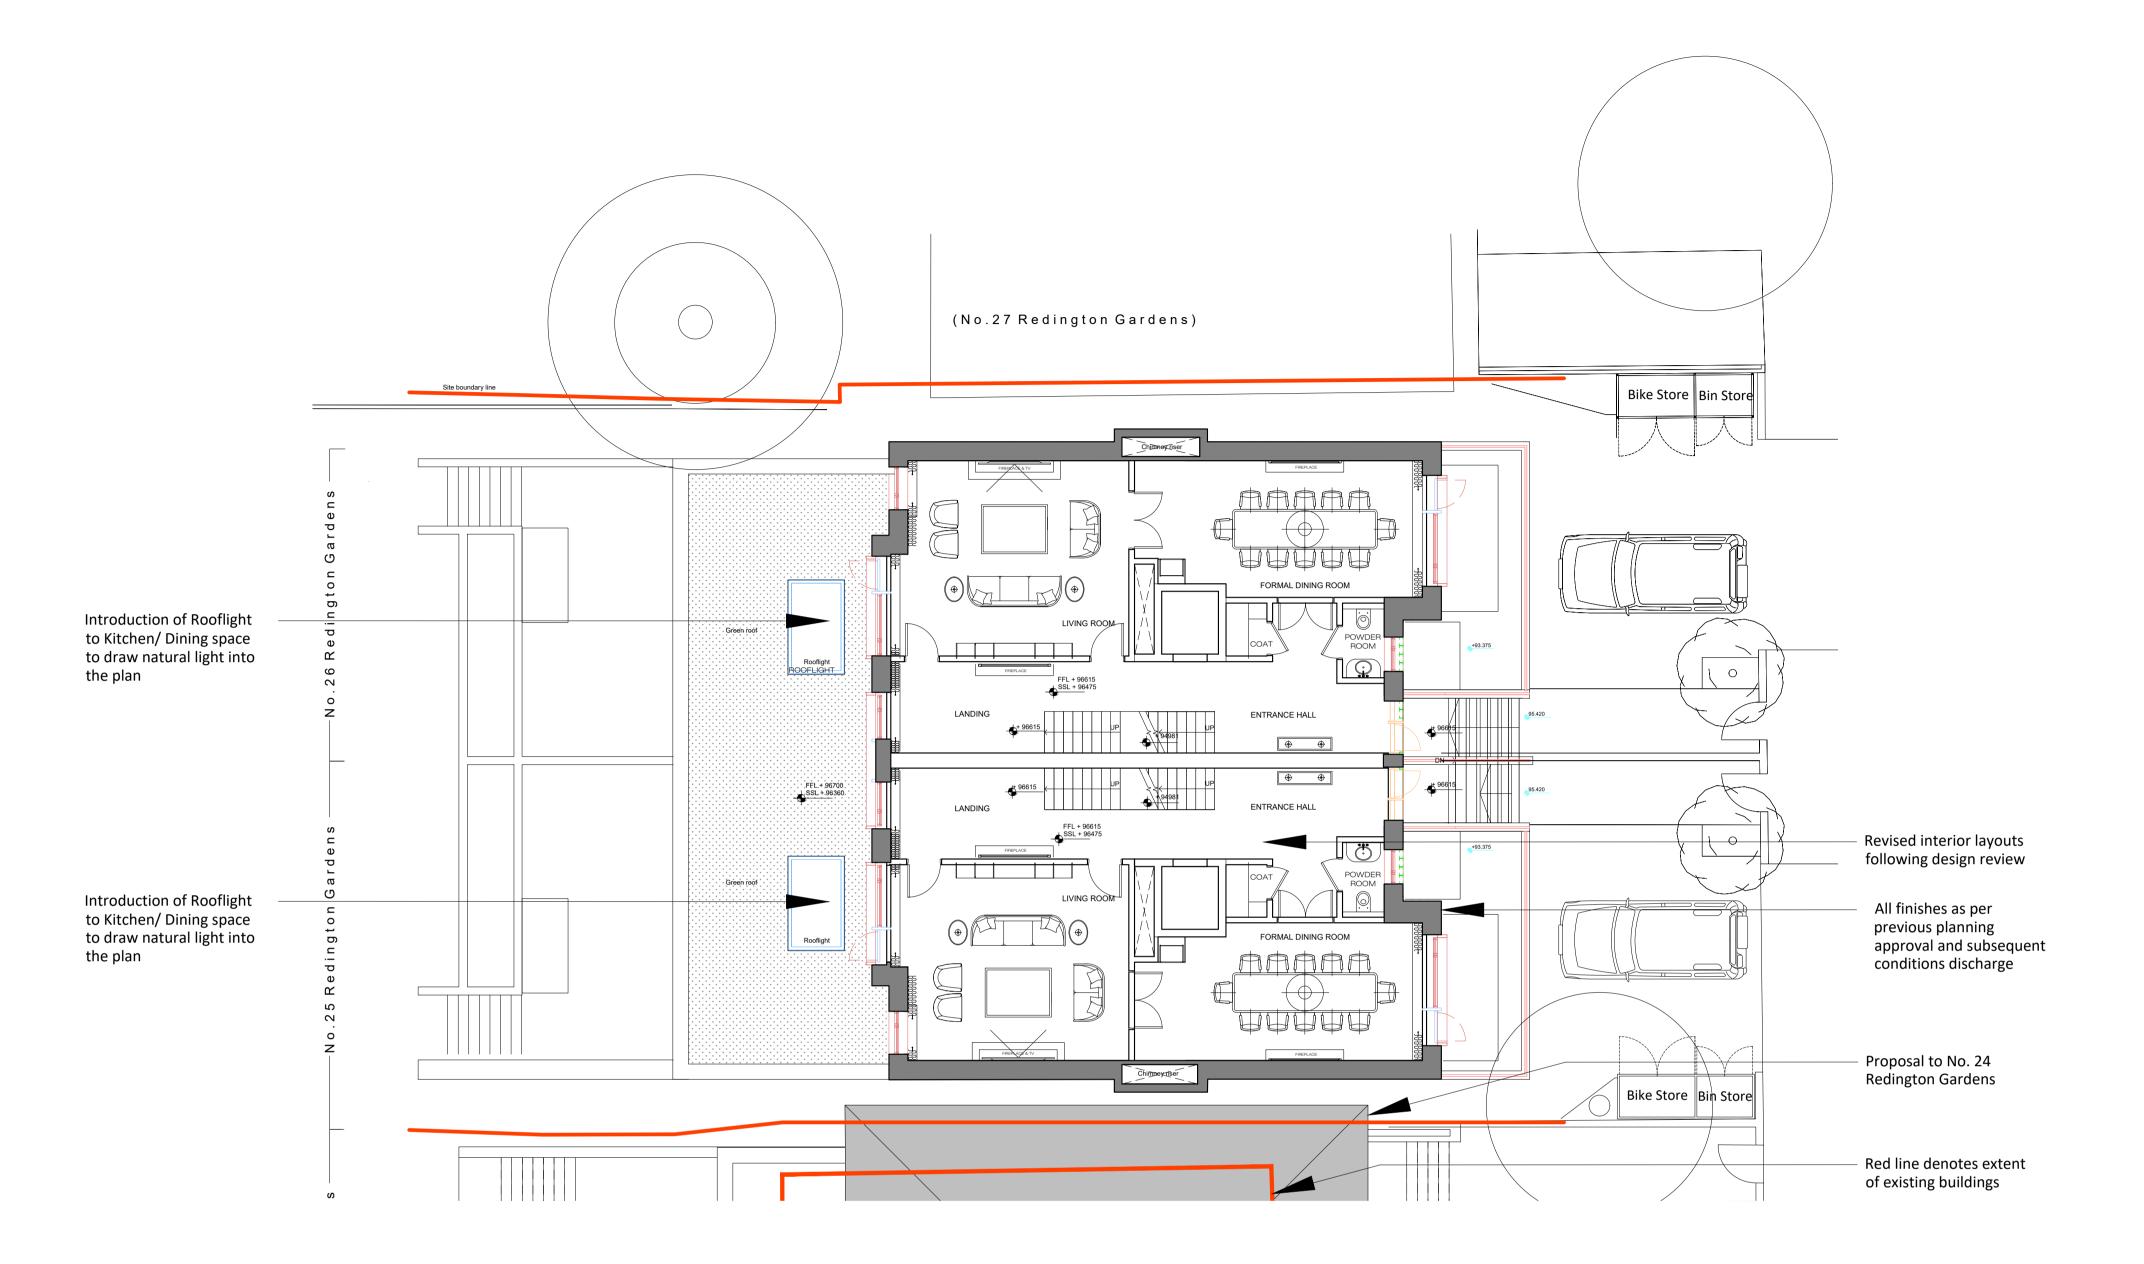

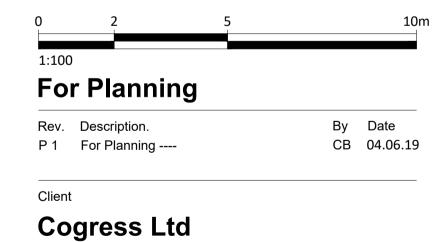

oogrood Ett

24-26 Redington Gardens


Title

No. 25-26 Proposed Upper Ground Floor Plan

Drawing No.			Rev.
A111			P 1
Project No.	Scale	1:100 @ A1	1:200 @ A3
020	Drawn CB	Checked CB	Date 10.05.2019


Do not scale from this drawing. All dimensions should be checked and confirmed on site before the commencement of work. All discrepancies must be reported. Subcontractors must verify all dimensions on site before making a shop drawing or commencing manufacturing. This drawing is subject to copyright. ©



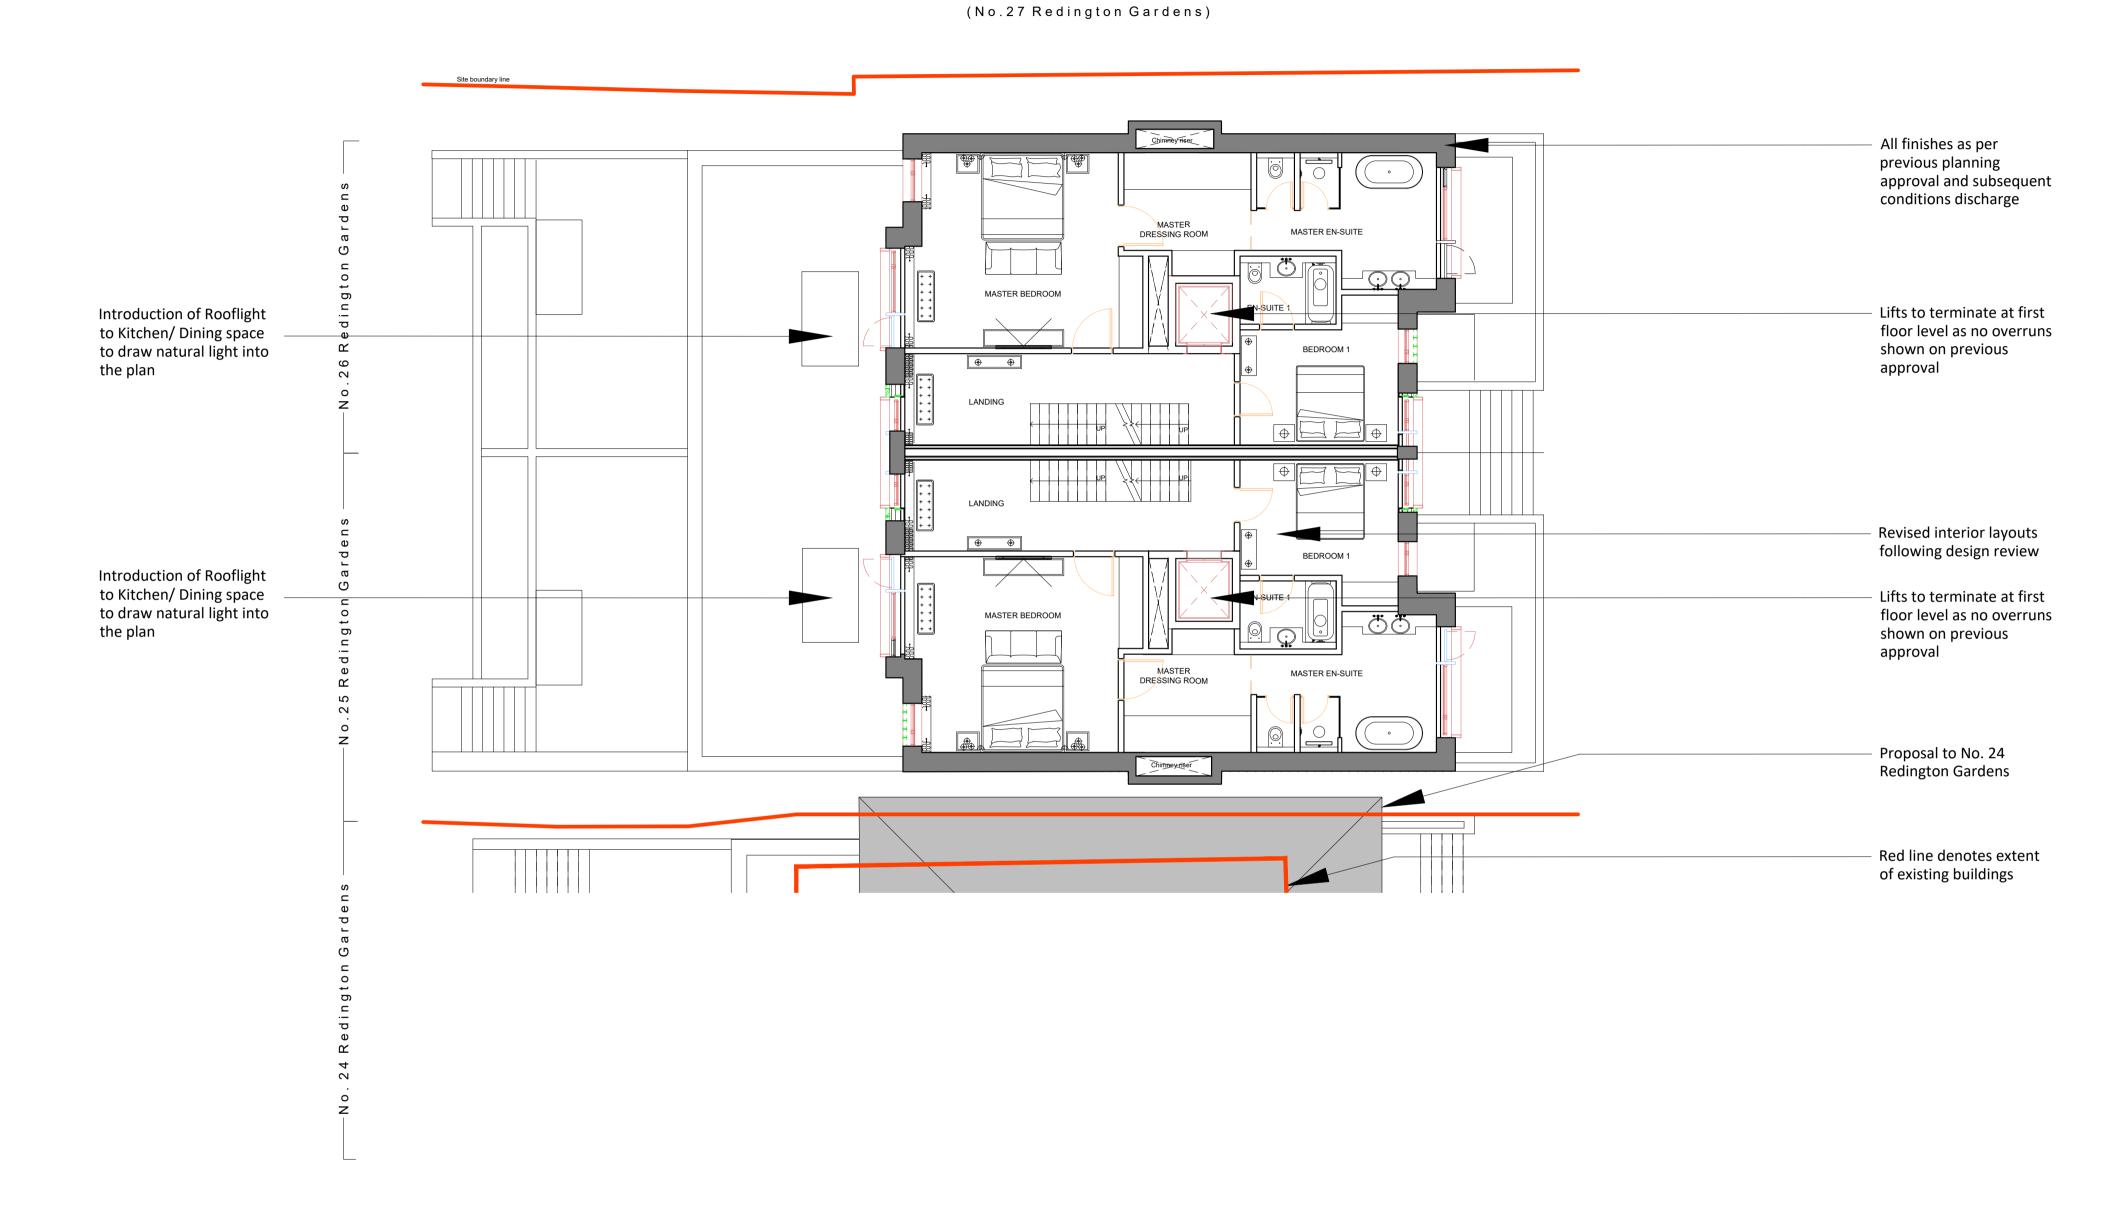

Notes:

1. This drawing replaces drawing A112

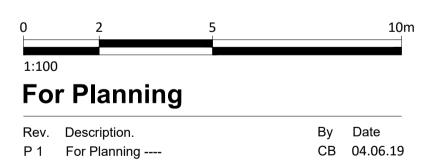

Cogress Ltd

24-26 Redington Gardens


No. 25-26 Proposed First Floor Plan

		Rev.
		P 1
Scale	1:100 @ A1	1:200 @ A
Drawn	Checked	Date
СВ	СВ	10.05.201
	Drawn	Drawn Checked

Do not scale from this drawing. All dimensions should be checked and confirmed on site before the commencement of work. All discrepancies must be reported. Subcontractors must verify all dimensions on site before making a shop drawing or commencing manufacturing. This drawing is subject to copyright. ©



(No.27 Redington Gardens)

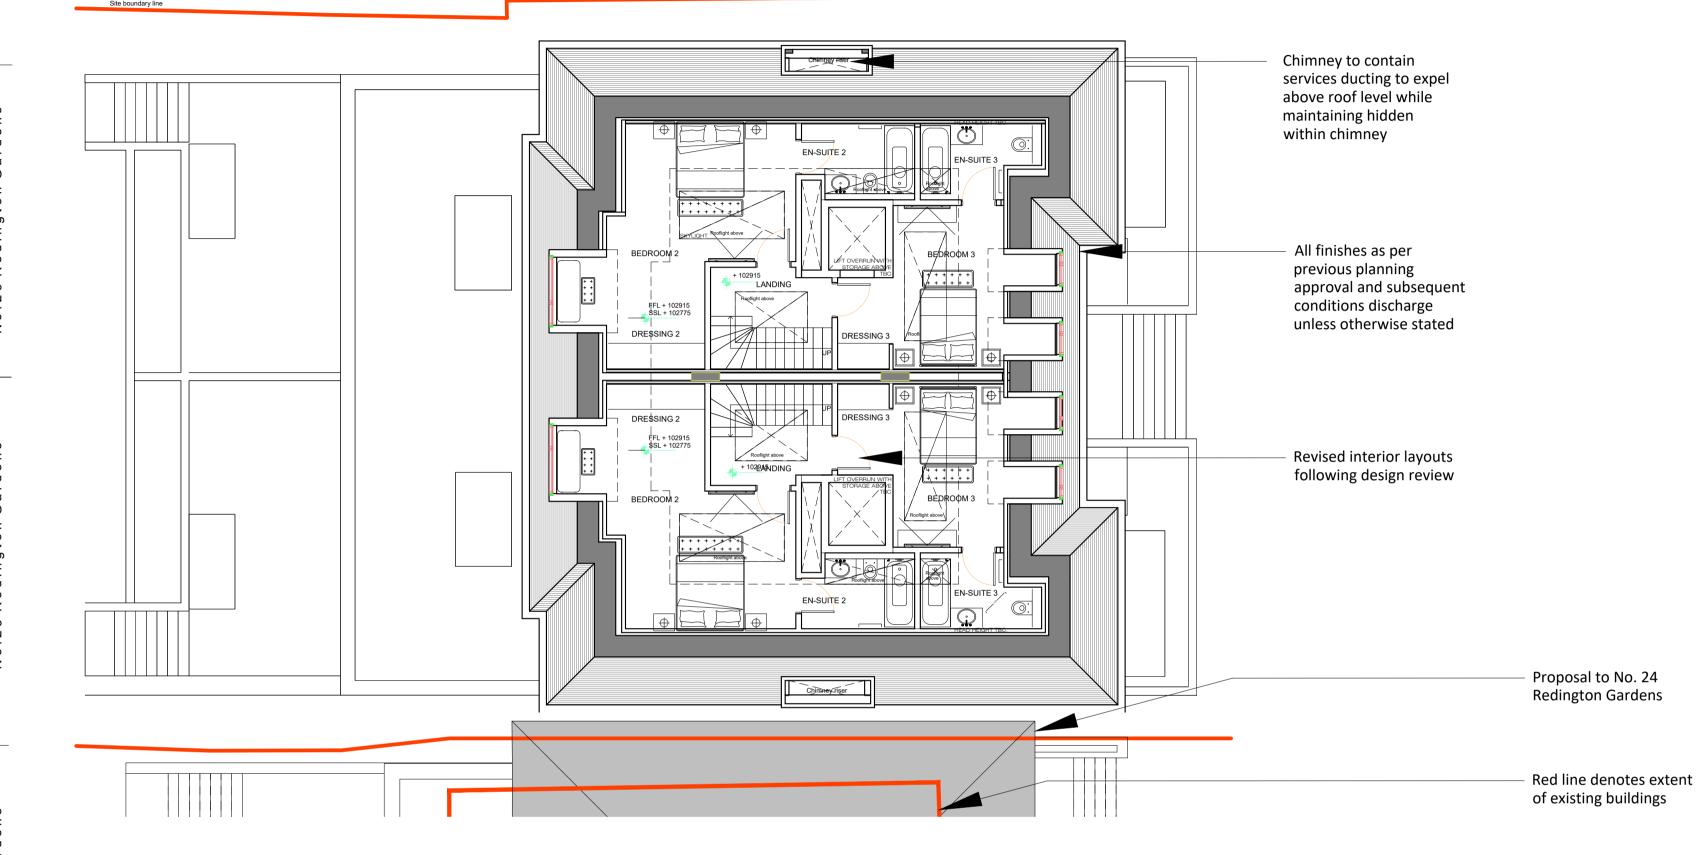

0	2	5		10m
1:100				
For F	Planning	9		
Rev. De	escription.		Ву	Date
P1 Fc	or Planning		СВ	04.06.19

Cogress Ltd

24-26 Redington Gardens

No. 25-26 Proposed

Second Floor Plan Drawing No.


A113			P 1
Project No.	Scale	1:100 @ A1	1:200 @
	Drawn	Checked	Date
020	СВ	СВ	10.05.201

Do not scale from this drawing. All dimensions should be checked and confirmed on site before the commencement of work. All discrepancies must be reported. Subcontractors must verify all dimensions on site before making a shop drawing or commencing manufacturing. This drawing is subject to copyright. ©



Unit 5, Sayer House Horseshoe Close, London, NW2 7JN T +44 (0)20 8450 5747 E info@myconstruction.co.uk

Rev.

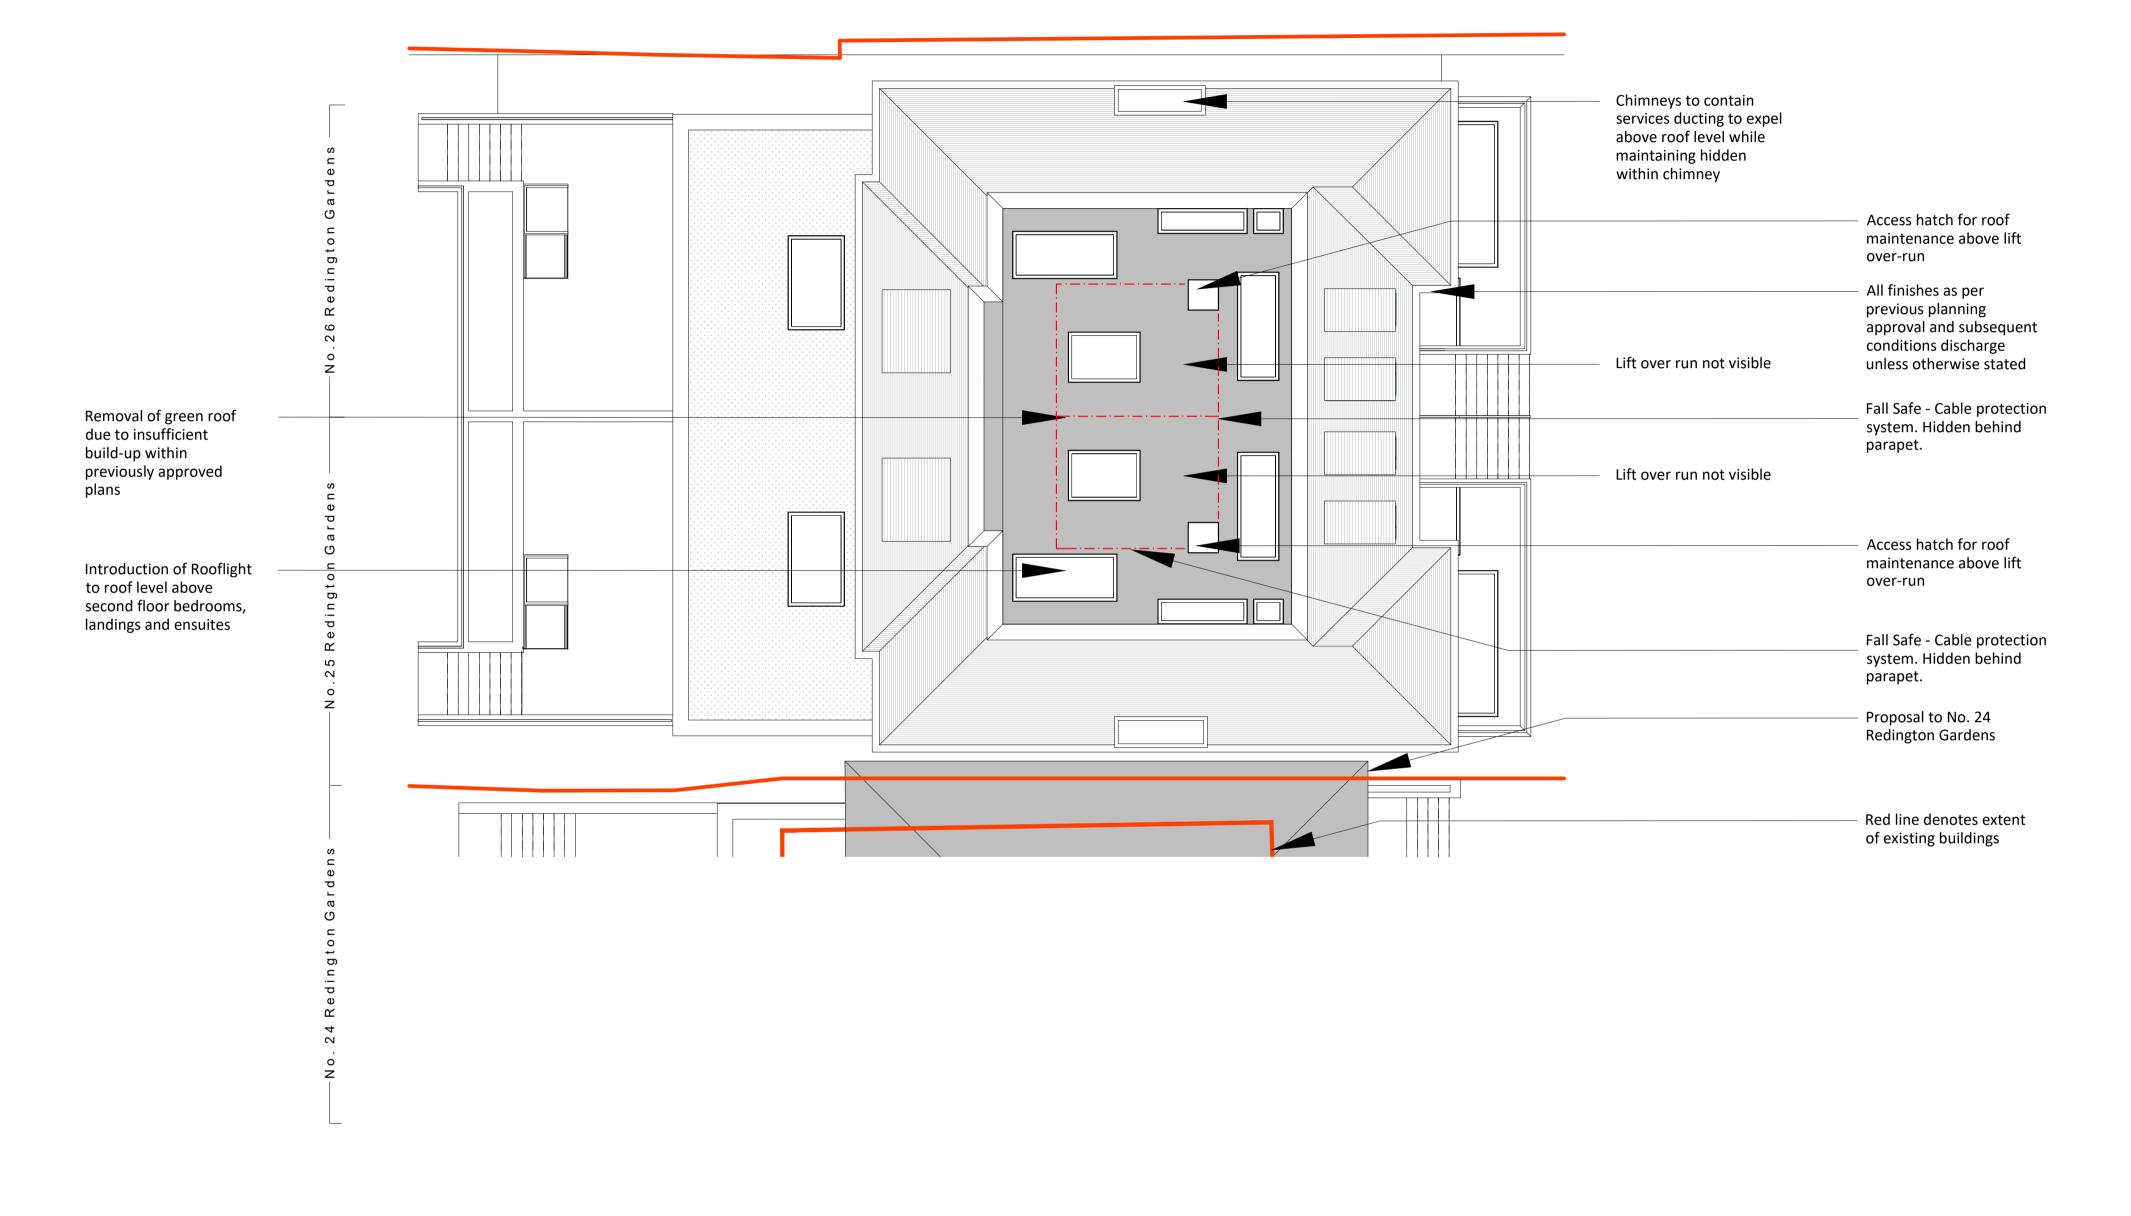

1:100)		
Fo	r Planning		
	Description.	By	Date
Rev.	Description.		

Cogress Ltd

Project

24-26 Redington Gardens


Title

No. 25-26 Proposed Roof Plan


Drawing No.			Rev.
A114			P 1
Project No.	Scale	1:100 @ A1	1:200 @ A3
020	Drawn CB	Checked CB	Date 10.05.2019

Do not scale from this drawing. All dimensions should be checked and confirmed on site before the commencement of work. All discrepancies must be reported. Subcontractors must verify all dimensions on site before making a shop drawing or commencing manufacturing. This drawing is subject to copyright. ©



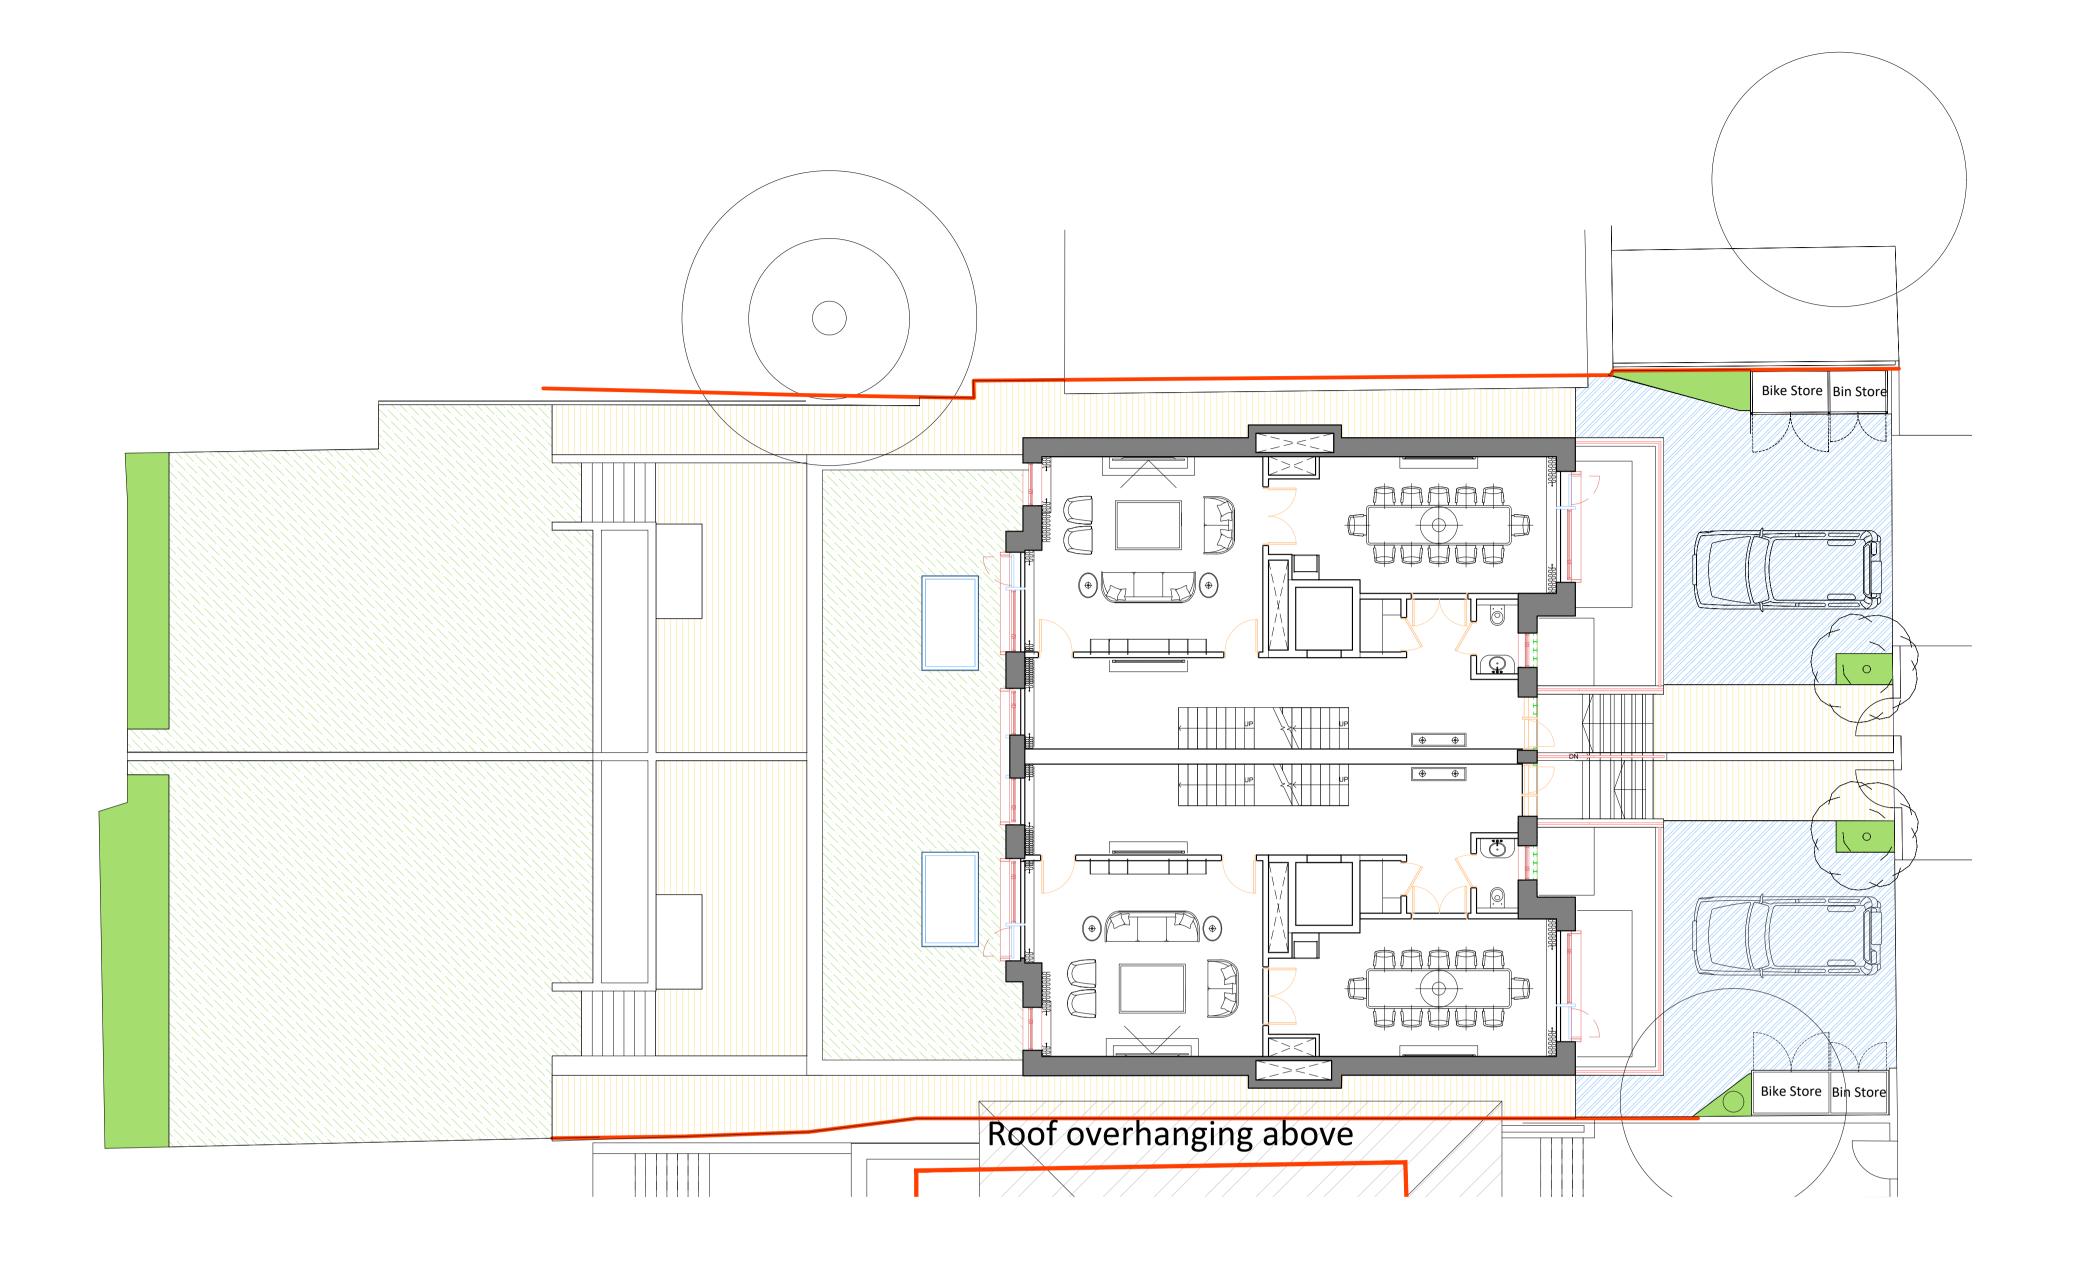

Do not scale from this drawing. All dimensions should be checked and confirmed on site before the commencement of work. All discrepancies must be reported. Subcontractors must verify all dimensions on site before making a shop drawing or commencing manufacturing. This drawing is subject to copyright. ©

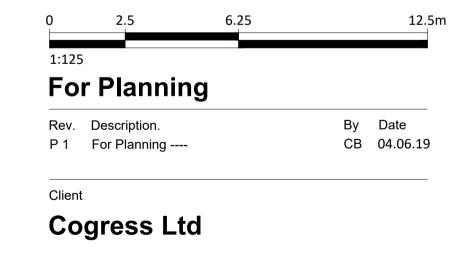

New sand bedded granite paving sets

New planting bed for trees/ shrubs/ flowers

Lawn/ Grass

New Stone Paving Slabs

24-26 Redington Gardens

Proposed Structural Landscaping

Drawing No.			Rev.
A800			P 1
Project No.	Scale	1:125 @ A1	1:250 @ A
000	Drawn	Checked	Date
020	СВ	СВ	10.05.2019
Do not scale from	n this drawing	All dimensions	should he

