


Notes:

1. This drawing replaces drawing A100


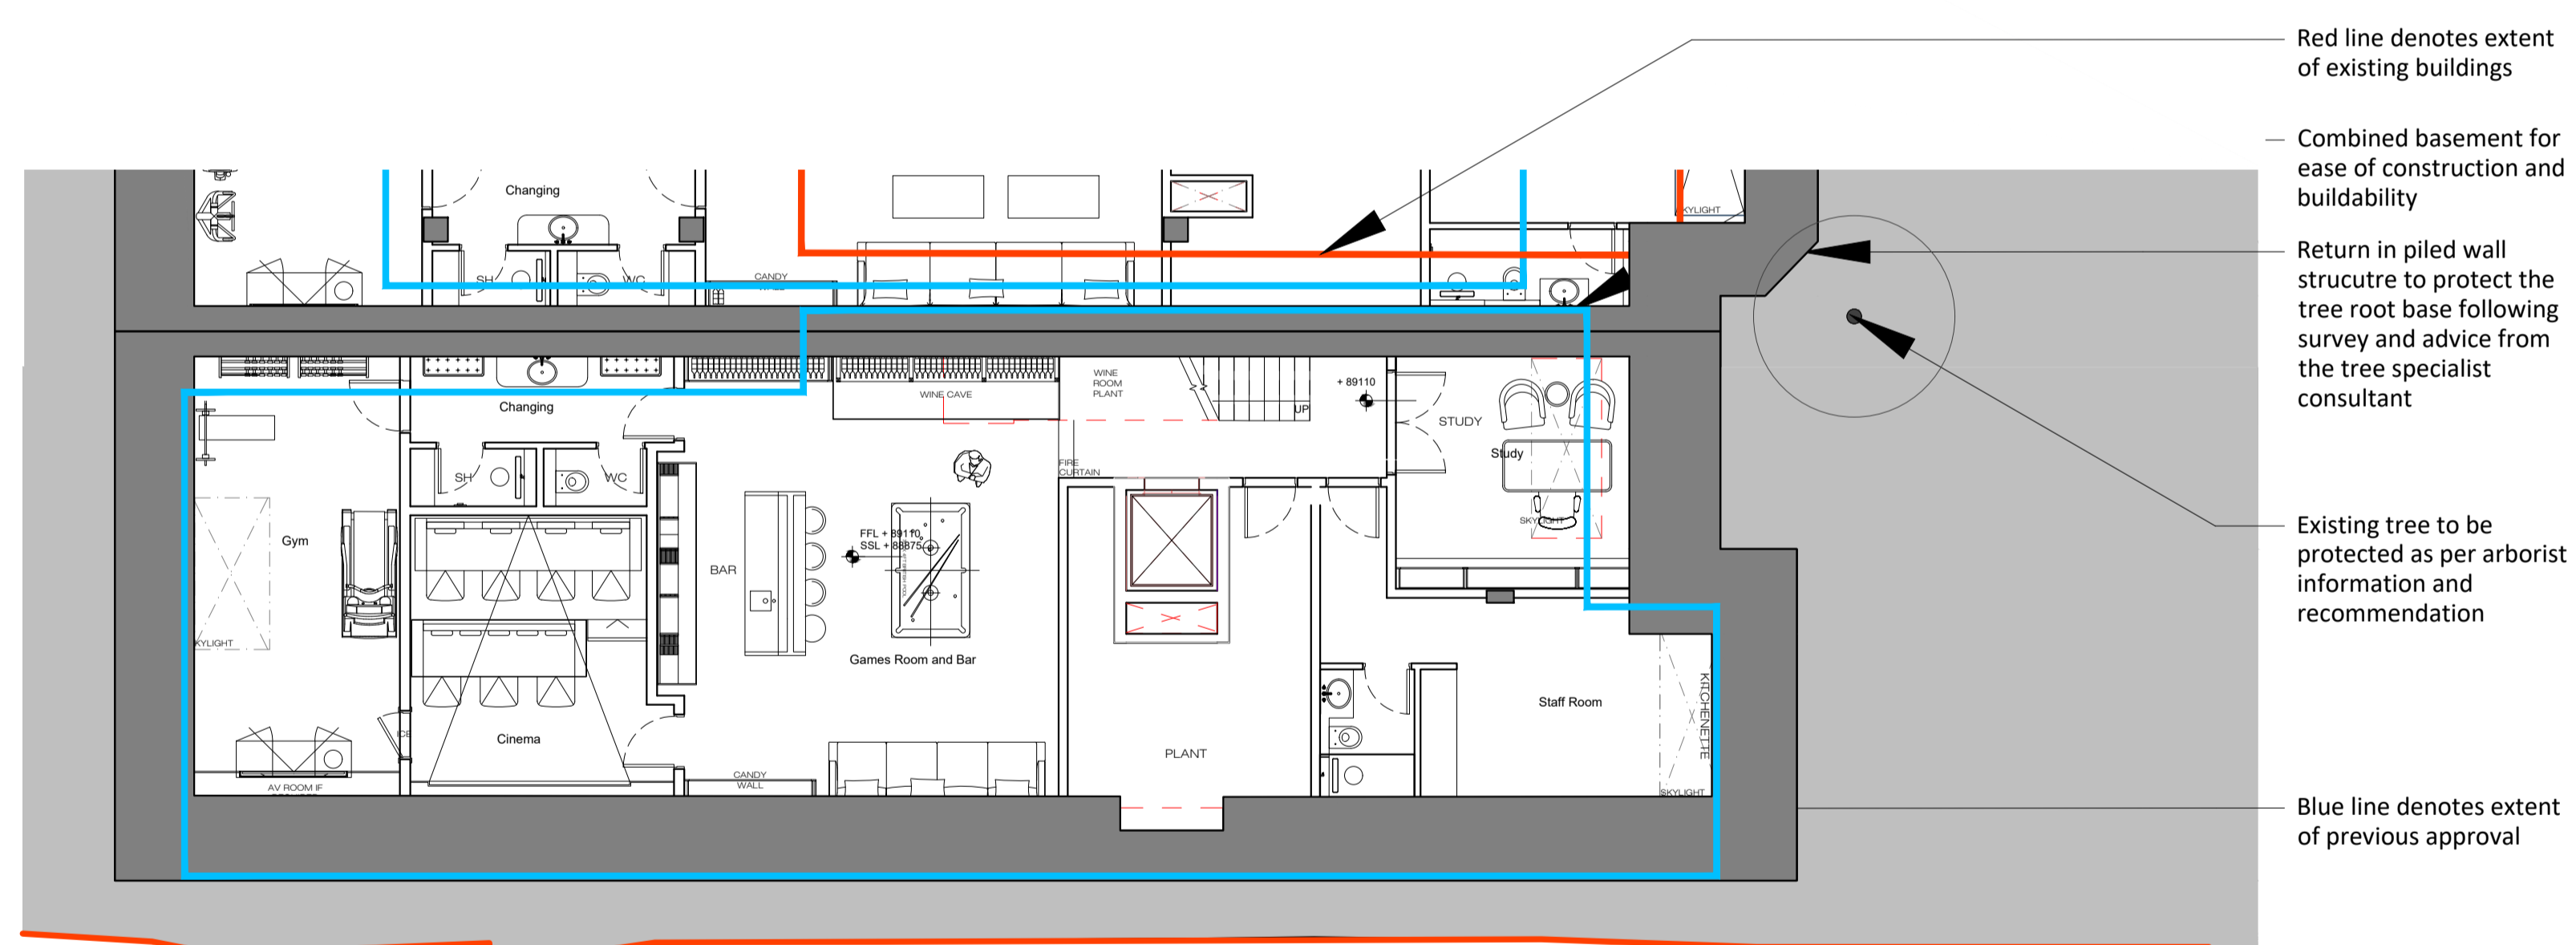


Notes:

- 1. This drawing replaces drawing A101

Example 1: Acoustic enclosure with door

Example 2: Acoustic louvred wall

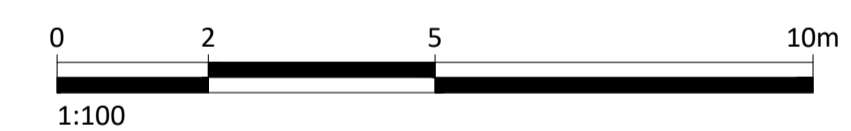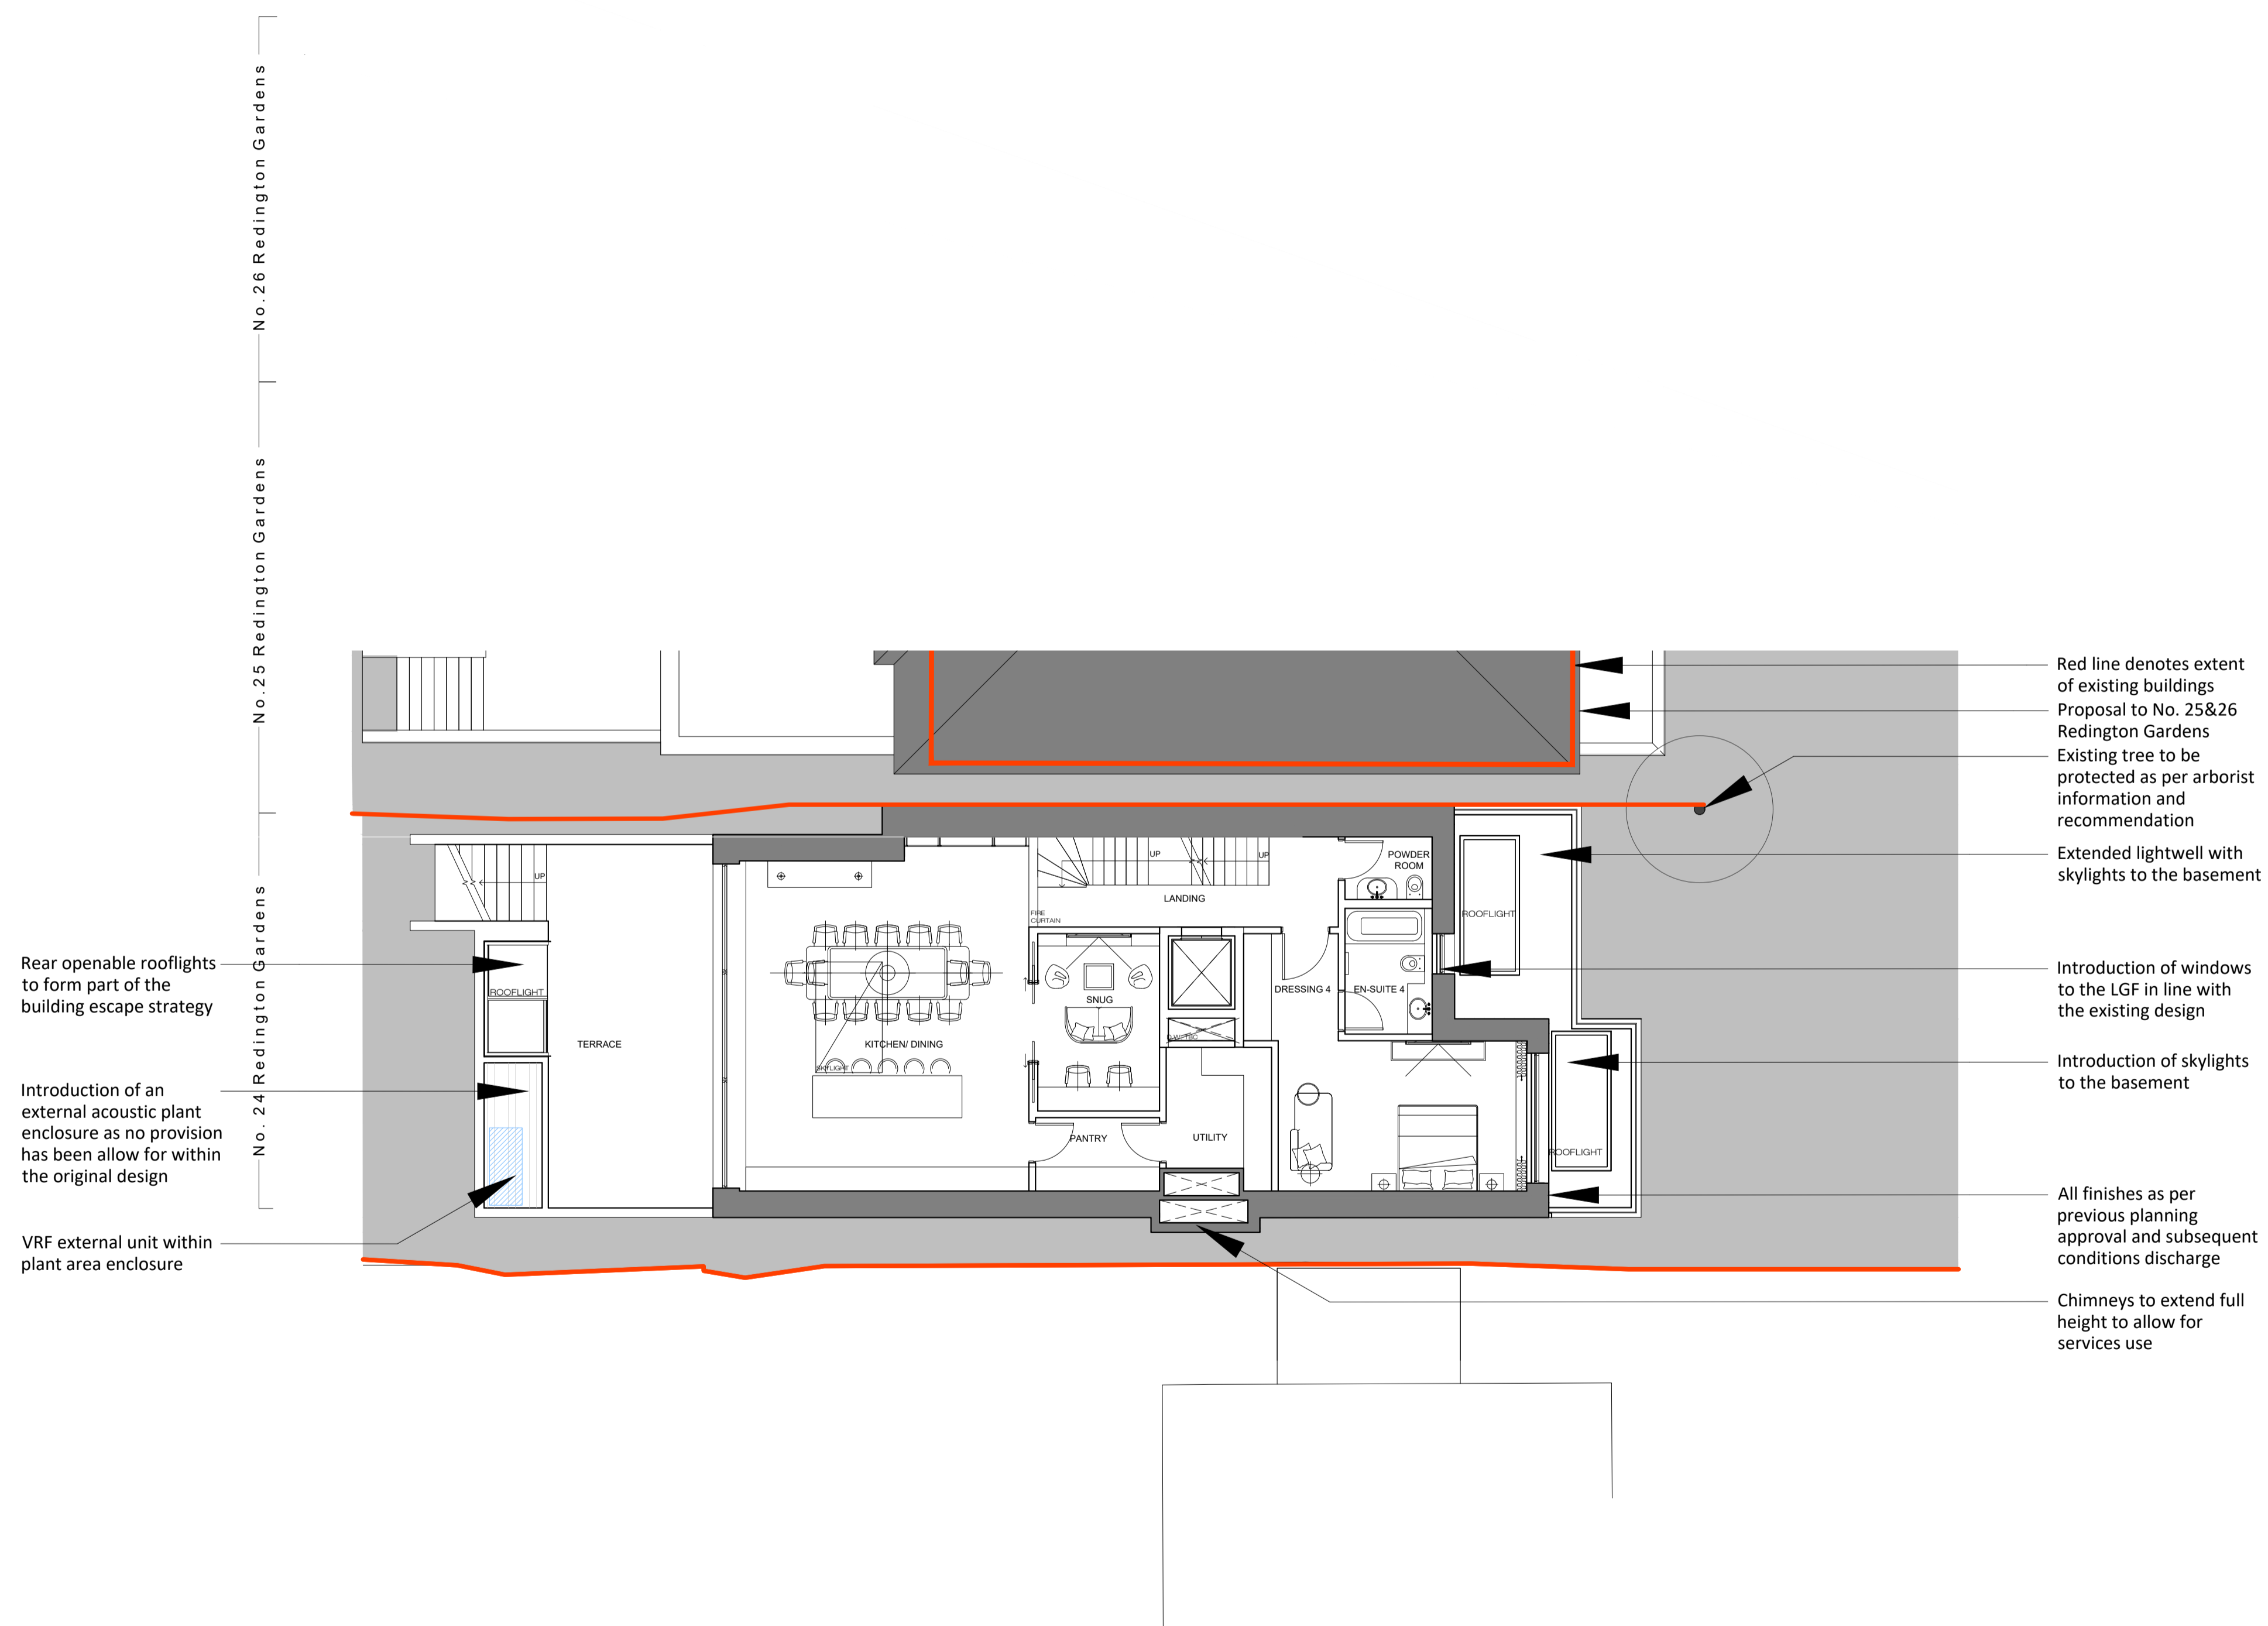

For Planning

Rev.	Description	By	Date
P 1	For Planning ----	CB	04.06.19

Client

Cogress Ltd

Project

24-26 Redington Gardens

Title

No.24 Proposed Lower Ground Floor Plan

Drawing No.	Rev.
A101	P1


Project No.	Scale	1:100 @ A1	1:200 @ A3
Drawn	Checked	Date	
020	CB	CB	10.05.2019

Do not scale from this drawing. All dimensions should be checked and confirmed on site before the commencement of work. All discrepancies must be reported. Subcontractors must verify all dimensions on site before making a shop drawing or commencing manufacturing. This drawing is subject to copyright. ©

MY construction
 Unit 5, Sayer House
 Horseshoe Close, London, NW2 7JN
 T +44 (0)20 8450 5747
 E info@myconstruction.co.uk

Notes:


1. This drawing replaces drawing A102

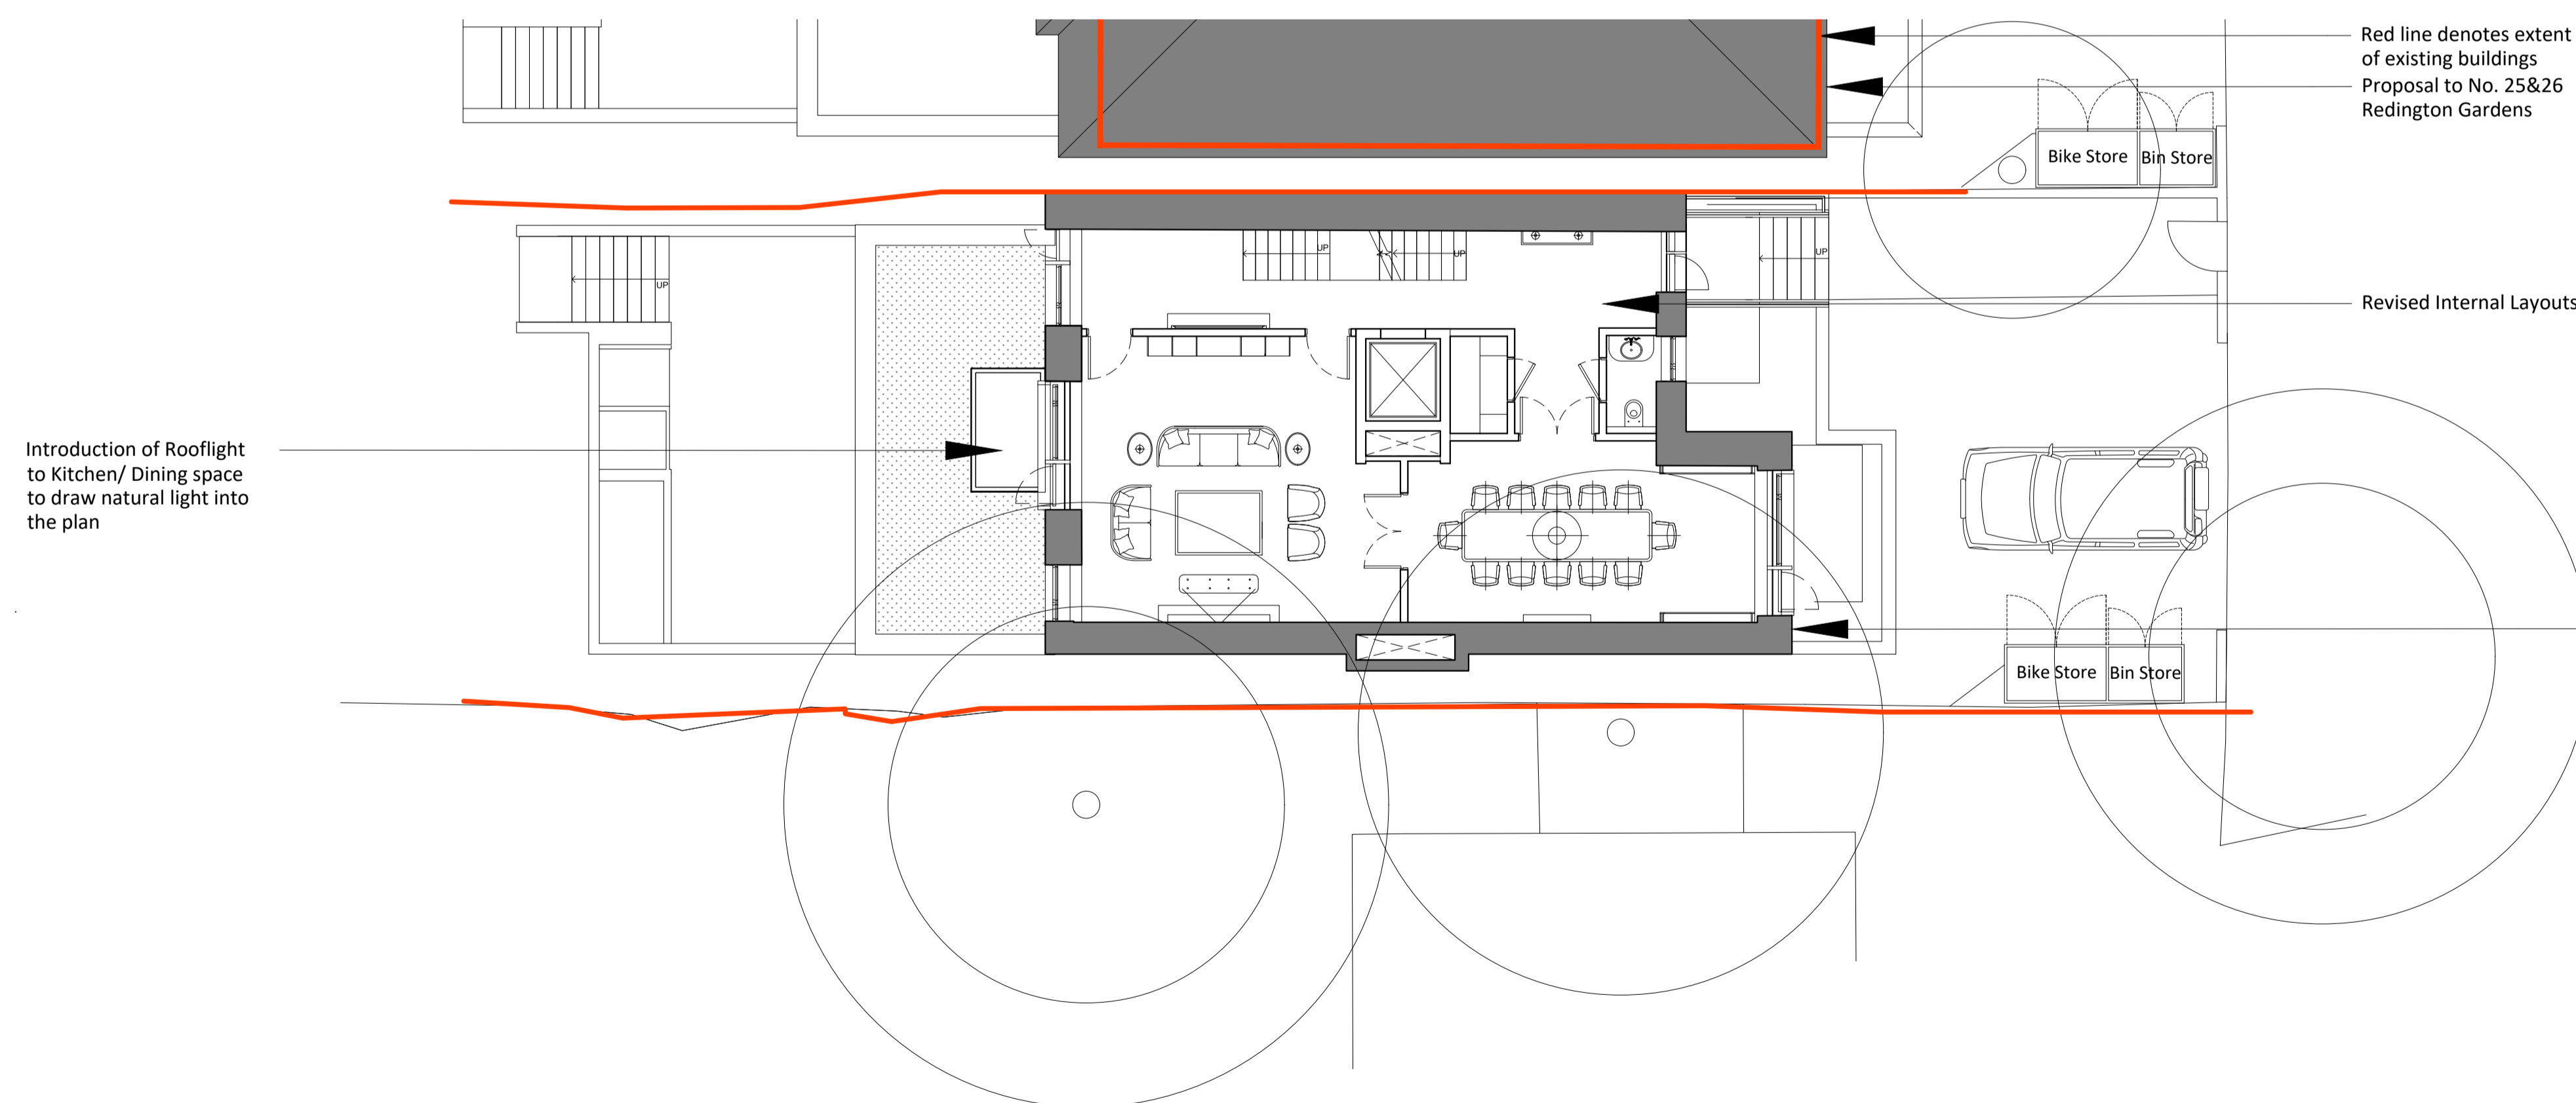

Red line denotes extent of existing buildings
Proposal to No. 25&26 Redington Gardens

Revised Internal Layouts

Introduction of Rooflight to Kitchen/ Dining space to draw natural light into the plan

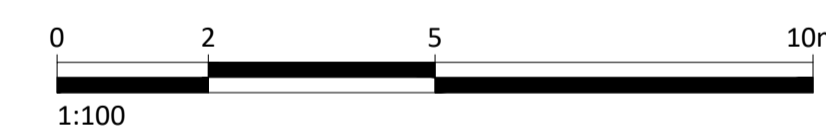

For Planning

Rev.	Description	By	Date
P 1	For Planning ----	CB	04.06.19

Client

Cogress Ltd

Project

24-26 Redington Gardens

Title

No.24 Proposed Upper Ground Floor Plan

Drawing No.	Rev.
A102	P1



Project No.	Scale	1:100 @ A1	1:200 @ A3
020	Drawn	Checked	Date
	CB	CB	10.05.2019

Do not scale from this drawing. All dimensions should be checked and confirmed on site before the commencement of work. All discrepancies must be reported. Subcontractors must verify all dimensions on site before making a shop drawing or commencing manufacturing. This drawing is subject to copyright. ©

MY
construction
Unit 5, Sayer House
Horseshoe Close, London, NW2 7JN
T +44 (0)20 8450 5747
E info@myconstruction.co.uk

Notes:

- 1. This drawing replaces drawing A103

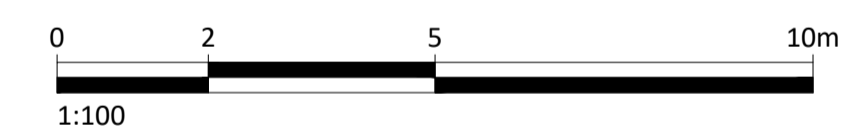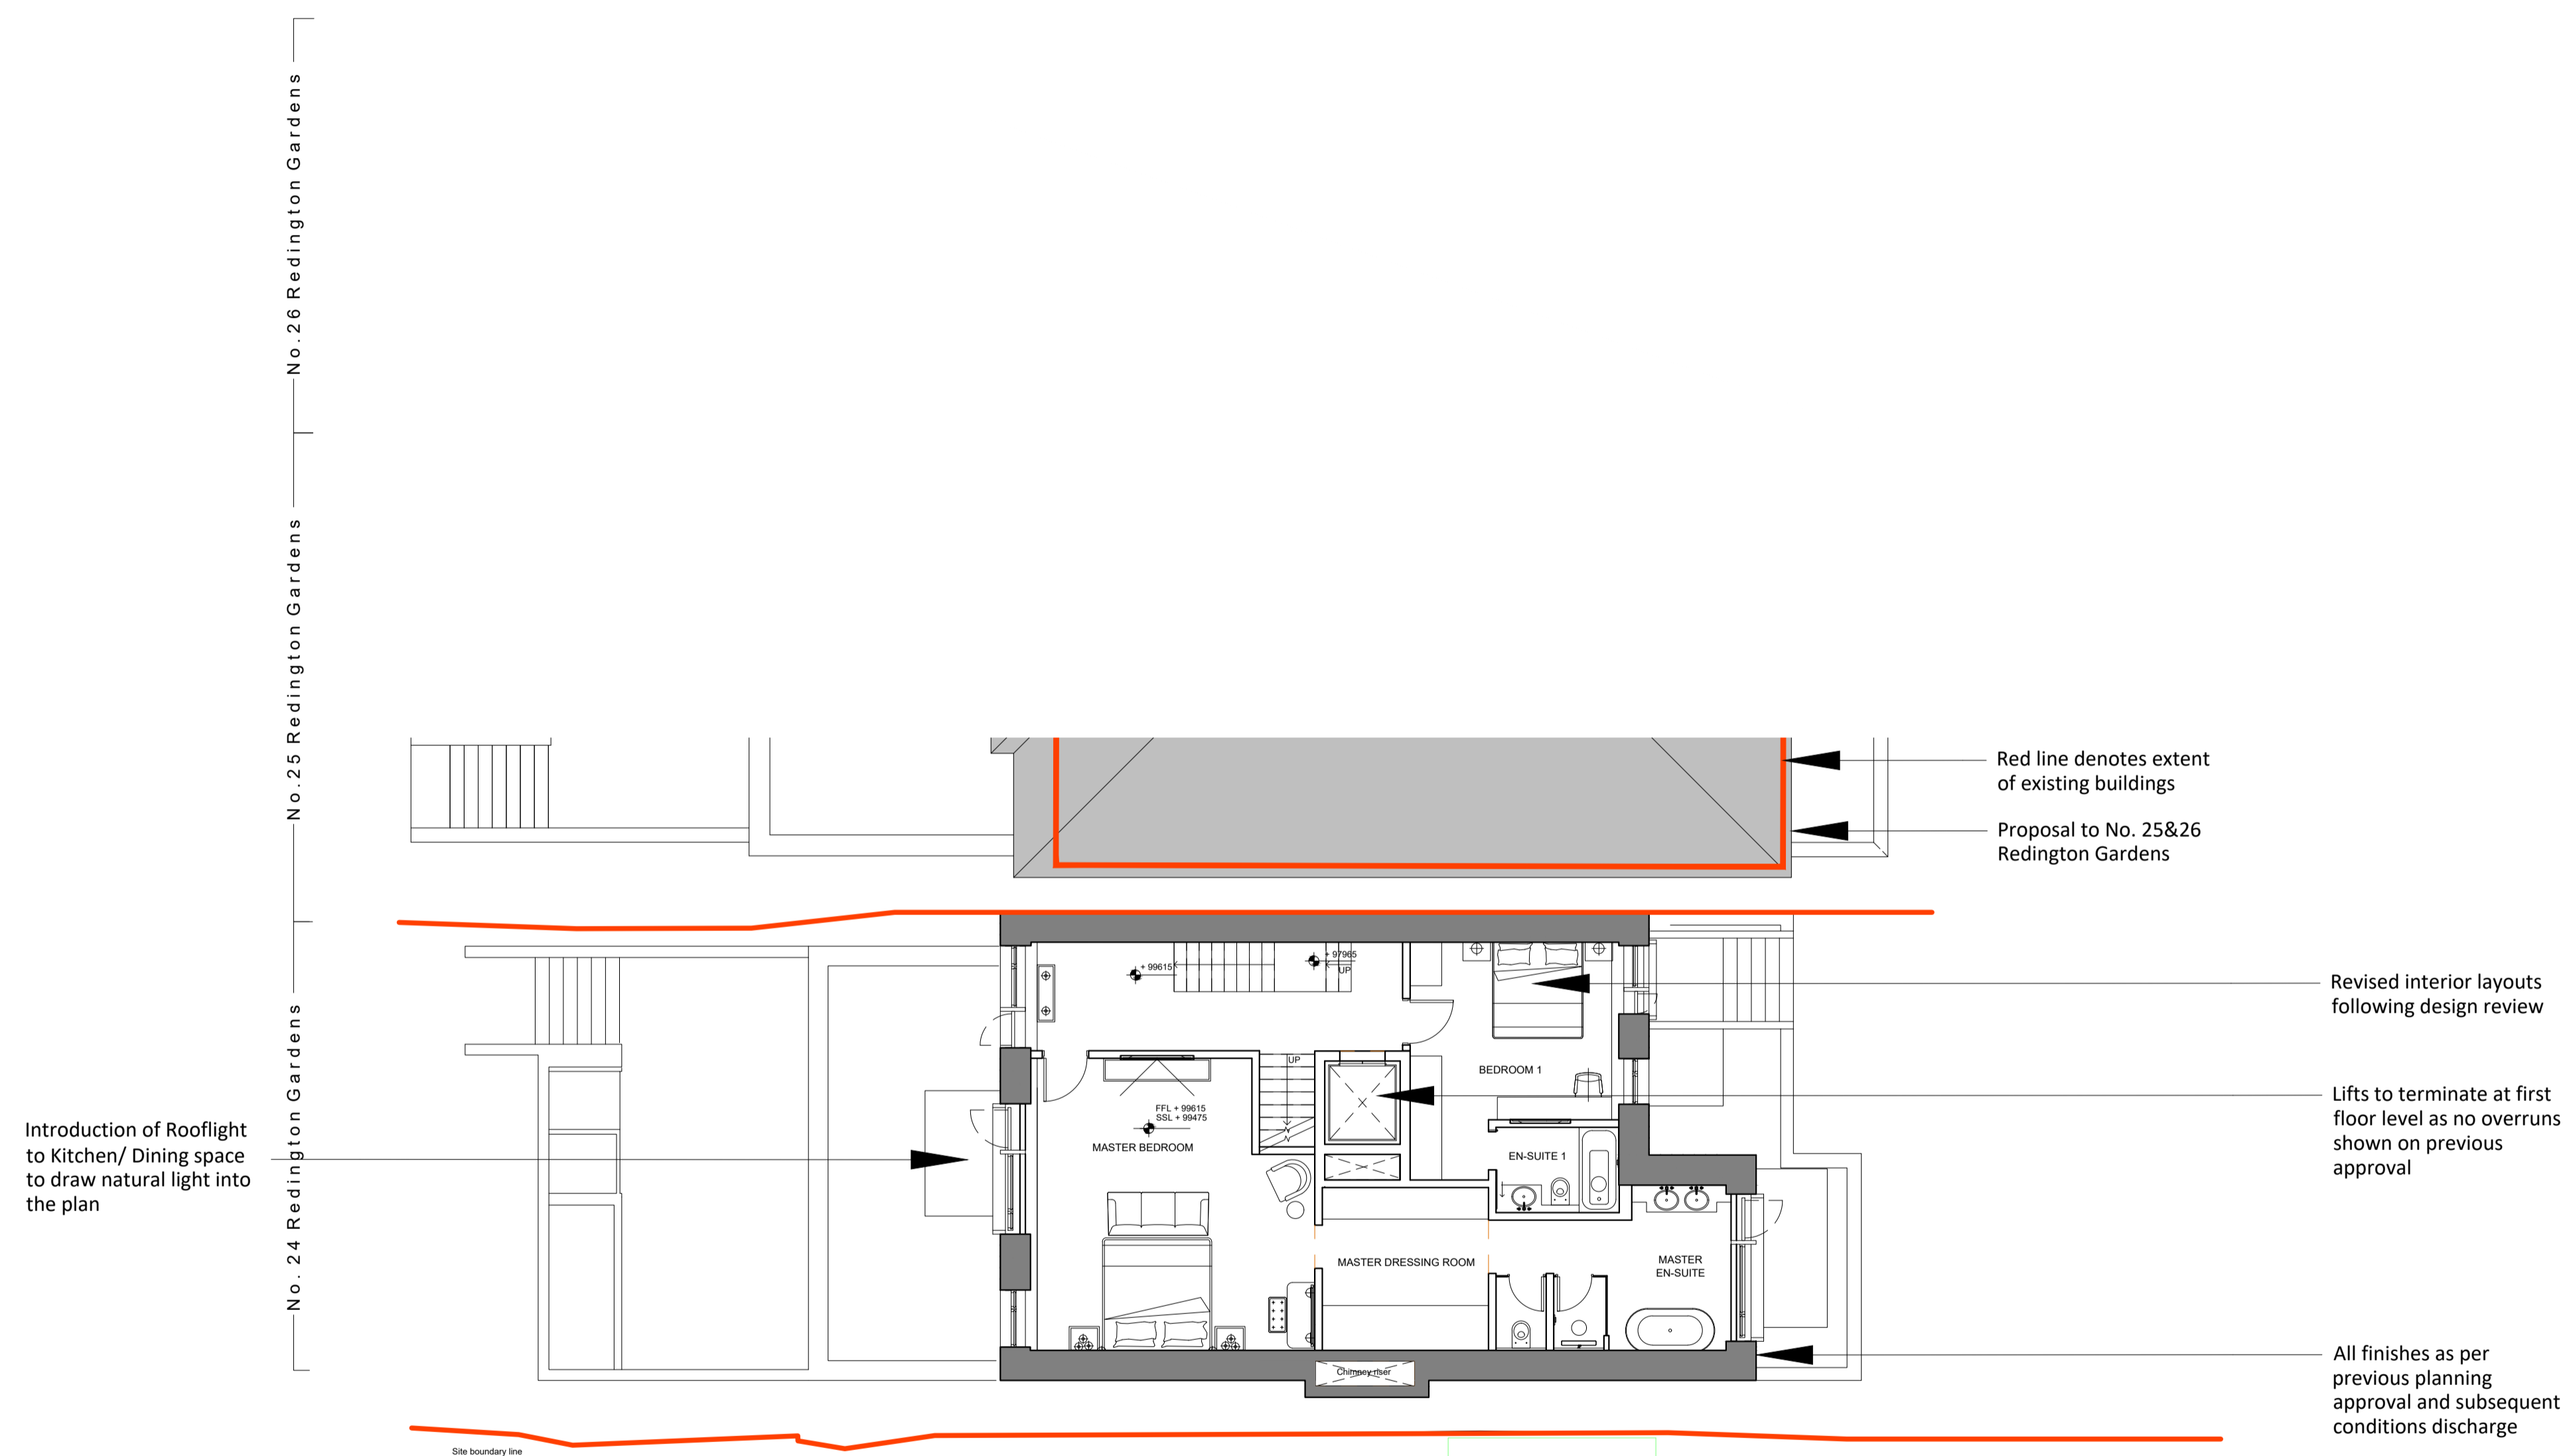

For Planning

Rev.	Description	By	Date
P 1	For Planning ----	CB	04.06.19

Client

Cogress Ltd

Project

24-26 Redington Gardens

Title

No.24 Proposed First Floor Plan

Drawing No.	Rev.
A103	P1

Project No.	Scale	1:100 @ A1	1:200 @ A3
020	Drawn	Checked	Date
	CB	CB	10.05.2019



Do not scale from this drawing. All dimensions should be checked and confirmed on site before the commencement of work. All discrepancies must be reported. Subcontractors must verify all dimensions on site before making a shop drawing or commencing manufacturing. This drawing is subject to copyright. ©

MY
construction

Unit 5, Sayer House
Horseshoe Close, London, NW2 7JN
T +44 (0)20 8450 5747
E info@myconstruction.co.uk

Notes:

- 1. This drawing replaces drawing A104

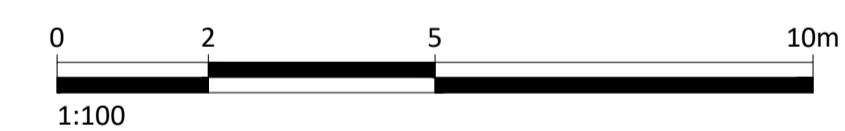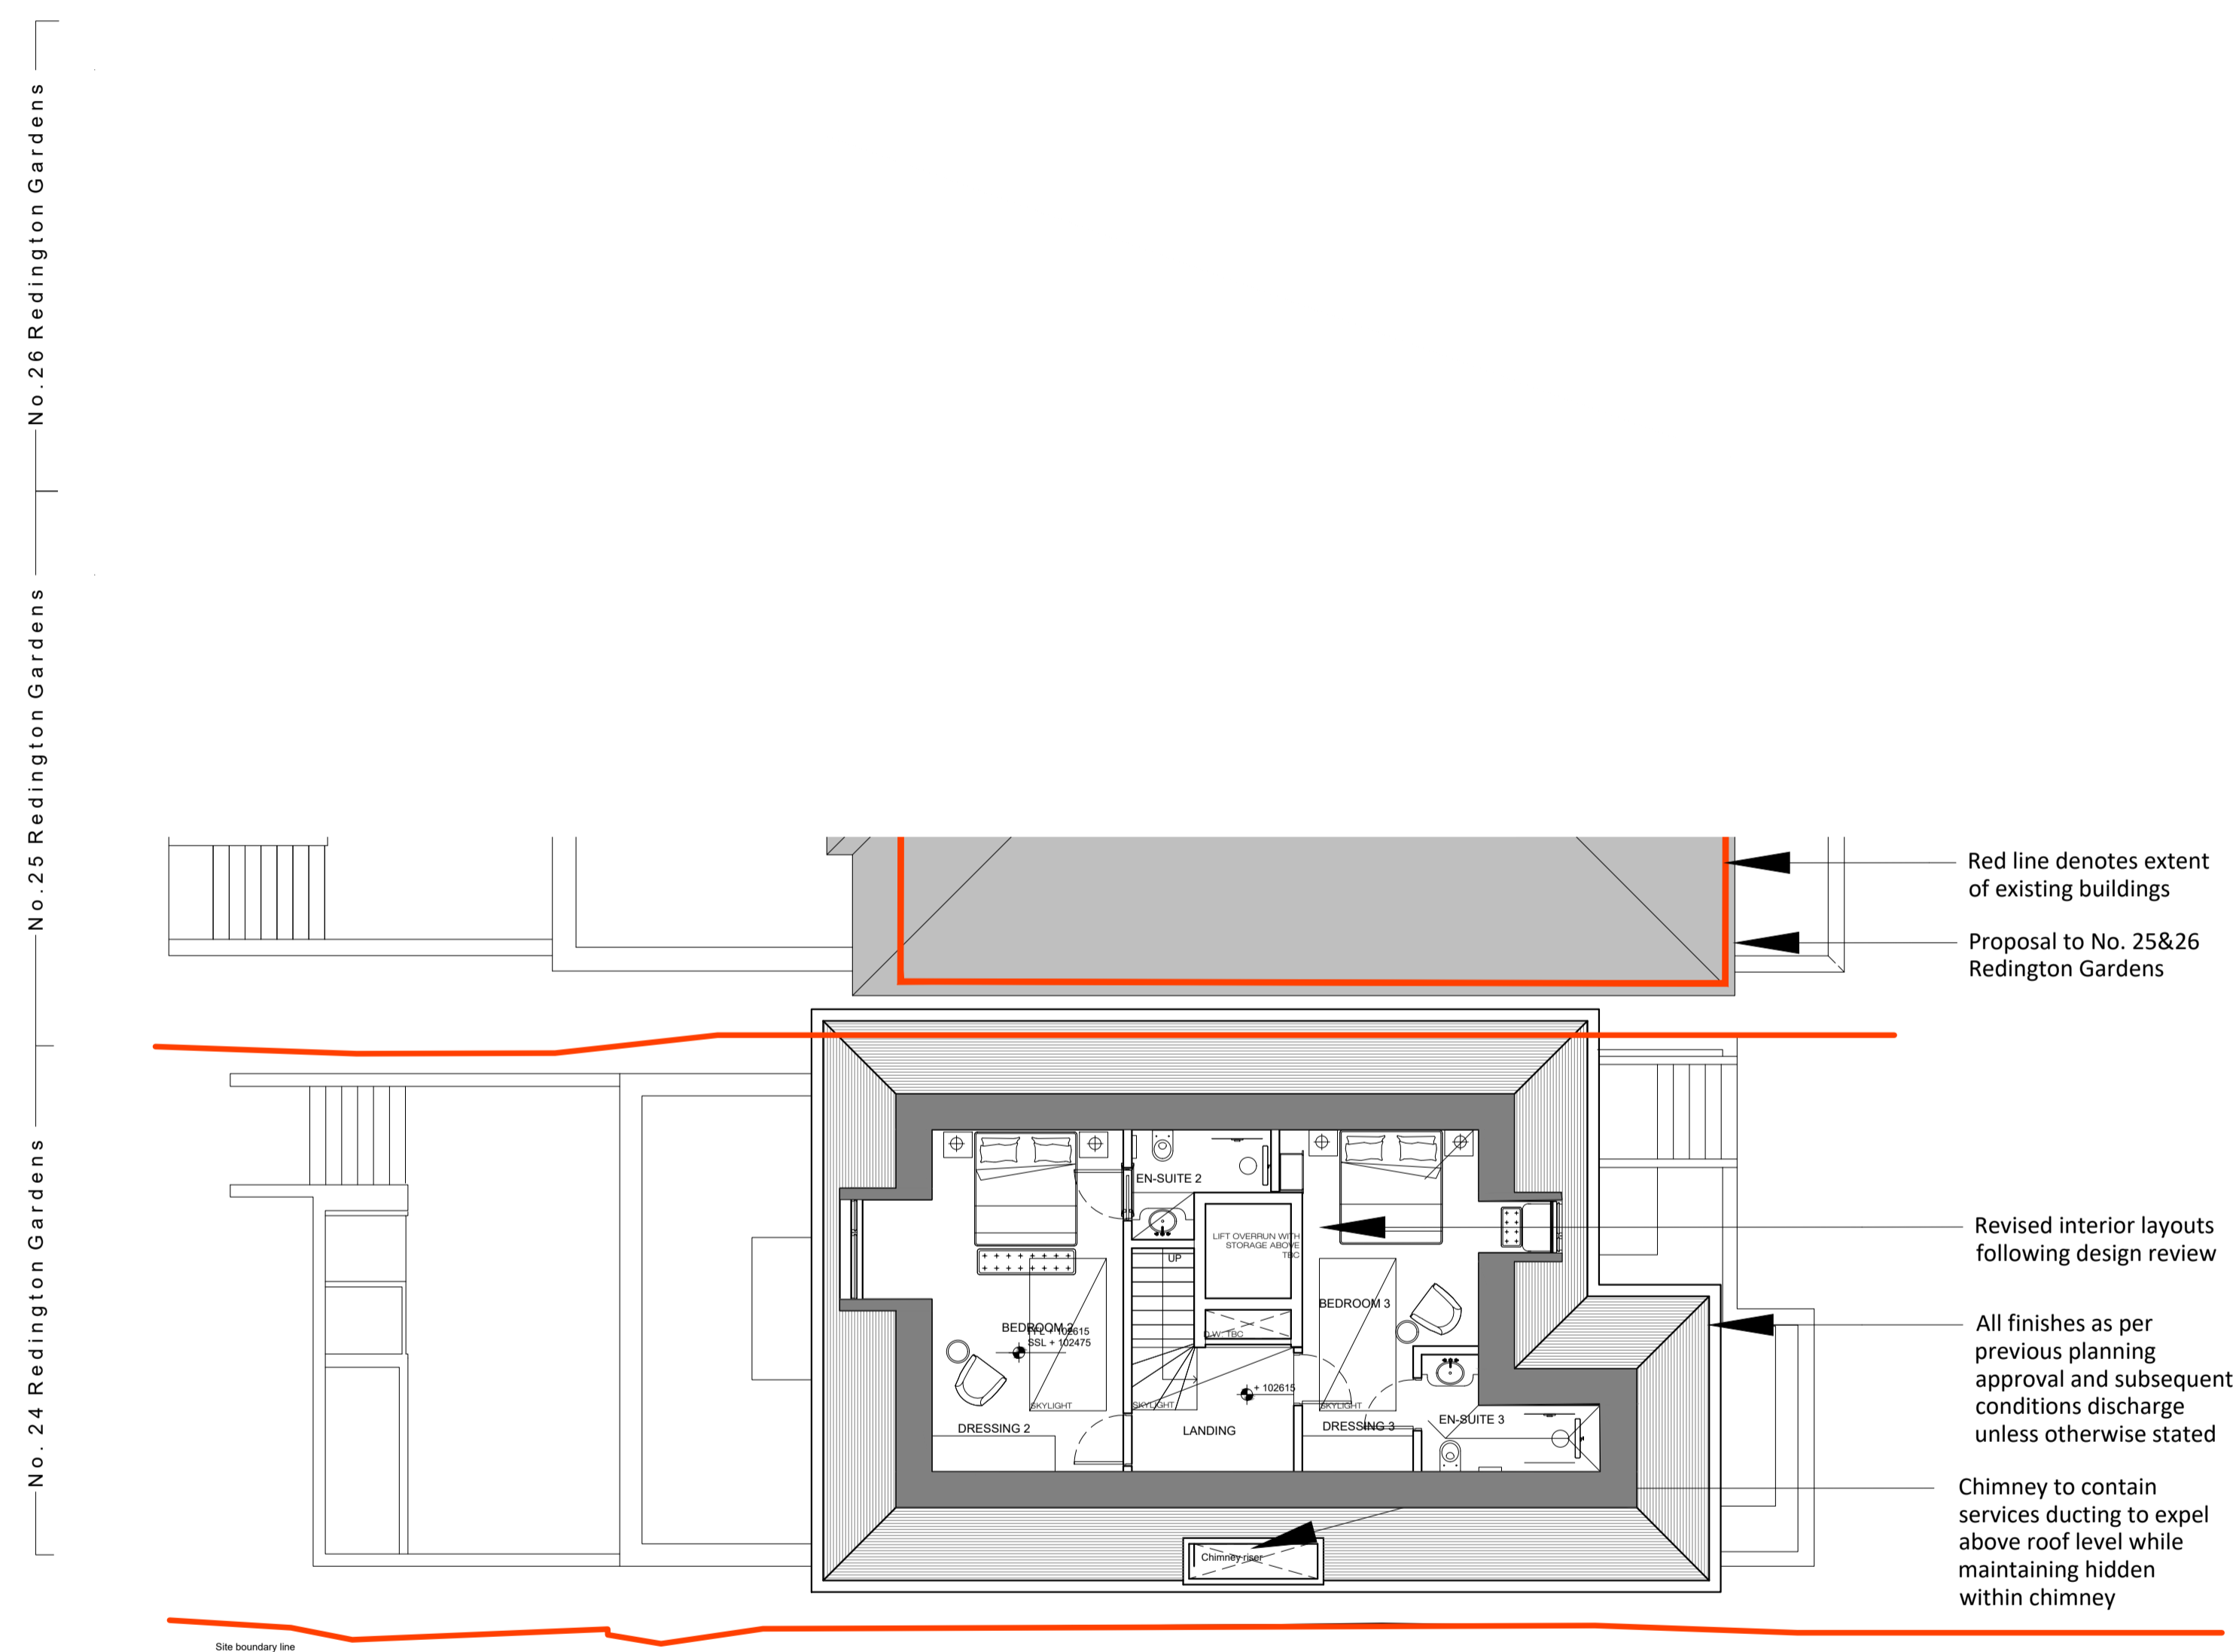

For Planning

Rev.	Description	By	Date
P 1	For Planning ----	CB	04.06.19

Client

Cogress Ltd

Project

24-26 Redington Gardens

Title

No.24 Proposed Second Floor Plan

Drawing No.	Rev.
A104	P1



Project No.	Scale	1:100 @ A1	1:200 @ A3
020	Drawn	Checked	Date
	CB	CB	10.05.2019

Do not scale from this drawing. All dimensions should be checked and confirmed on site before the commencement of work. All discrepancies must be reported. Subcontractors must verify all dimensions on site before making a shop drawing or commencing manufacturing. This drawing is subject to copyright. ©

MY
construction
Unit 5, Sayer House
Horseshoe Close, London, NW2 7JN
T +44 (0)20 8450 5747
E info@myconstruction.co.uk

Notes:

1. This drawing replaces drawing A105

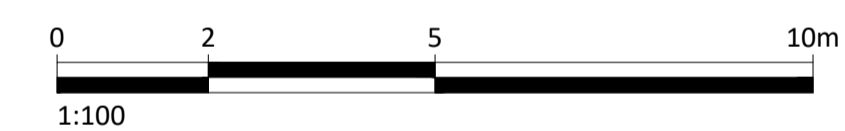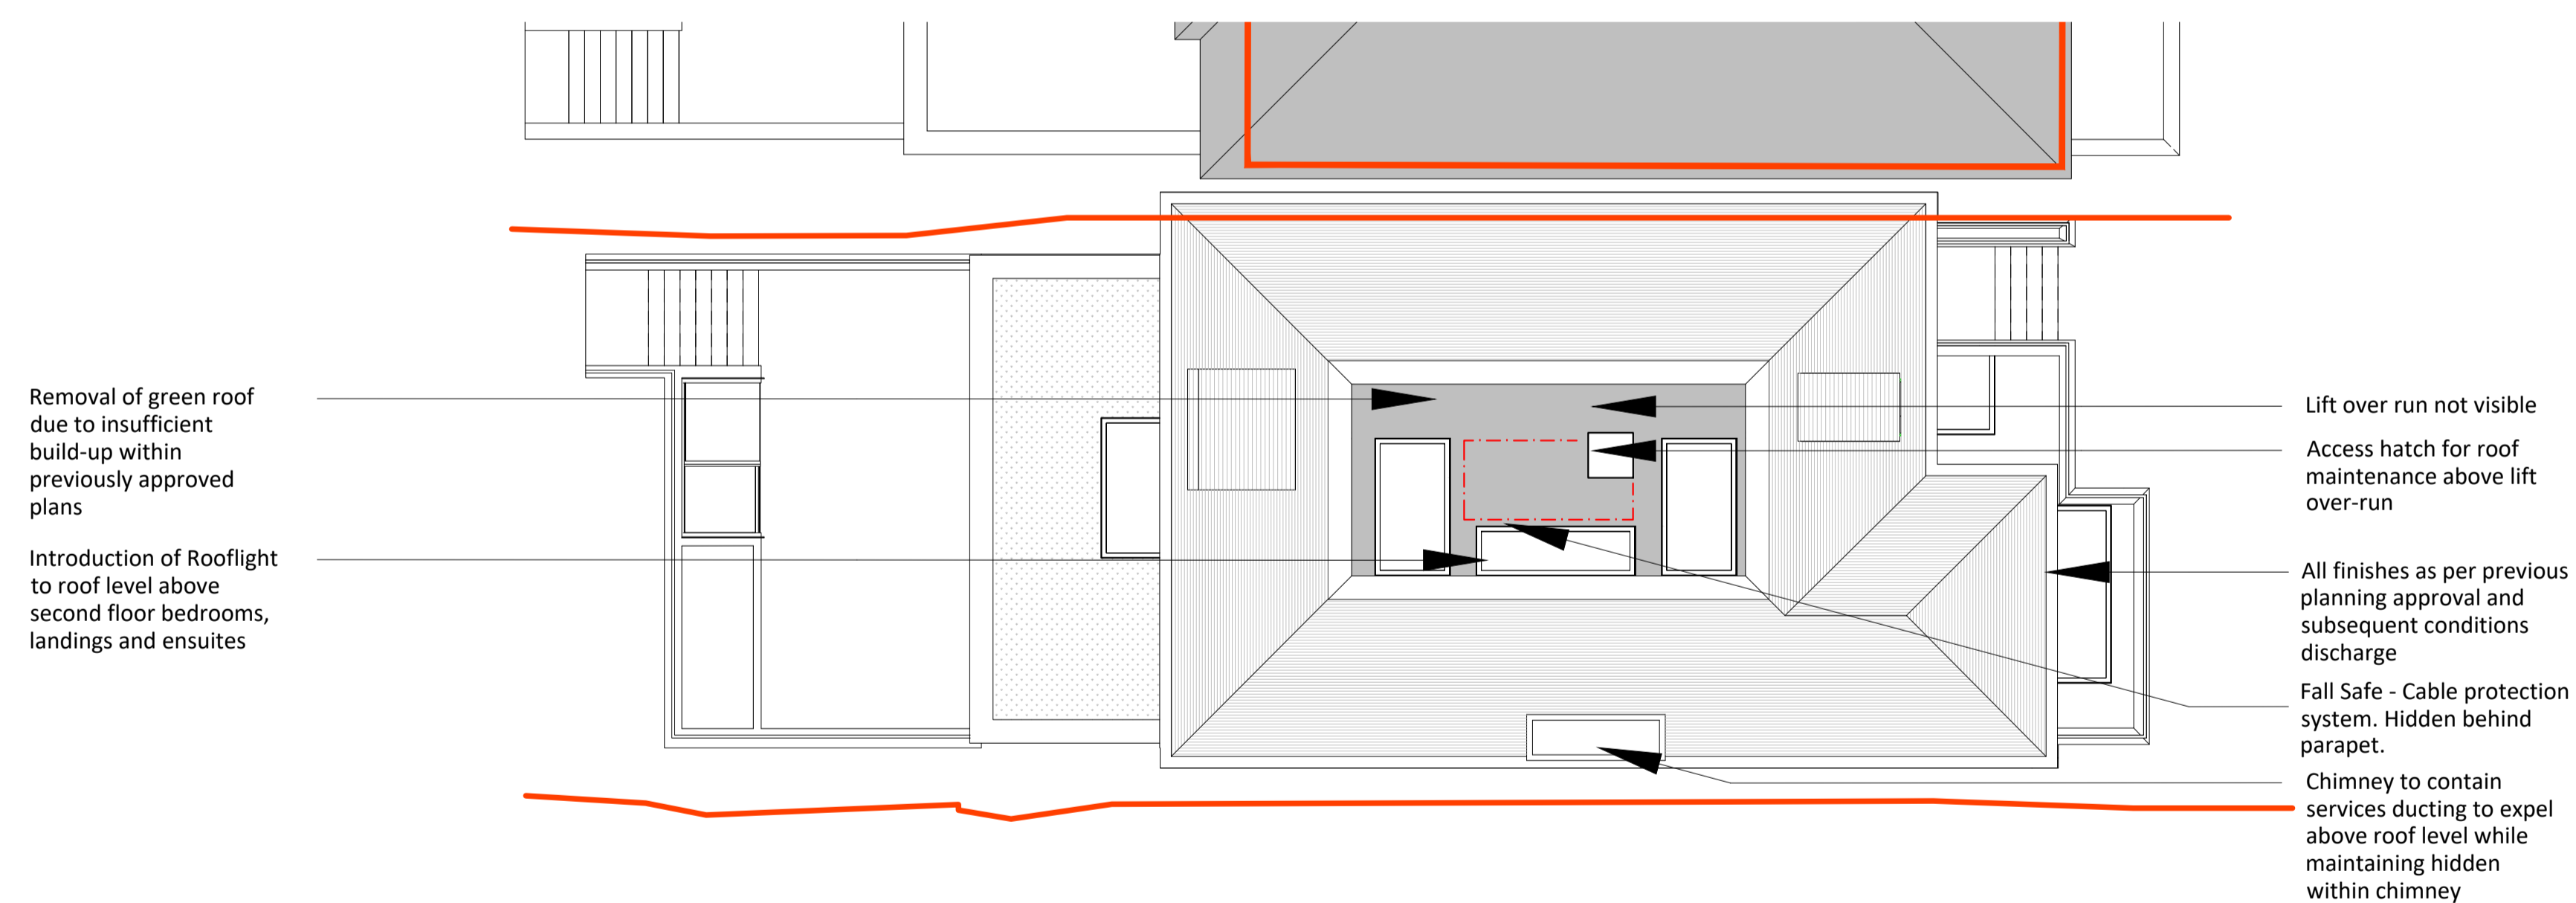

For Planning

Rev.	Description.	By	Date
P 1	For Planning ----	CB	04.06.19

Client

Cogress Ltd

Project

24-26 Redington Gardens

Title

No.24 Proposed Roof Plan

Drawing No.	Rev.
A105	P1

Project No.	Scale	1:100 @ A1	1:200 @ A3
020	Drawn	Checked	Date
	CB	CB	10.05.2019

Do not scale from this drawing. All dimensions should be checked and confirmed on site before the commencement of work. All discrepancies must be reported. Subcontractors must verify all dimensions on site before making a shop drawing or commencing manufacturing. This drawing is subject to copyright. ©

MY
construction

Unit 5, Sayer House
Horseshoe Close, London, NW2 7JN
T +44 (0)20 8450 5747
E info@myconstruction.co.uk