




EXISTING SITE PLAN 1:200 @ A1

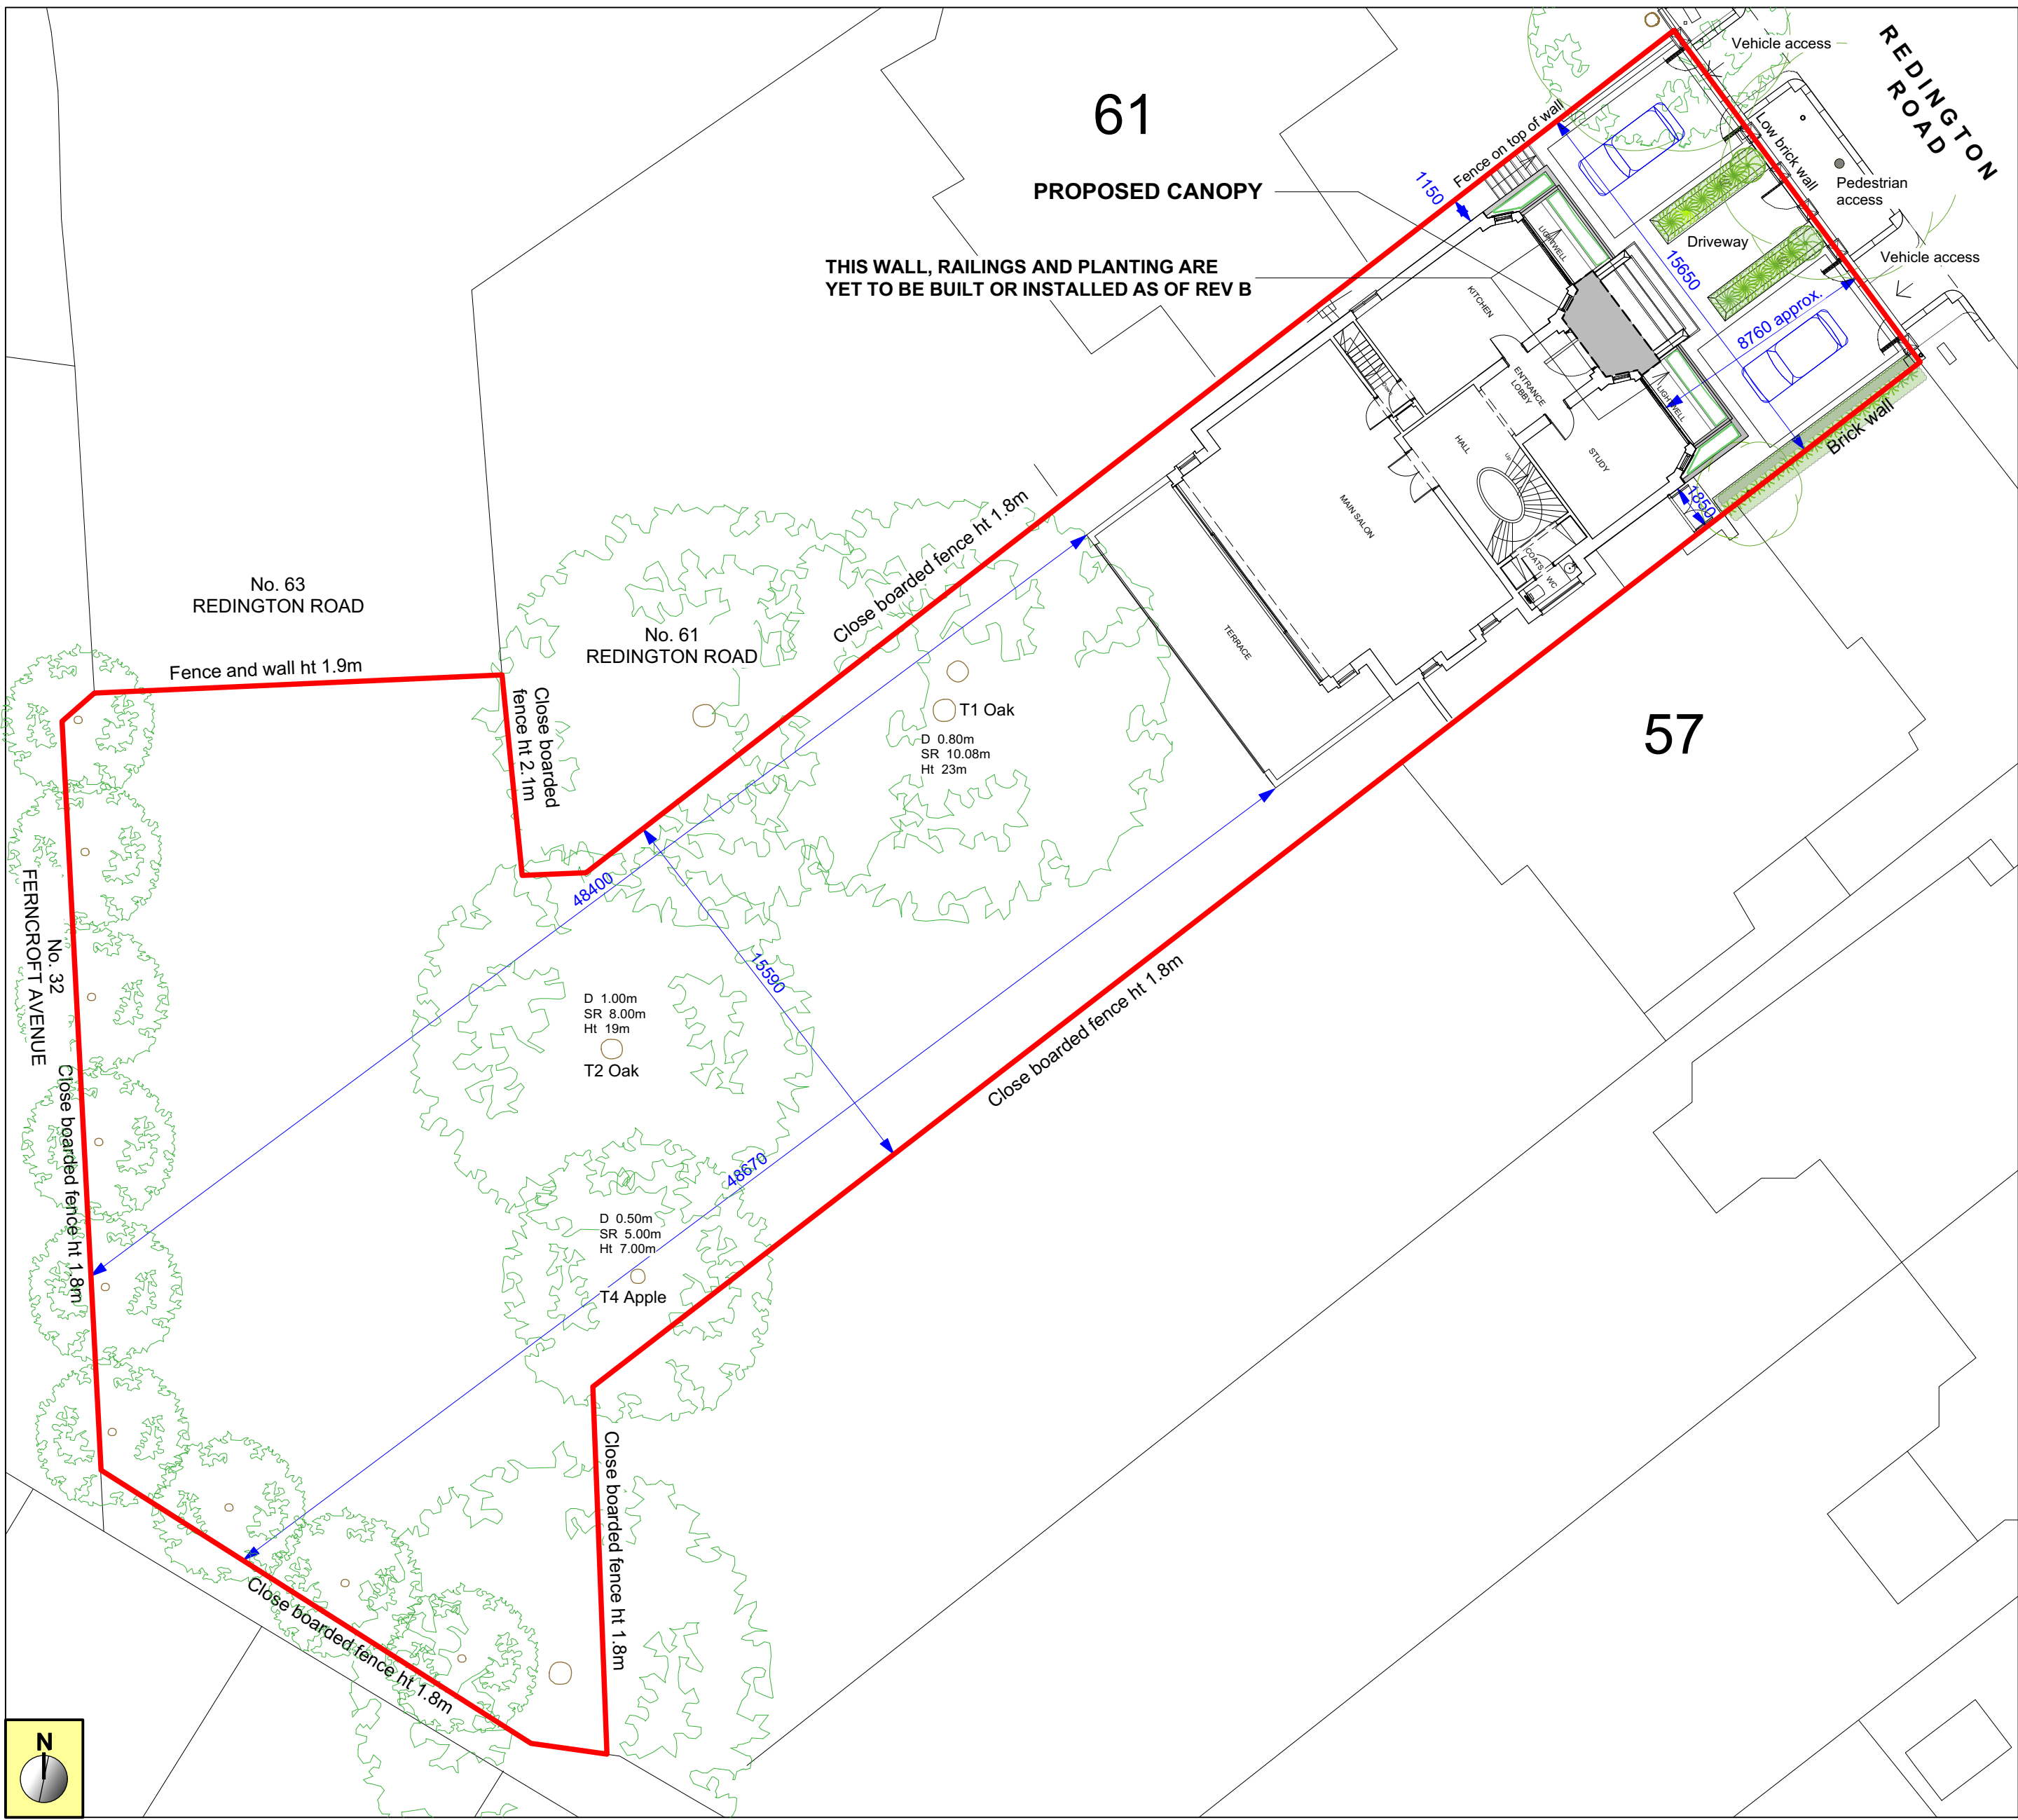


PROPOSED SITE PLAN 1:200 @ A1

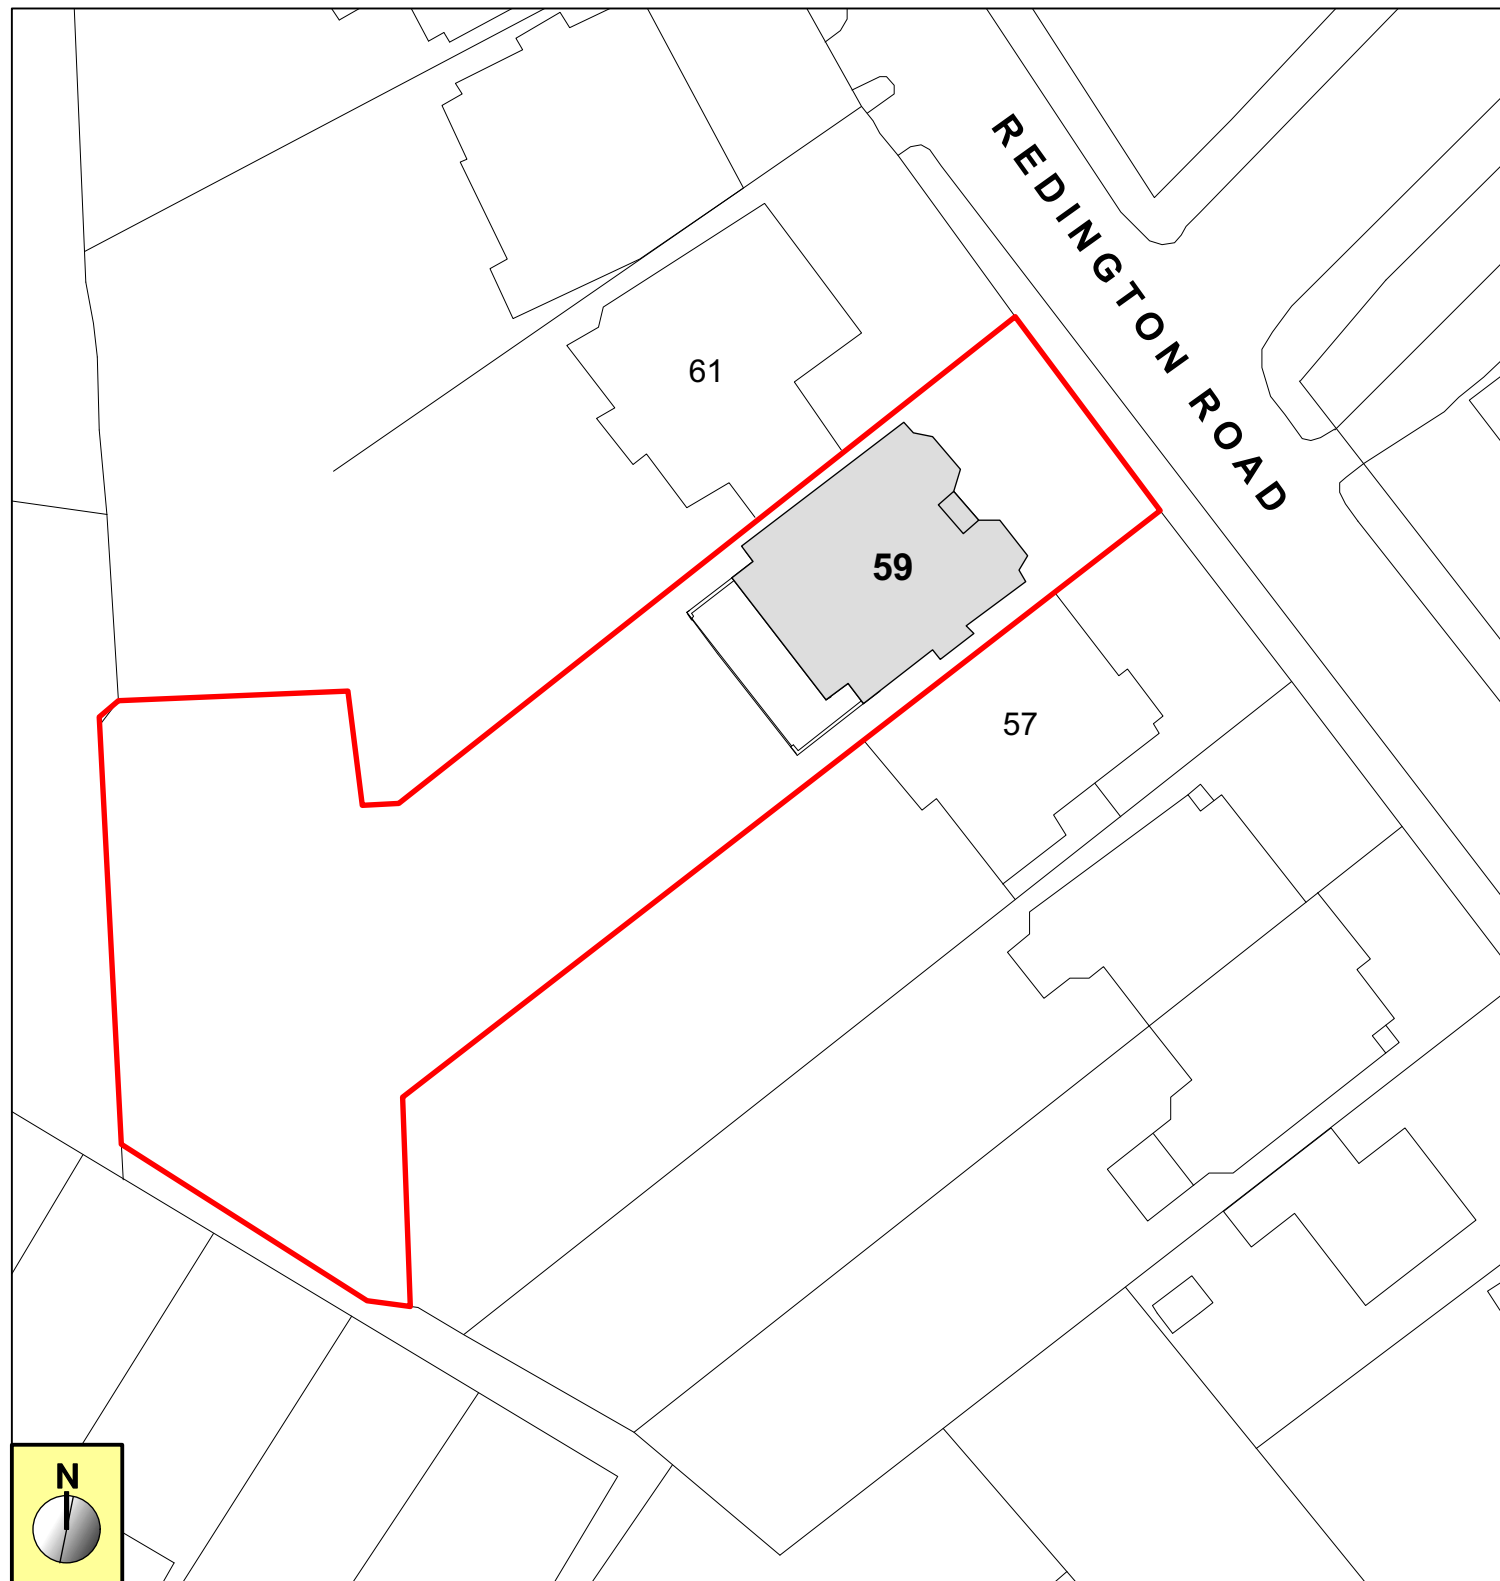

EXISTING BLOCK PLAN 1:500 @ A1

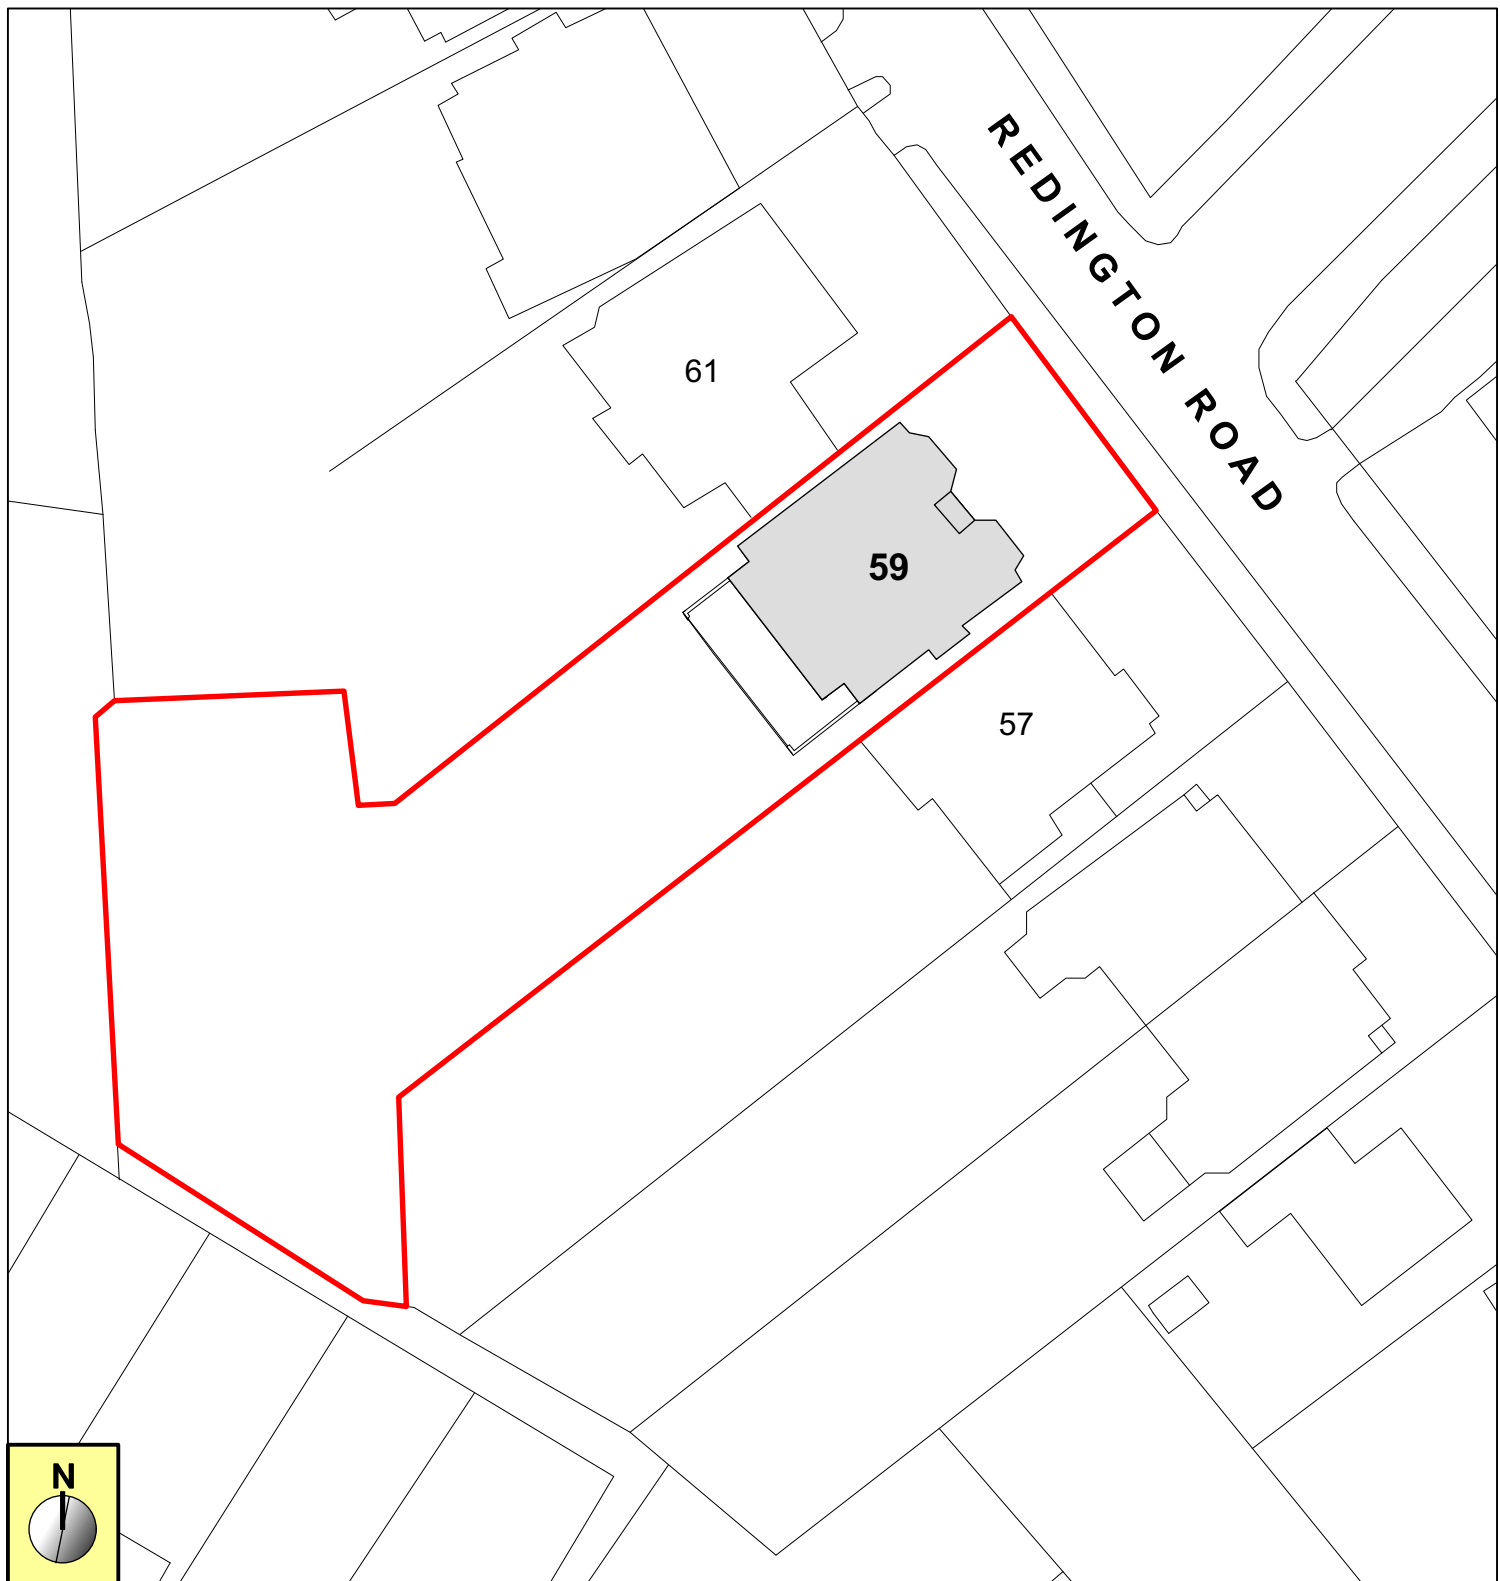

PROPOSED BLOCK PLAN 1:500 @ A1

B	19/06/2019	Front lightwells shown as built.
A	10/06/2019	Front lightwells + railings shown as previously approved - 120164230P.
No.	Date	Issue Notes
This Drawing Is For Design Analysis Only And Must Not Be Scaled For Setting Out Or Any Other Construction Purposes.		
All Dimensions Are To Be Checked On Site By Builder Before Work Commences. Any Discrepancies Between The Drawings And Site Conditions Must Be Reported To The Designer Before Work Commences.		
Any Work Commencing Before Approvals Have Been Granted Is At The Risk Of The Client And The Builder.		
<div><p>Unit 5, Sayer House Oxgate Lane London NW2 7JN</p></div>		
Job	REPLACEMENT CANOPY TO FRONT ENTRANCE: 59 REDINGTON ROAD, HAMPSTEAD, LONDON, NW3 7RP	
Drawing Title		
EXISTING AND PROPOSED SITE AND BLOCK PLANS		
Telephone	0208 450 5747	Project ID MR UDI SHELEG
Drawn By	JS	Scale 1:200, 1:500 @ A1
Date	APRIL 2019	Drawing No.
CAD File Name	59 REDINGTON ROAD	ECPL05B-226-2015