




Internal Room Elevation
Scale: 1:10

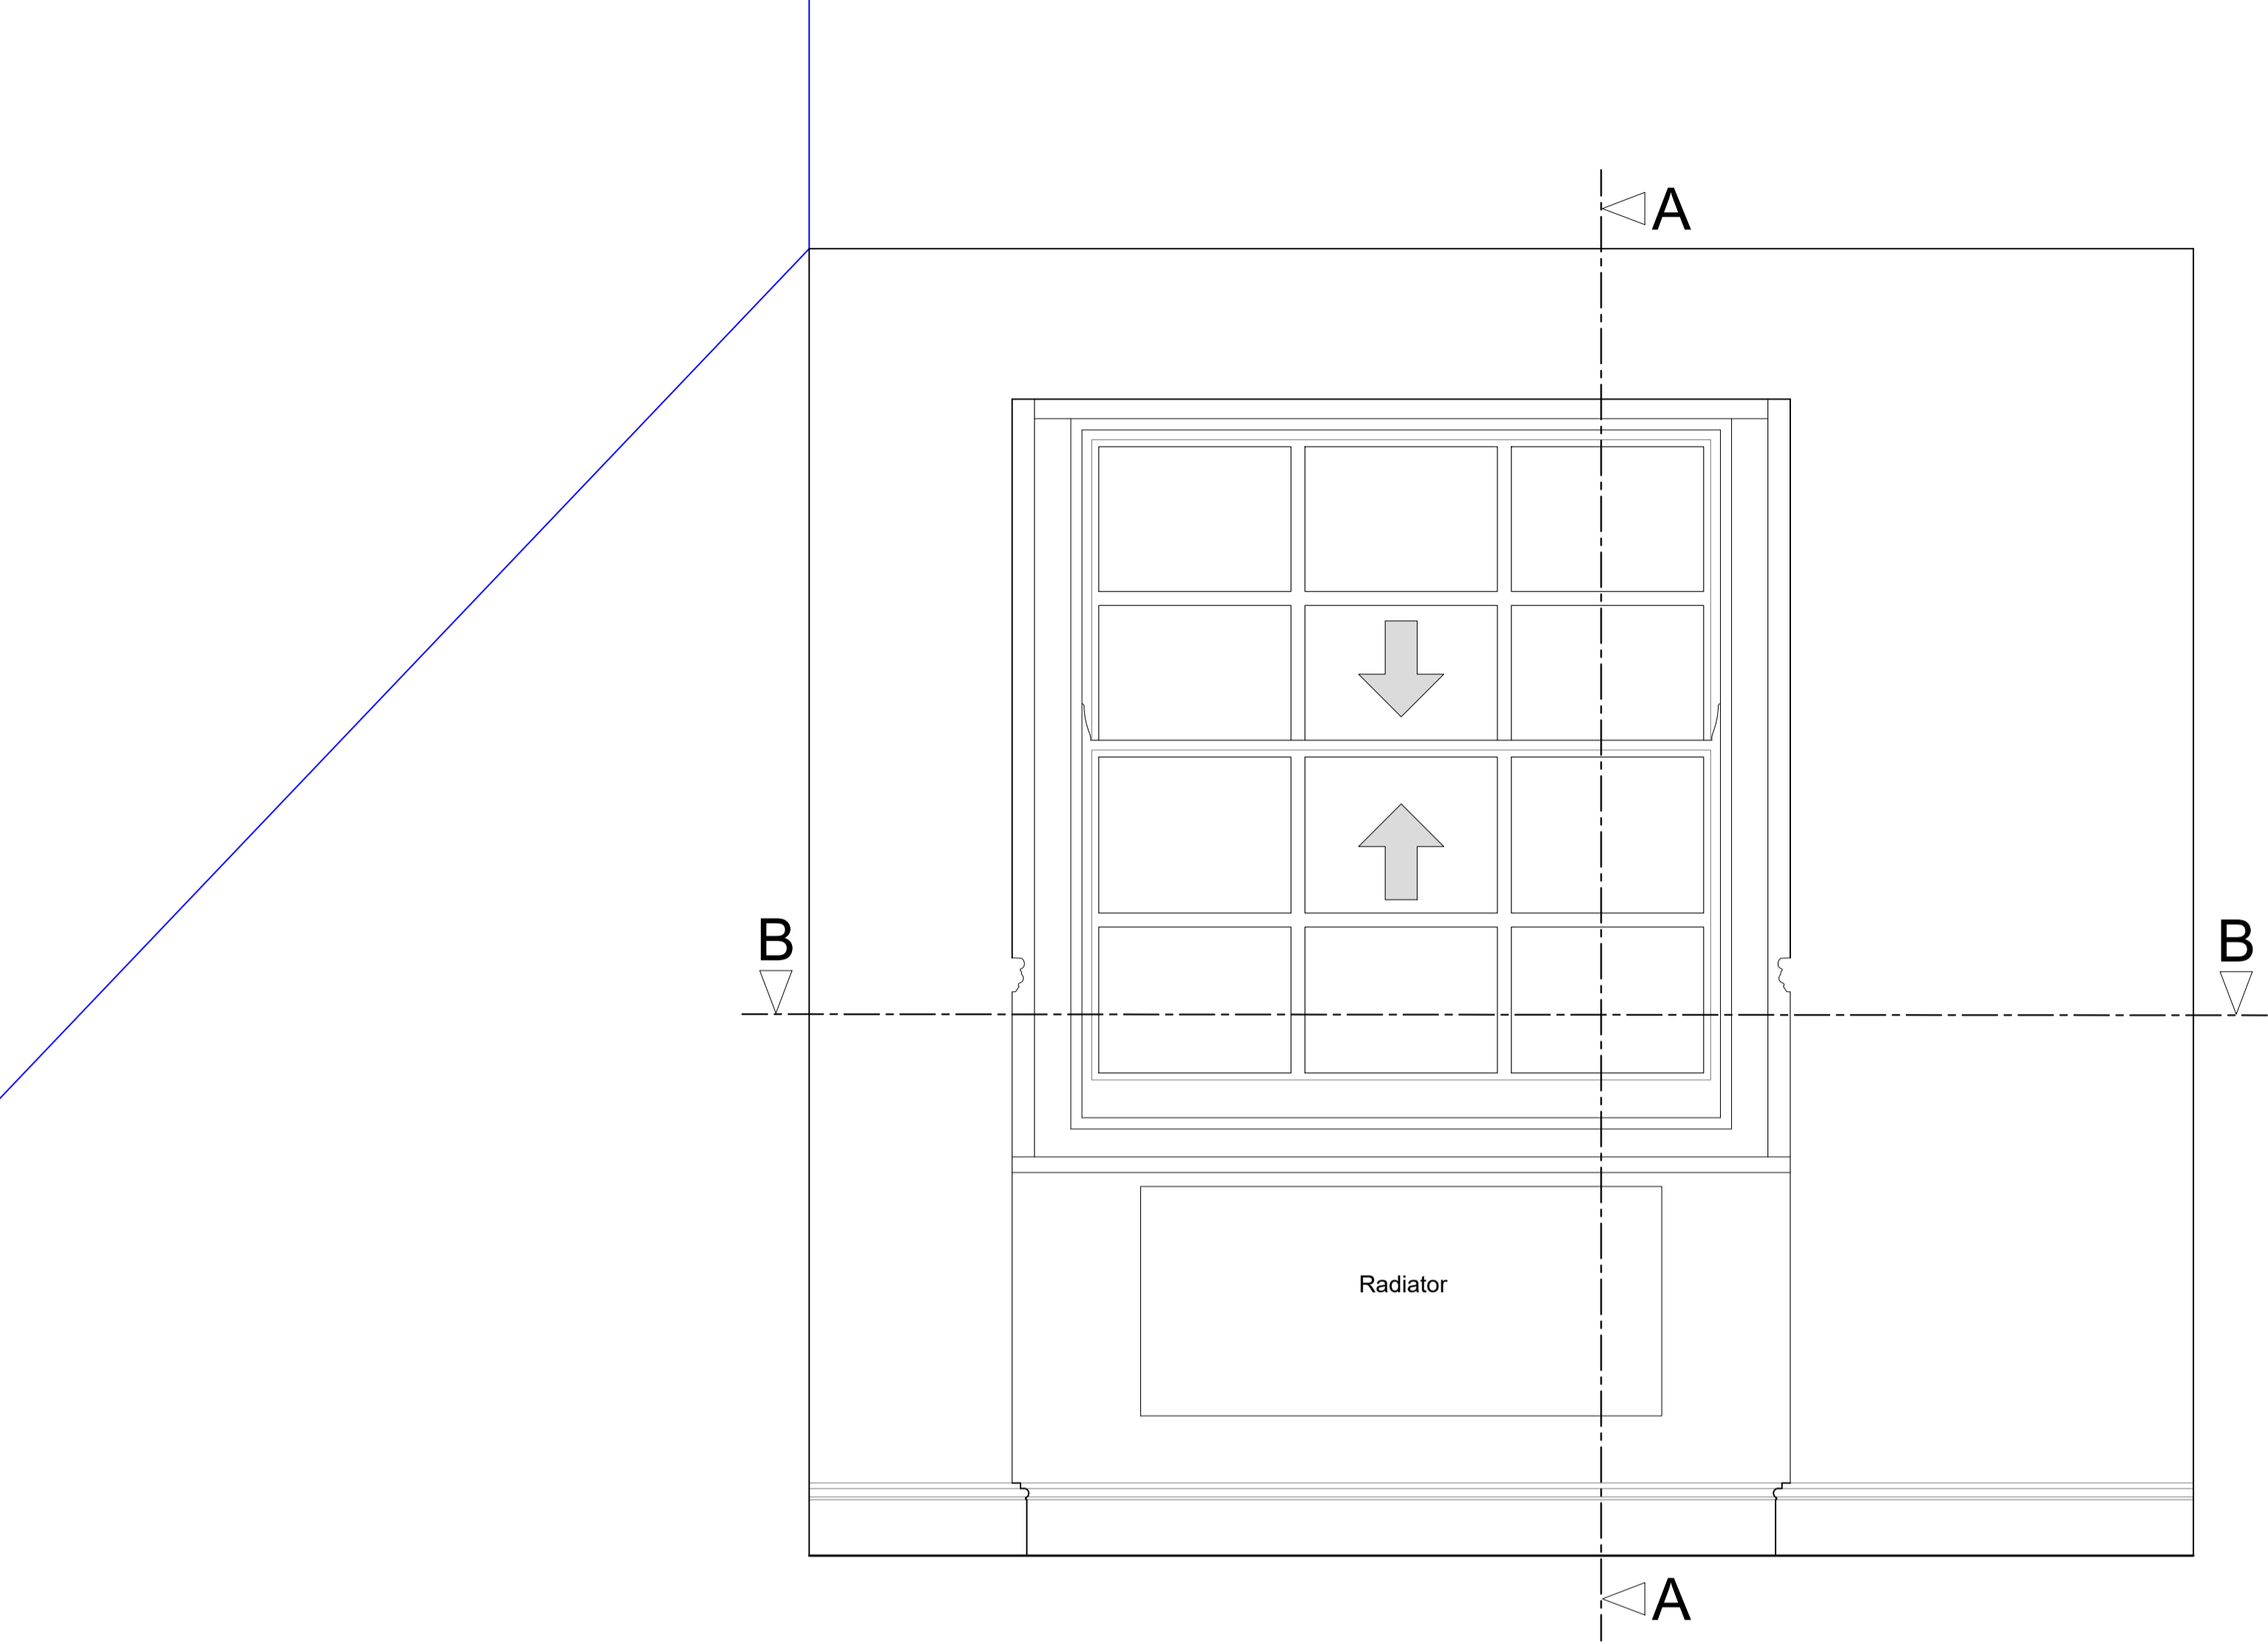

Section A-A through External Wall
Scale: 1:10

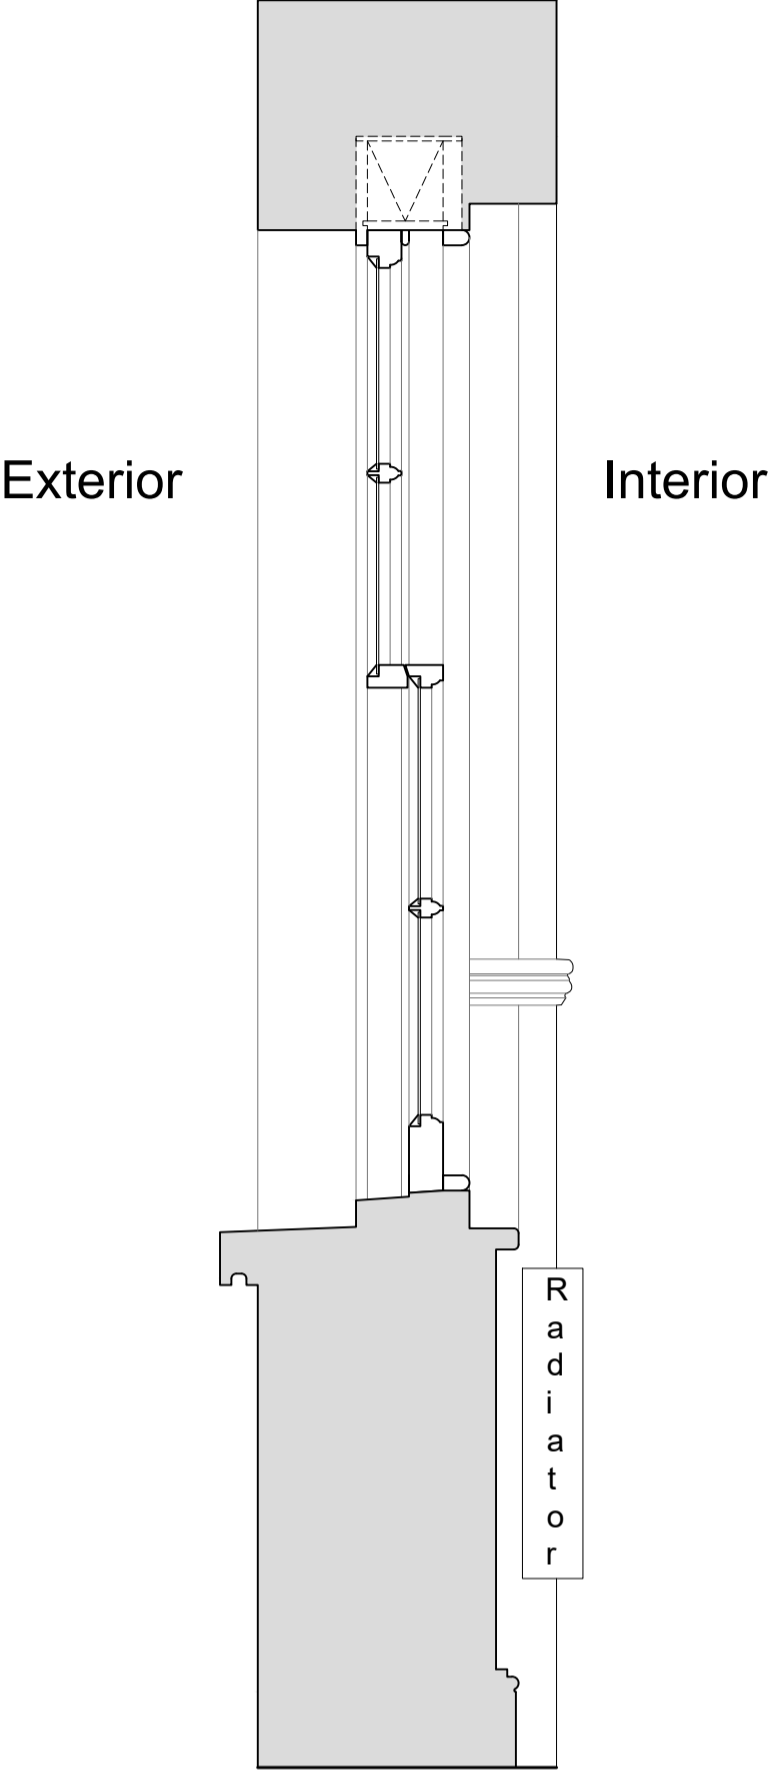

Plan Section B-B
Scale: 1:10

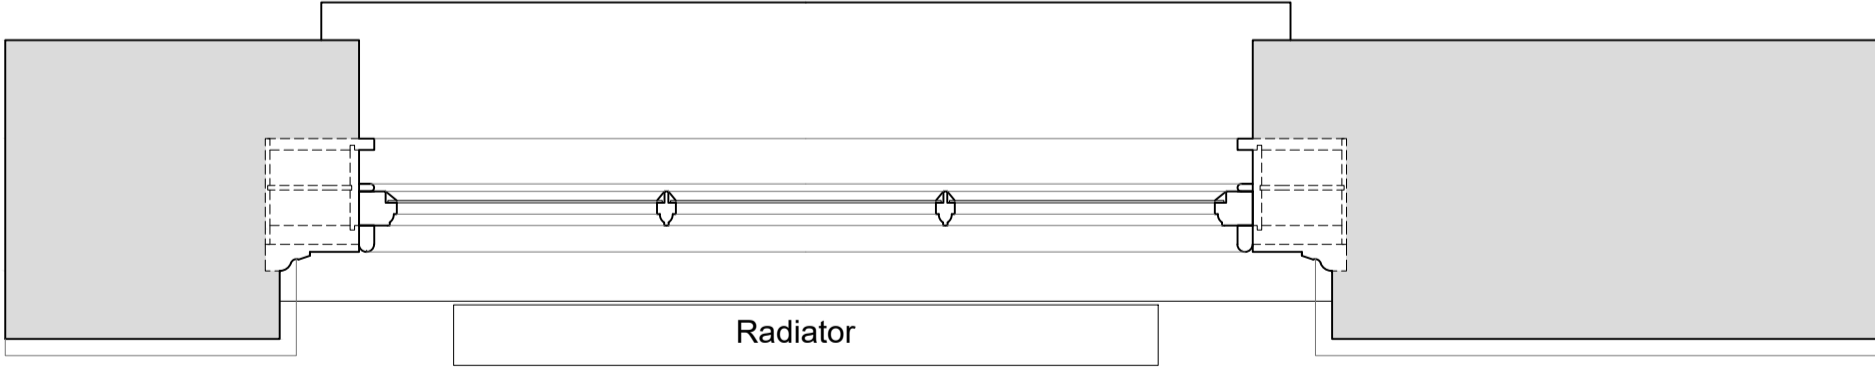

Revision	Date	Amendment
1.0	14-03-2019	Issued for listed building consent application

Do not reproduce this drawing without written permission
All dimensions are in millimetres unless stated otherwise

Drawing Not For Construction

HS2


High Speed (HS2) Limited
1st-3rd Floor
The Podium
1 Eversholt Street
London NW1 2DN

COSTAIN SKANSKA


Costain Skanska Joint Venture
9th Floor
The Tower
1 Eversholt Street
London NW1 2DN

Site Address: 41 A Morningside Terrace, London NW1			
Drawing Title: Basement - Bedroom: EXISTING Window Joinery Details - Sheet 1 of 3			
Surveyed by: AP & PB	Drawn by: AP	Checked by: OB	Presentation Scale: as shown @ A1
Date: 07-03-2019	Drawing No: WPI P066 NI - 41A MT-EX-BS-J-01	Revision: 1.0	


Internal Room Elevation with Secondary Glazing Installed
Scale: 1:10

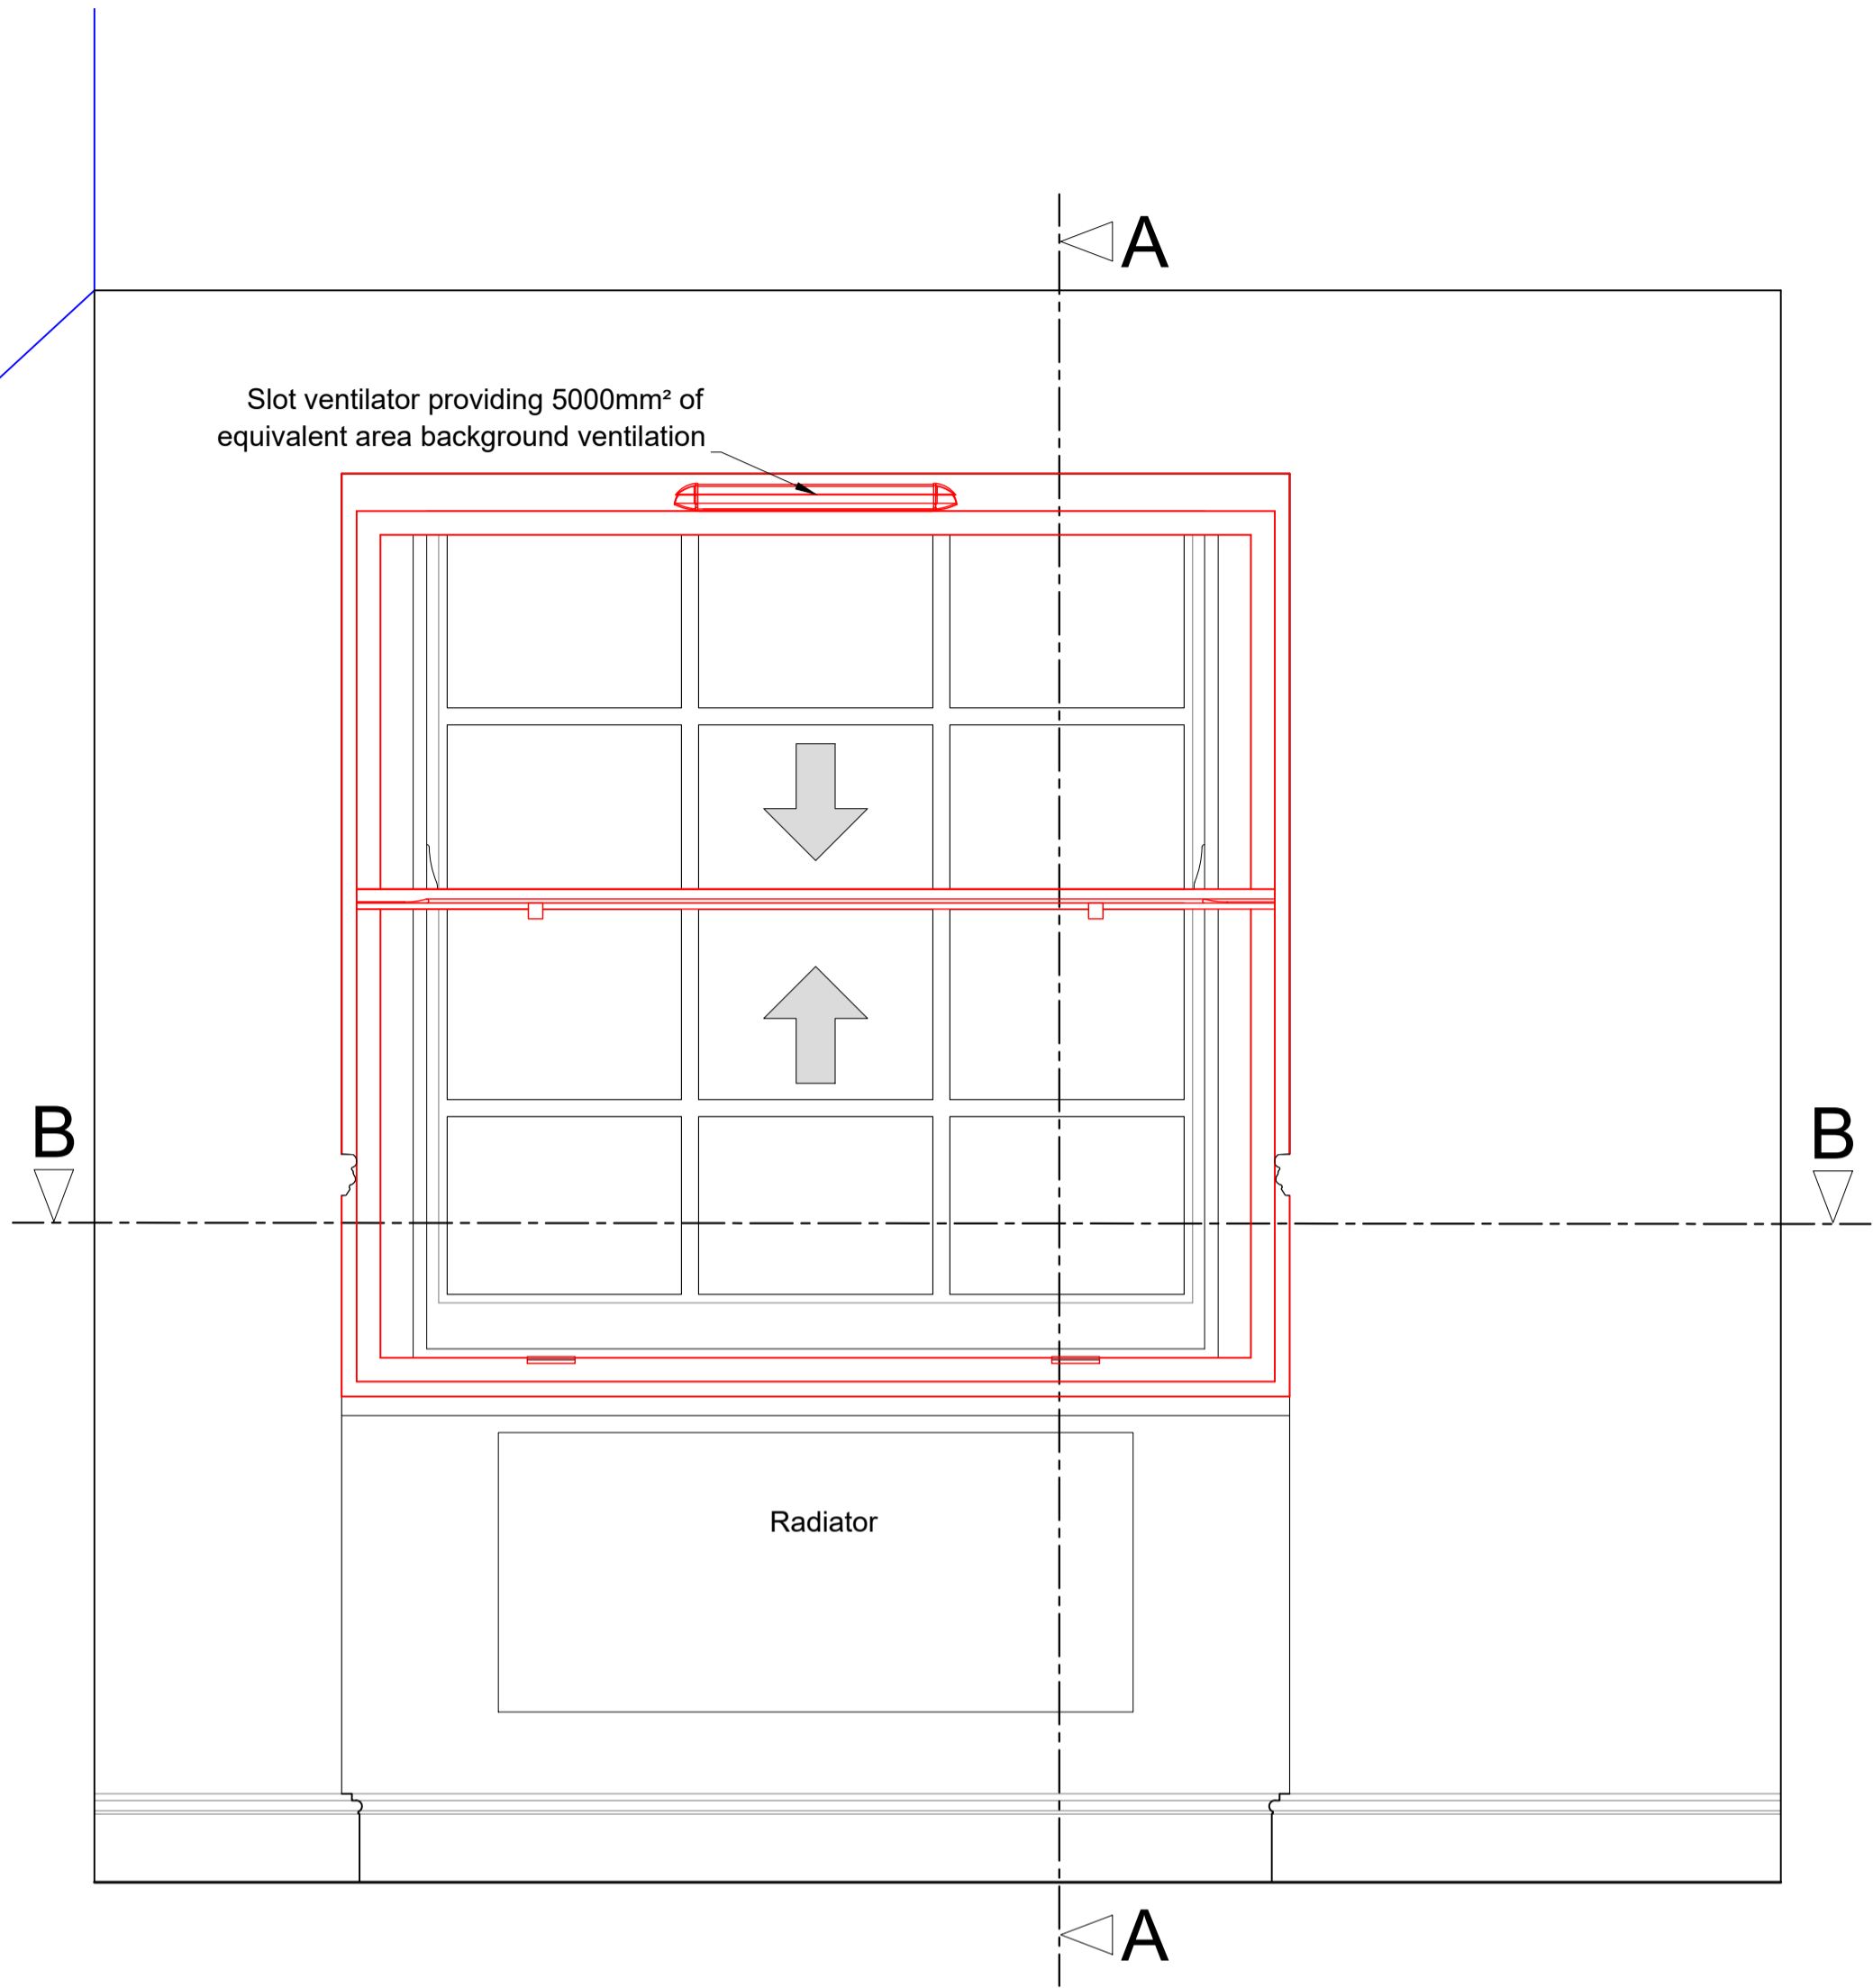

Section A-A through External Wall with Secondary Glazing Installed
Scale: 1:10

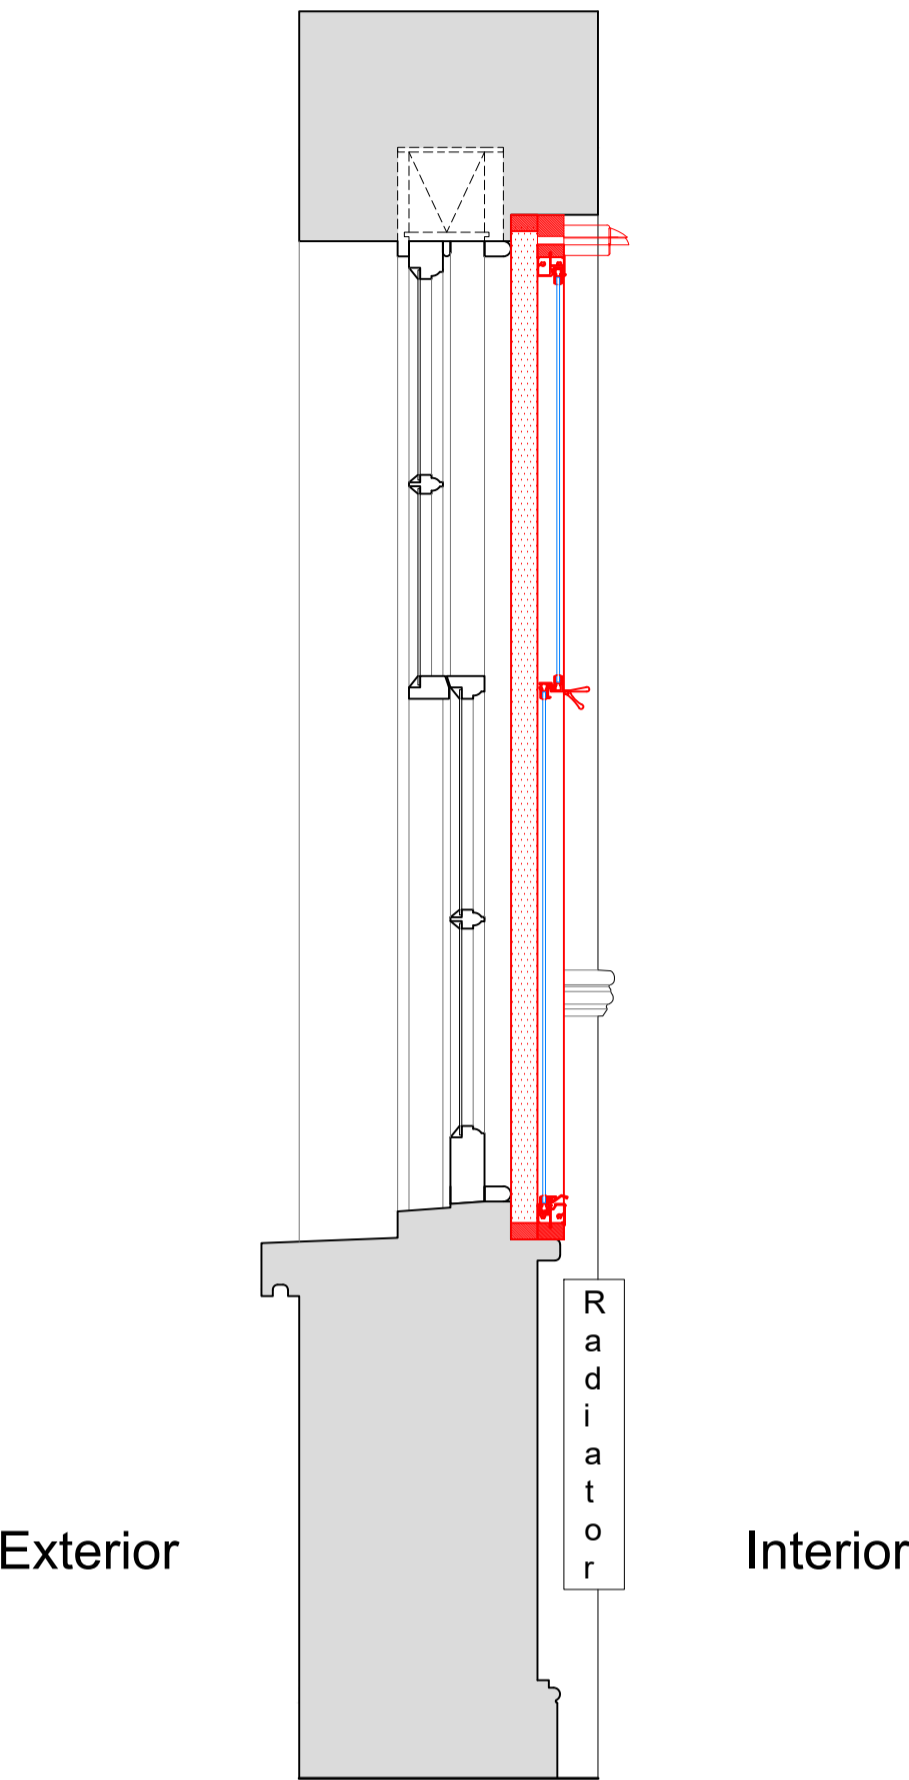

Plan Section B-B with Secondary Glazing Installed
Scale: 1:10

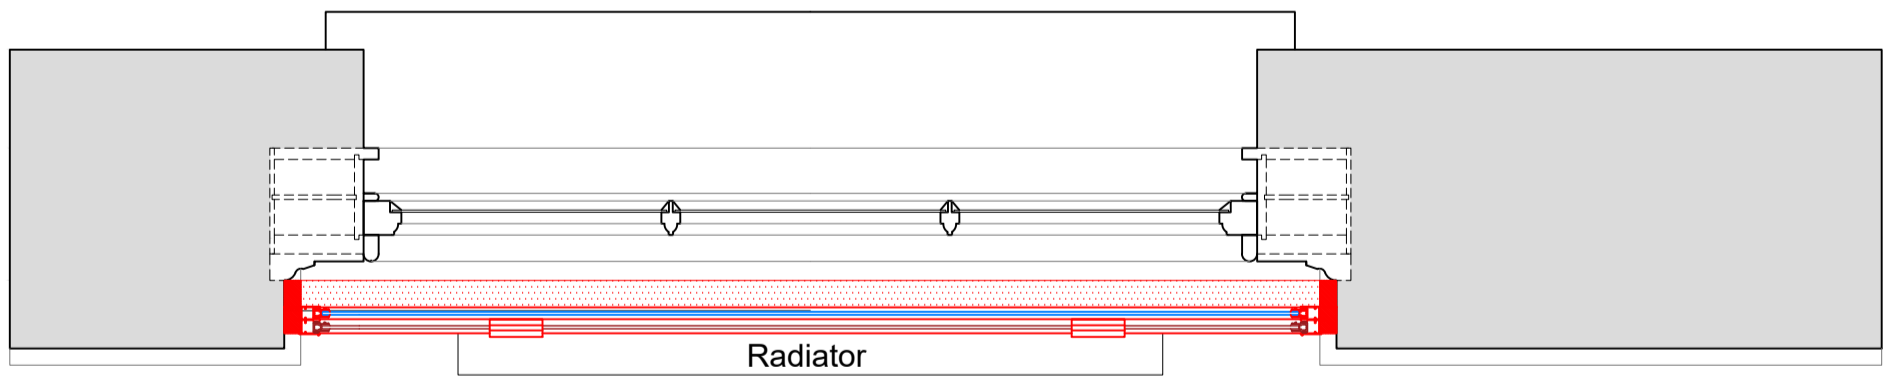

SECONDARY GLAZING SHOWN IN RED FOR VISUAL CLARITY ONLY

Revision	Date	Amendment
1.0	14-03-2019	Issued for listed building consent application

Do not reproduce this drawing without written permission
All dimensions are in millimetres unless stated otherwise

Drawing Not For Construction

HS2


High Speed (HS2) Limited
1st-3rd Floor
The Podium
1 Eversholt Street
London NW1 2DN

COSTAIN SKANSKA


Costain Skanska Joint Venture
9th Floor
The Tower
1 Eversholt Street
London NW1 2DN

Site Address: 41 A Mornington Terrace, London NW1			
Drawing Title: Basement - Bedroom: PROPOSED Secondary Glazing Details - Sheet 2 of 3			
Surveyed by: AP & PB	Drawn by: AP	Checked by: OB	Presentation Scale: as shown @ A1
Date: 07-03-2019	Drawing No: WPI P066 NI - 41A MT-PR-BS-J-01.1	Revision: 1.0	


Section C-C
Scale: 1:5 on A1

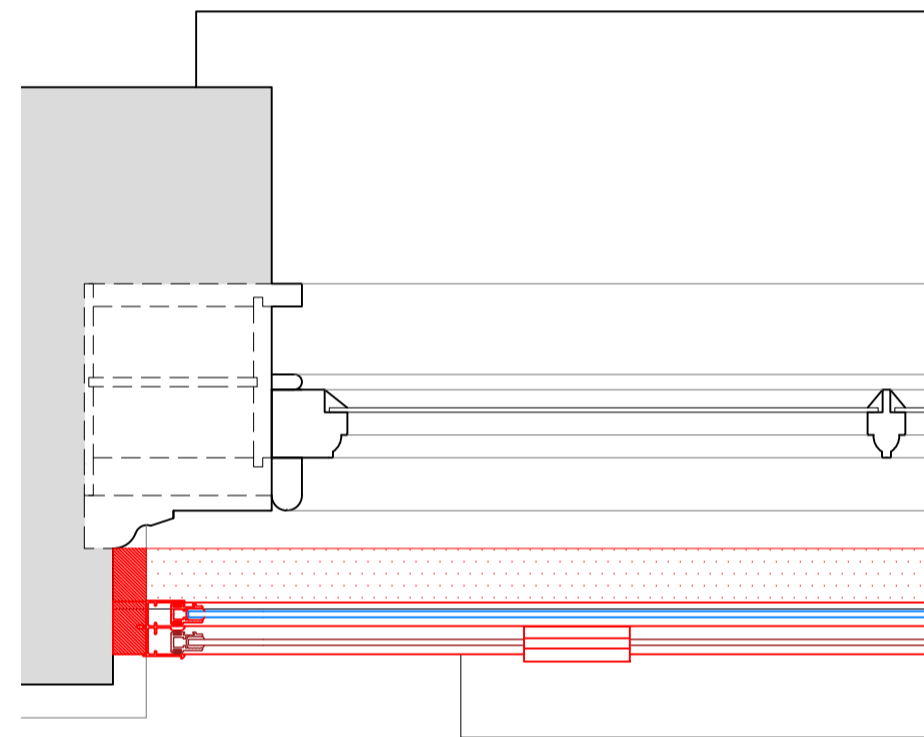


Section D-D
Scale: 1:5 on A1

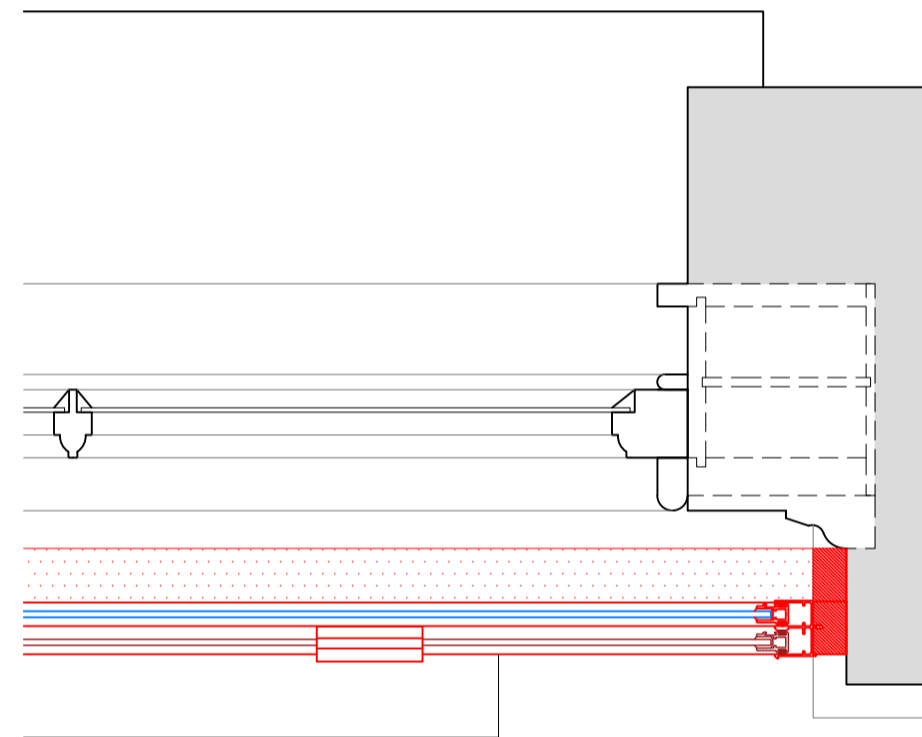


Section E-E
Scale: 1:5 on A1

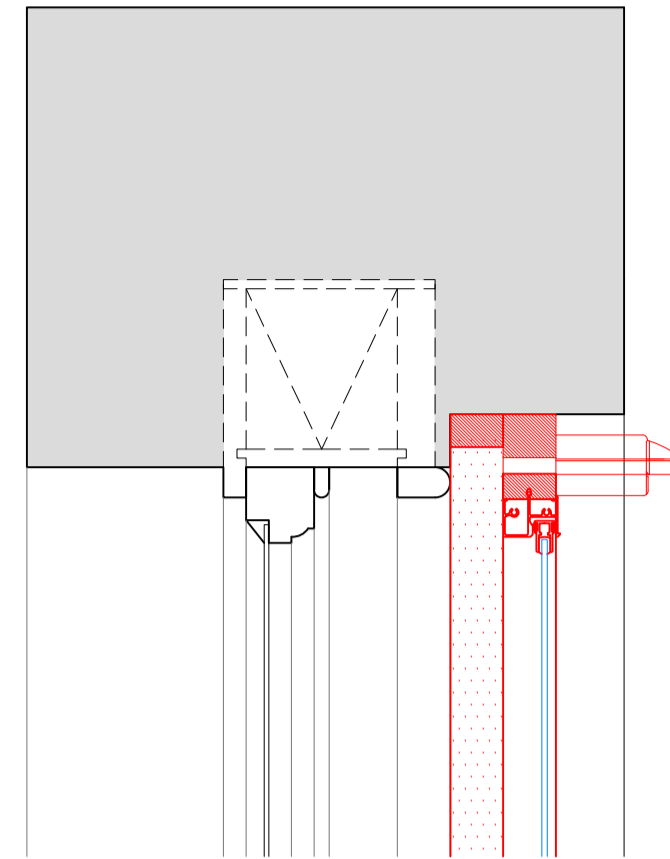

Section F-F
Scale: 1:5 on A1

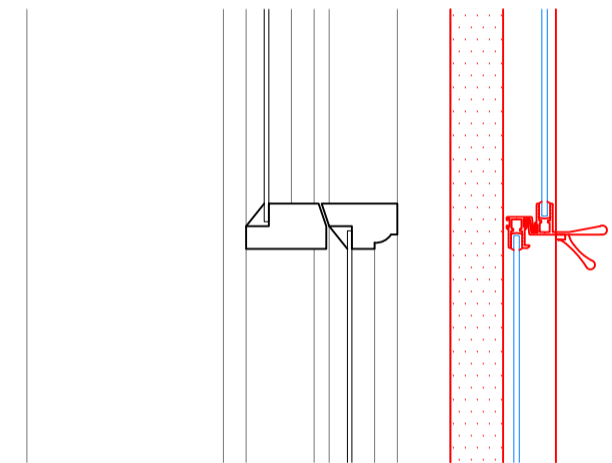

Section G-G
Scale: 1:5 on A1

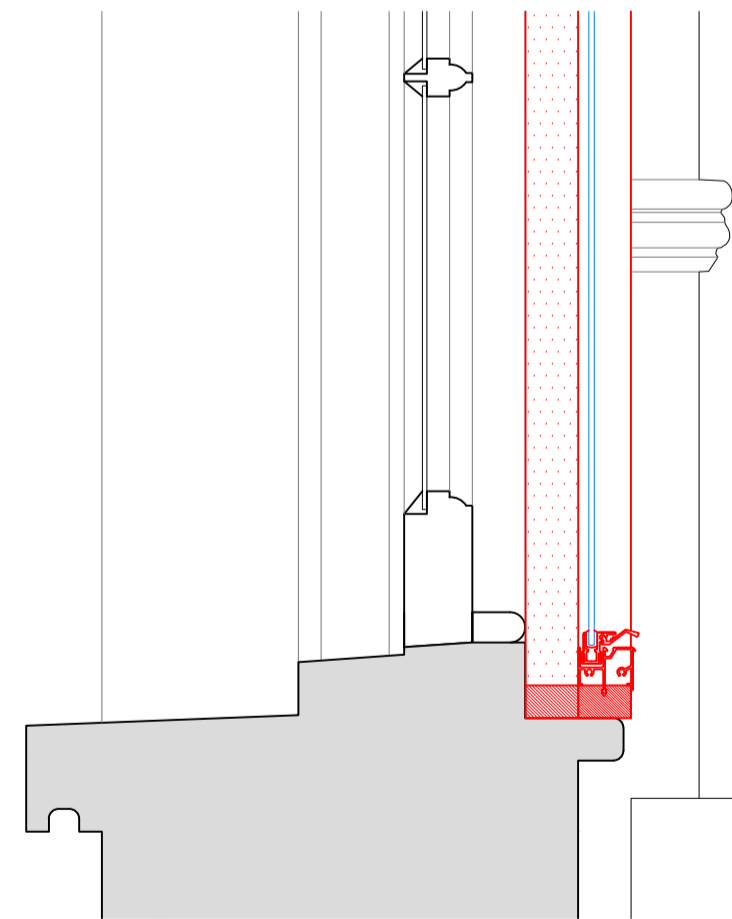

SECONDARY GLAZING SHOWN IN RED FOR VISUAL CLARITY ONLY

Revision	Date	Amendment
1.0	14-03-2019	Issued for listed building consent application

Do not reproduce this drawing without written permission
All dimensions are in millimetres unless stated otherwise

Drawing Not For Construction

HS2


High Speed (HS2) Limited
1st-3rd Floor
The Podium
1 Eversholt Street
London NW1 2DN

COSTAIN SKANSKA


Costain Skanska Joint Venture
9th Floor
The Tower
1 Eversholt Street
London NW1 2DN

Site Address: 41 A Mornington Terrace, London NW1			
Drawing Title: Basement - Bedroom: PROPOSED Secondary Glazing Details - Sheet 3 of 3			
Surveyed by: AP & PB	Drawn by: AP	Checked by: OB	Presentation Scale: 1:5 @ A1
Date: 07-03-2019	Drawing No: WPI P066 NI - 41A MT-PR-BS-J-01.2	Revision: 1.0	


Internal Room Elevation
Scale: 1:10

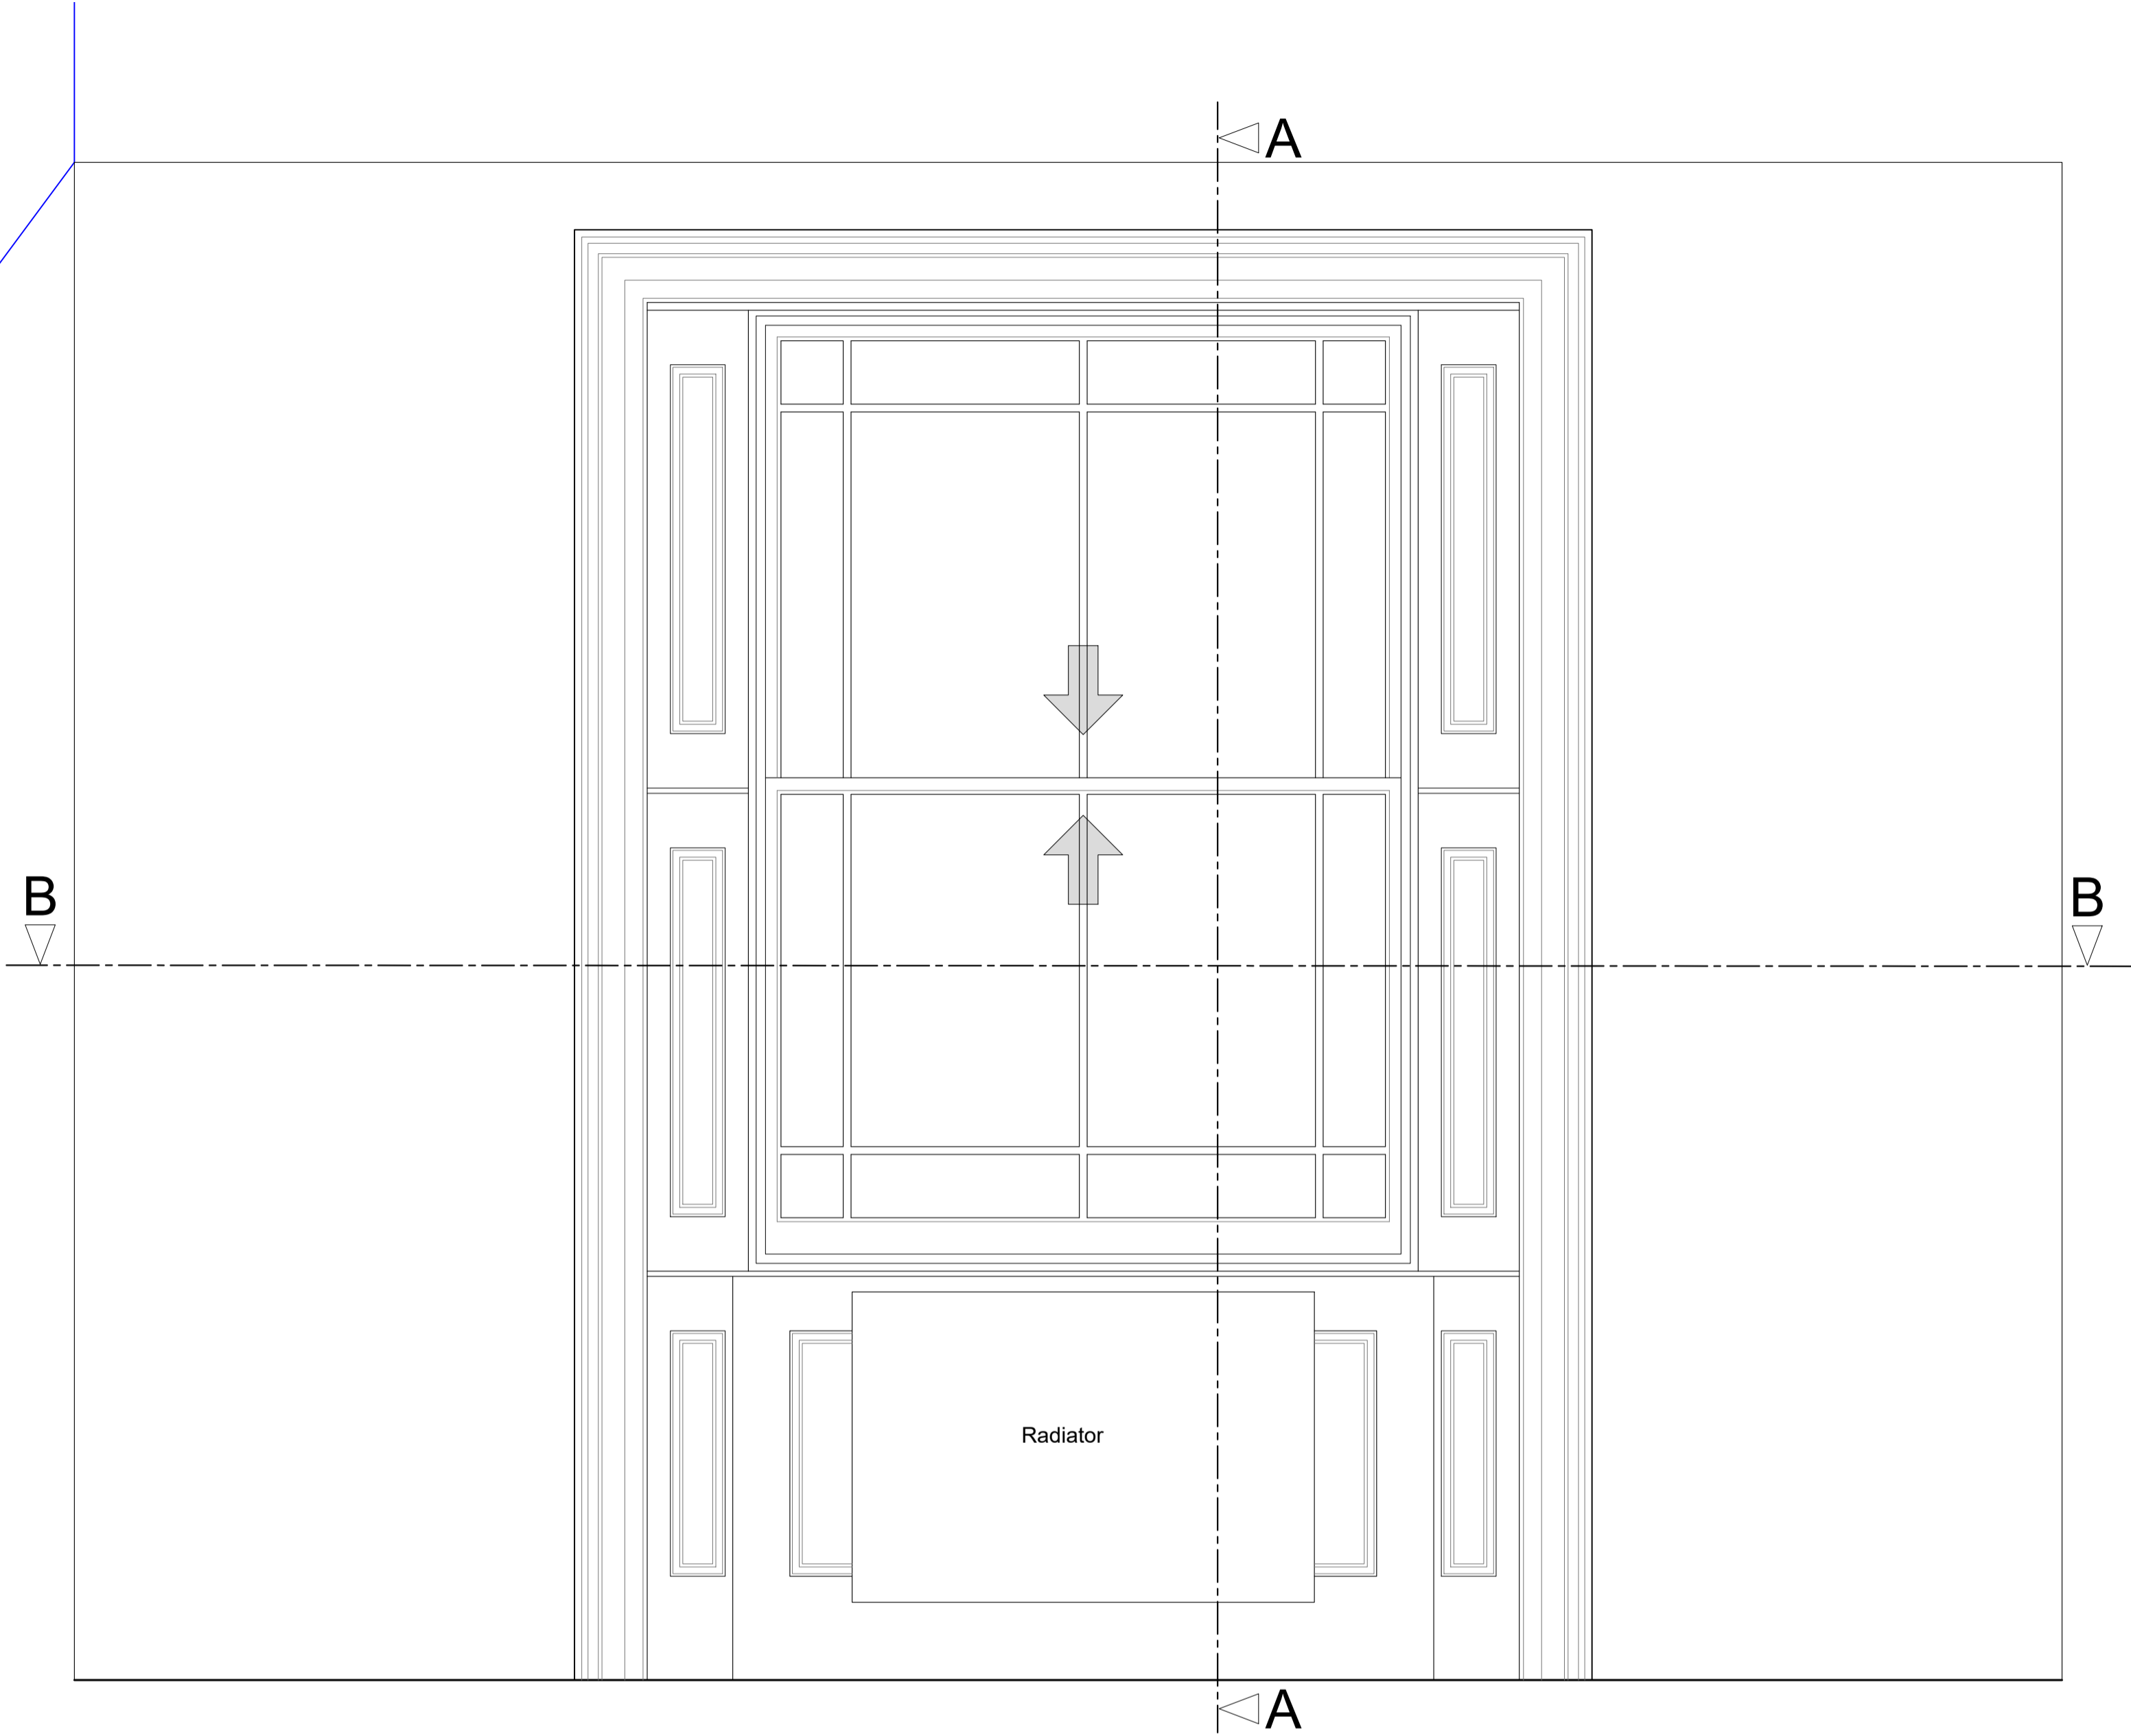

Section A-A through External Wall
Scale: 1:10

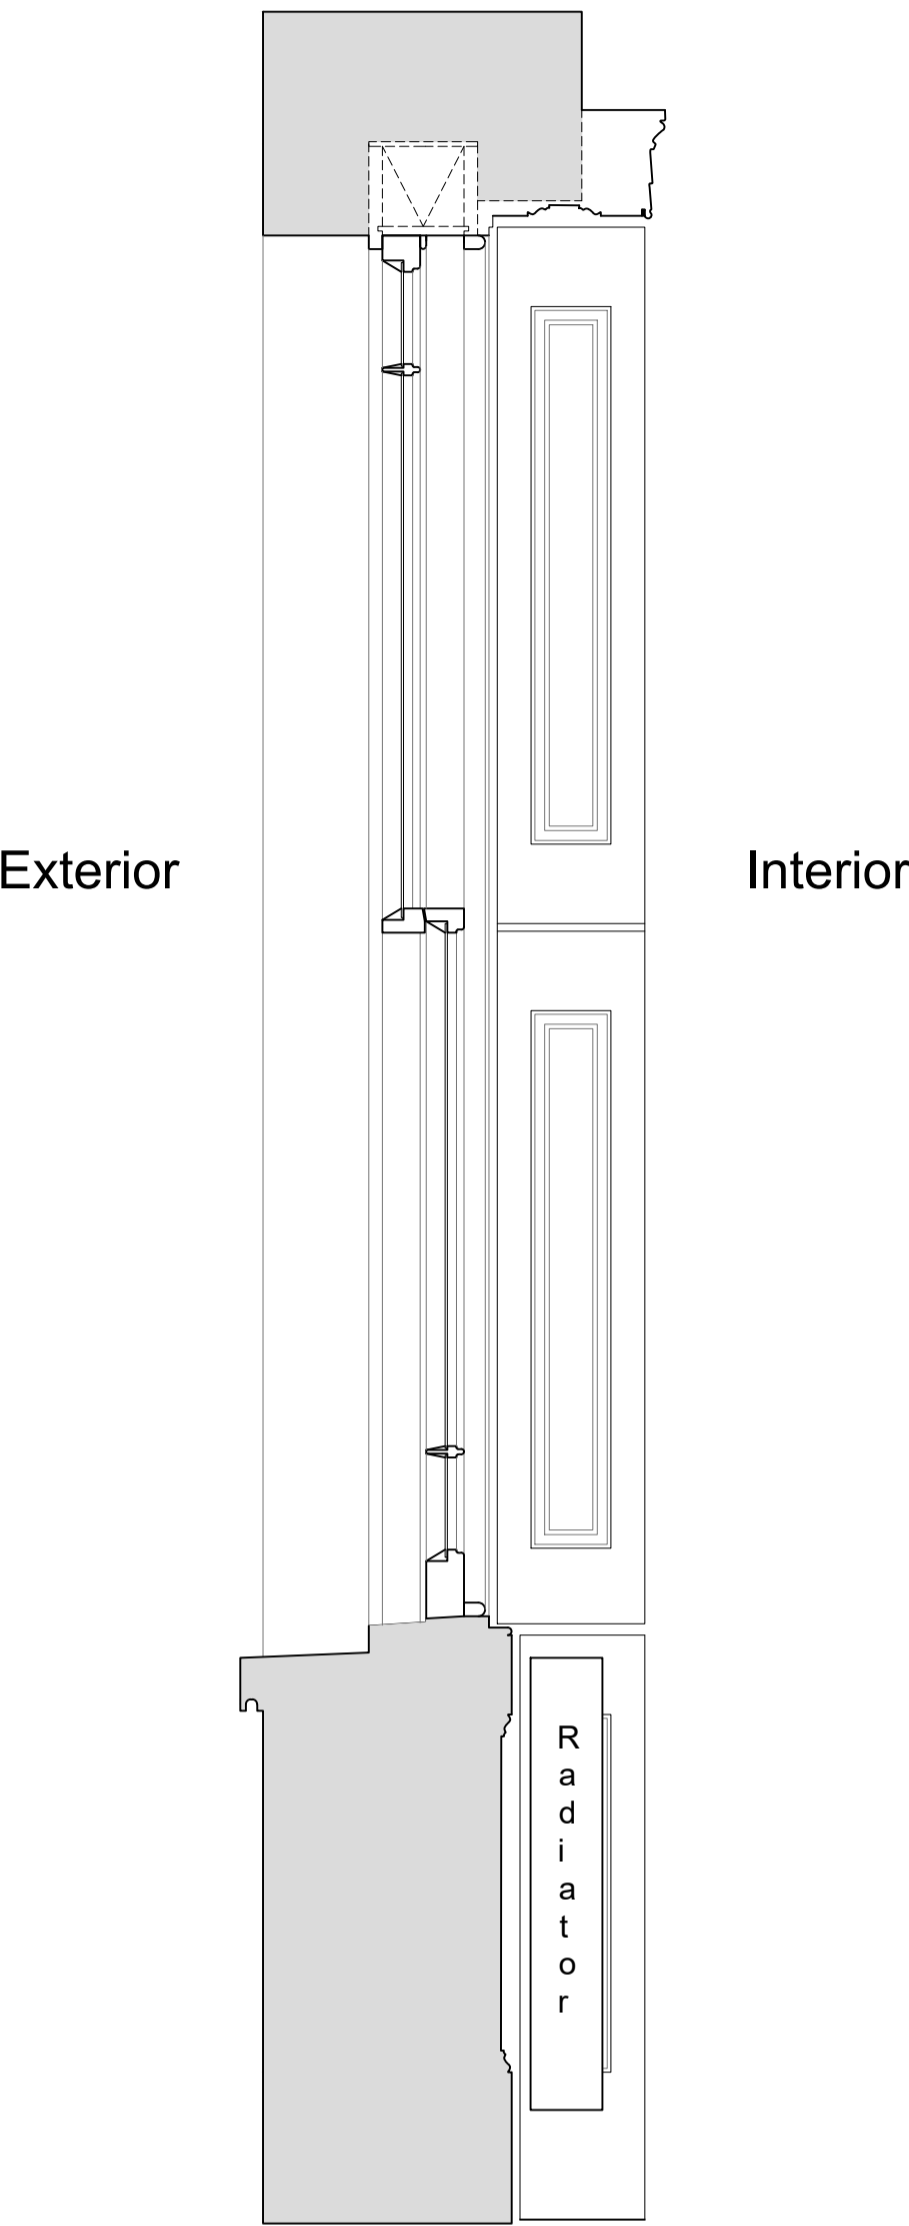

Plan Section B-B
Scale: 1:10

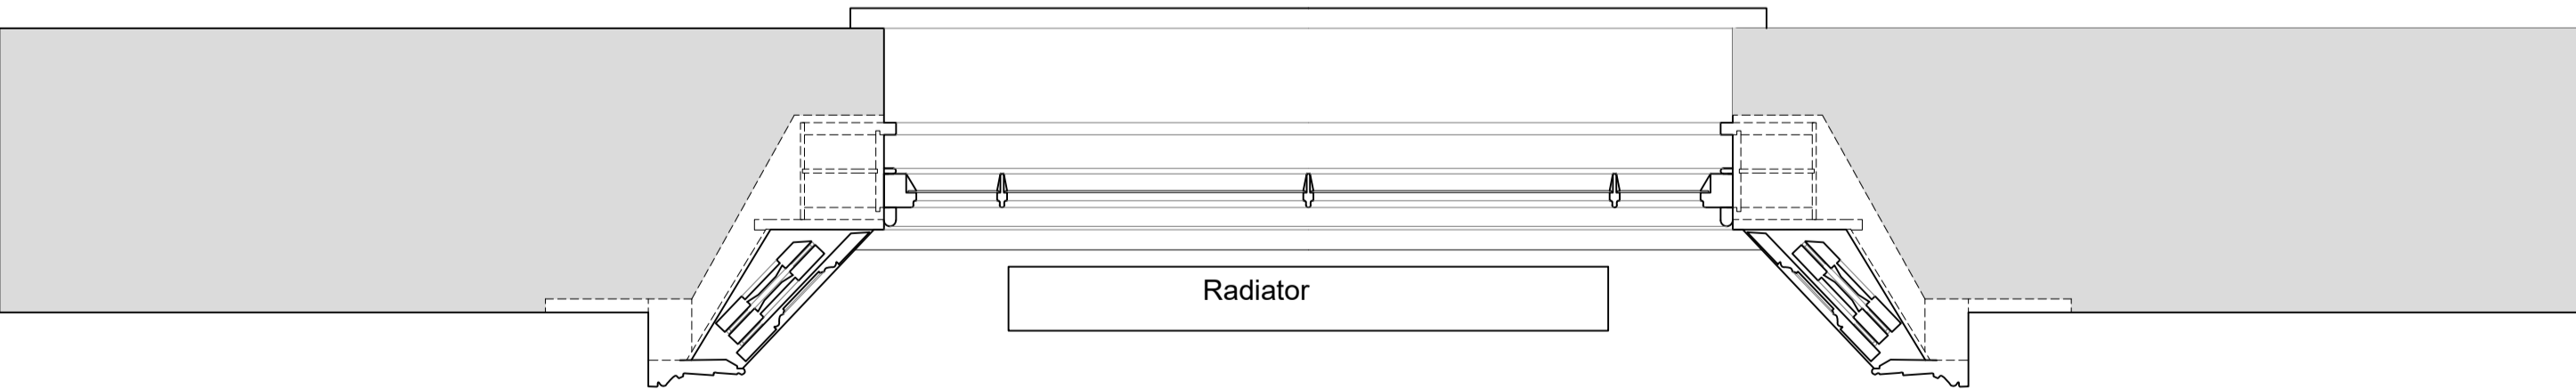

Revision	Date	Amendment
1.0	14-03-2019	Issued for listed building consent application

Do not reproduce this drawing without written permission
All dimensions are in millimetres unless stated otherwise

Drawing Not For Construction

HS2


High Speed (HS2) Limited
1st-3rd Floor
The Podium
1 Eversholt Street
London NW1 2DN

COSTAIN SKANSKA


Costain Skanska Joint Venture
9th Floor
The Tower
1 Eversholt Street
London NW1 2DN

Site Address: 41 A Morningside Terrace, London NW1		
Drawing Title: Ground Floor - Lounge: EXISTING Window Joinery Details - Sheet 1 of 3		
Surveyed by: AP & PB	Drawn by: AP	Checked by: OB
Presentation Scale: as shown @ A1		Revision: 1.0


Internal Room Elevation with Secondary Glazing Installed
Scale: 1:10

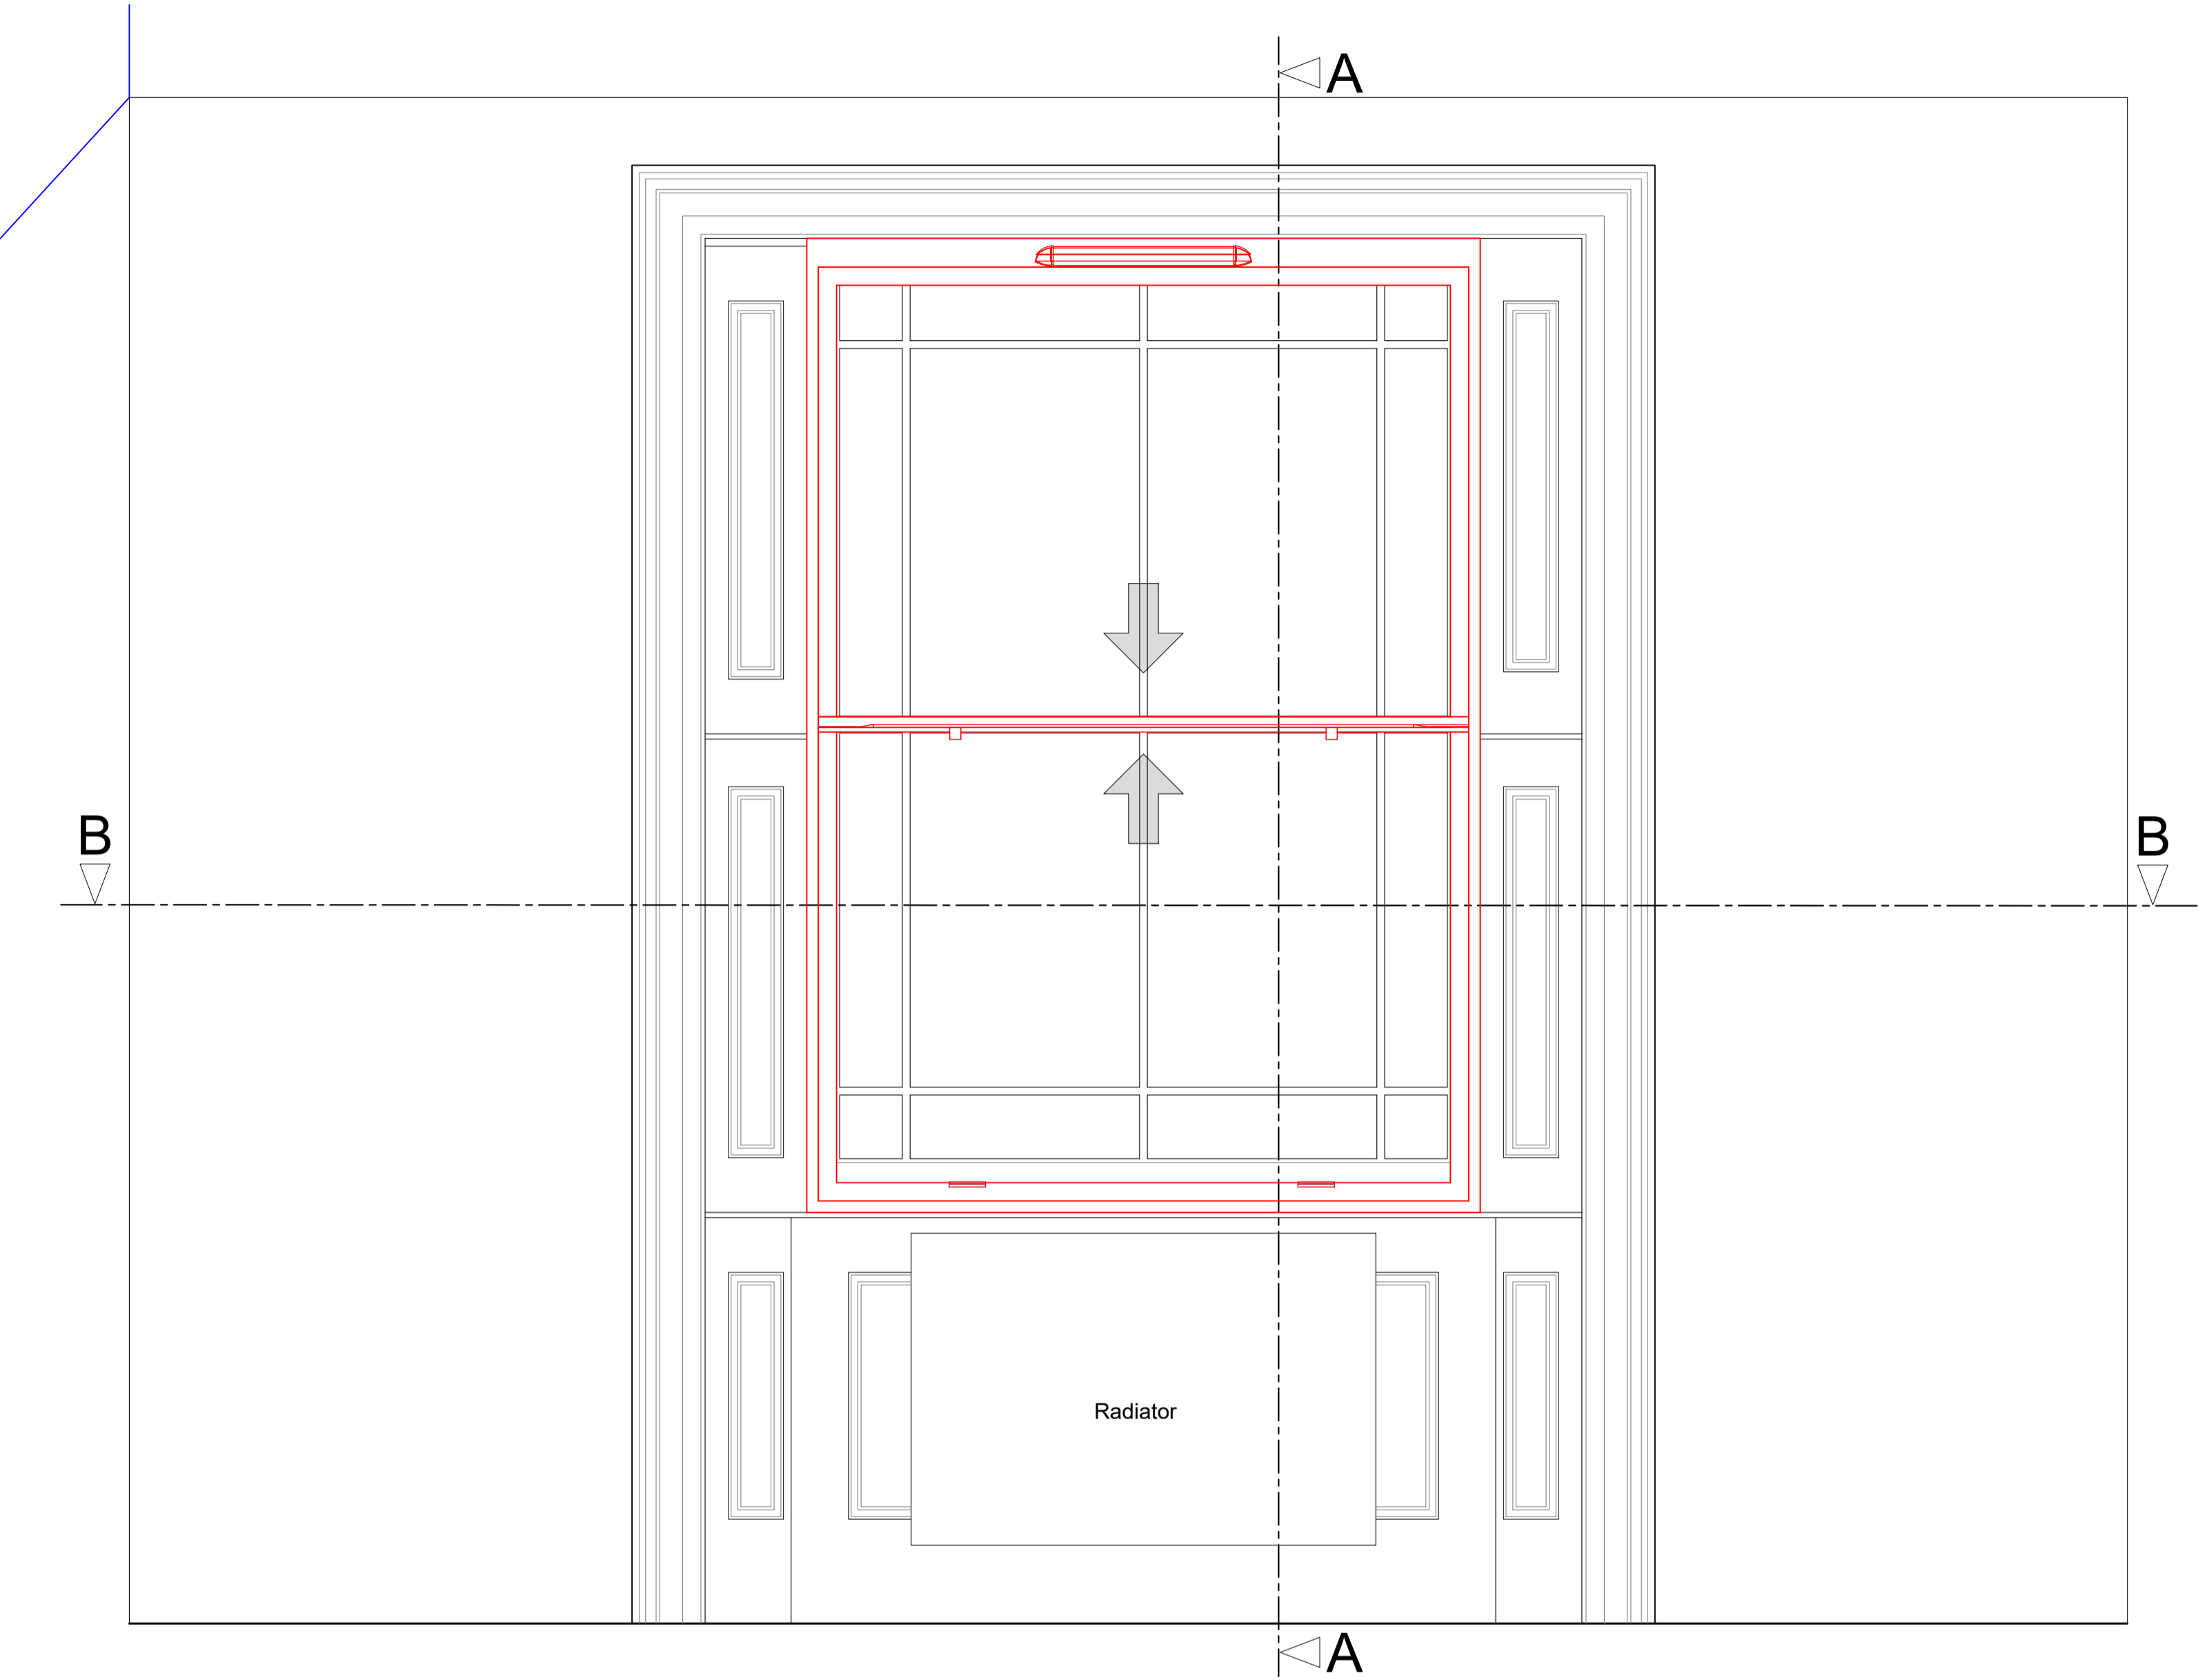

Section A-A through External Wall with Secondary Glazing Installed
Scale: 1:10

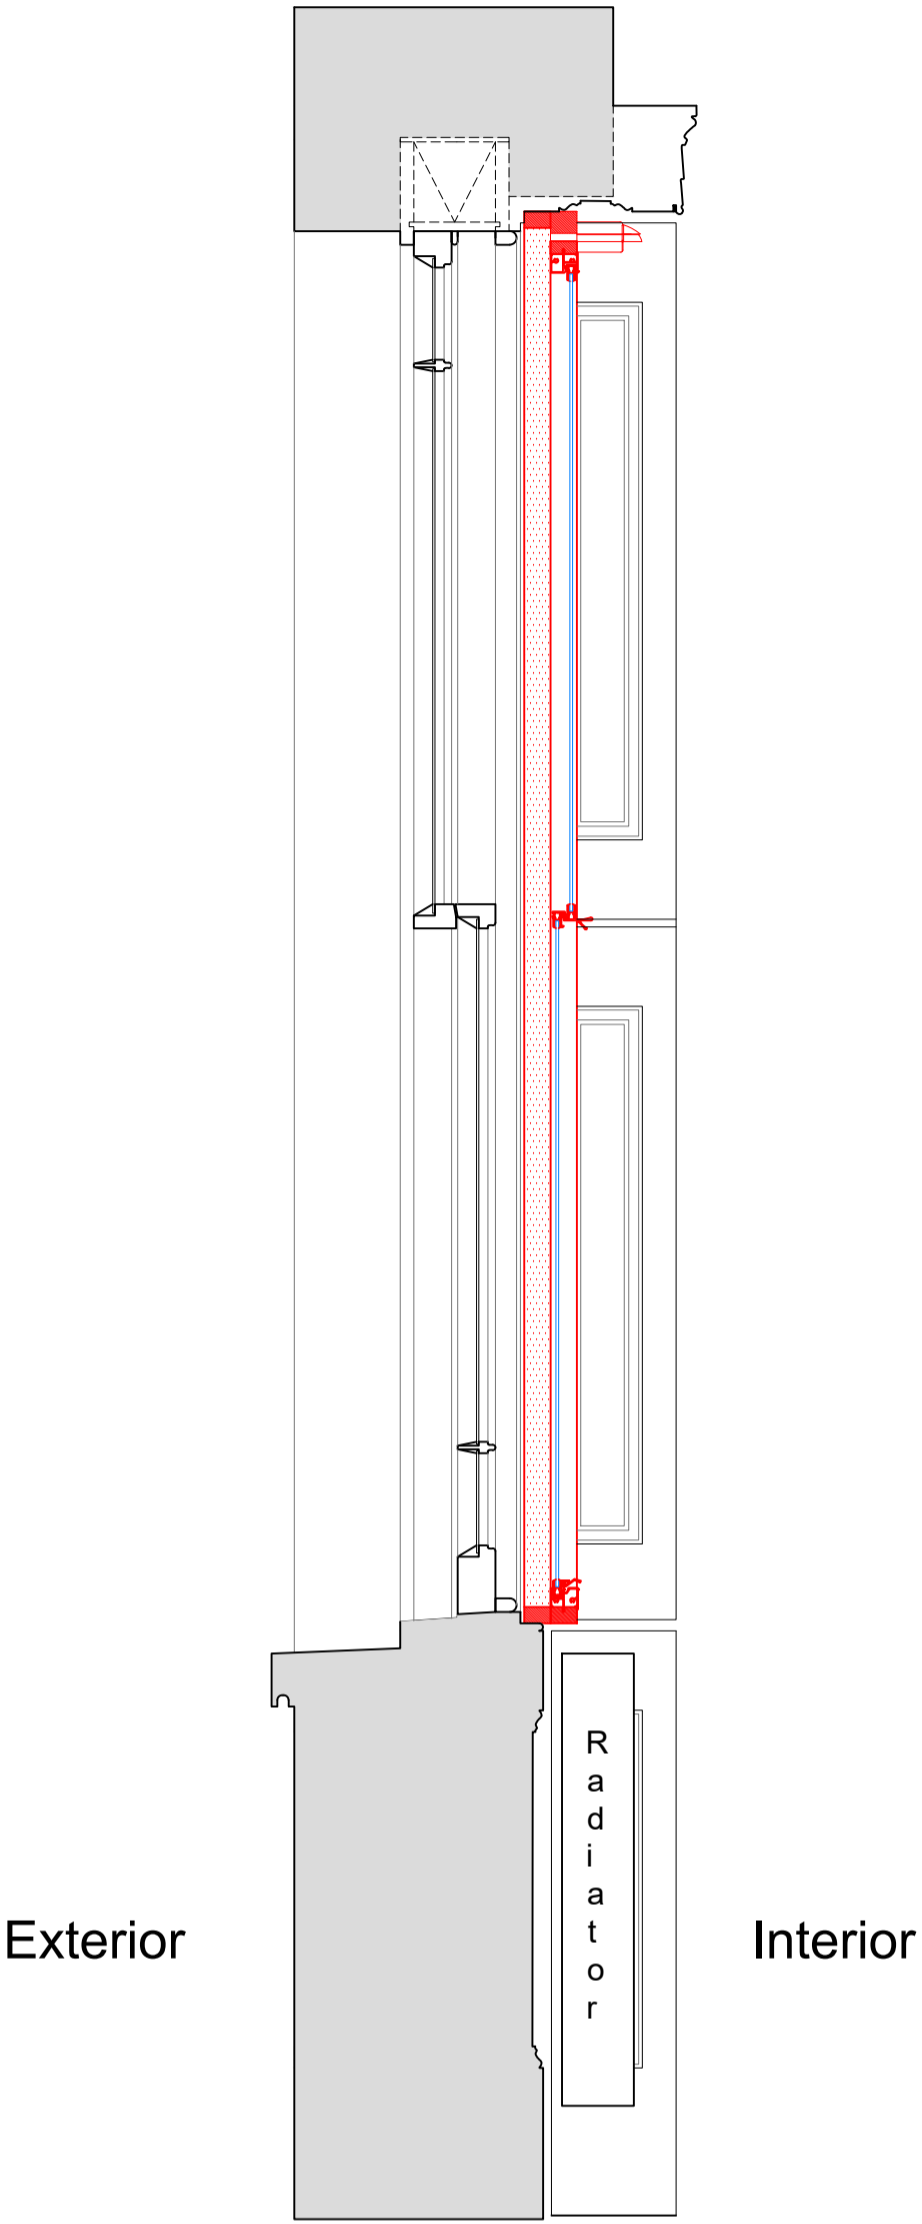

Plan Section B-B with Secondary Glazing Installed
Scale: 1:10

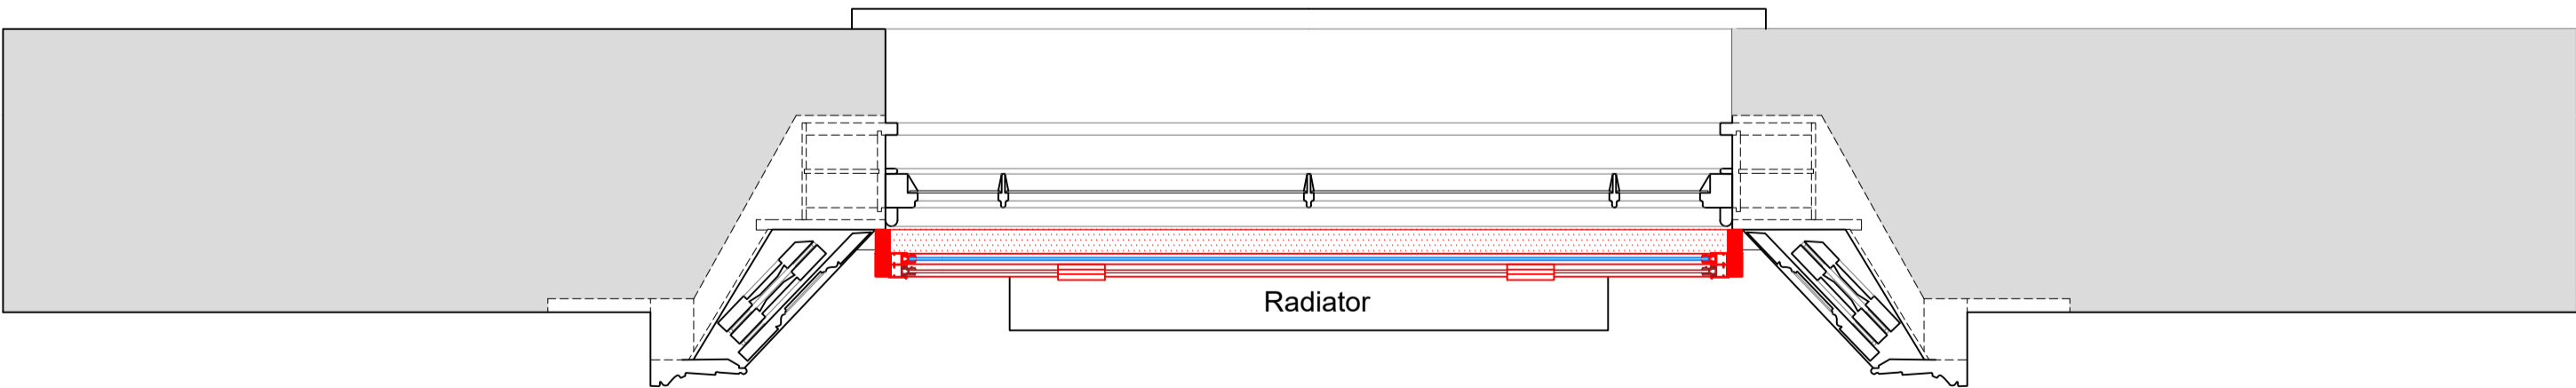

SECONDARY GLAZING SHOWN IN RED FOR VISUAL CLARITY ONLY

Revision	Date	Amendment
1.0	14-03-2019	Issued for listed building consent application

Do not reproduce this drawing without written permission
All dimensions are in millimetres unless stated otherwise

Drawing Not For Construction

HS2


High Speed (HS2) Limited
1st-3rd Floor
The Podium
1 Eversholt Street
London NW1 2DN




Costain Skanska Joint Venture
9th Floor
The Tower
1 Eversholt Street
London NW1 2DN

Site Address: 38 Morningson Crescent, London NW1		
Drawing Title: Ground Floor - Lounge: PROPOSED Secondary Glazing Details - Sheet 2 of 3		
Surveyed by: AP & PB	Drawn by: AP	Checked by: OB
Presentation Scale: as shown @ A1		Revision: 1.0
Date: 07-03-2019	Drawing No: WPI P066 NI - 41A MT-PR-GF-J-02.1	


Section C-C
Scale: 1:5 on A1

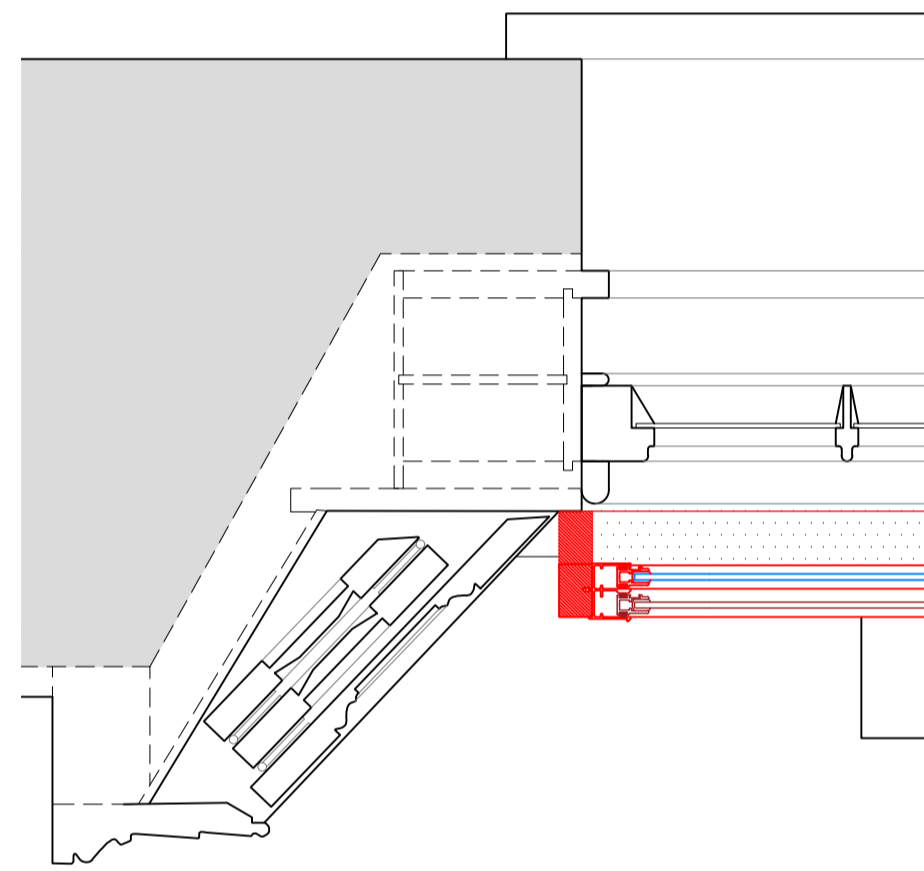


Section D-D
Scale: 1:5 on A1

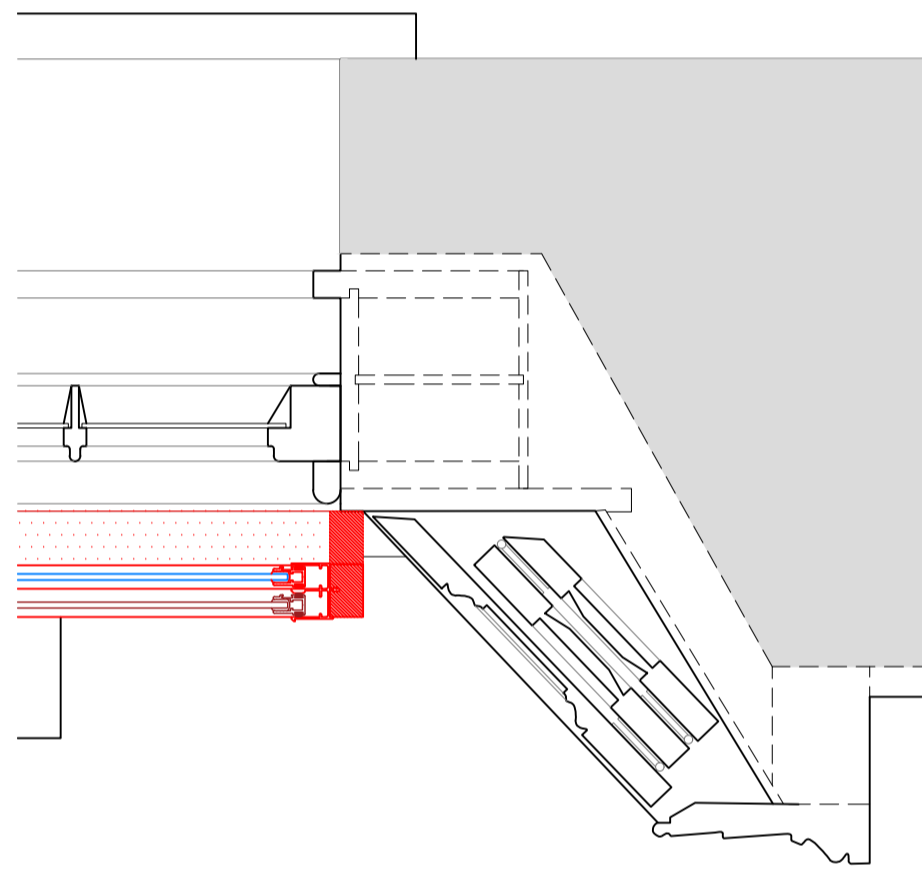


Section E-E
Scale: 1:5 on A1

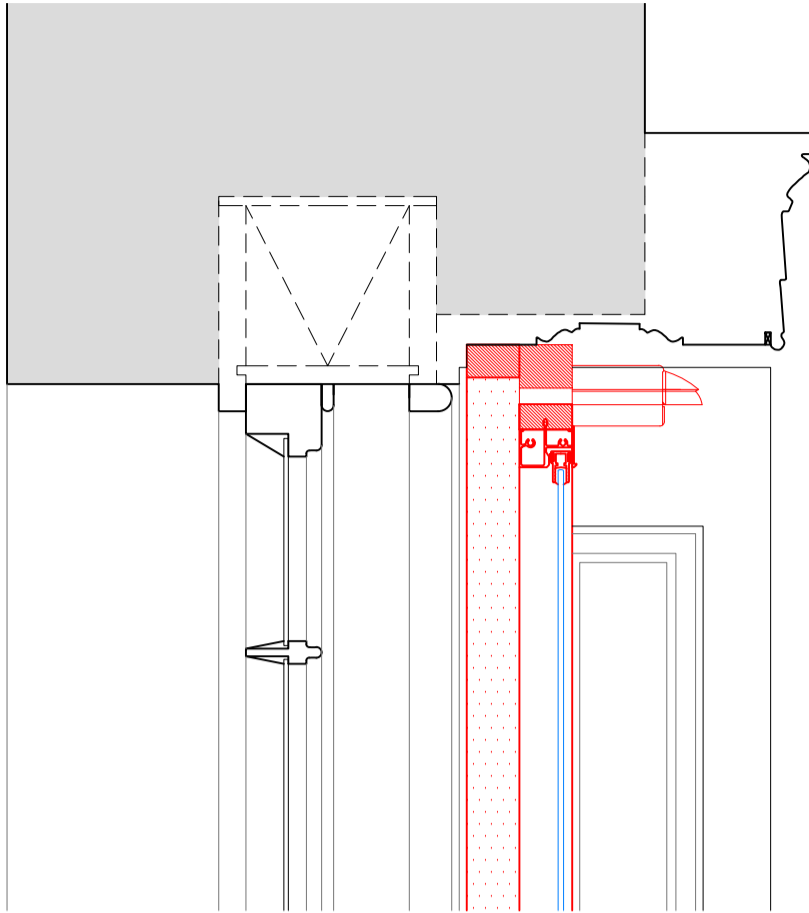

Section F-F
Scale: 1:5 on A1

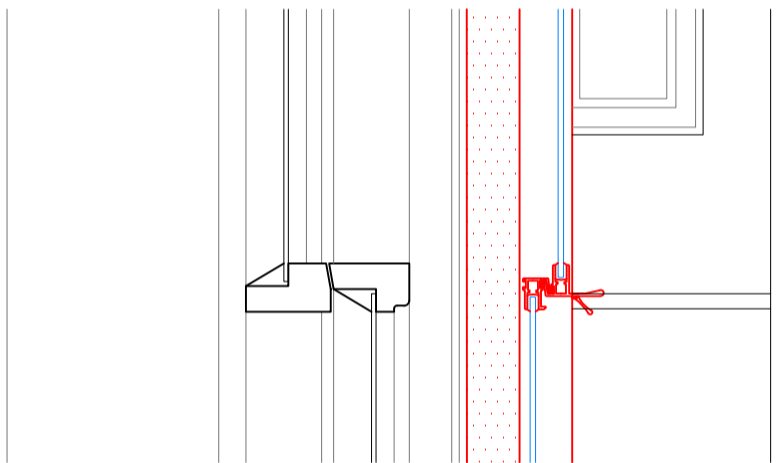

Section G-G
Scale: 1:5 on A1

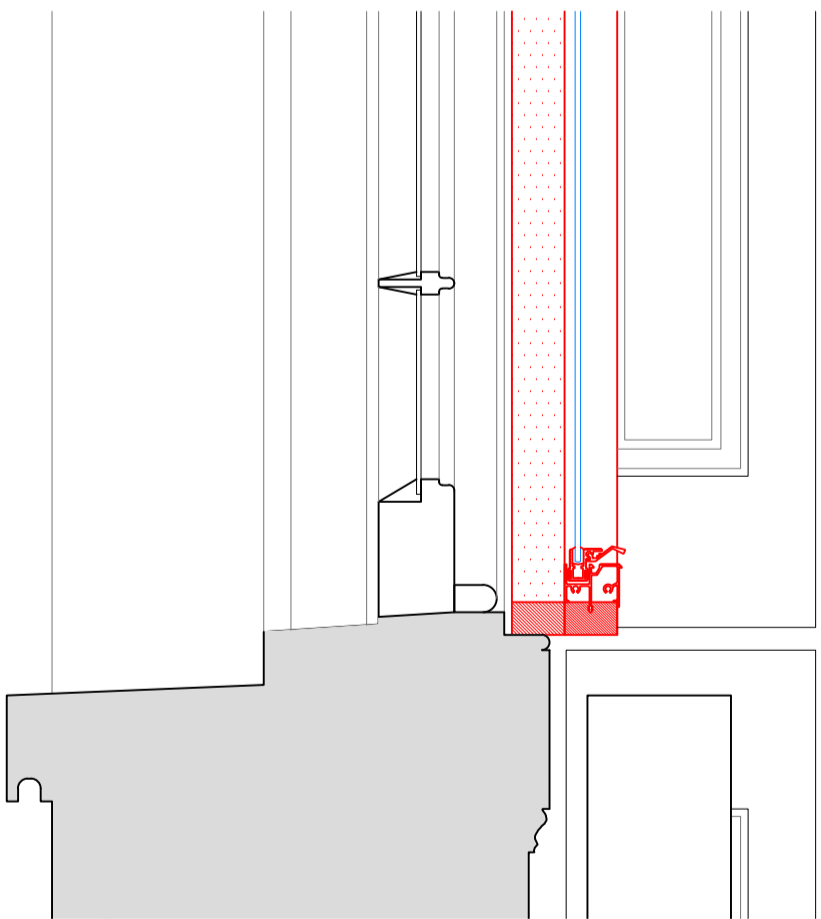

SECONDARY GLAZING SHOWN IN RED FOR VISUAL CLARITY ONLY

Revision	Date	Amendment
1.0	14-03-2019	Issued for listed building consent application

Do not reproduce this drawing without written permission
All dimensions are in millimetres unless stated otherwise

Drawing Not For Construction

HS2

High Speed (HS2) Limited
1st-3rd Floor
The Podium
1 Eversholt Street
London NW1 2DN

COSTAIN SKANSKA

Costain Skanska Joint Venture
9th Floor
The Tower
1 Eversholt Street
London NW1 2DN

Site Address: 41 A Morningside Terrace, London NW1		
Drawing Title: Ground Floor - Lounge: PROPOSED Secondary Glazing Details - Sheet 3 of 3		
Surveyed by: AP & PB	Drawn by: AP	Checked by: OB
Date: 07-03-2019	Drawing No: WPI P066 NI - 41A MT-PR-GF-J-02.2	Revision: 1.0