


PRESENTED TO
28 MAR 1938
TOWN PLANNING AND BUILDING
REGULATION COMMITTEE.

ARCHITECTS DEPT
10 MAR 1938 041158


REGD No. 4517

DRAWN BY
S. WHEELER
(Sd) E. P. WHEELER
Superintending Architect
25/3/38
WROUGHT IRON
BALUSTRADE

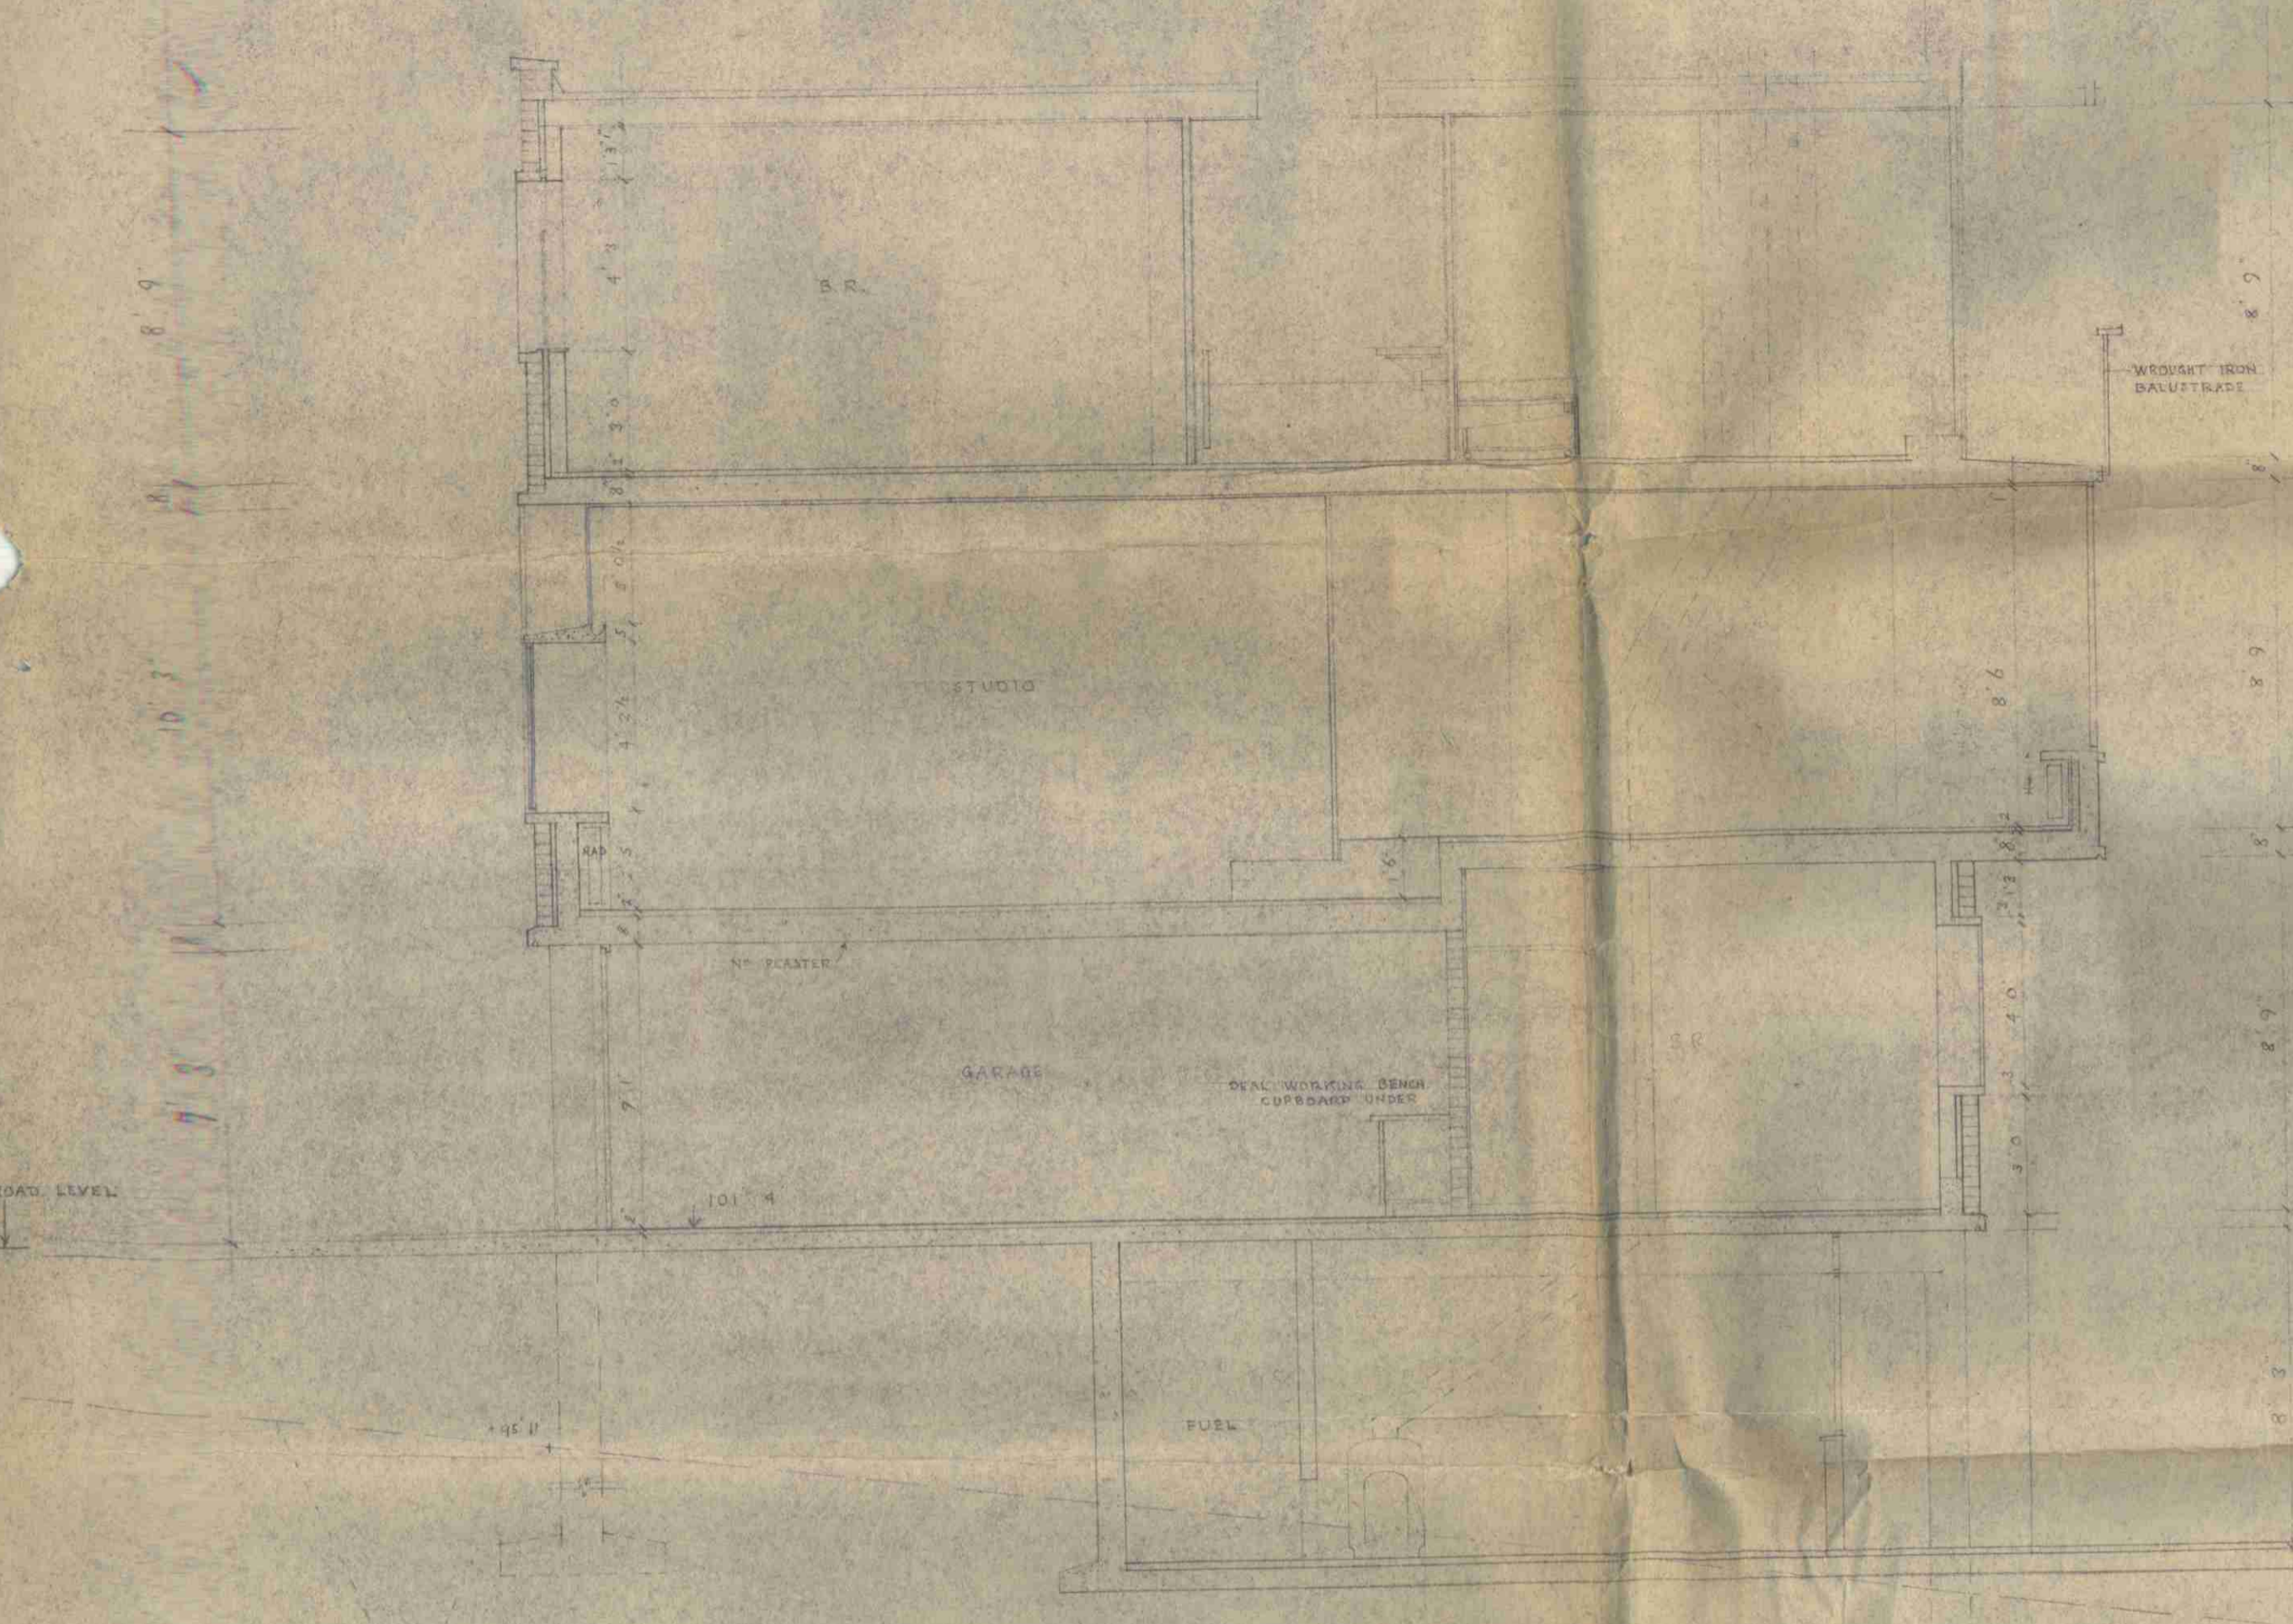

SECTION ~~BB~~ A-A

PARTY WALL
1" SCALE SECTION OF PARTY
WALL AT Y-Y

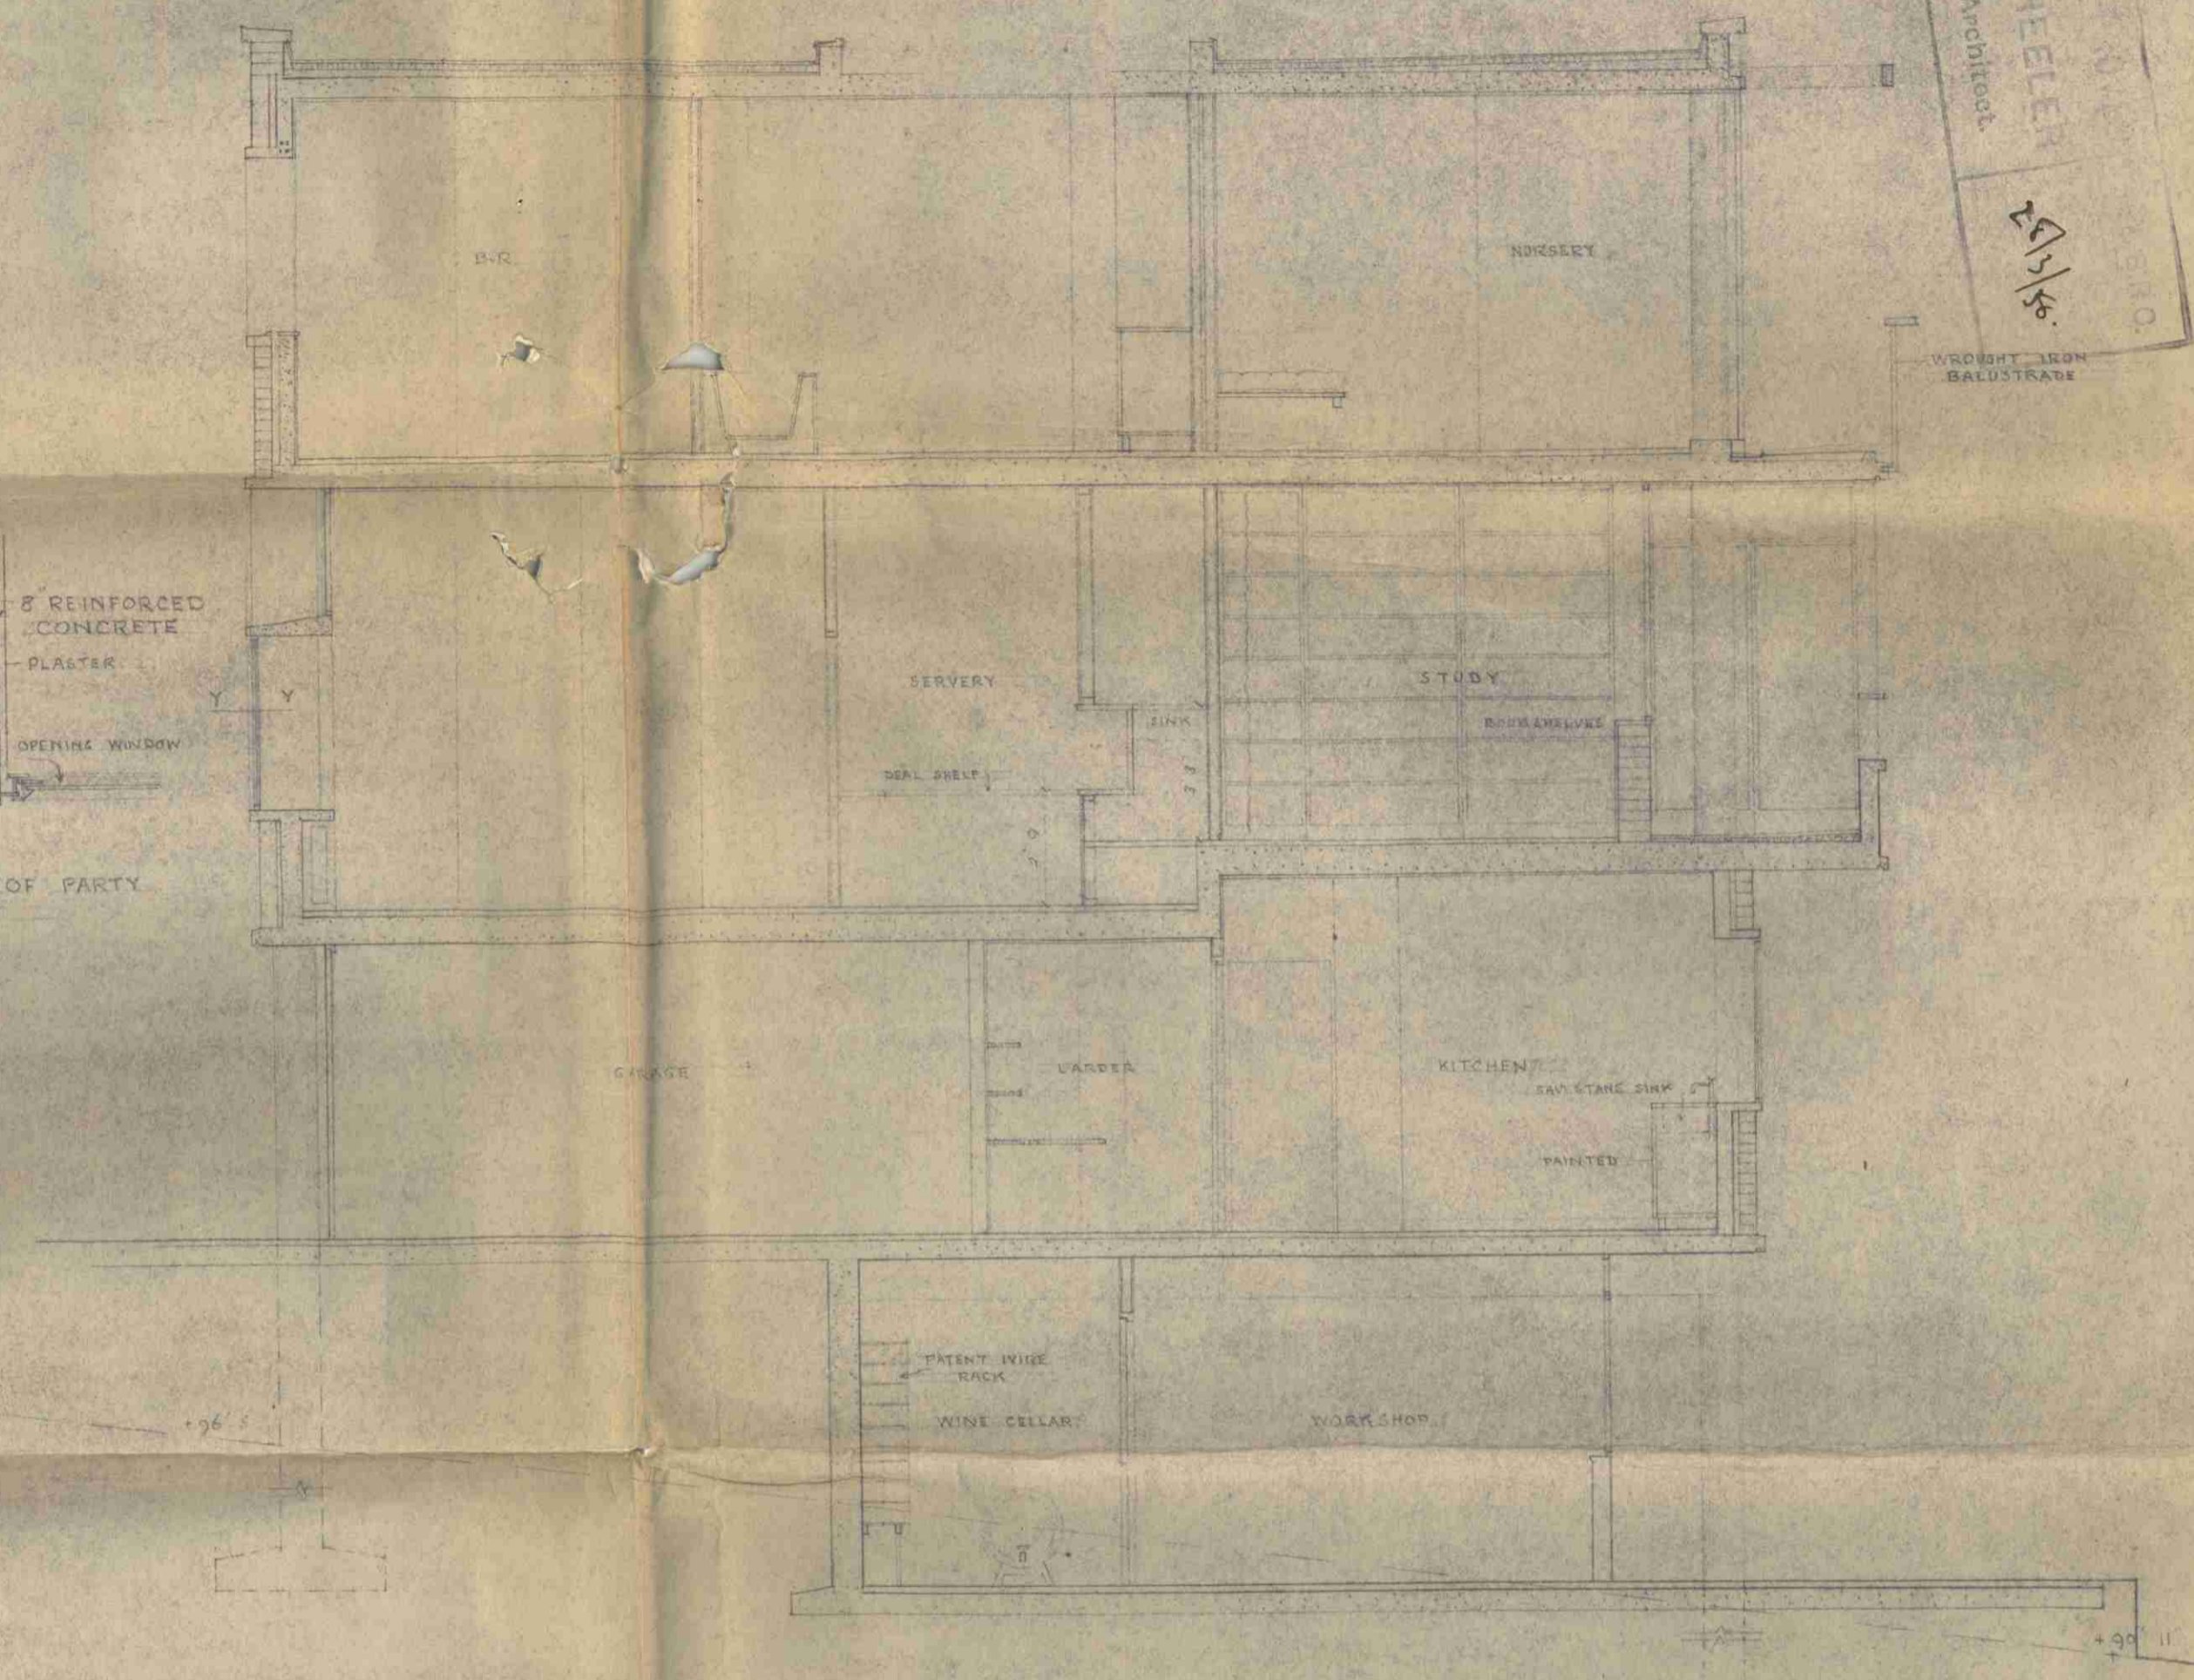

SECTION ~~CC~~ B-B

NWR 39
CLIENT: CONTEMPORARY CONSTRUCTION LTD
JOB: 1-4 WILLOW ROAD, HAMPSTEAD
DRAWING: SECTIONS: CENTRAL HOUSE
SCALE: 1/4" = 1'-0"
DRAWN BY: R.S.T.
CHECKED BY:
DATE: 1.3.38
ERNÖ GOLDFINGER, O.P.L.G.
GERALD FLOWER, A.R.L.B.A. ARCHITECTS,
7, BEDFORD SQUARE, LONDON, W.G.I.