

**TYPE A REMOVAL OF LOW LEVEL HORIZONTAL TRUNKING ELEMENT**

**TYPE A1 REMOVAL OF LOW LEVEL VERTICAL TRUNKING ELEMENT**

**TYPE B - REMOVAL OF HIGH LEVEL VERTICAL TRUNKING ELEMENT**


-SOCKETS+ DATA POINTS TO BE RECESSED AND SET @100MM CENTER LINE FROM SKIRTING LEVEL

See the method statements at the back of this document for details of making good the lath & plaster and decorative plaster in materials to match existing following the chasing in of the cabling during these works.

11MS/2/004 - AS BUILT CONDITION




North Elevation - Type A,A1


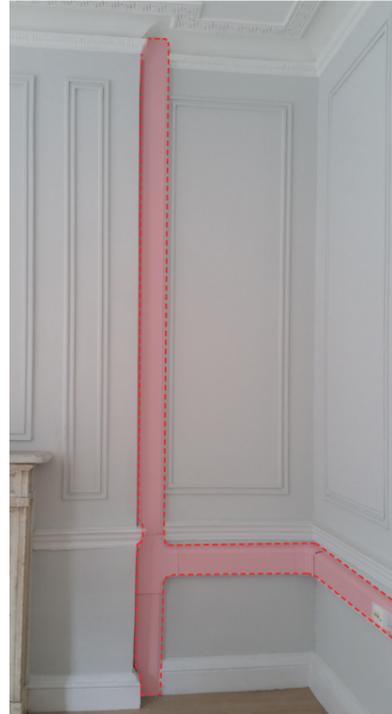


North Elevation - Type B  
(Plus work required to adjoining east wall)

11MS/2/004 - AS PROPOSED

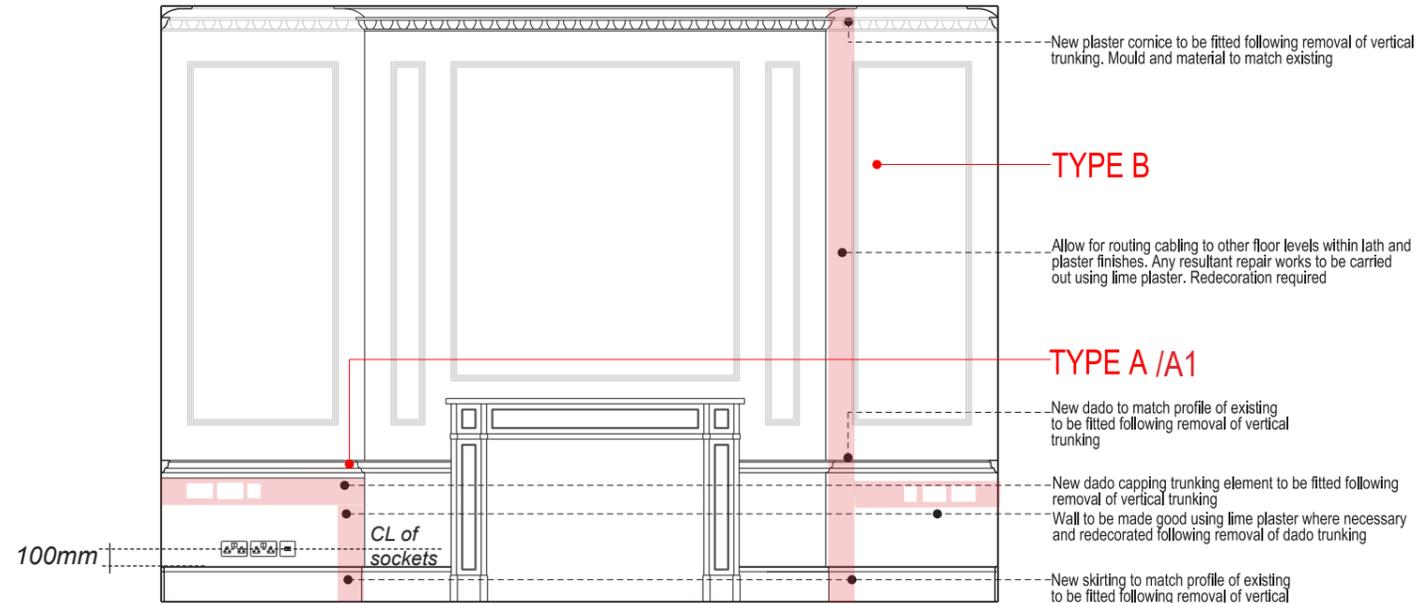

11MS/2/004 North Elevation - Additional Works Type A & Type B

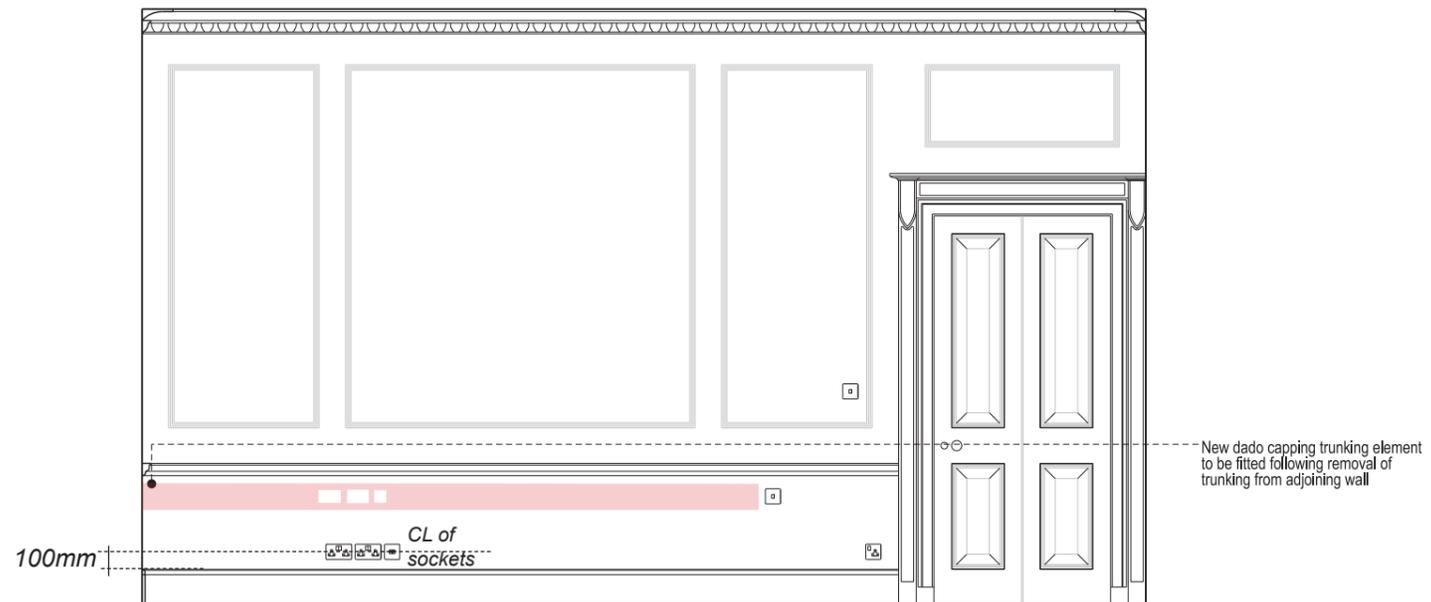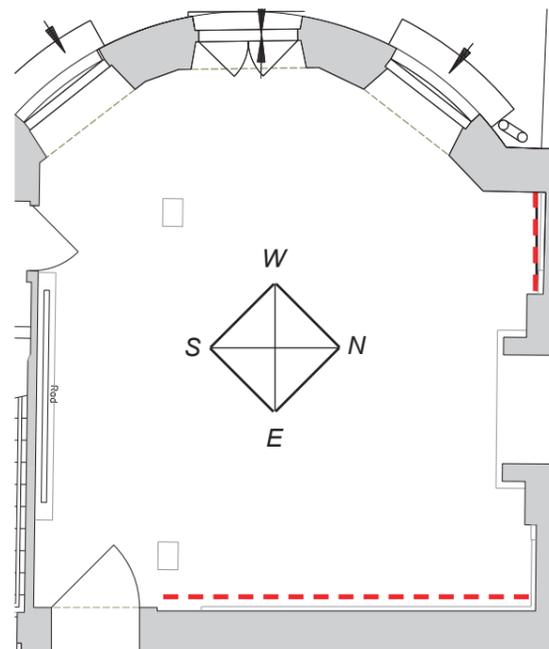

11MS/2/004 East Elevation - Additional Works  
(Work required in conjunction with Type A)

THE BRITISH MUSEUM

**BDP.**

16 Brewhouse Yard  
Clerkenwell  
London EC1V 4LJ  
United Kingdom  
T +44 (0)20 7812 8000  
F +44 (0)20 7812 8399  
www.bdp.com

PROJECT TITLE  
British Museum  
Perimeter Properties Refurbishment

PROJECT NUMBER  
P2002323

PROJECT TITLE  
Additional works  
Type A, A1, B  
Removal of horizontal /vertical  
trunking

SCALE  
Varies@A3

DATE  
14/06/2019

ISSUE NO.  
(70)AD002