

TYPE C REMOVAL OF LOW LEVEL BOXING & TRUNKING
 SOCKETS+ DATA POINT TO BE RECESSED AND SET @100MM CENTER LINE FROM SKIRTING LEVEL

See the method statements at the back of this document for details of making good the lath & plaster and decorative plaster in materials to match existing following the chasing in of the cabling during these works.

11MS/2/004 - AS BUILT CONDITION




South Elevation - Type C

11MS/2/004 - AS PROPOSED




11MS/2/004 South Elevation Additional Works Type C

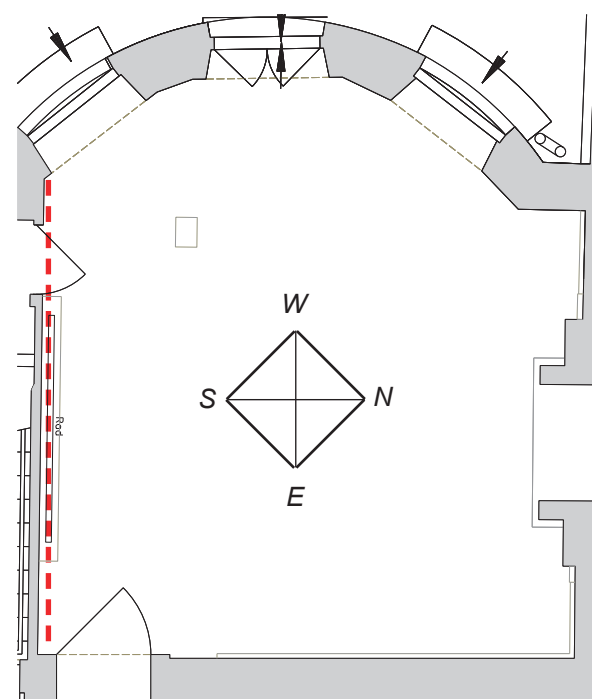

--- Trunking Removed

11MS/2/004 - Key Plan

	
	
16 Brewhouse Yard Clerkenwell London EC1V 4LJ United Kingdom T +44 (0)20 7812 8000 F +44 (0)20 7812 8399 www.bdp.com	
PROJECT TITLE British Museum Perimeter Properties Refurbishment	
PROJECT NUMBER P2002323	
PROJECT TITLE Additional works Removal of low level boxing & trunking	SCALE Varies@A3
DRAWING NO. (70)AD004	DATE 14/06/2019
	REVISION -