

TYPE C1- REMOVAL OF LOW LEVEL TRUNKING ABUTTING FIREPLACE

SOCKETS+ DATA POINT TO BE RECESSED AND SET @100MM CENTER LINE FROM SKIRTING LEVEL

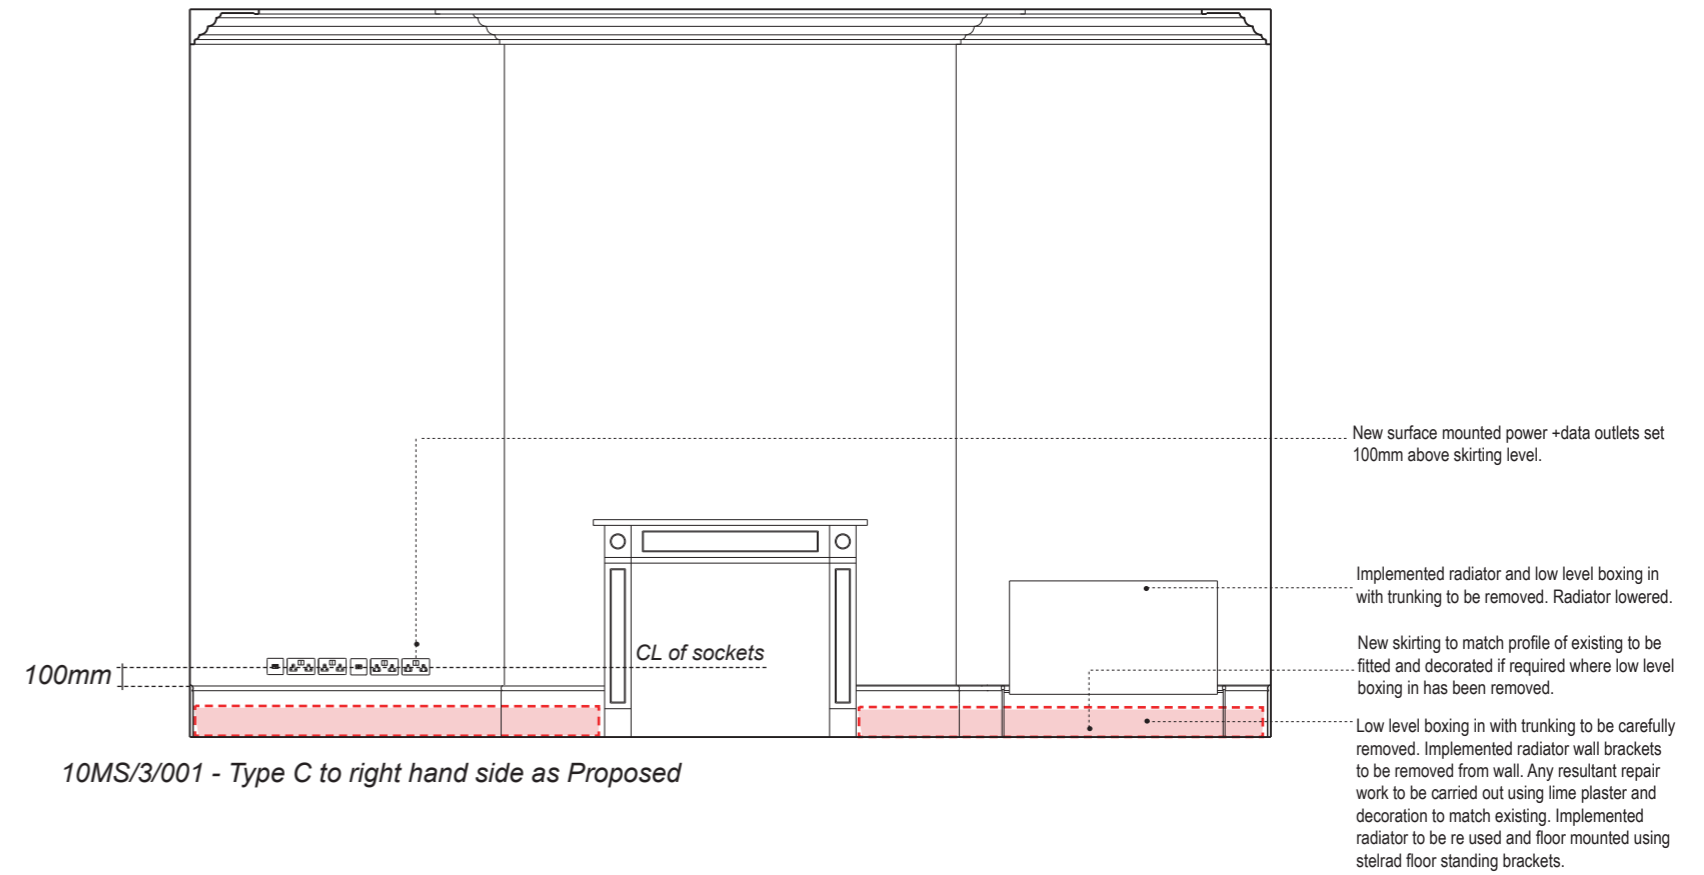
See the method statements at the back of this document for details of making good the lath & plaster and decorative plaster in materials to match existing following the chasing in of the cabling during these works.

10MS/3/001 - AS BUILT CONDITION





North Elevation - Type C

10MS/3/001 - AS PROPOSED



10MS/3/001 - Type C to right hand side as Proposed

| | |
|-----------------------------------------------------------------------------------------------------------------------------------------------------|-----------------------------------------------------------------------------|
|  | |
|  | |
| <p>16 Brewhouse Yard Clerkenwell London EC1V 4LJ United Kingdom T +44 (0)20 7812 8000 F +44 (0)20 7812 8399 www.bdp.com</p> | |
| <p>PROJECT TITLE British Museum Perimeter Properties Refurbishment</p> | |
| <p>PROJECT NUMBER P2002323</p> | |
| <p>DESCRIPTION Additional works Type C1 Removing of low level trunking abutting the fireplace</p> | <p>SCALE Varies@A3</p> <p>DATE 14/06/2019</p> <p>REVISION -</p> |
| <p>CLIENT (70)AD005</p> | |