



TYPE D - REMOVAL OF MODERN LIGHTING FROM DECORATIVE CEILING

See the method statements at the back of this document for details of making good the lath & plaster and decorative plaster in materials to match existing.

11MS/3/001 - AS BUILT CONDITION

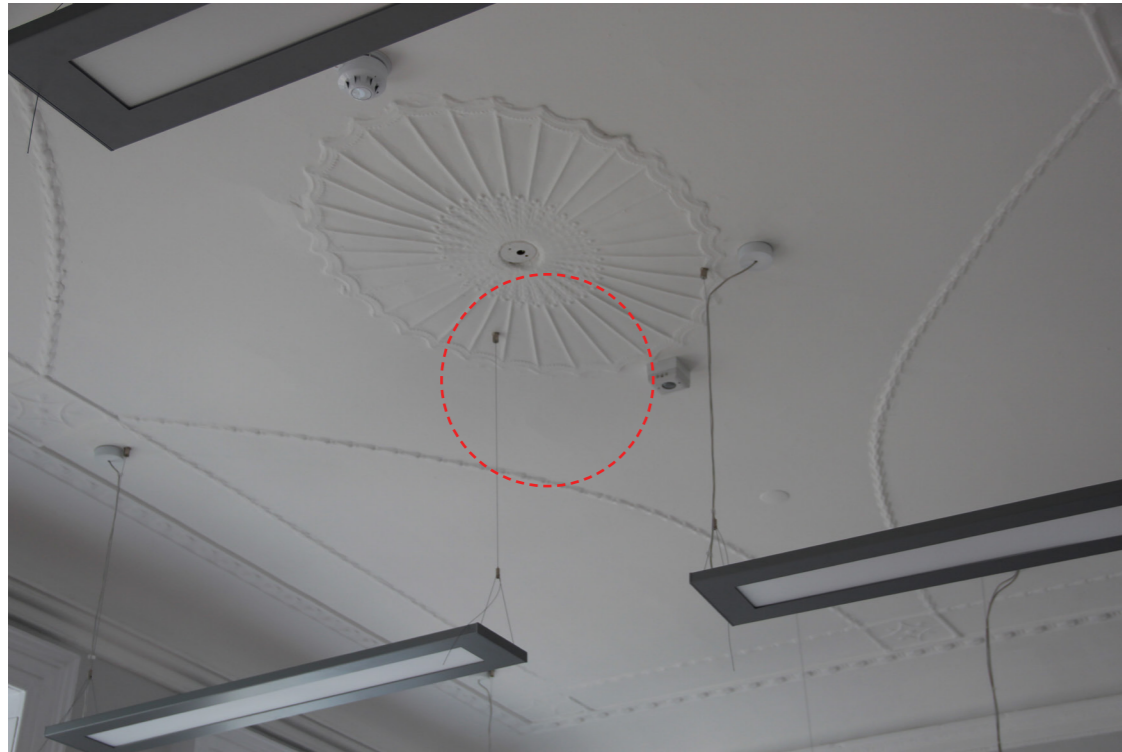

11MS/3/001 - Reflected Ceiling Plan - As Built Condition

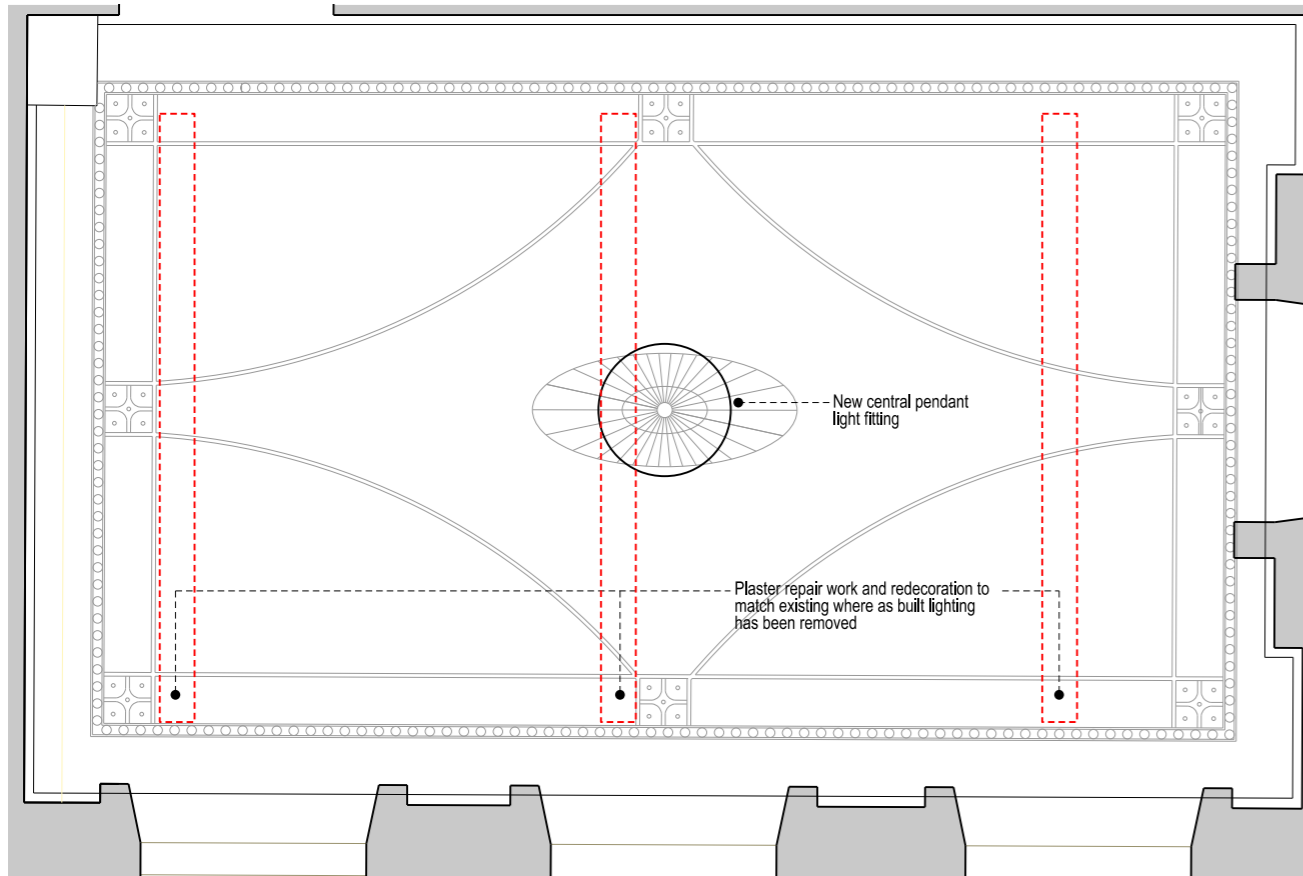



11MS/3/001 Reflected Ceiling Plan - Additional Works Type D

11MS/3/001 - PROPOSED CEILING LANTERN



Manufacturer: Franklite Montagu 4
 Type: Ceiling Lantern
 Ref: LA7009/4
 Control: non dimming
 Colour Temperature 3000k
 Diameter: 315mm
 Finish: Brass
 Supplier : www.Oceanlighting.co.uk
 Provide 4NO SES/E14 LED candle filament lamps. 4.5W 470lm warm white

	
	
16 Brewhouse Yard Clerkenwell London EC1V 4LJ United Kingdom T +44 (0)20 7812 8000 F +44 (0)20 7812 8399 www.bdp.com	
PROJECT TITLE British Museum Perimeter Properties Refurbishment	
PROJECT NUMBER P2002323	
DESCRIPTION Additional works Type D Removal of modern lighting from decorative ceiling	SCALE Varies@A3 DATE 14/06/2019 DRAWN BY -
DRAWING NO. (70)AD006	