



TYPE F - REDUCTION OF RISERS FROM CORNER

See the method statements at the back of this document for details of making good the lath & plaster and decorative plaster in materials to match existing.


10MS/2/S02 - STAIR LOBBY - AS BUILT CONDITION

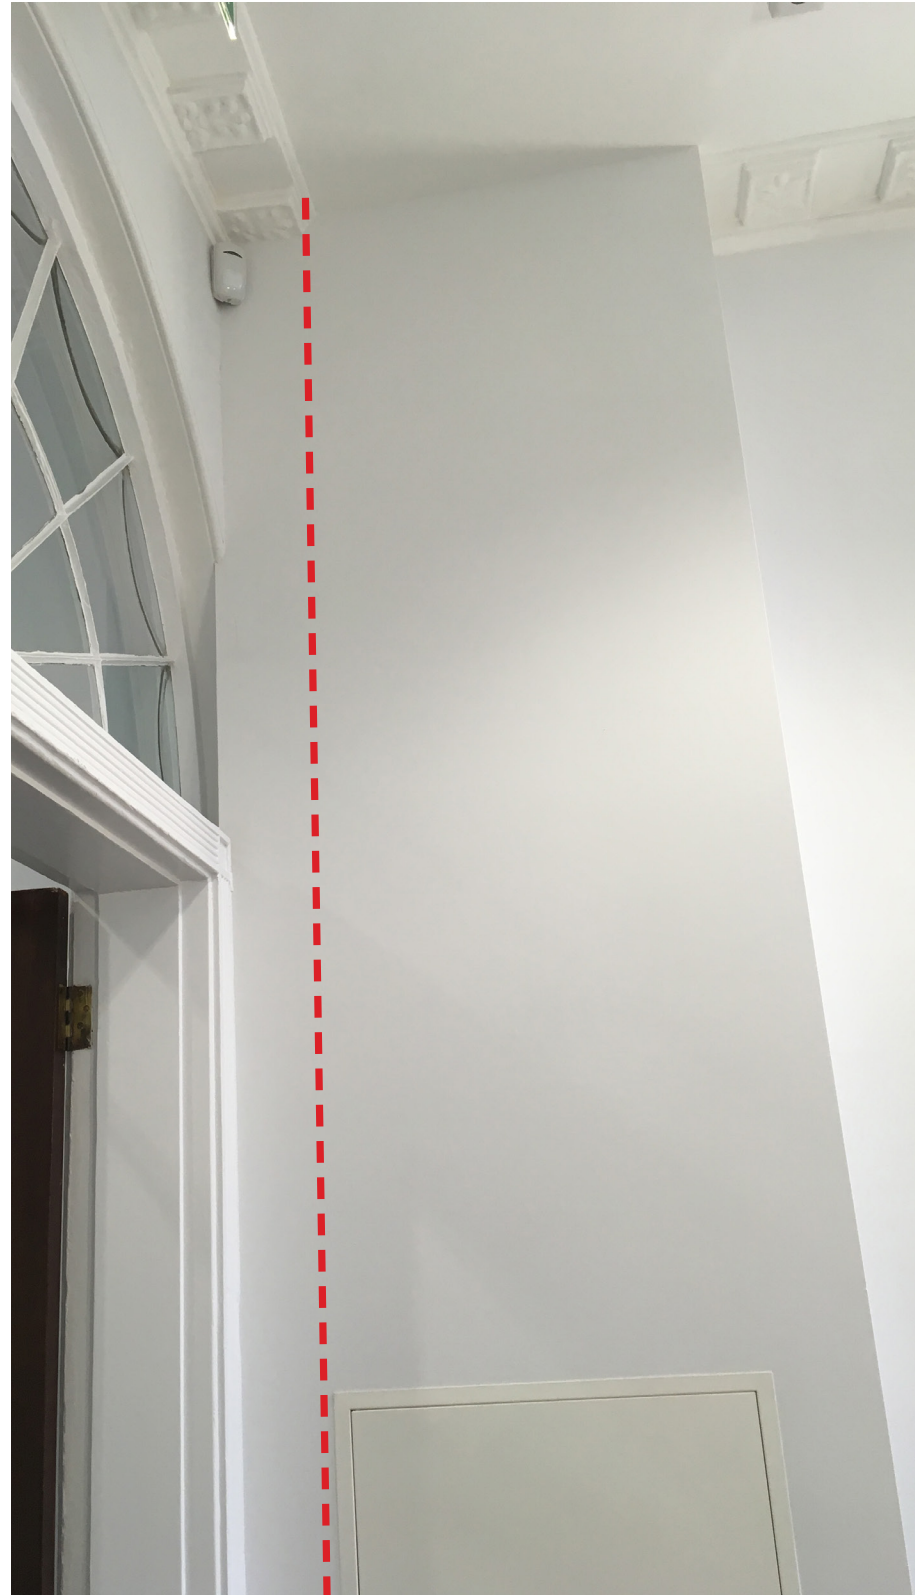


10MS/2/S02 - STAIR LOBBY - AS PROPOSED

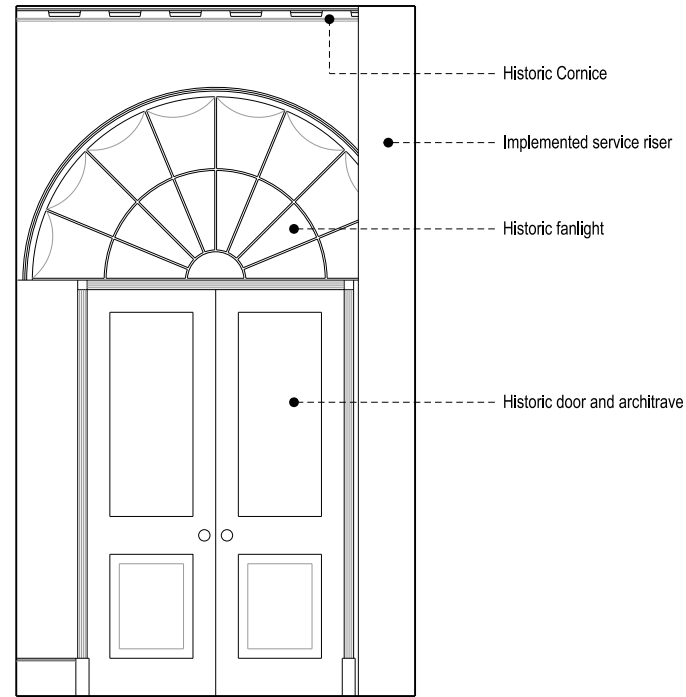


8MS/2/S02 East Elevation

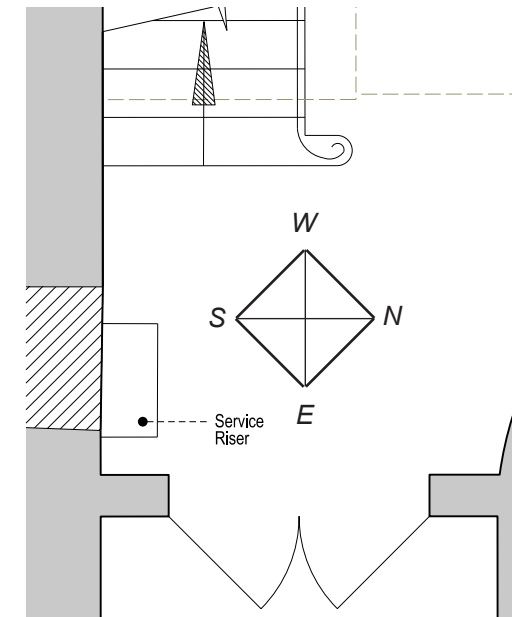

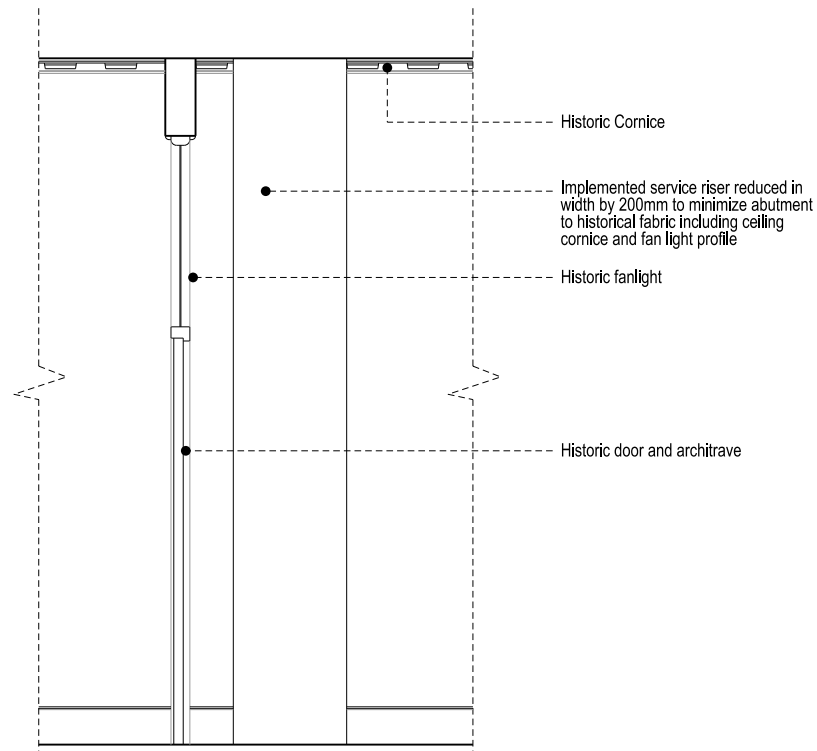

8MS/2/S02 Plan

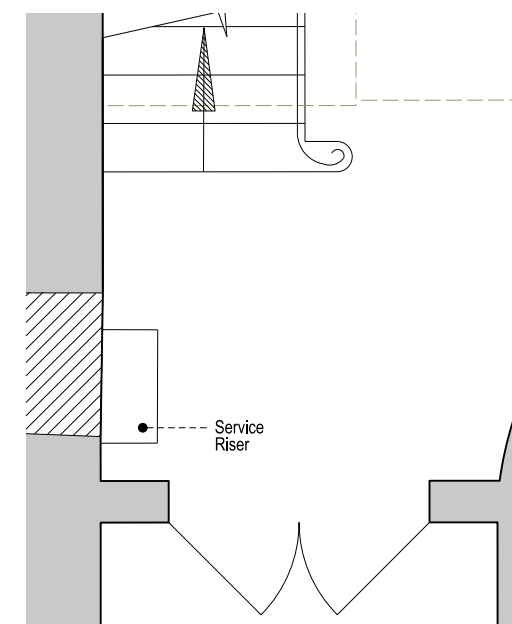

8MS/2/S02 South Elevation



8MS/2/S02 Alternative riser layout should more space be required for implemented services

	
	
<p>16 Brewhouse Yard Clerkenwell London EC1V 4LJ United Kingdom T +44 (0)20 7812 8000 F +44 (0)20 7812 8399 www.bdp.com</p>	
<p>PROJECT TITLE British Museum Perimeter Properties Refurbishment</p>	
<p>PROJECT NUMBER P2002323</p>	
<p>DESCRIPTION Additional works Type F Reduction of risers from corner</p>	<p>SCALE Varies@A3</p>
<p>DATE (70)AD009</p>	<p>DATE 14/06/2019</p>