




**TYPE H - REMOVE BOXING AT HIGH LEVEL**



See the method statements at the back of this document for details of making good the lath & plaster and decorative plaster in materials to match existing.

**9MS/3/001 OFFICE - AS BUILT CONDITION**

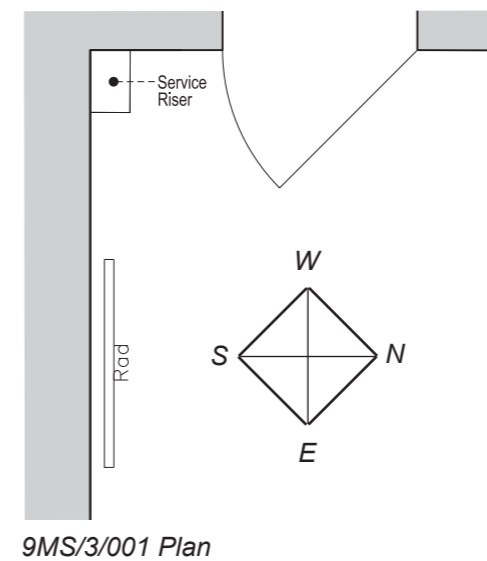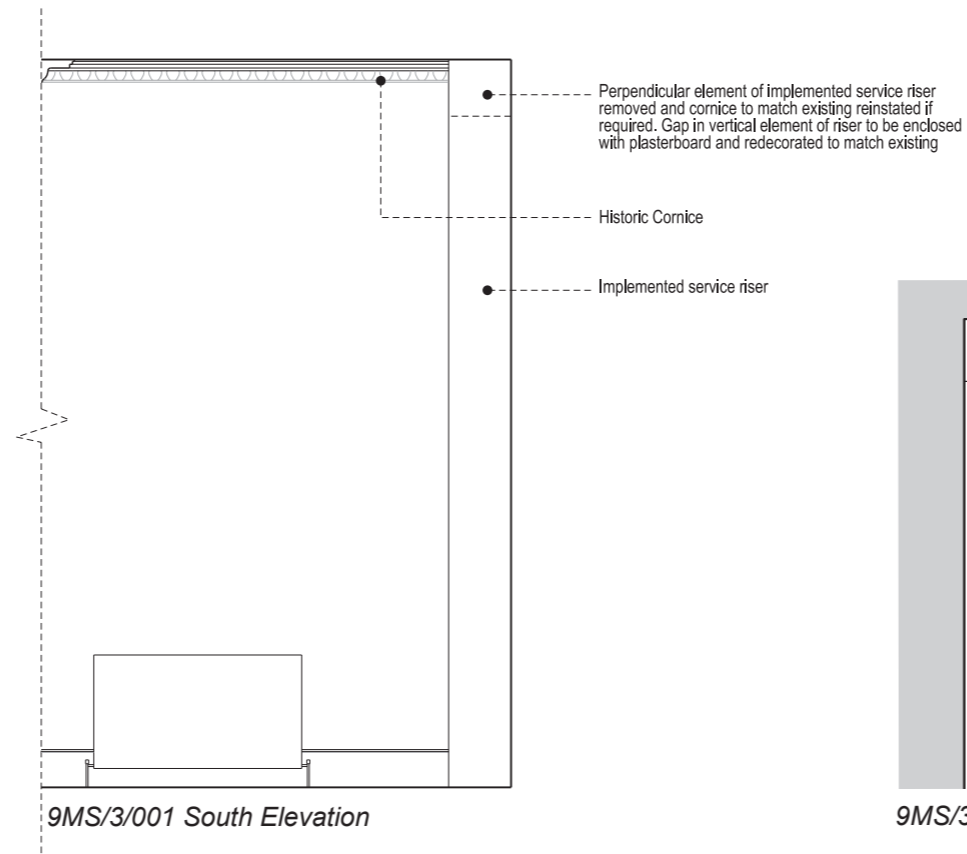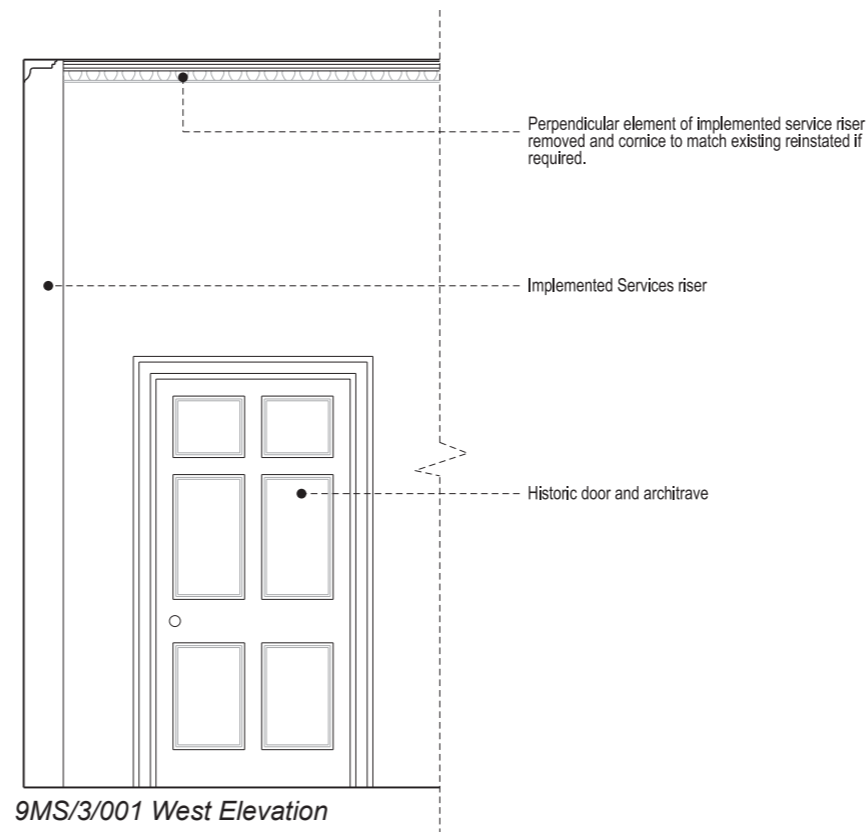

**9MS/3/001 OFFICE - AS PROPOSED CONDITION**



	
	
<p>16 Brewhouse Yard Clerkenwell London EC1V 4LJ United Kingdom T +44 (0)20 7812 8000 F +44 (0)20 7812 8399 www.bdp.com</p>	
<p>PROJECT TITLE <b>British Museum Perimeter Properties Refurbishment</b></p>	
<p>PROJECT NUMBER <b>P2002323</b></p>	
<p>DESCRIPTION Additional works Type H Remove boxing at high level</p>	<p>SCALE Varies@A3</p> <p>DATE 14/06/2019</p>
<p>CLIENT (70)AD010</p>	<p>REVISION -</p>