


11B

Scale 1:200

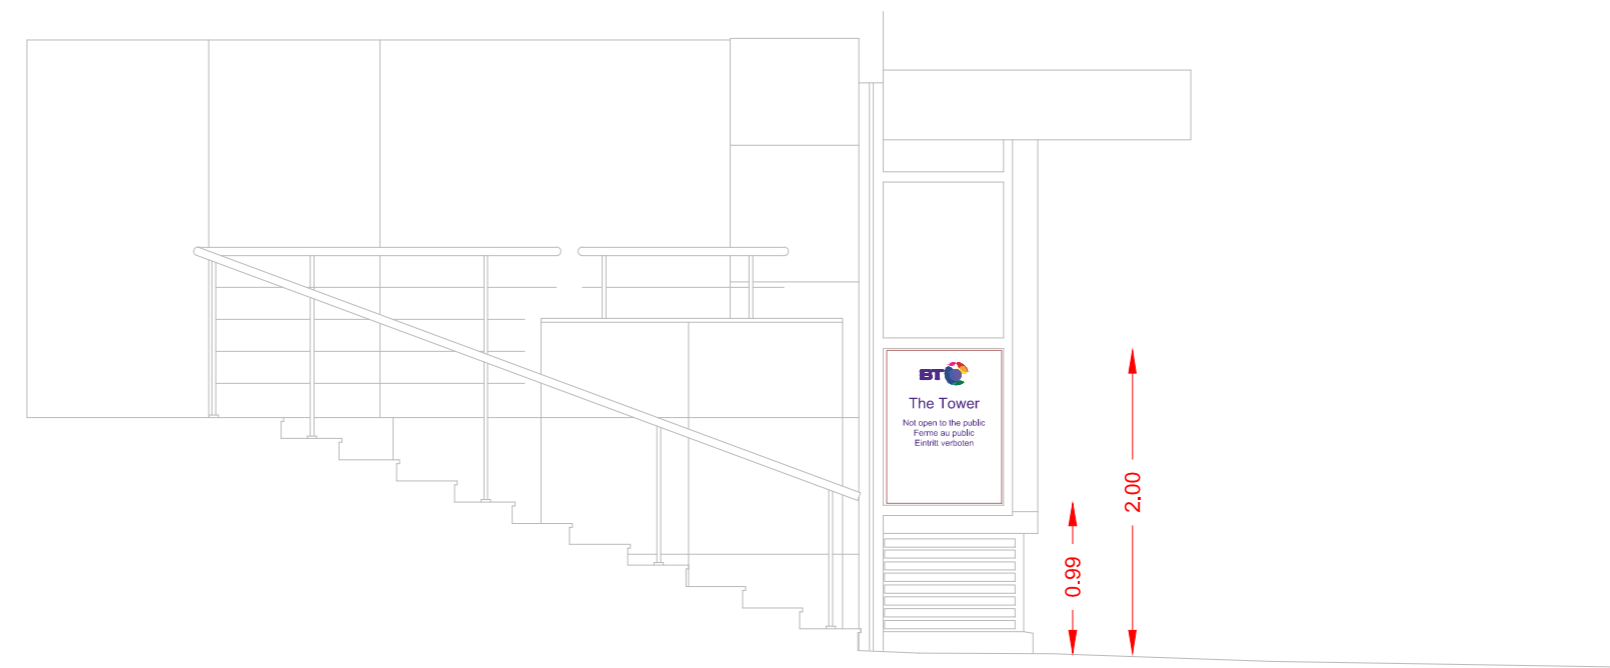

EXISTING ELEVATION ITEM 11B  
MAPLE STREET


Scale 1:50



EXISTING  
MAPLE STREET

**Murphy Surveys Ltd. Disclaimer**  
The user or recipient of this survey data understands and acknowledges this data may be inaccurate or contain errors or omissions and the user or recipient assumes full responsibility for any risks or damages resulting from, arising from, or in connection with any use of, or reliance upon data displayed herein. Although significant care has been exercised to produce surveys that satisfy survey accuracy standards, these surveys are only as accurate as the source data from which they were compiled. Although all reasonable steps have been taken to locate all features visible at the time of the survey, there is no guarantee that all will be shown on the drawing, as some above ground features may have obstructed the survey. Wherever possible, areas unable to be surveyed will be indicated as 'UTS'.  
The Company shall not be liable for any inaccuracy of the data provided beyond the specified scale or accuracy, or for any matters resulting from their use for purposes other than that stated in the Contract. No liability shall attach to the Surveyor in respect of any consequential loss or damages suffered by the Client.  
The Client must promptly notify the Company of any errors in mapping of which it becomes aware. If misleading, inaccurate or otherwise inappropriate information is brought to the Company's attention or the Company itself identifies any such inaccuracy or error in a survey, it shall use its reasonable endeavours to fix or remove it and if necessary in certain instances, the Company being on notice of any such misleading, inaccurate or otherwise inappropriate information, it will re-conduct the survey and reproduce the data to within the specified scale or accuracy.

Revisions				
Rev	Description	Surveyed by	Drawn by	Checked by
1	First Issue	21-10/2019	21-10/2019	TMD-20/2019

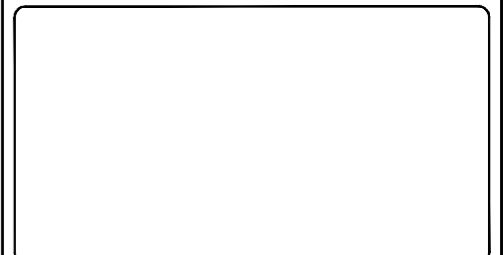

**murphy**  
SURVEYS  
GLOBAL CONSULTING SURVEYORS

Topographic surveys, Measured Building Surveys,  
Setting-Out, As-built Surveys, Hydrographic Surveys, Legal Mapping,  
Pipeline Surveys, Services Location, Ground Penetrating Radar,  
Laser Scanning, Aerial Photogrammetry

London Warrington Glasgow Belfast Cork Kildare

**UK Head Office**  
39-41 North Road London N7 9DP  
Phone: (+44) 0203 596 3775  
Email: info@murphysurveys.co.uk

[www.murphysurveys.co.uk](http://www.murphysurveys.co.uk)

Client	Cluttons
Project	BT Elevation Plans 60 Cleveland St, Fitzrovia, London W1T 4JZ
Site Address	Existing Elevation Item 11 Maple Street
Description	MSL Local Grid
Survey Grid	MSL Local Datum
Survey Datum	1:20 @ A2
Drawing Scale	MSL24583-W1T4JZ-011B-E
Drawing Number	