



This drawing is protected under Copyright and at no time must any portion of this drawing be reproduced or copied in anyway without the permission of Morgan Lovell.
All dimensions must be checked on site and NOT scaled from this drawing.

SUBJECT TO SITE SURVEY
CHECK SURVEY UNDERTAKEN ONLY
BUILDING PARAMETERS TAKEN FROM DRAWINGS PROVIDED
BUILDING PARAMETERS TAKEN FROM AS BUILT DRAWINGS PROVIDED

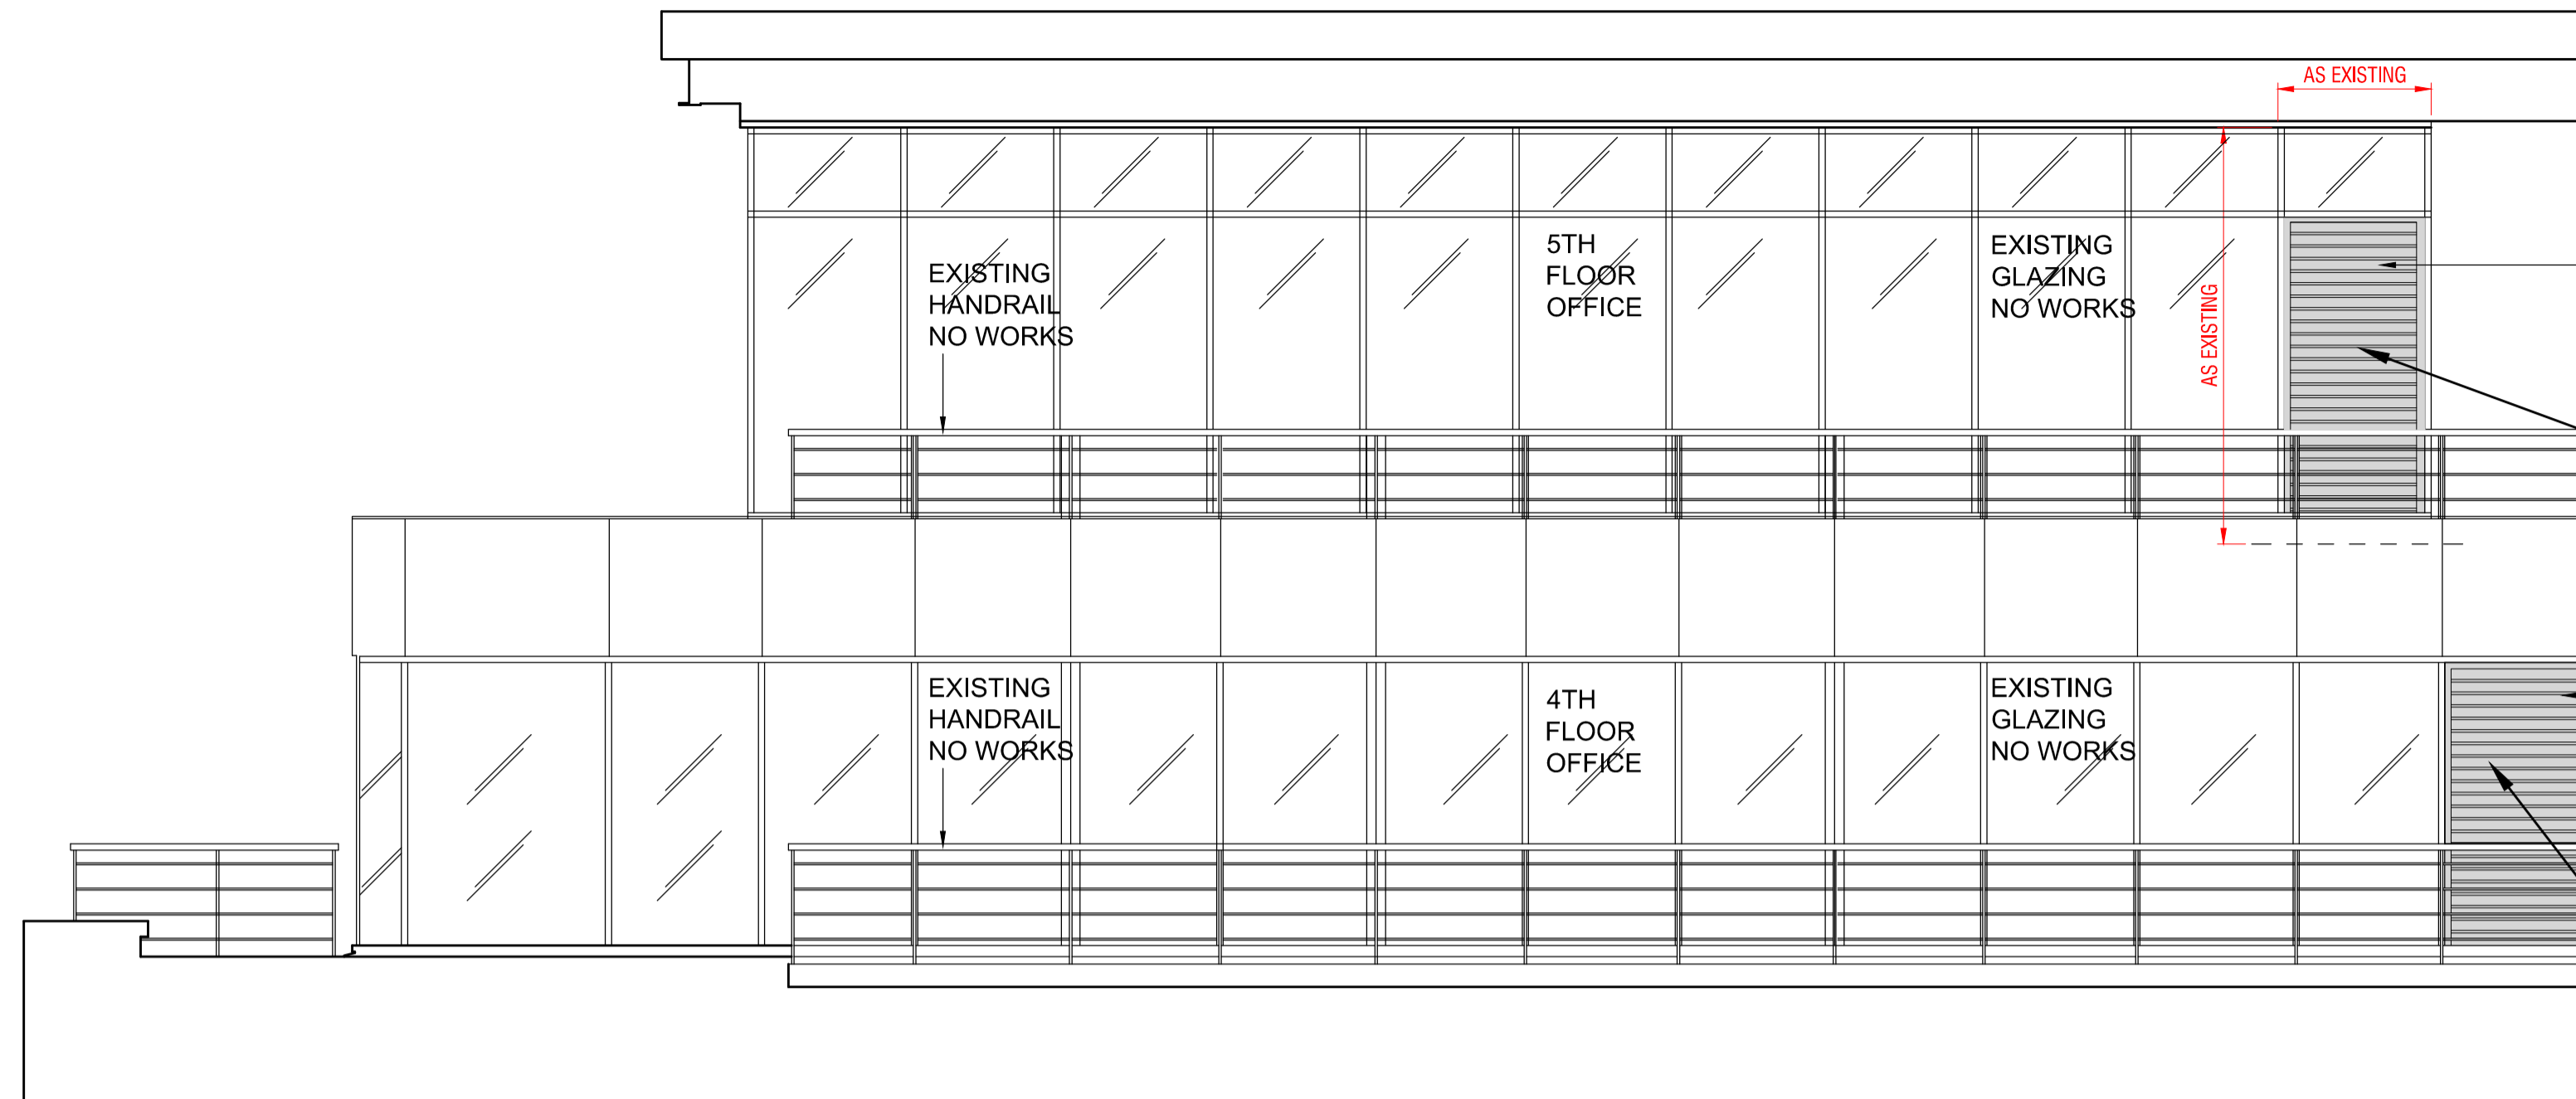


NEW FRESH AIR INTAKE LOUVRE, STYLE & COLOUR TO MATCH EXISTING LOUVRES


NEW FRESH AIR INTAKE LOUVRE, STYLE & COLOUR TO MATCH EXISTING LOUVRES

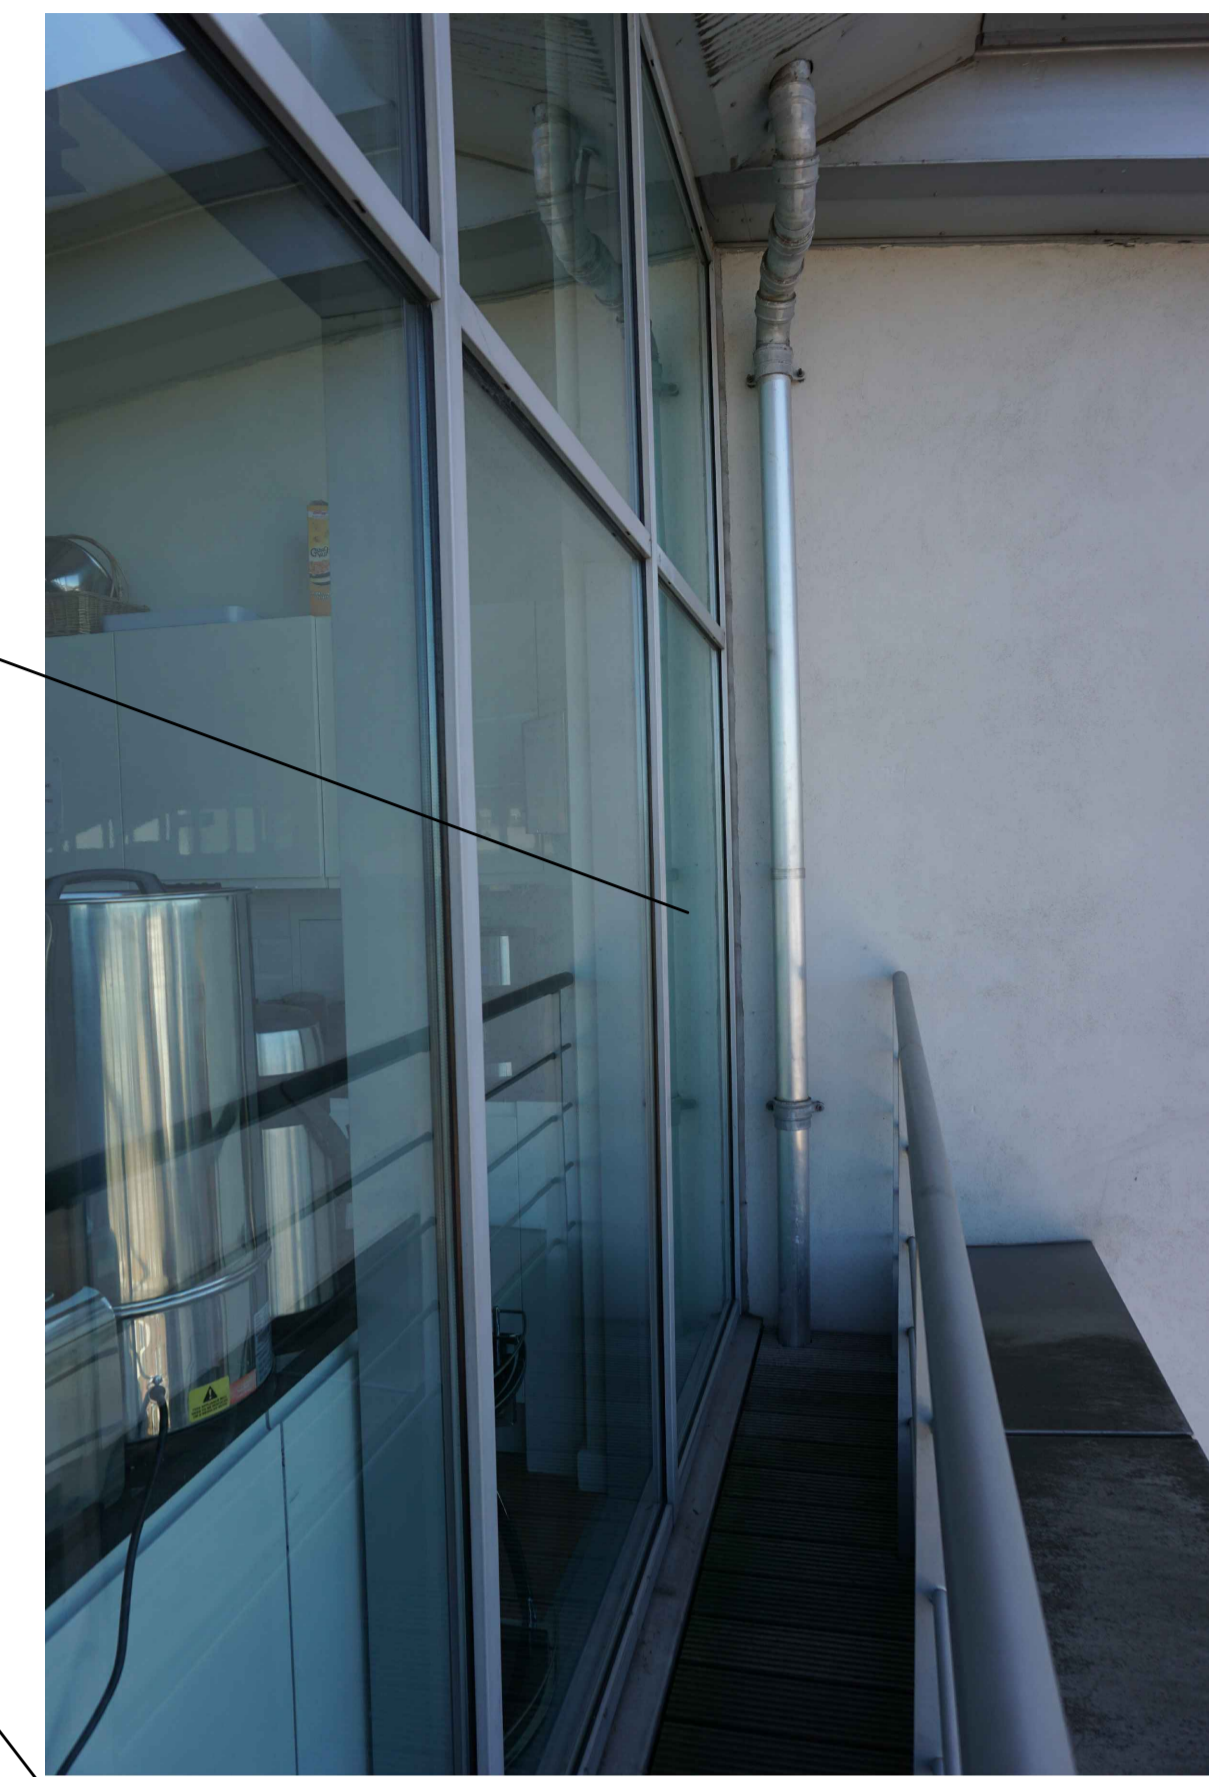


PROPOSED SIDE ELEVATION (C)
1:50@A1
0 1 2 3 4 5 metres

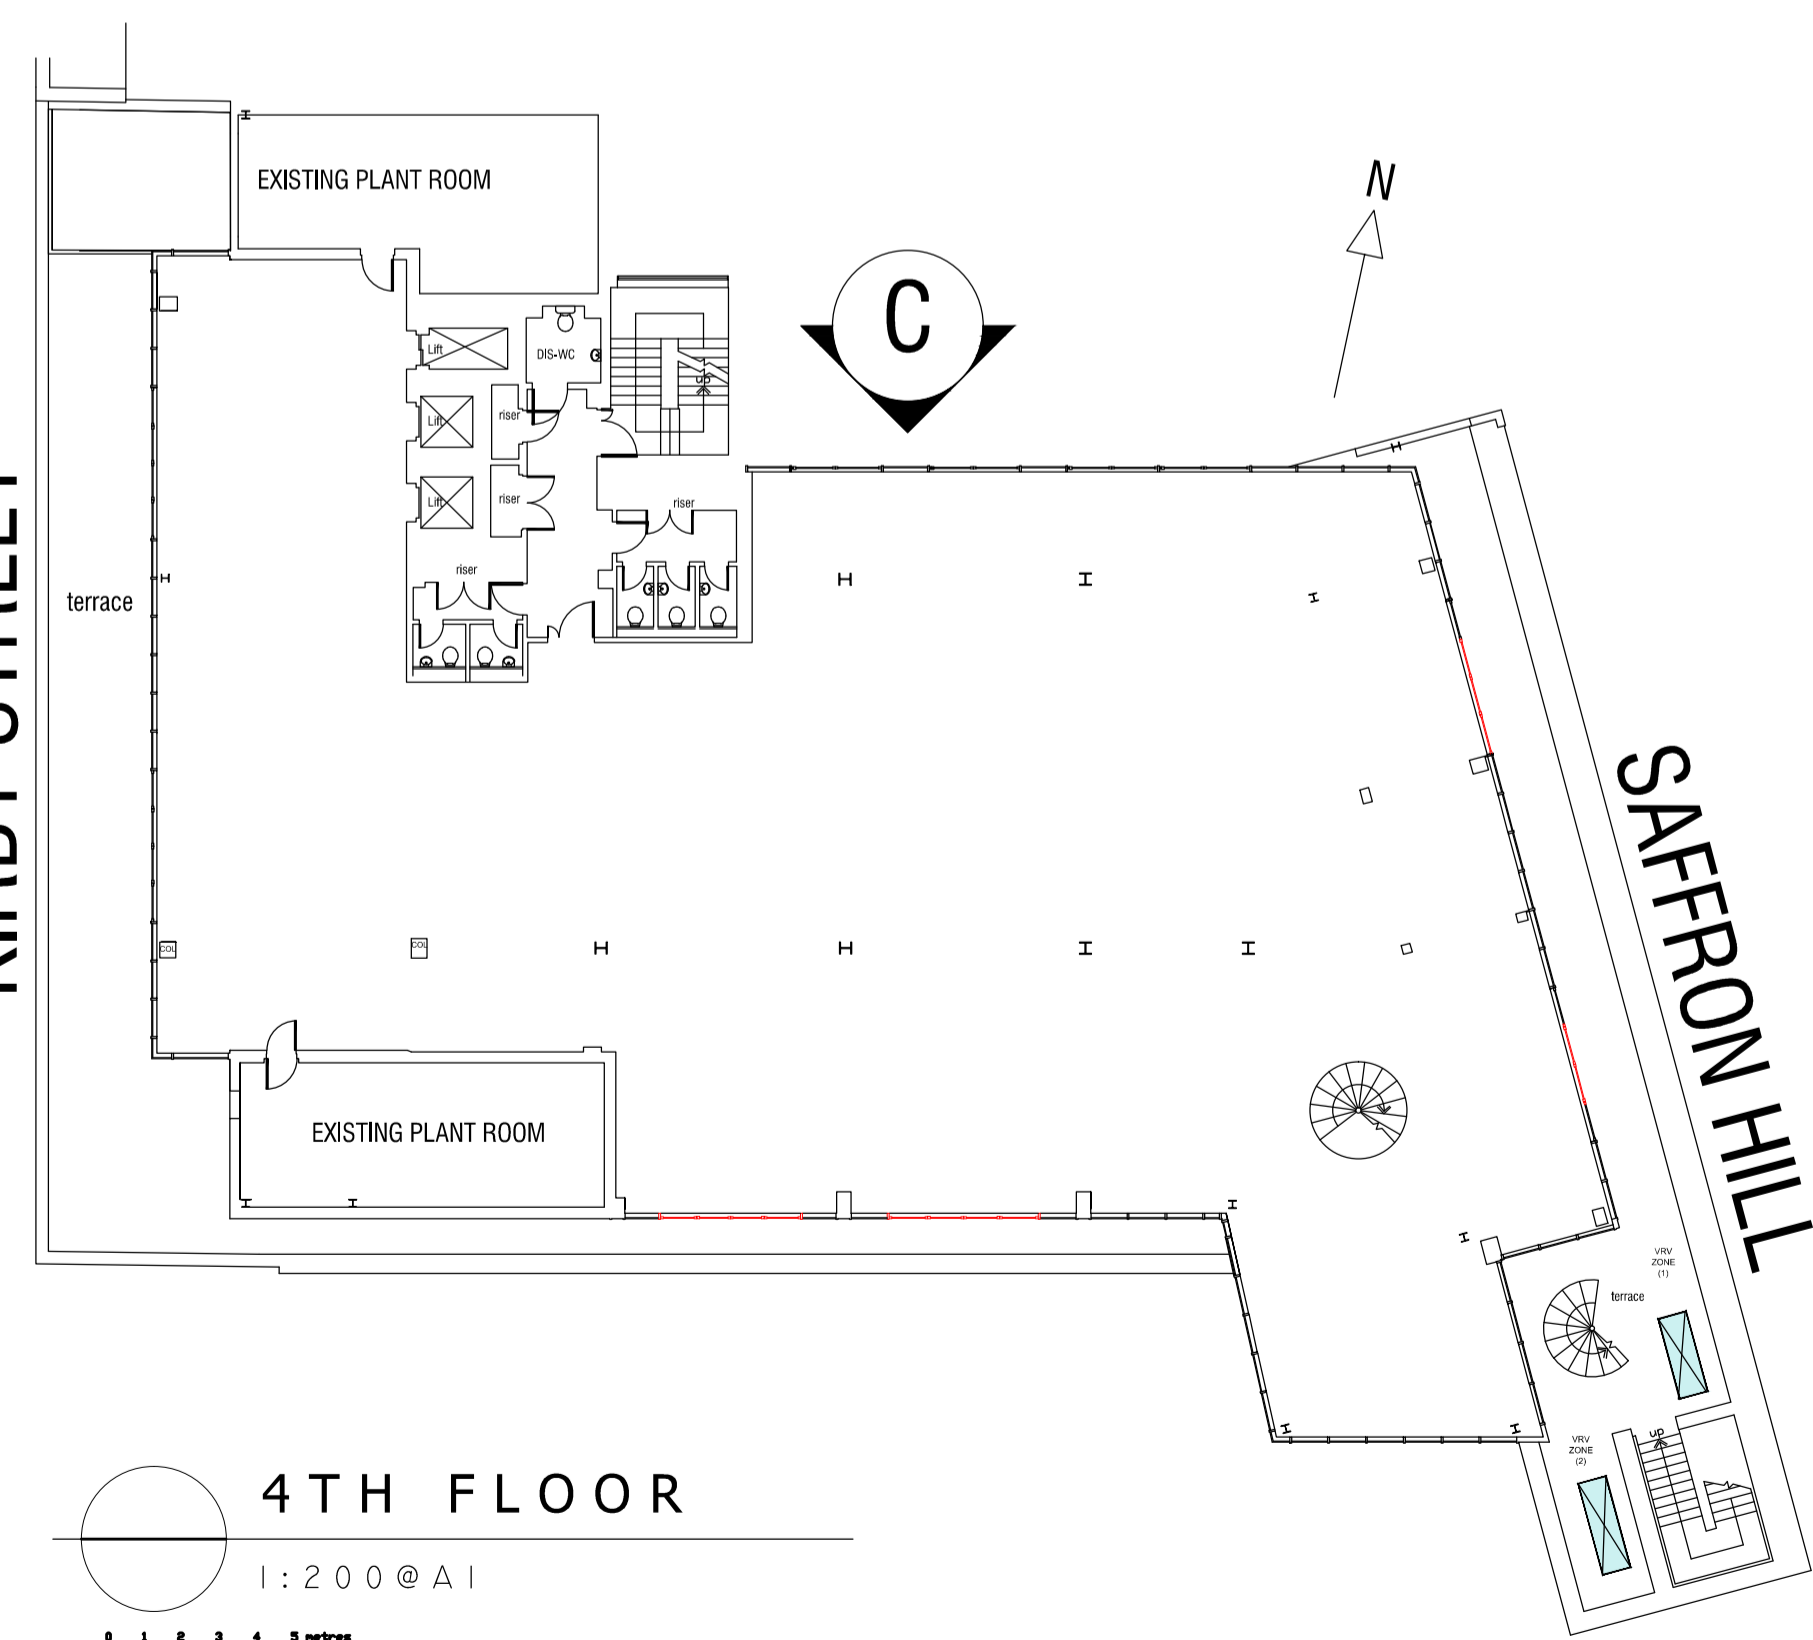

4TH FLOOR
1:200@A1
0 1 2 3 4 5 metres

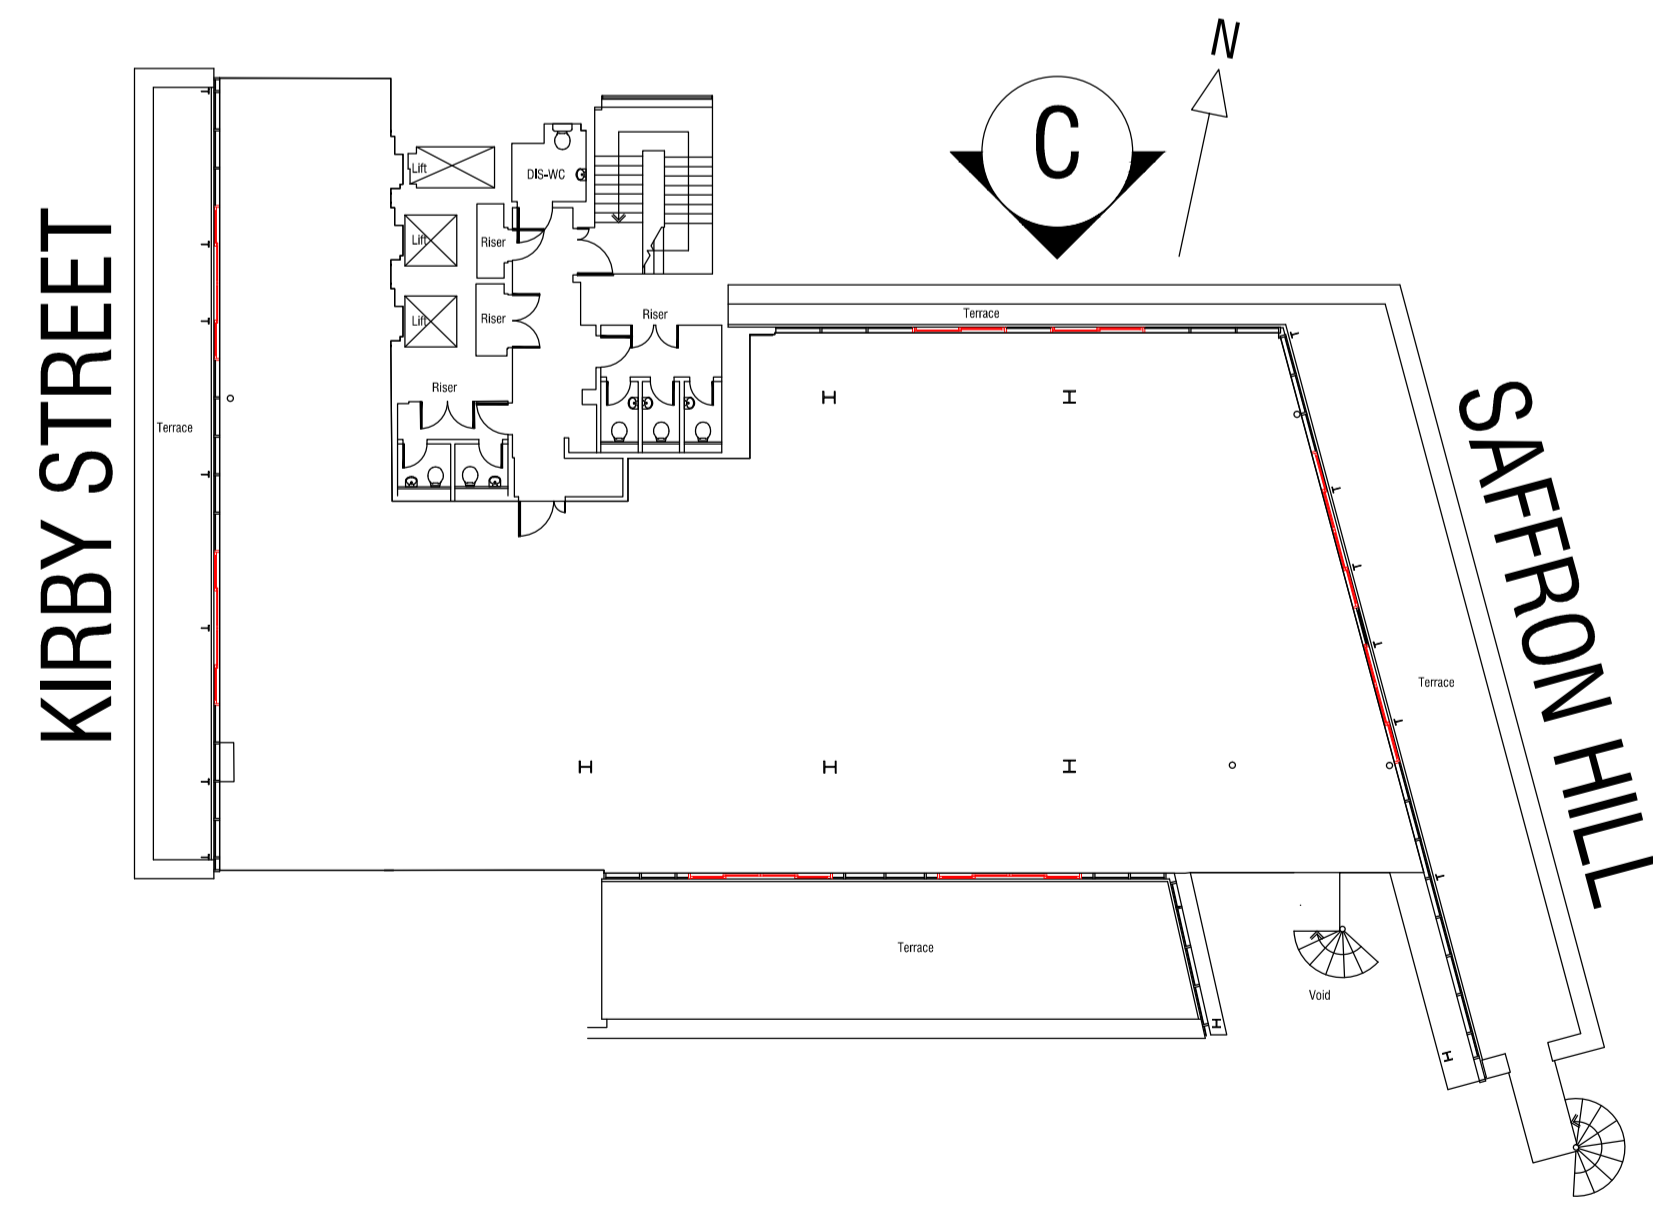

5TH FLOOR
1:200@A1
0 1 2 3 4 5 metres

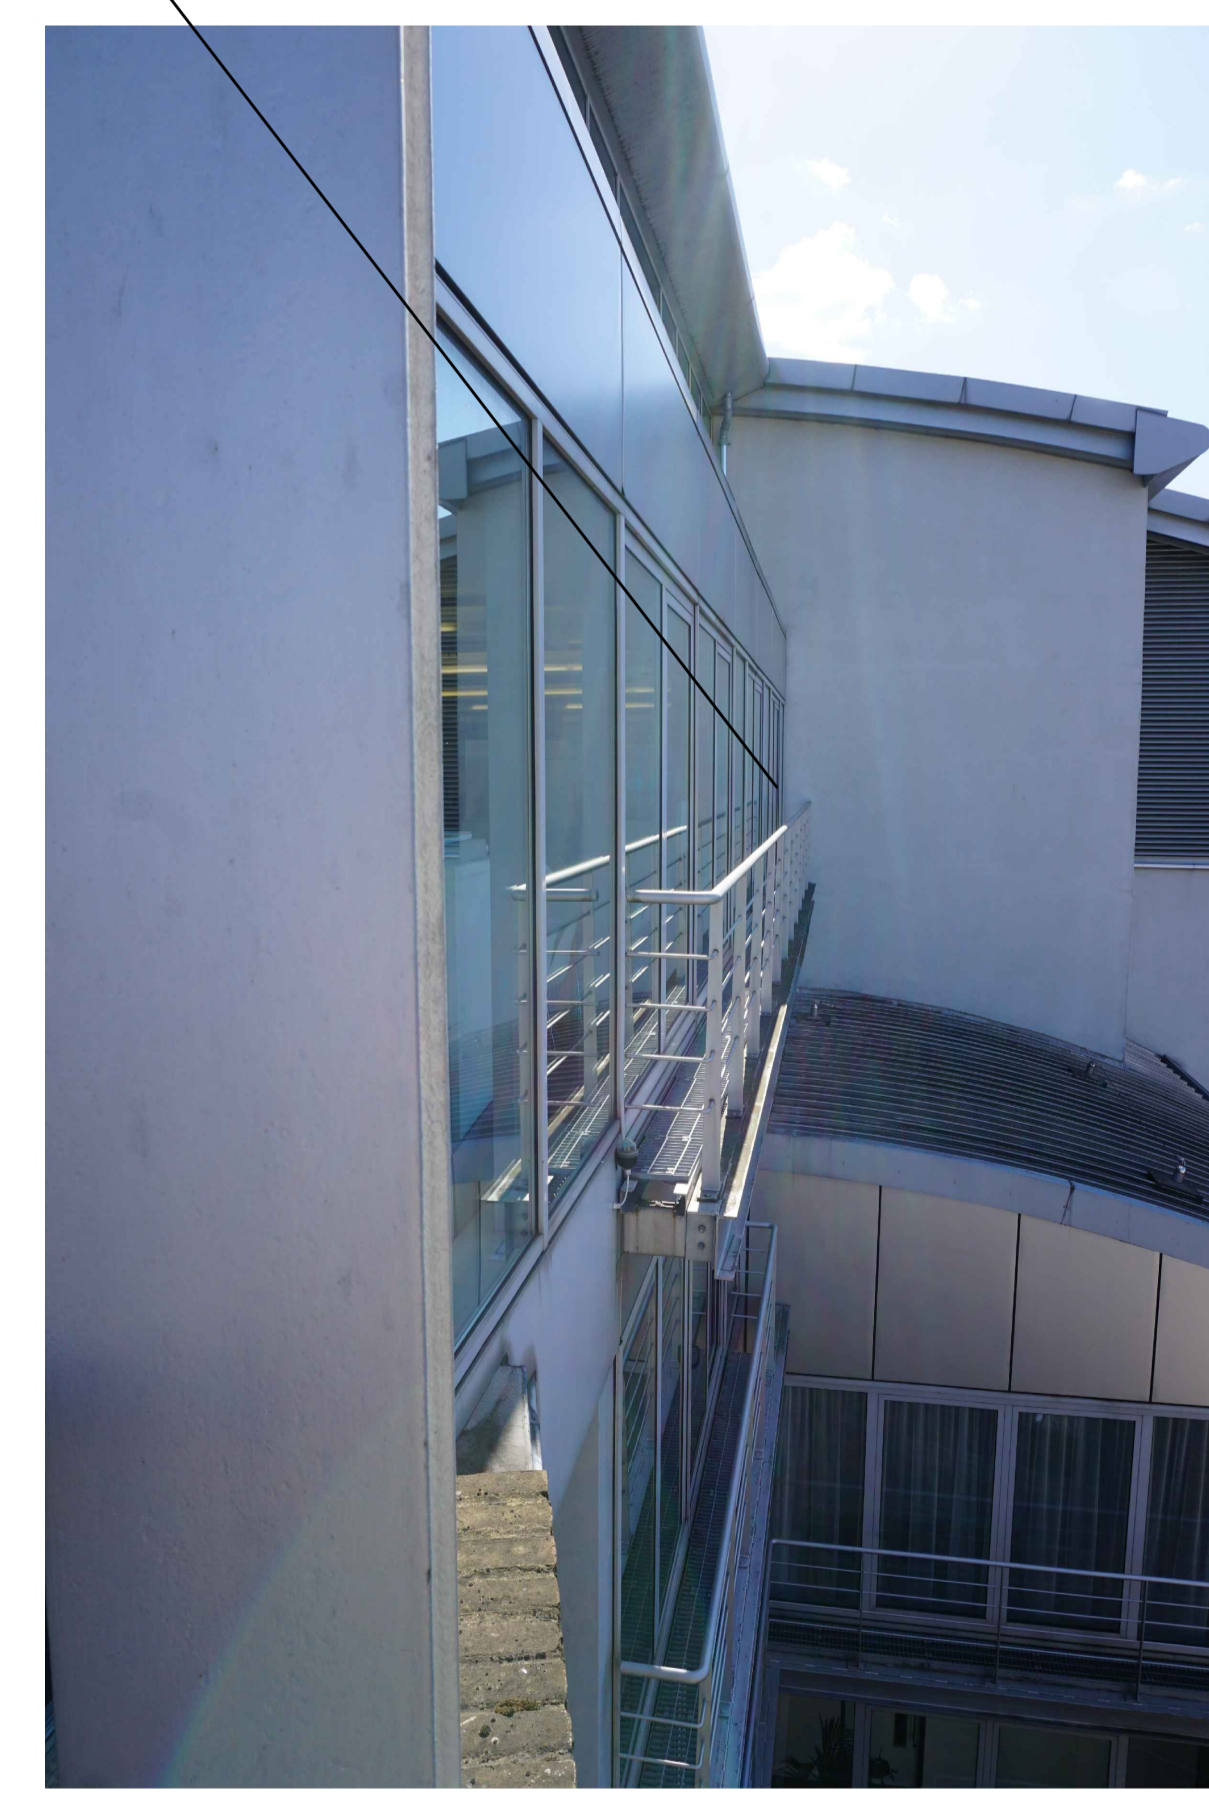

EXISTING PHOTOGRAPHS

| | | | |
|-----|--|----|----------|
| Rev | Revision | By | Date |
| B | REVISED TO SUIT PLANNING OFFICERS COMMENTS | NS | 07.08.18 |
| A | WINDOW TRANSOM ADDED TO 5TH | TC | 02.08.18 |
| - | DRAWING FIRST ISSUED | TC | 16.05.18 |

FOR PLANNING

Morgan Lovell

16 Noel Street London W1F 8DA
T: 0207 734 4466 F: 0207 734 2968 E: contact@morganlovell.com
W: http://www.morganlovell.com

Client
SAFFRON HOUSE

Project
6-10 KIRBY STREET
LONDON
EC1N 8TS

Title
4TH & 5TH PROPOSED SIDE ELEVATION (C)

| | | | |
|---------|----------|-------------------|-------------------|
| Scale | Date | Designer/Drawn By | Checked By / Date |
| 1:50@A1 | 26.06.18 | TC/TC | |

| | | | |
|----------------|-------|-------------|-----|
| Drawing Number | | | |
| Project No. | Floor | Drawing No. | Rev |
| ML2918 | 4-5 | 905 | B |