



Low level brickwork walls, not part of application
 Trellis Screen, not part of application
 Extended brick pillars

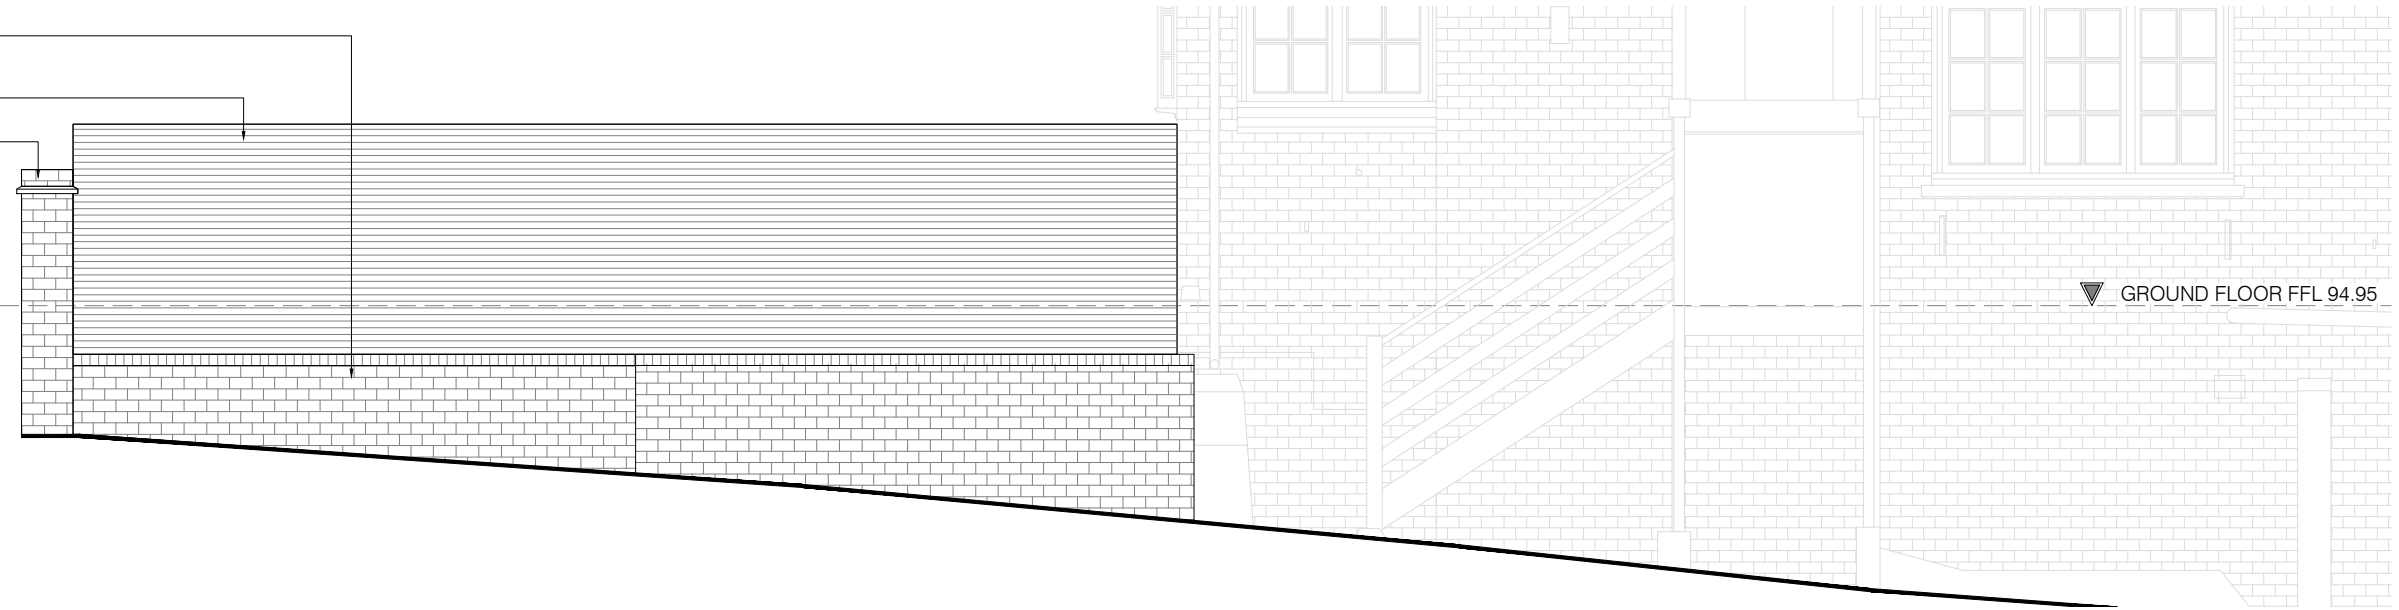


Elevation A

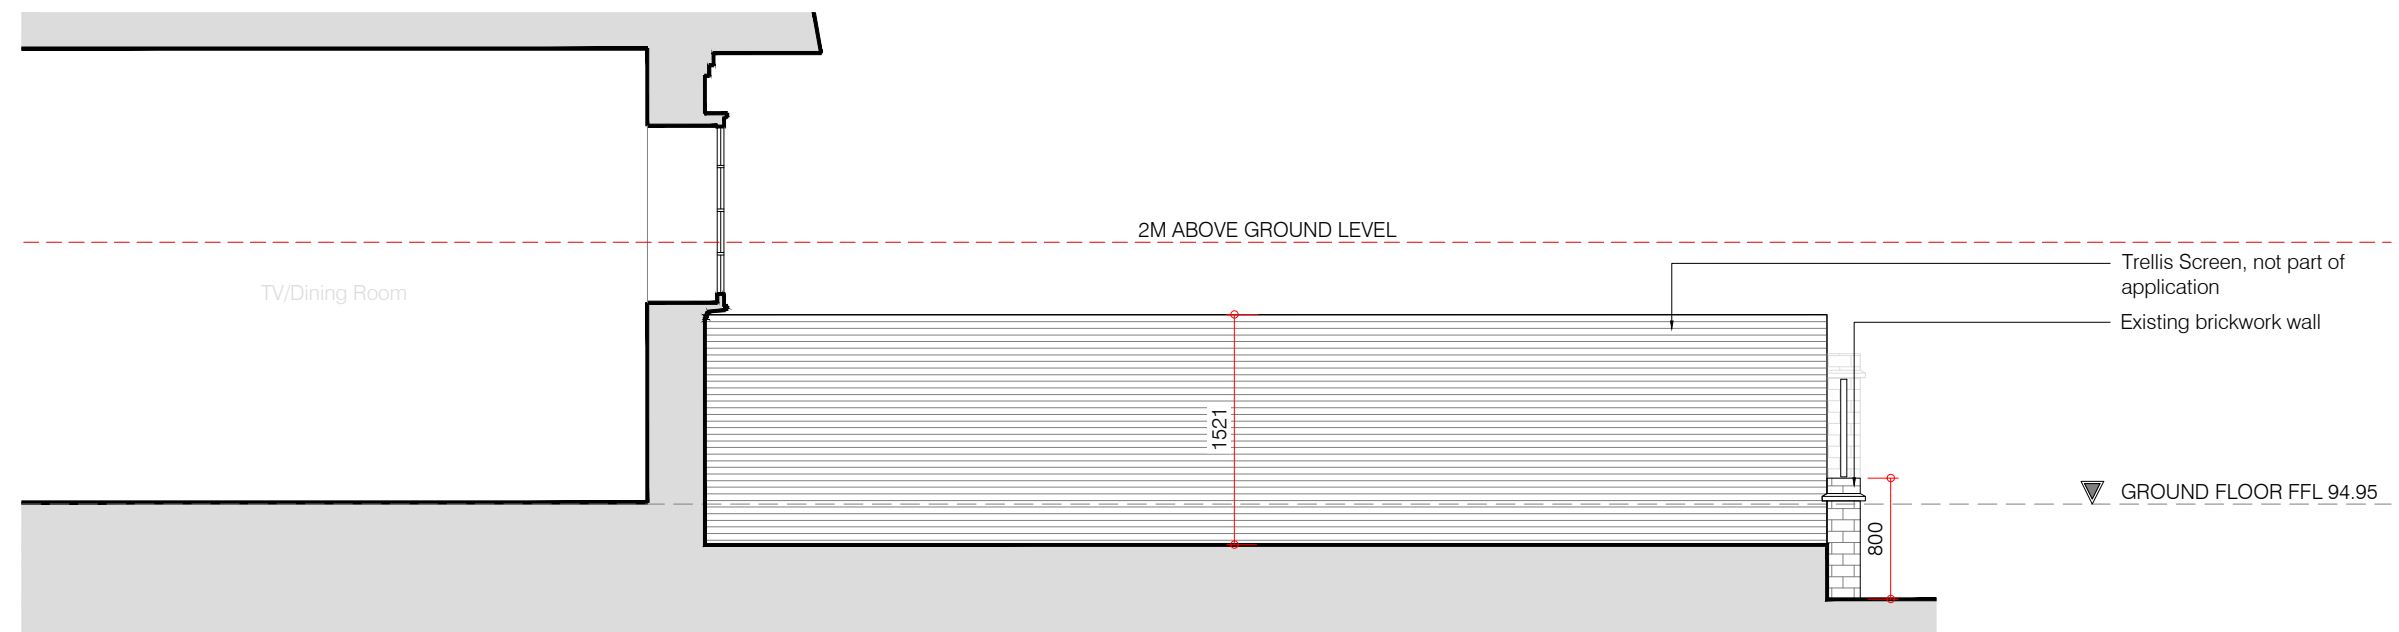

Elevation B

KEY PLAN

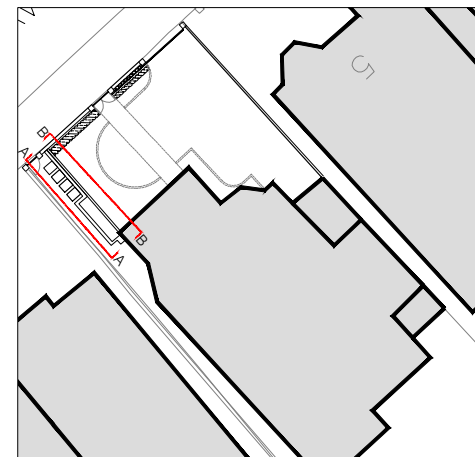

<p>Rev: Comments: By: Date:</p>				<p>PLANNING</p>		<p>kyson⁺</p>	
<p>Client: Rebecca Bard</p>				<p>Studio</p>		<p>28 Scrutton Street London UK EC2A 4RP</p>	
<p>Project Title: 7 Oakhill Avenue, Hampstead, NW3 7RD</p>				<p>Client: Rebecca Bard</p>		<p>T: +44(0) 20 7247 2462 E: enquiries@kyson.co.uk W: www.kyson.co.uk</p>	
<p>Drawing Title: As Built Side Elevations</p>				<p>Scale: 1:50@A3</p>		<p>Date: Jul 19</p>	
<p>Do not scale this drawing. All dimensions must be checked on site. All rights reserved. No reproduction in any material form is permitted without consent.</p>				<p>Drawn: KK</p>		<p>Checked: PH</p>	
<p>Project No.: 536-17</p>				<p>Drawing No.: 3001</p>		<p>Revision: -</p>	