
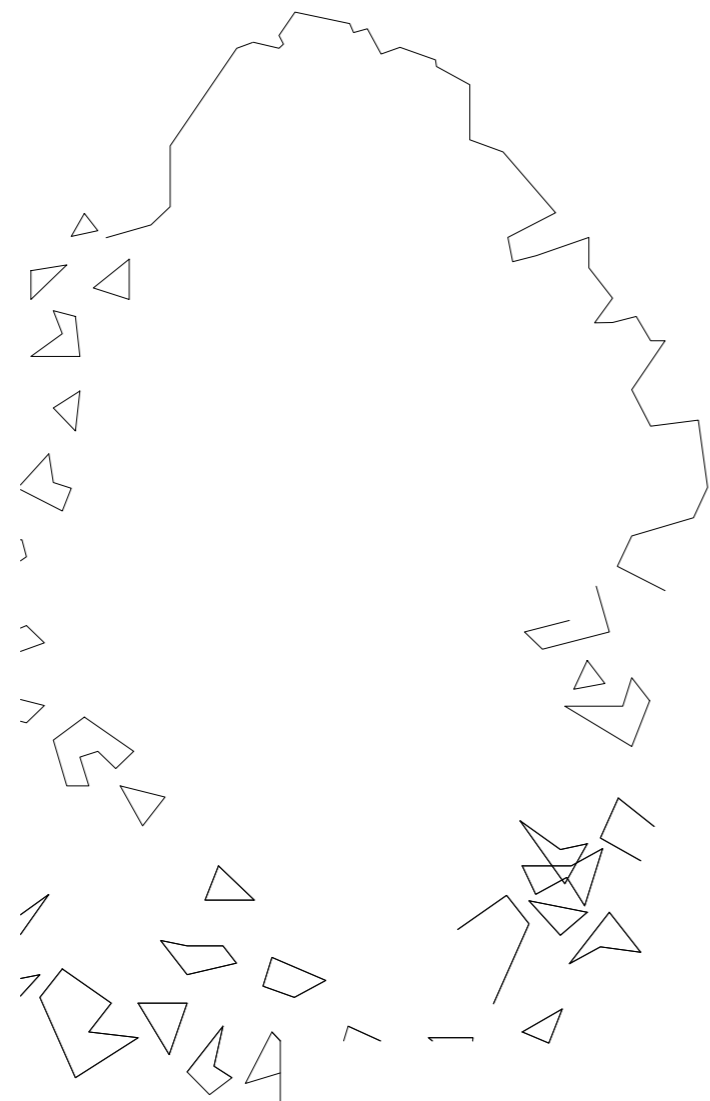


NOTES

DO NOT SCALE FROM THIS DRAWING

AS BUILT

NOTE:


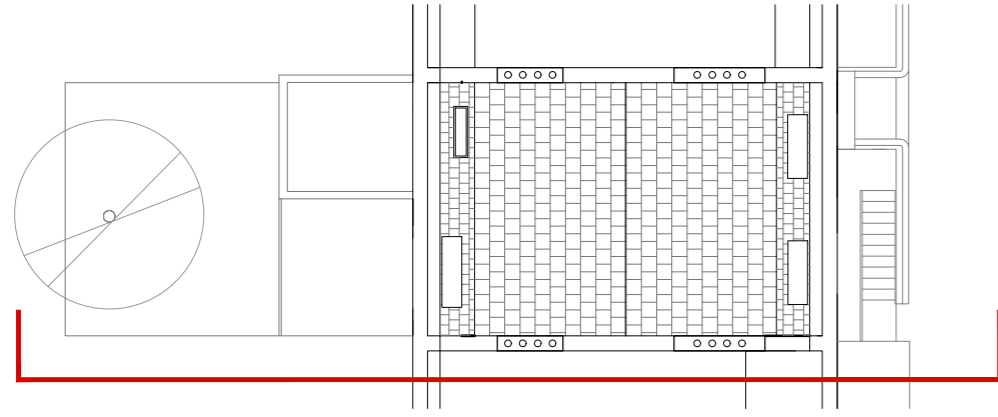


Extractor fan unit to be revised.
See Proposed drawings.

3000 mm high consented previously

431

2500

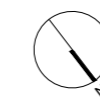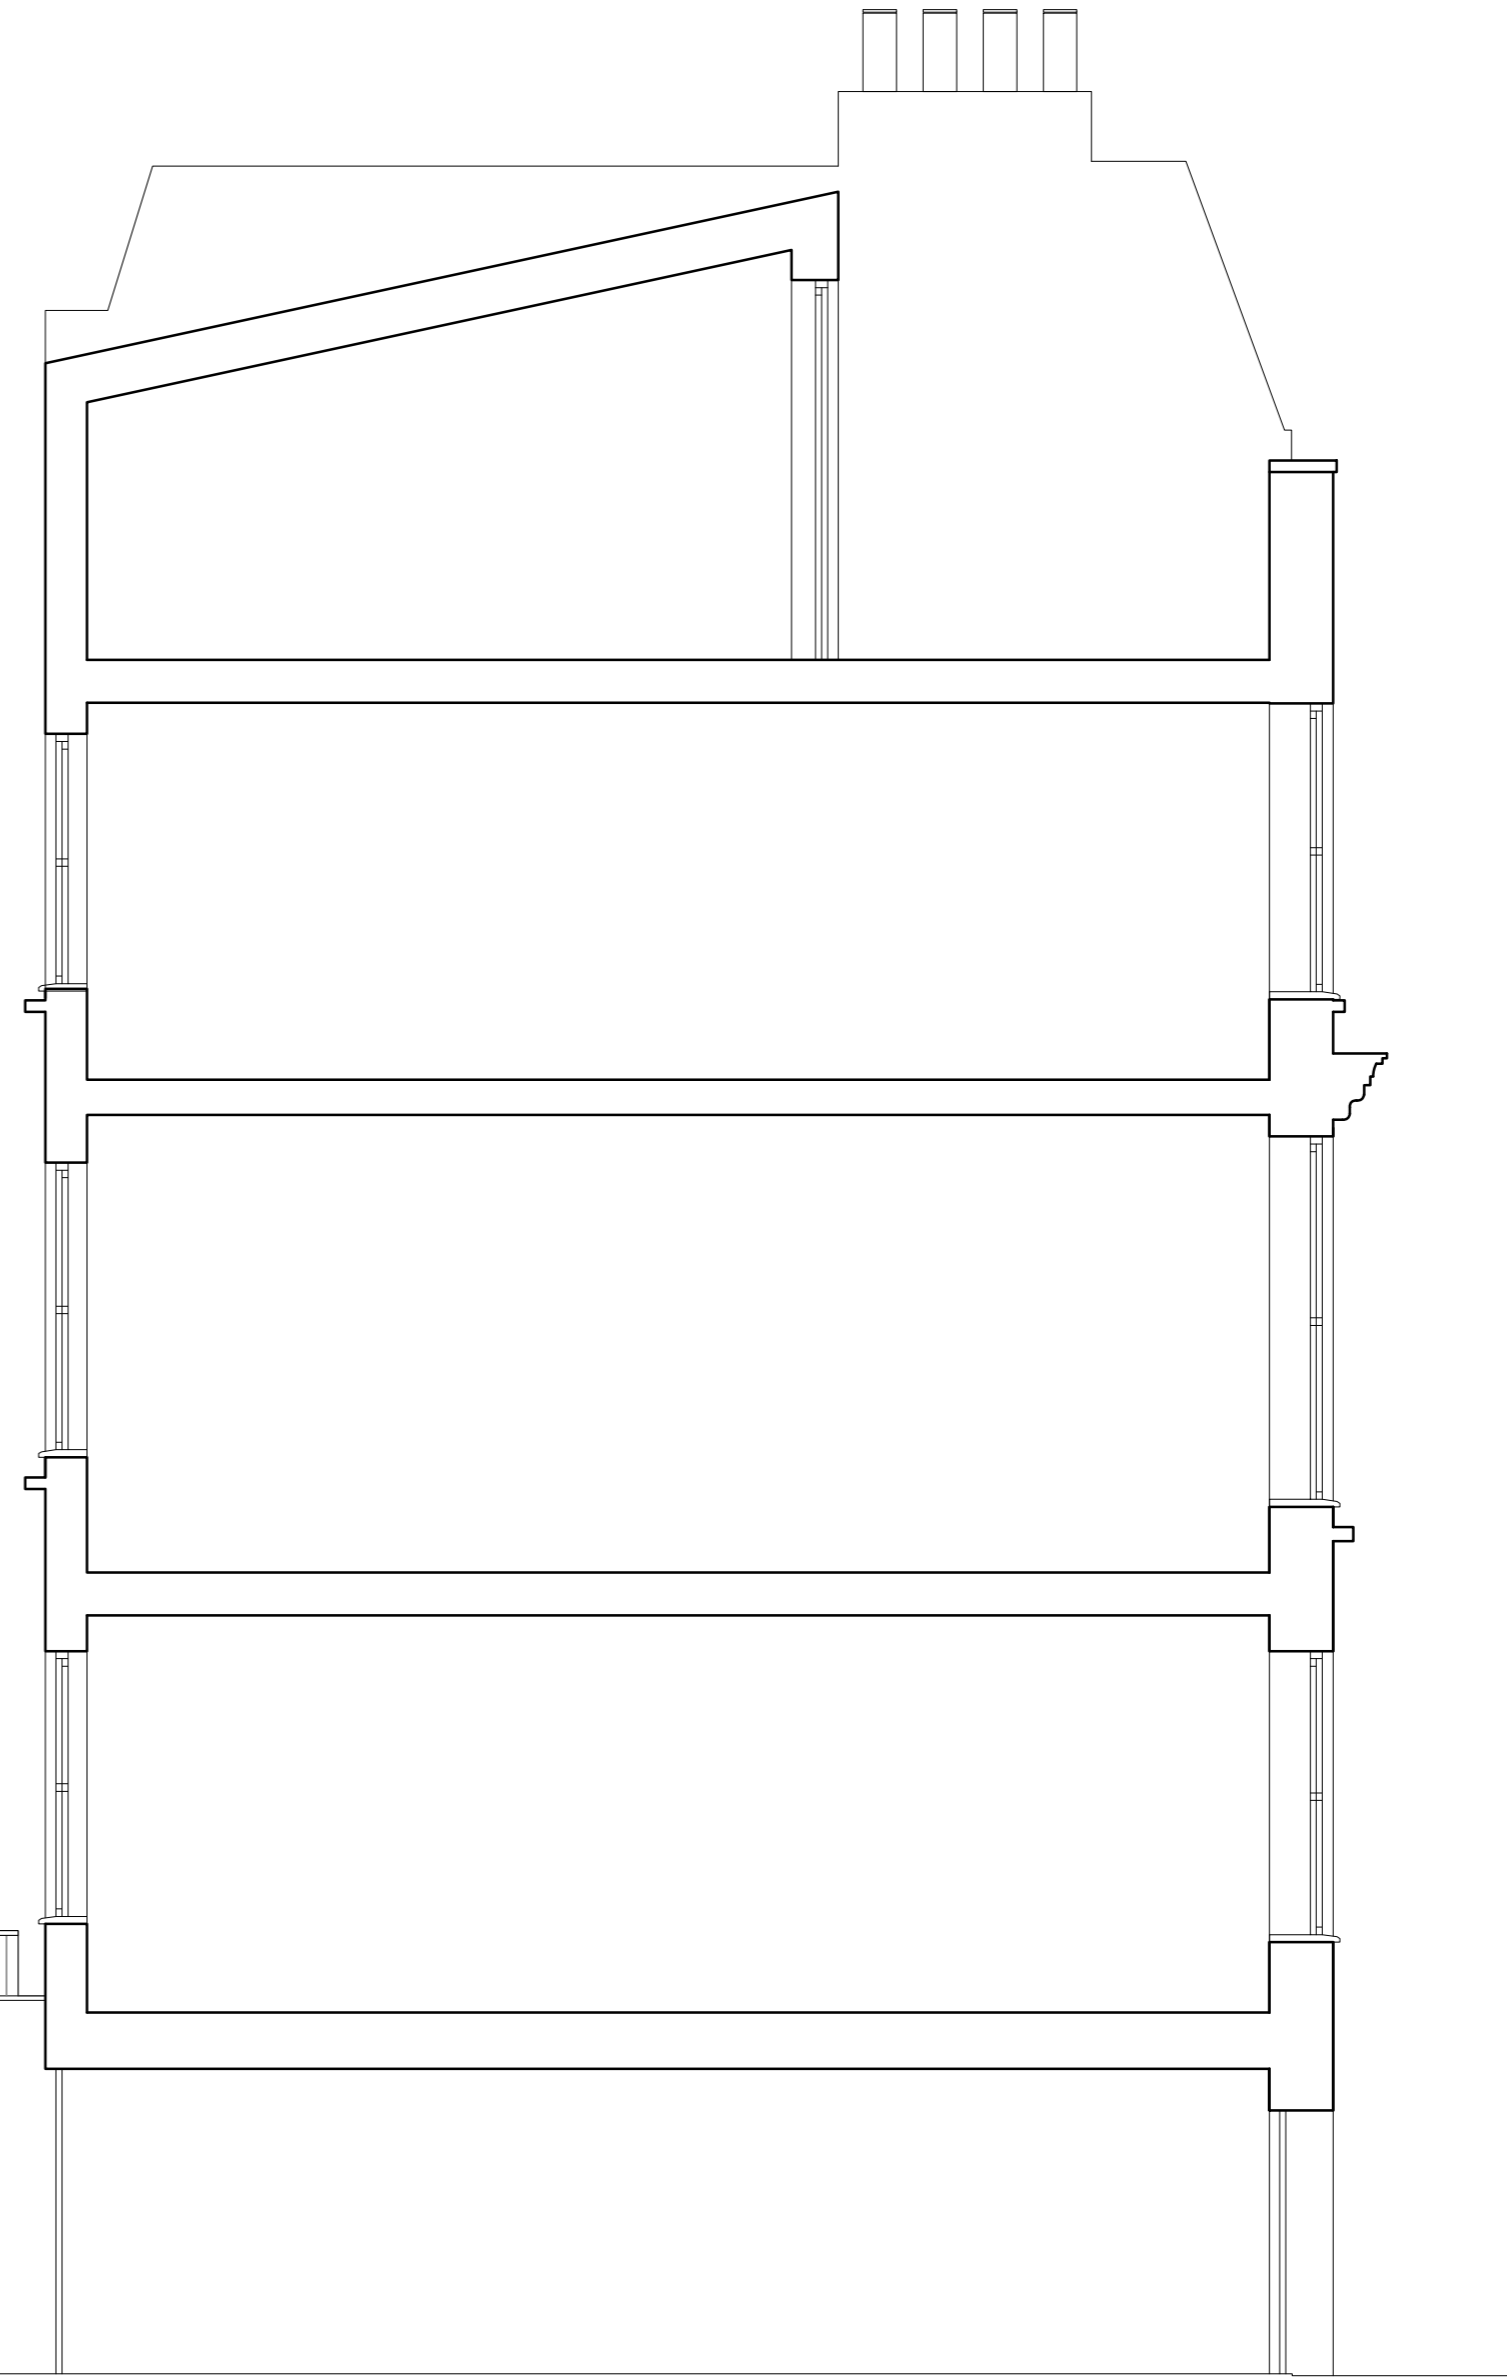

Martin Evans Architects o 18 Charlotte Road London EC2A 3PB tel 020 7729 2474	
JOB 17, EDIS STREET NW1 5LE LONDON	
TITLE SIDE ELEVATION AS BUILT through 16 Edis St	
DATE	27.06.2019
SCALE	1:50 @ A3
DRAWN	C.F.
DRAWING NO. EDI-BUILT-GA-16	