

General note

This drawing is to be read in conjunction with all other relevant drawings, schedules and specifications issued by AYH DESIGNS

All interior dimensions including ceiling heights are taken to and from finished surfaces unless otherwise stated. All levels and dimensions must be checked on site.


Any discrepancies with the information depicted in this drawing must be reported to AYH DESIGNS. Responsibility can not be accepted for alterations made to this drawing without prior permission from AYH DESIGNS

This drawing must not be photocopied, scaled or reproduced otherwise scale accuracy can not be guaranteed.




This drawing should not be used in any circumstances for any structural calculation or building construction / demolition work.




A Proposed Rear Elevation
Scale: 1:100

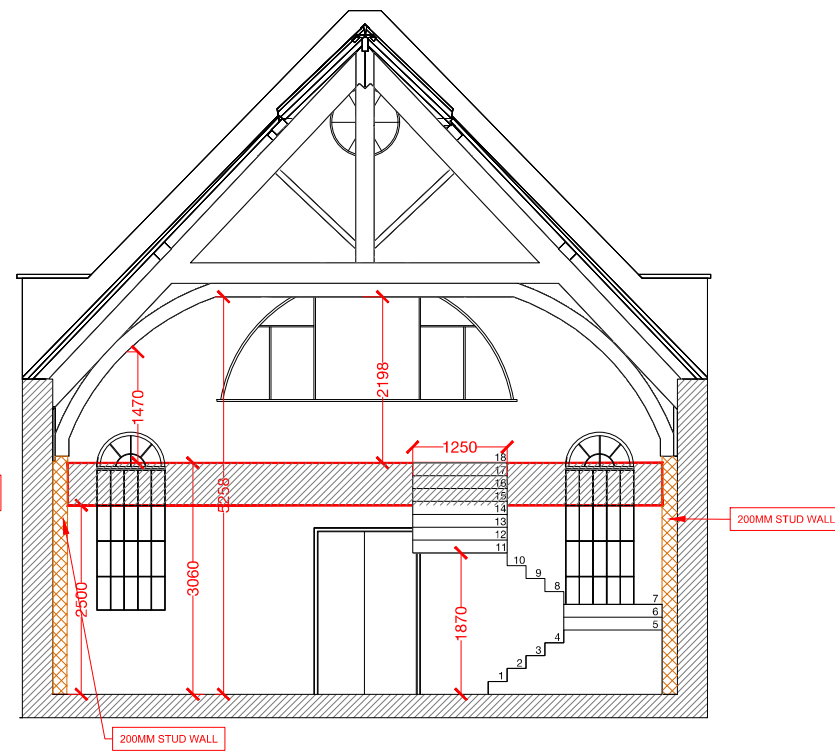


A1 Proposed Short Section D-D
Scale: 1:100

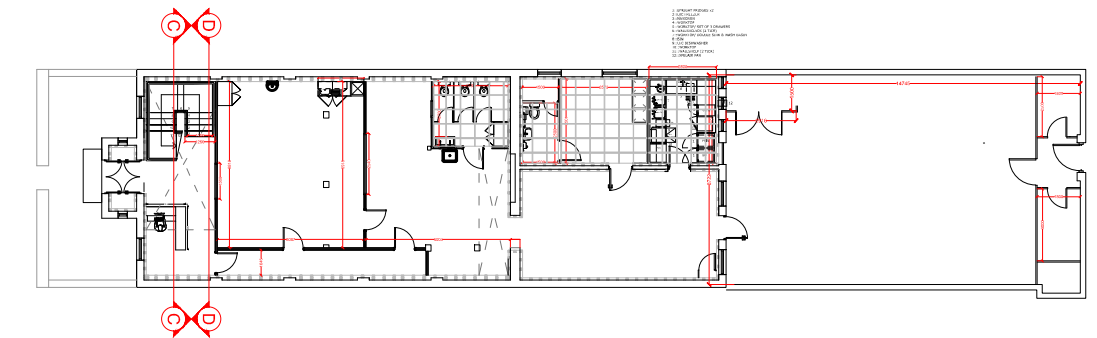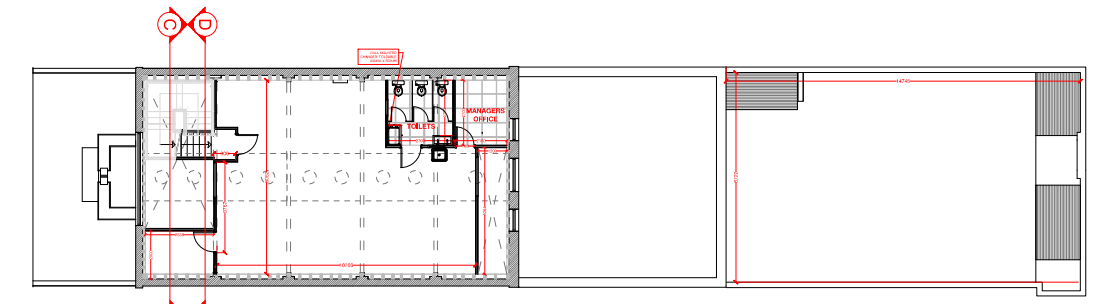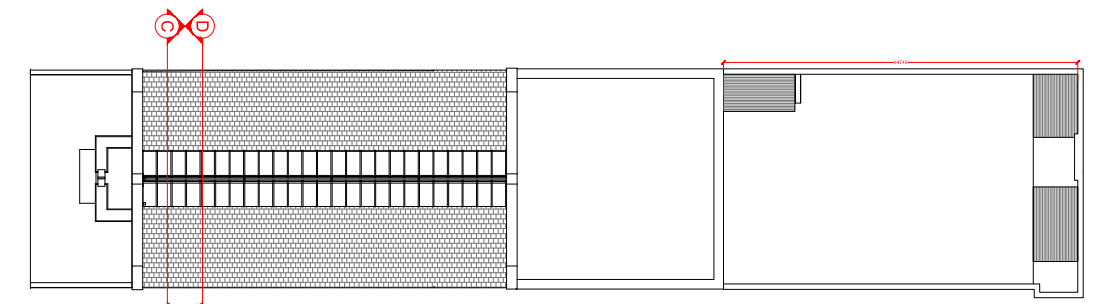

A FLOOR PLANS
NOT TO SCALE

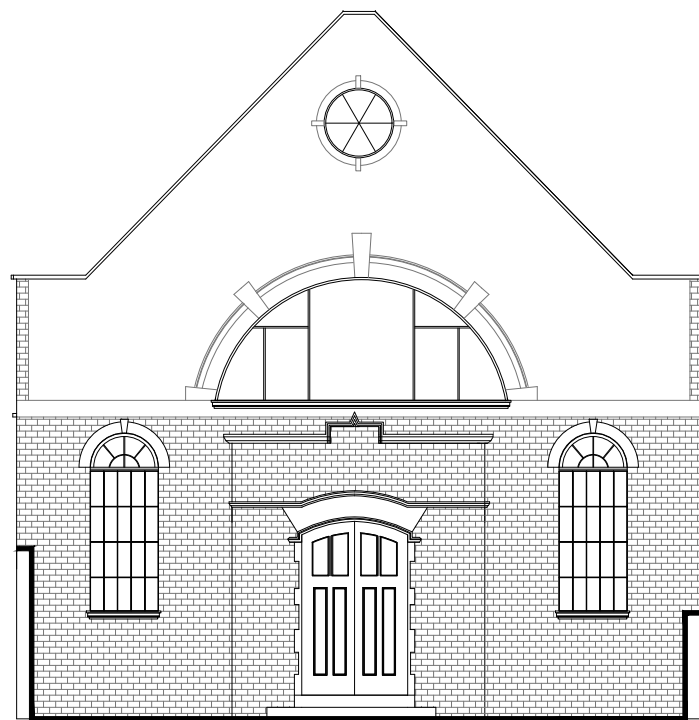

B Proposed Front Elevation
Scale: 1:100

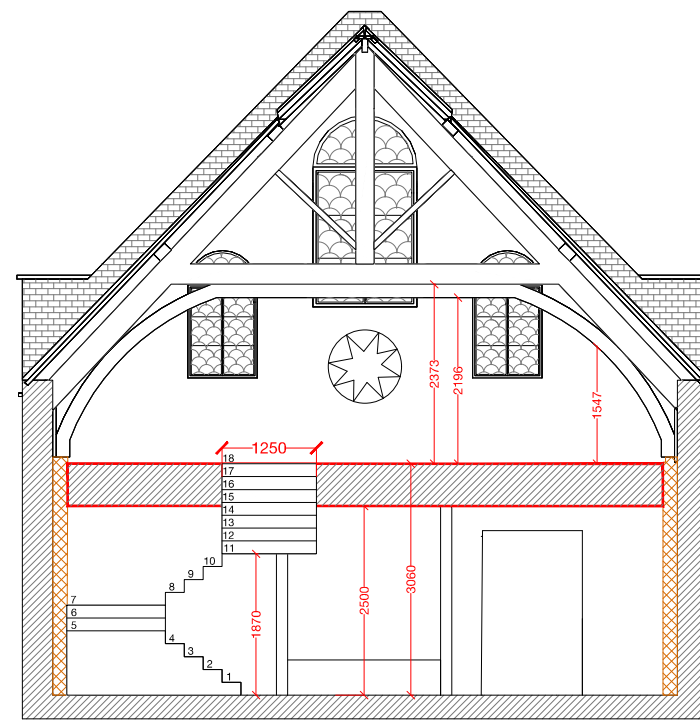

B1 Proposed Short Section C-C
Scale: 1:100

AYHDESIGNS

M: +44 (0)7595464885 M: ayhconceptdesigns@gmail.com

CLIENT:
SAFARI KID
JOB TITLE:
ROCHESTER SQUARE, NW1 9RY
DRAWING TITLE:
PROPOSED ELEVATIONS & SECTION
TOTAL SQM/SQFT:

JOB NO:	DRAWING NO: 010	REVISION: B	SCALE(S): 1:100@A3
DRAWN: AYH	CHECKED: YES	AS BUILT	DATE: 14.06.19